

SCAN REQUIRED

Ref: BC 23935


Address: 17 Elsie Drive

12-02-2013

Revised
As-built plan

House 1st Floor Deck Handrail


fixing detail

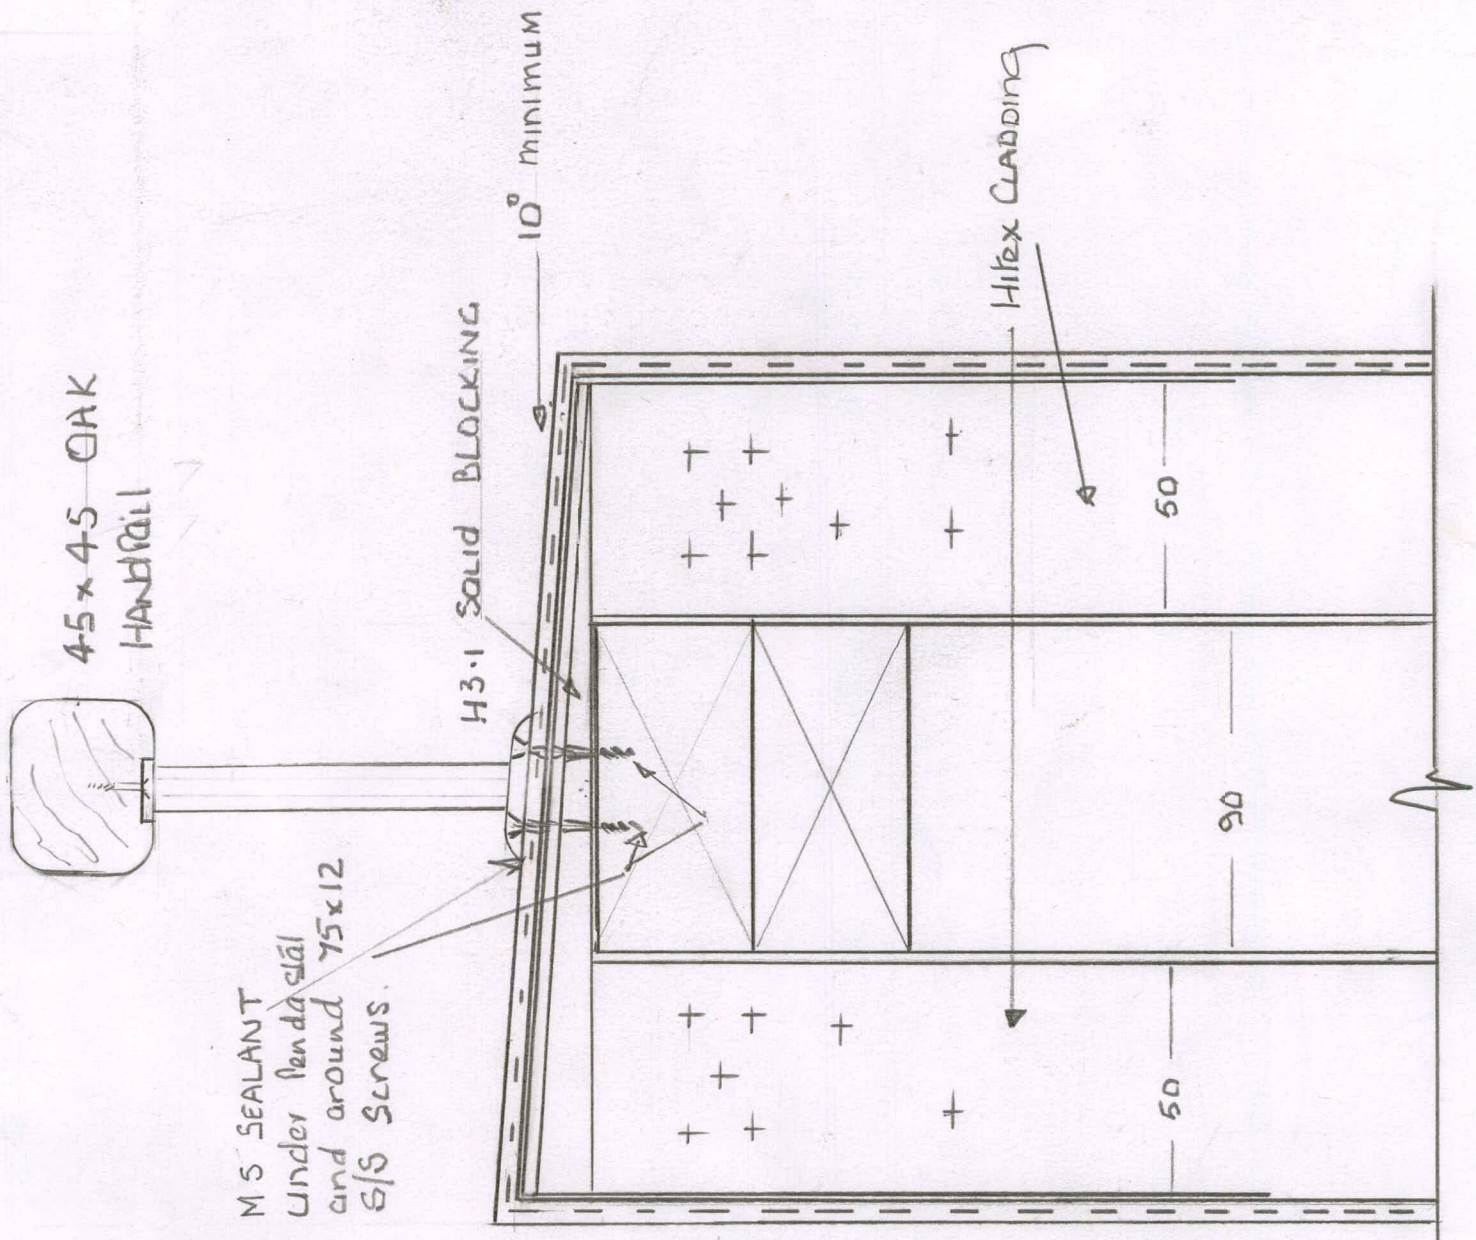

Scale 1-2

Guest house deck detail

New detail
R.L.

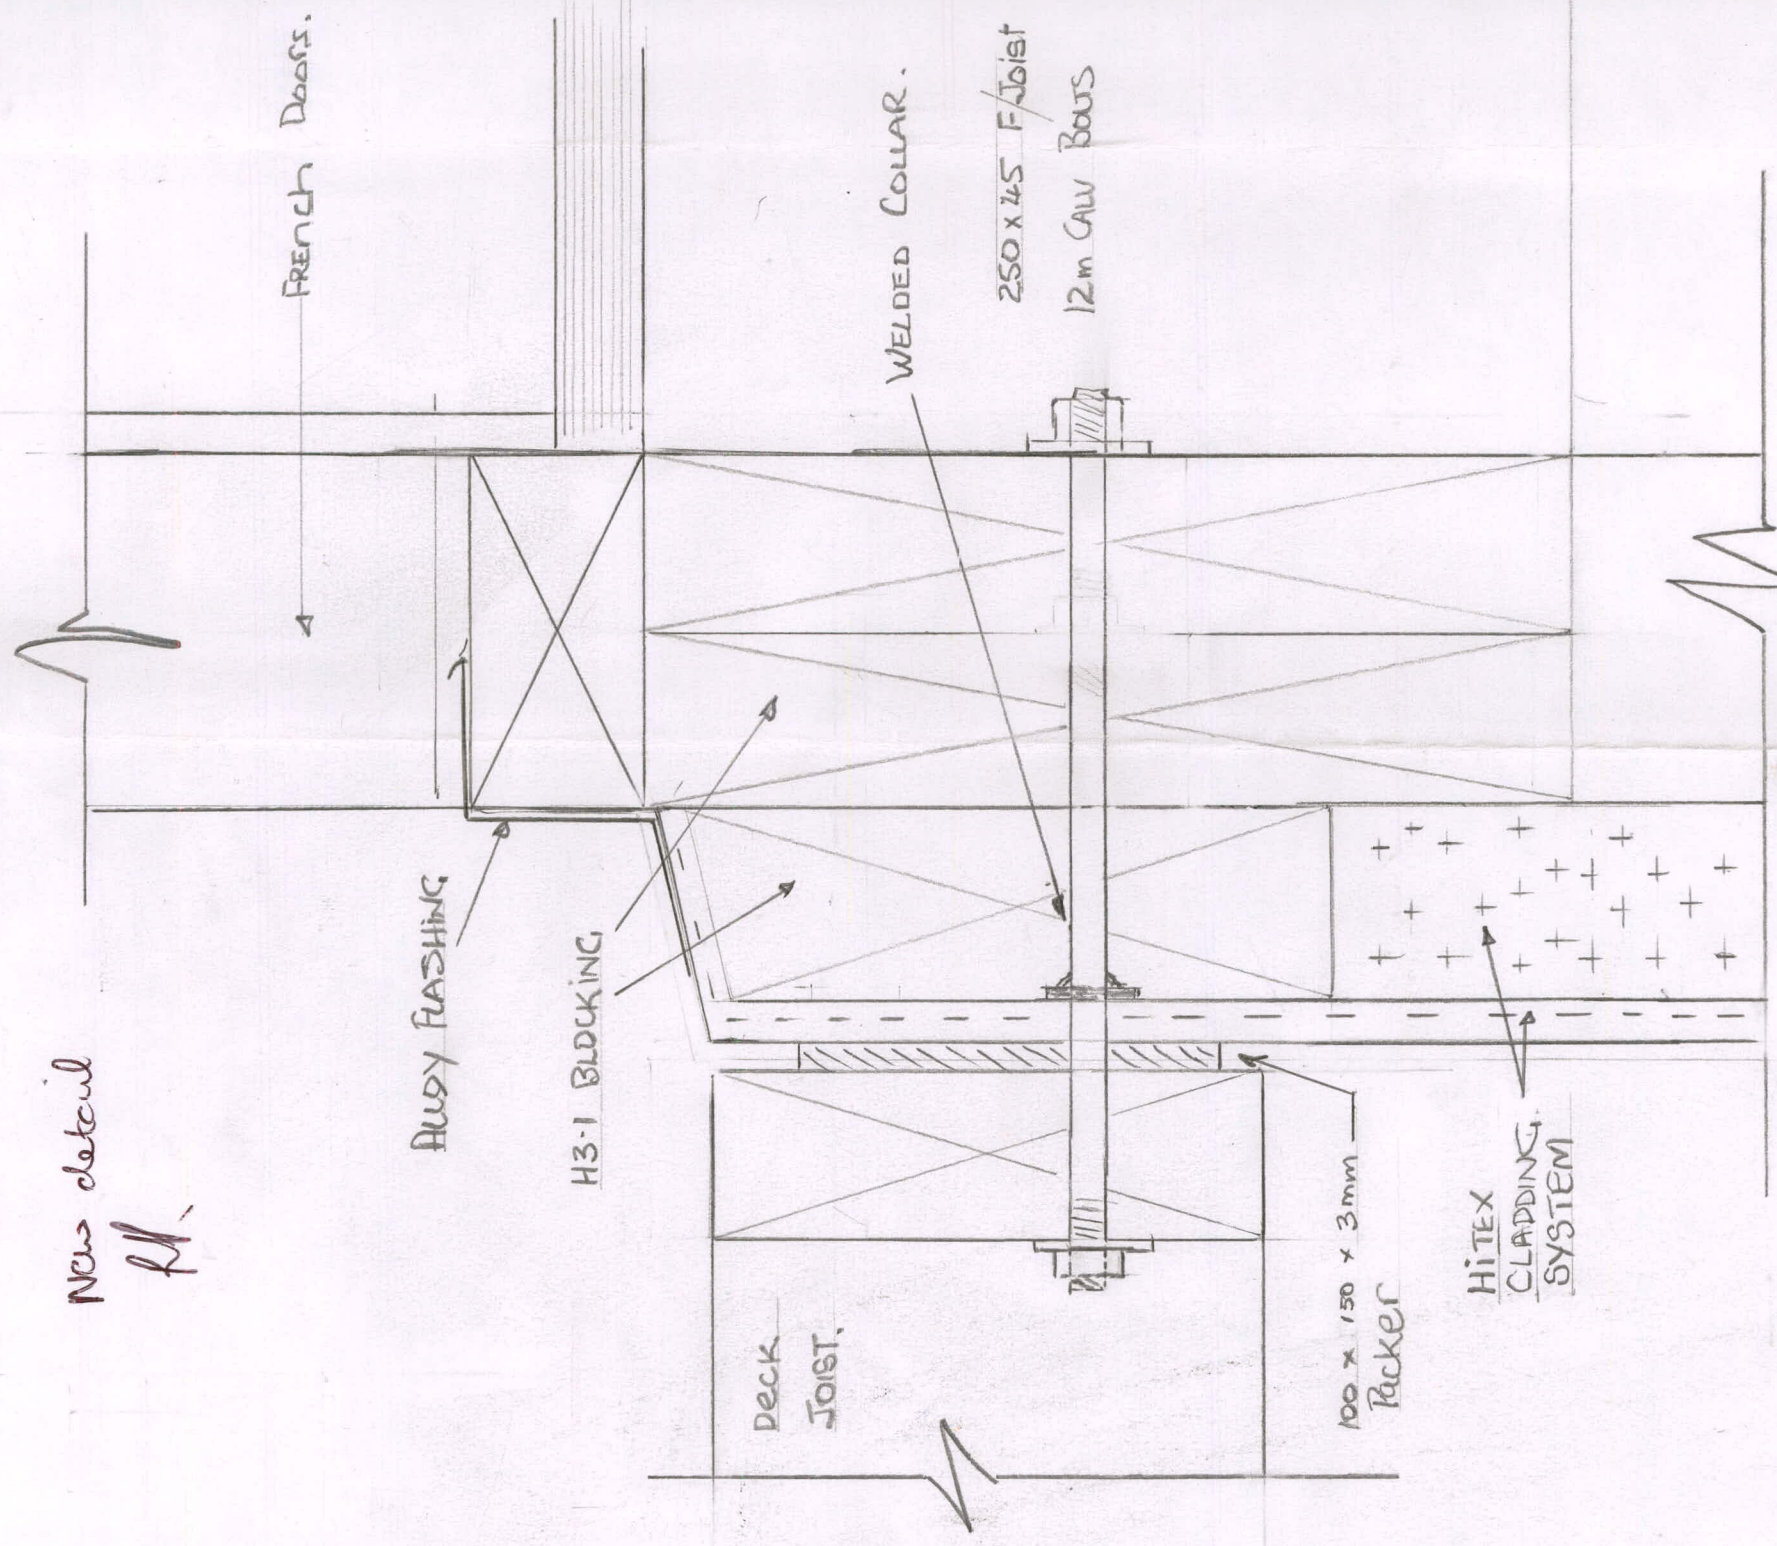

Scale 1-2

SCAN REQUIRED

Ref: BC 23935


Address: 17 Elsie Drive

12.02.2013

Handrail Detail for Guest House

17 ELSIE DRIVE WAIKUKU.

Revised
As-built plan

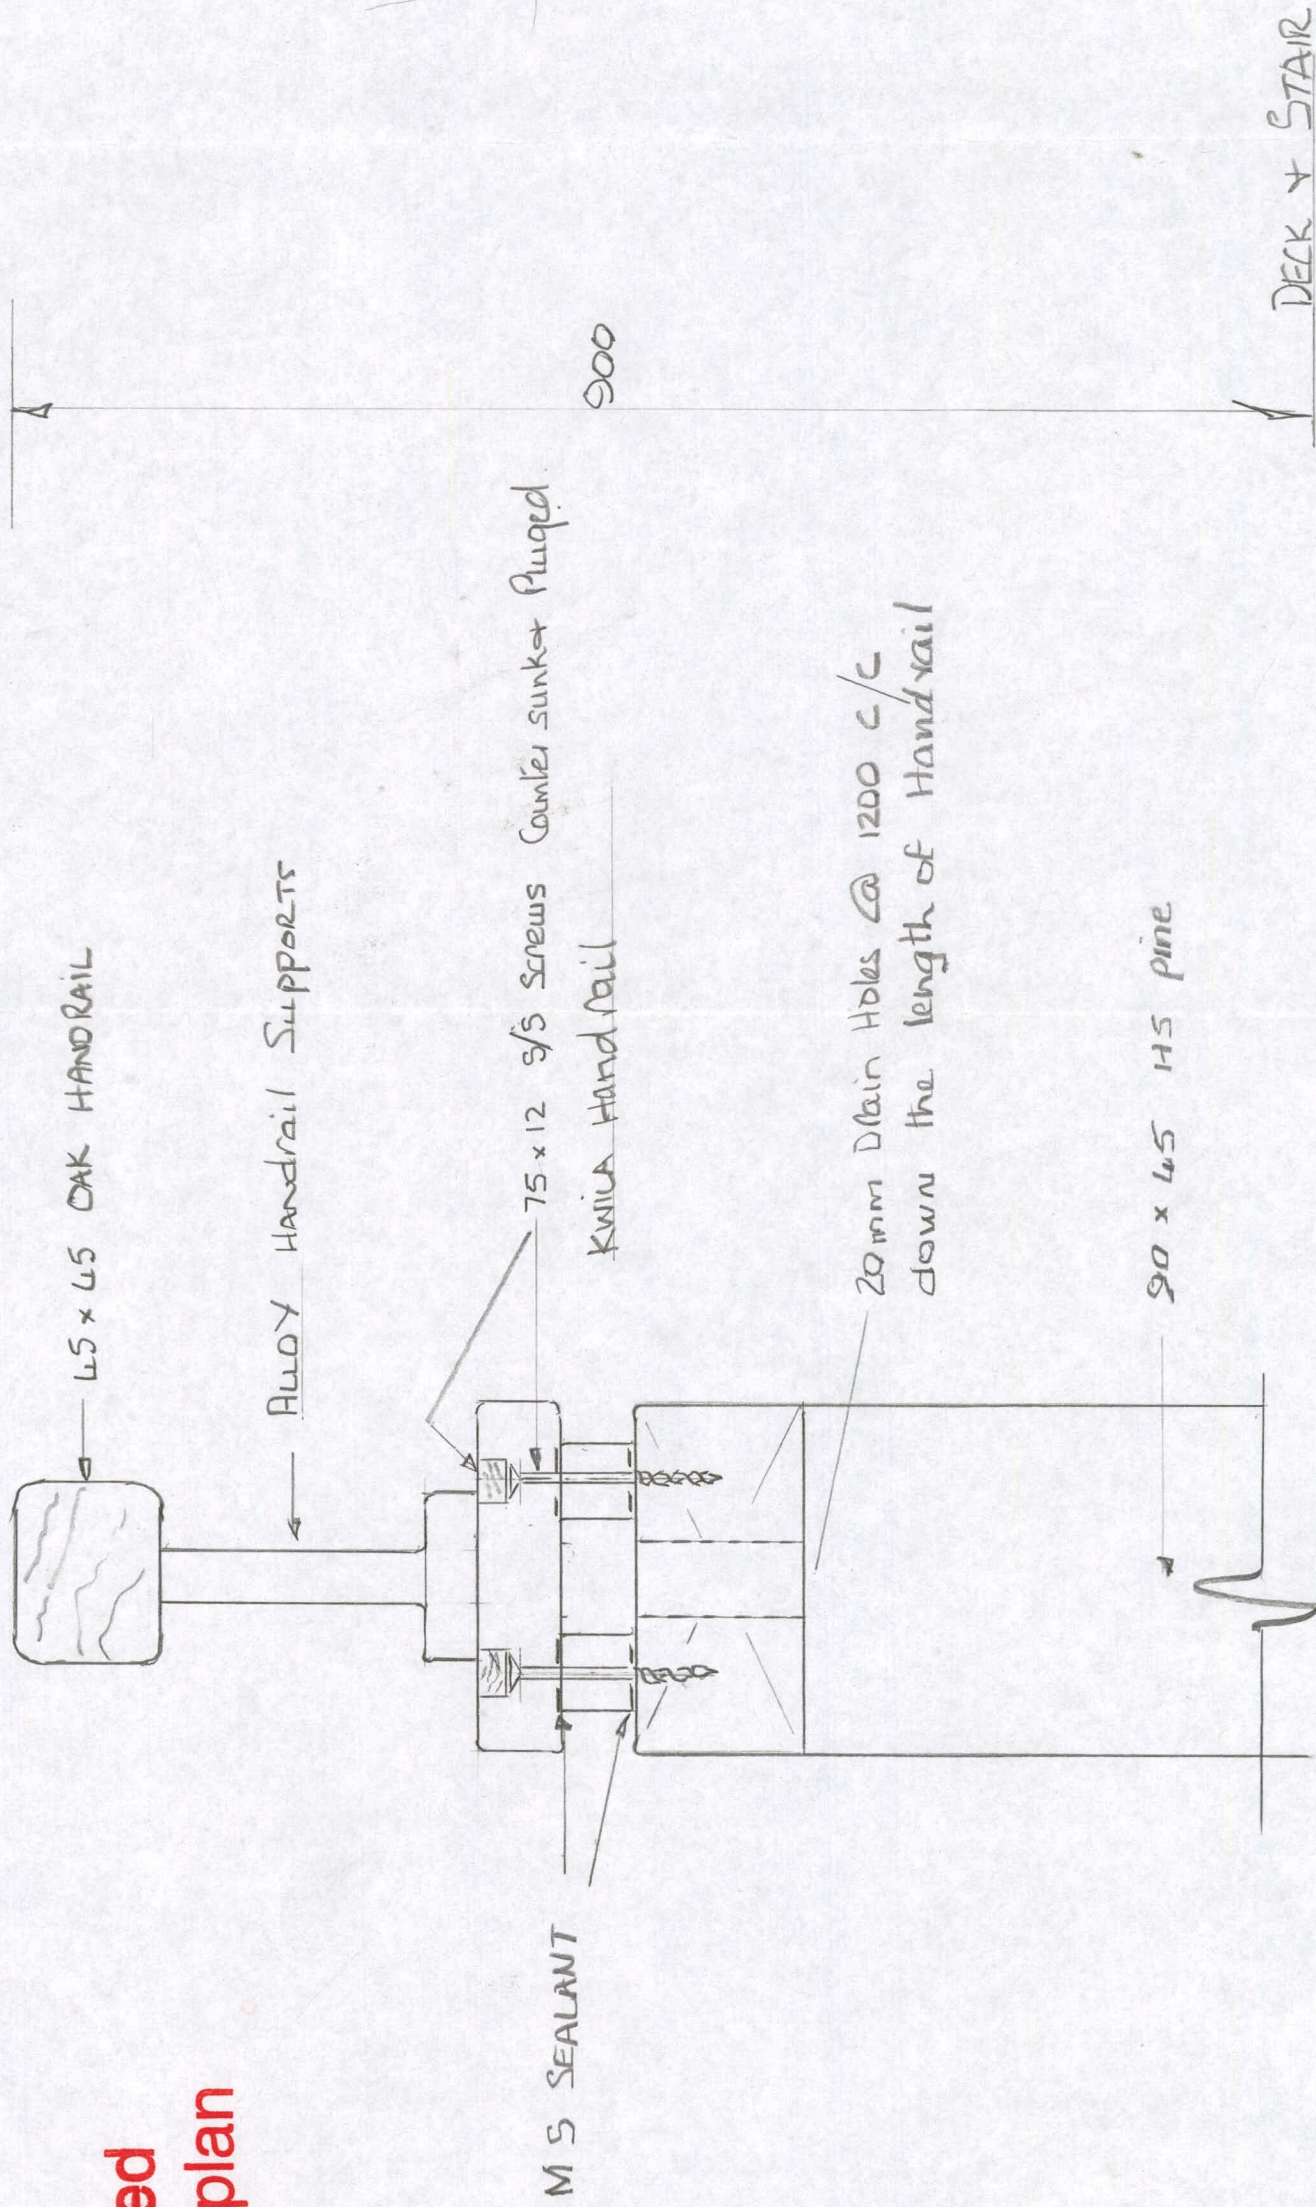

Scale 1-2