



AS-BUILT DRAINAGE PLAN

Our Reference

Kaitia Service Centre
Redan Road, P.O. Box 262, Kaitia
Telephone (09) 408-1400, Fax (09) 408-1404


If calling, please ask for

Owner's Name P. J. JAMES.

Permit No 1104

Situation of Premises TOLARA BEACH RD Val No 30/159.

WHATUWHIWHI	Lot

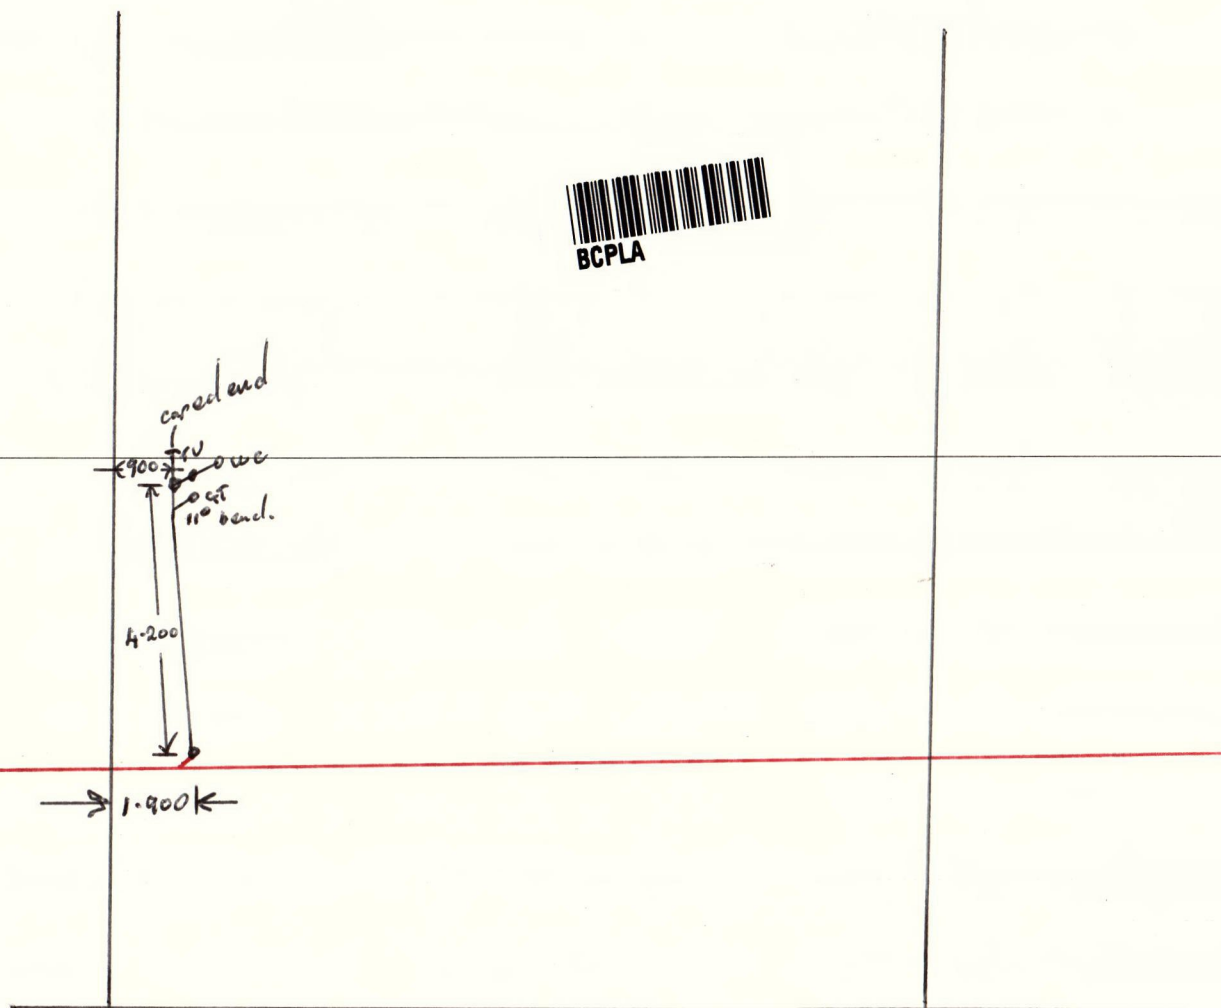

JOHNSON BEACH RD

Registered Drainlayer/Plumber

Address _____