

WHAKATANE DISTRICT COUNCIL

As Built Drainage Plan

Lot D.P.

Road *Harbour Rd* *No 49*


County Town *Harbour Rd* *7240-368*

Sewer Connection

Harbour Rd

7240-368

Shapel 15-11-85

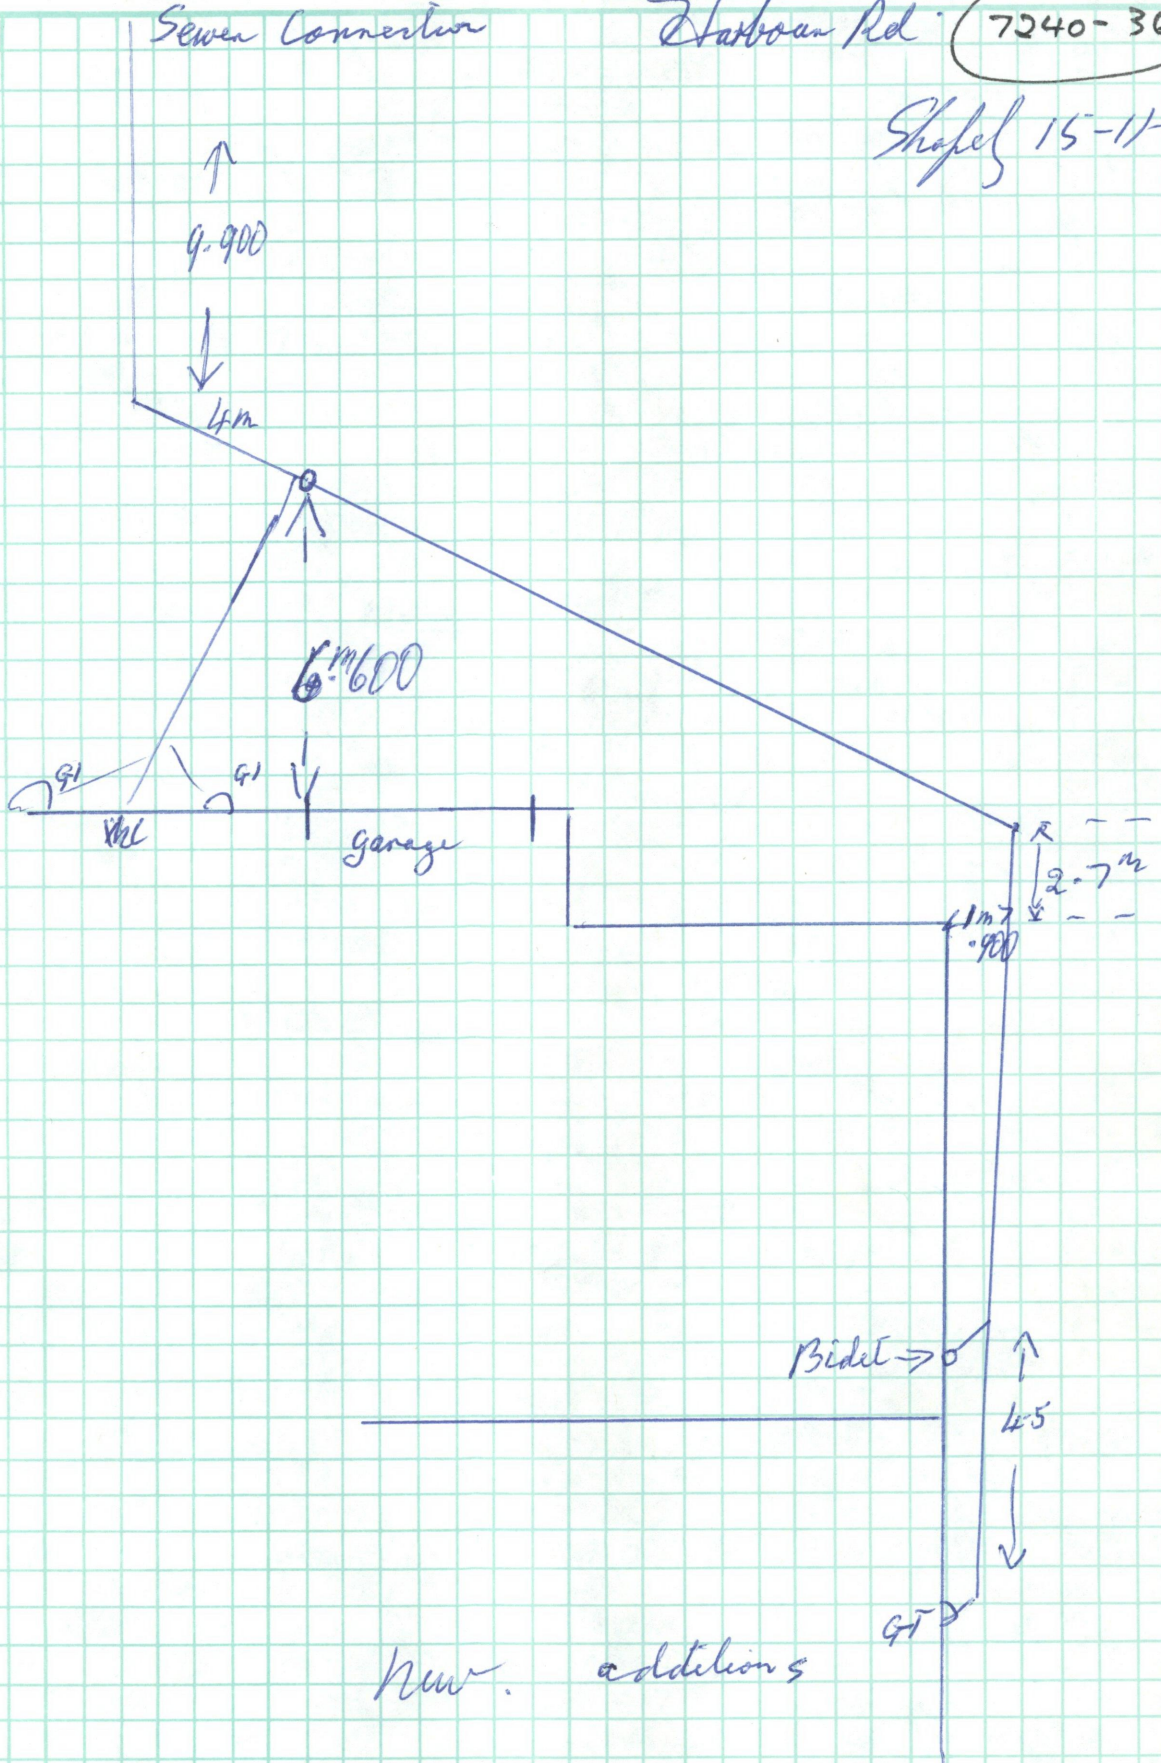

ROAD

For Office Use Only

Permit No. Infiltration Sources

Date Connected

Scale 1 : 100

1 : 200