


WEST
Boundary

1/8ths, 1/2 & 1 inch

B081Y

GORMACK GRAPH PAPERS : CHRISTCHURCH N.Z.

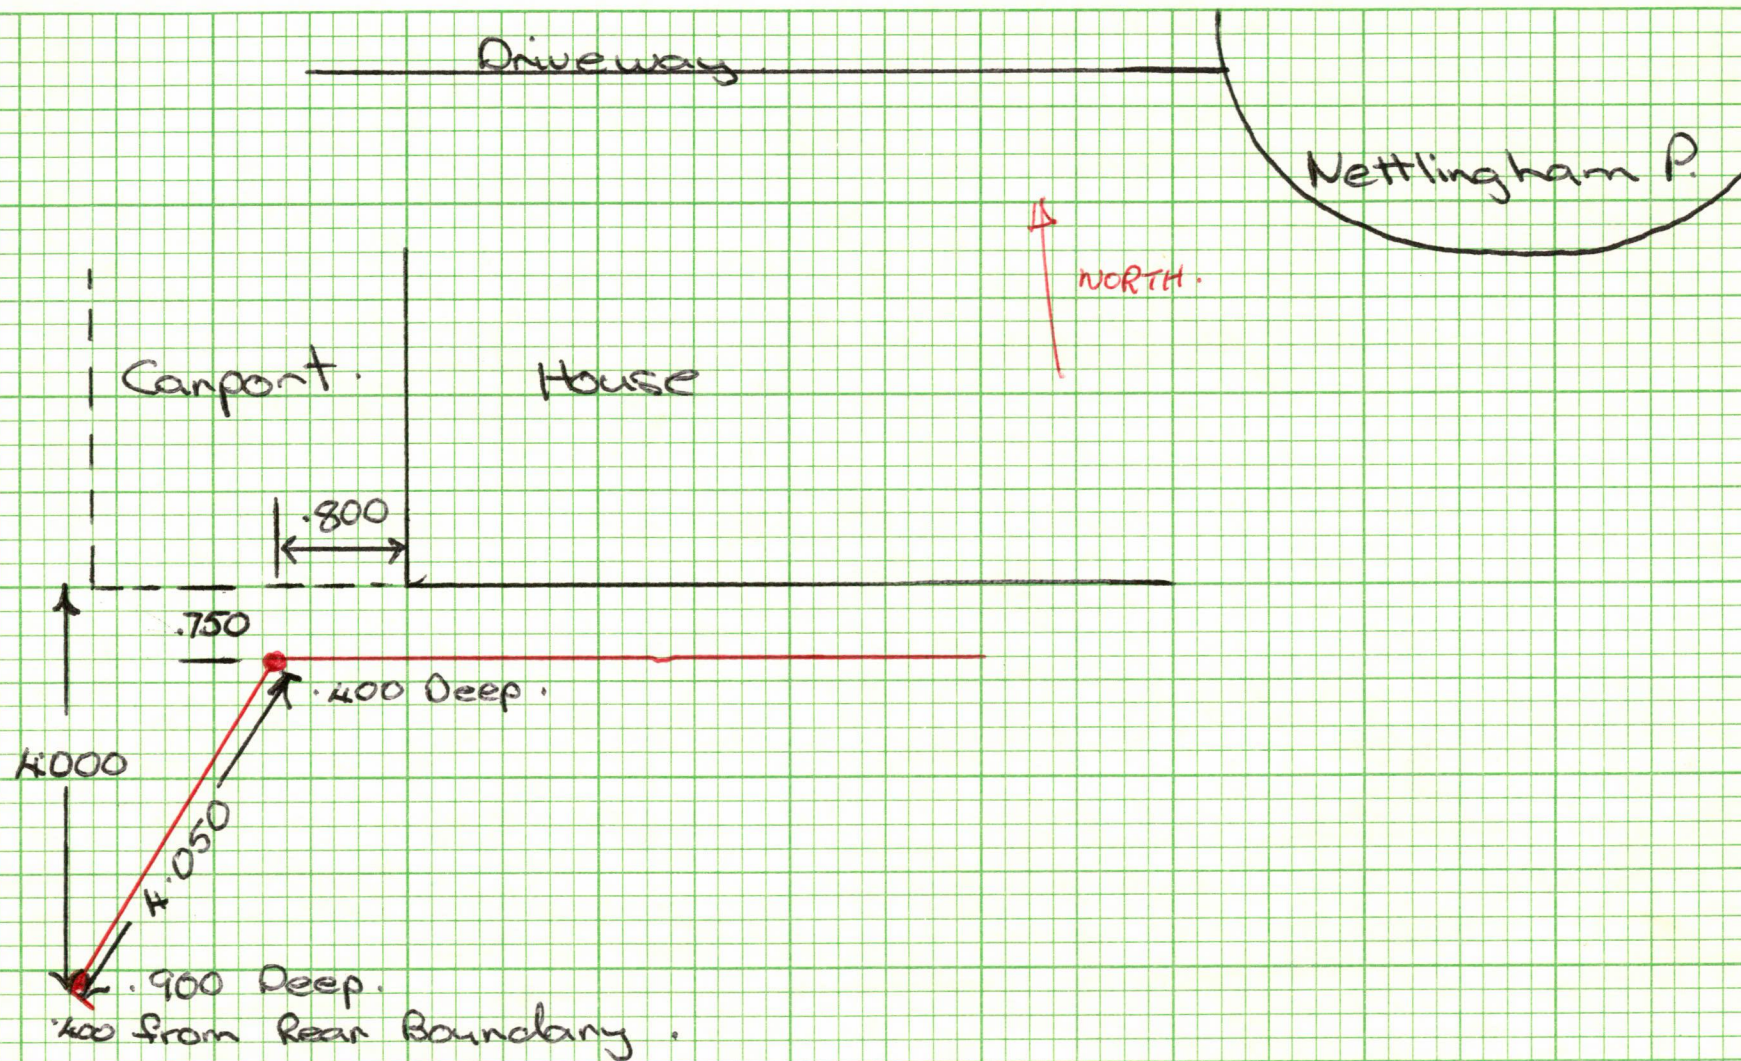

Mr. Mudge.
7 Nettlingham Place.