

ALL PLUMBING & DRAINAGE WORK TO COMPLY WITH DRAINAGE & PLUMBING REGULATIONS 1973



NOTE: ONLY QUALIFIED PLUMBERS (INCLUDING DUAL FLUSH) ARE TO BE INSTALLED.


APPROVED PLUMBING & DRAINAGE
 INSPECTOR
 DATE: 4/6/99

PLUMBER AND DRAINLAYER MUST CONTACT THE SANITARY INSPECTOR BEFORE COMMENCING WORK

ROUTING DOWNPIPES AND PROVIDING DRAINAGE TO BE PROVIDED TO THE APPROVAL OF THE INSPECTOR

Scale 1:100

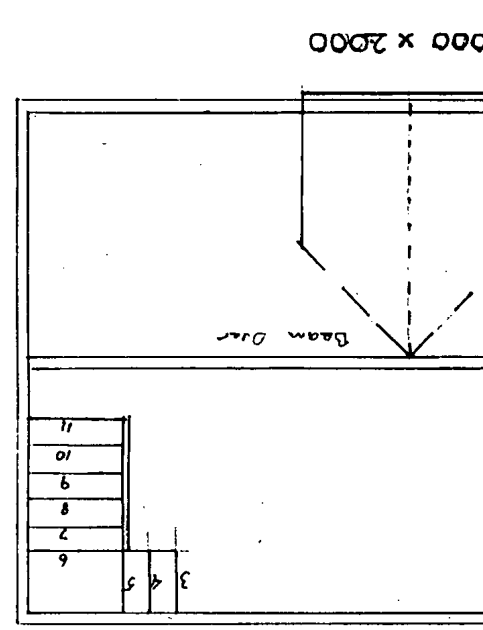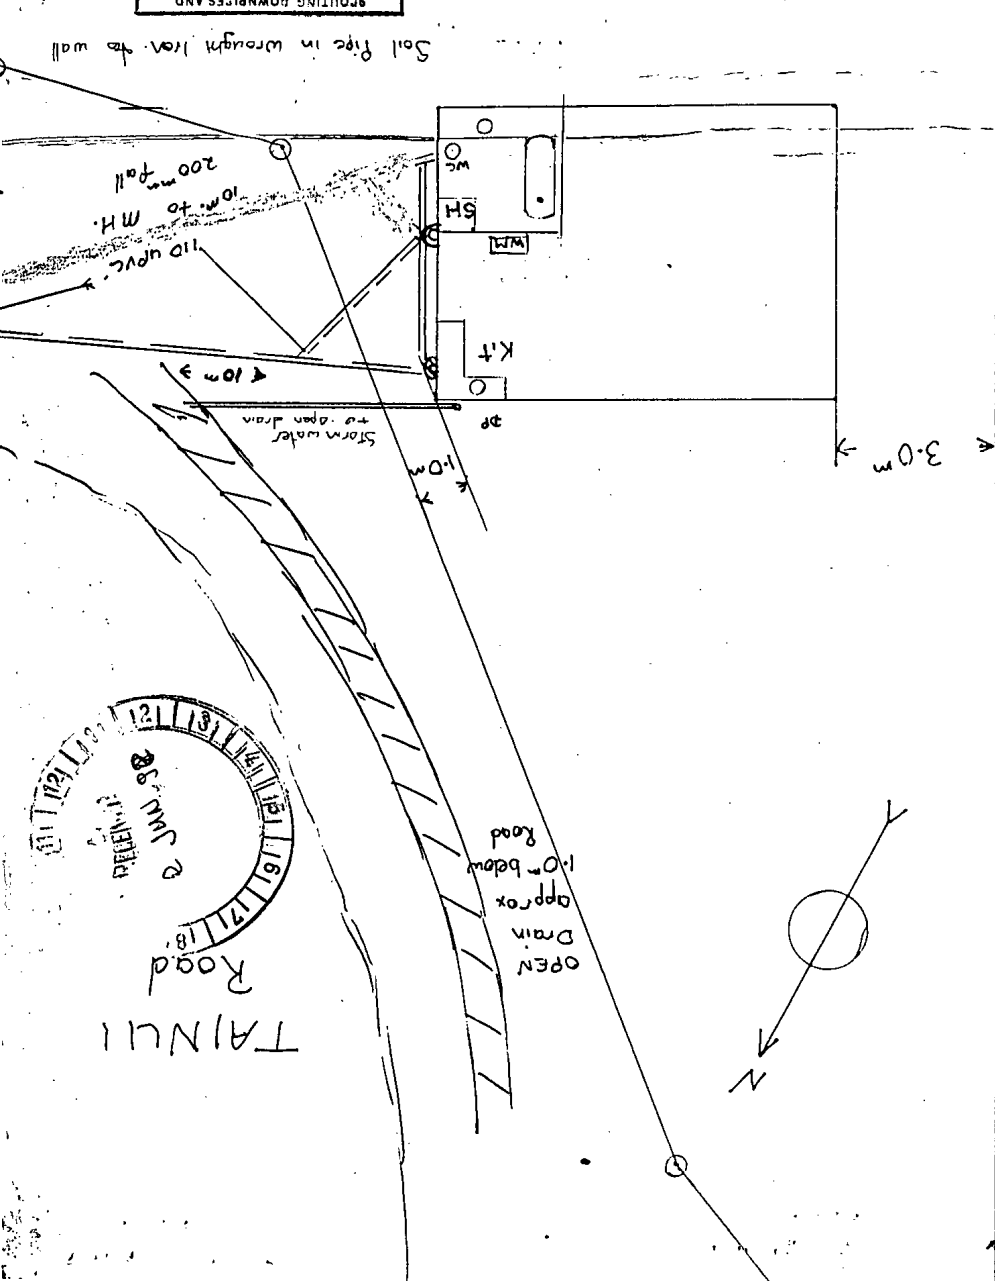

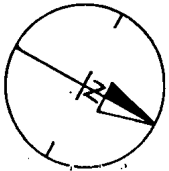

NOTES

1. Base information from Lane Priest Architects Site Plan ref 625

WM origin of levels Lane Priest Architects Site datum 20.000 4.3

Belu

TAKU ROAD

18

19

20

A	Amend No	Description	ckd	date
A		Proposed dwelling location amended.	22/3/92	

KEY




Topographic contour (m)

Top of bank

Scarp

Graphic Scale

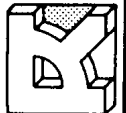

Prepared by
RILEY CONSULTANTS LTD
P.O. Box 100253
NORTH SHORE MAIL CENTRE

For
Mr K. Heathcington

Scale 1:100
Drawn BB/BA
Checked

SITE INVESTIGATION
33 Tairua Rd Titirangi

Site Plan

Drawing No

91142-1A

Date OCT 1991

REGULATIONS 1978

ALL PLUMBING &
DRAINAGE WORK TO COMPLY
WITH DRAINAGE & PLUMBING
REGULATIONS 1978

APPROVED PLUMBING & DRAINAGE INSPECTOR
DATE: 4/6/92
LUMBER AND DRAIN LAYER MUST CONTACT THE SANITARY INSPECTOR BEFORE COMMENCING WORK

SPOTTING LUBRICANTS
STORING WATER SUPPLIES
PROVIDED TO INSPECTOR
OF THE INSPECTOR

NOTE: ONE / SANITARY PLUMBING FITTINGS INCLUDING DUAL FLUSH WATER CLOSETS, APPROVED BY COUNCIL A/E TO BE INSTALLED.
--

Front row of Piles 175 SED
Poles concrete encased in
400mm Ø Hole founded
2.0 m min. into competent
Rock.

PROPOSED
DWELLING

1.0m

3.0m

Bay

OK 3m

WB

WB


WB

WB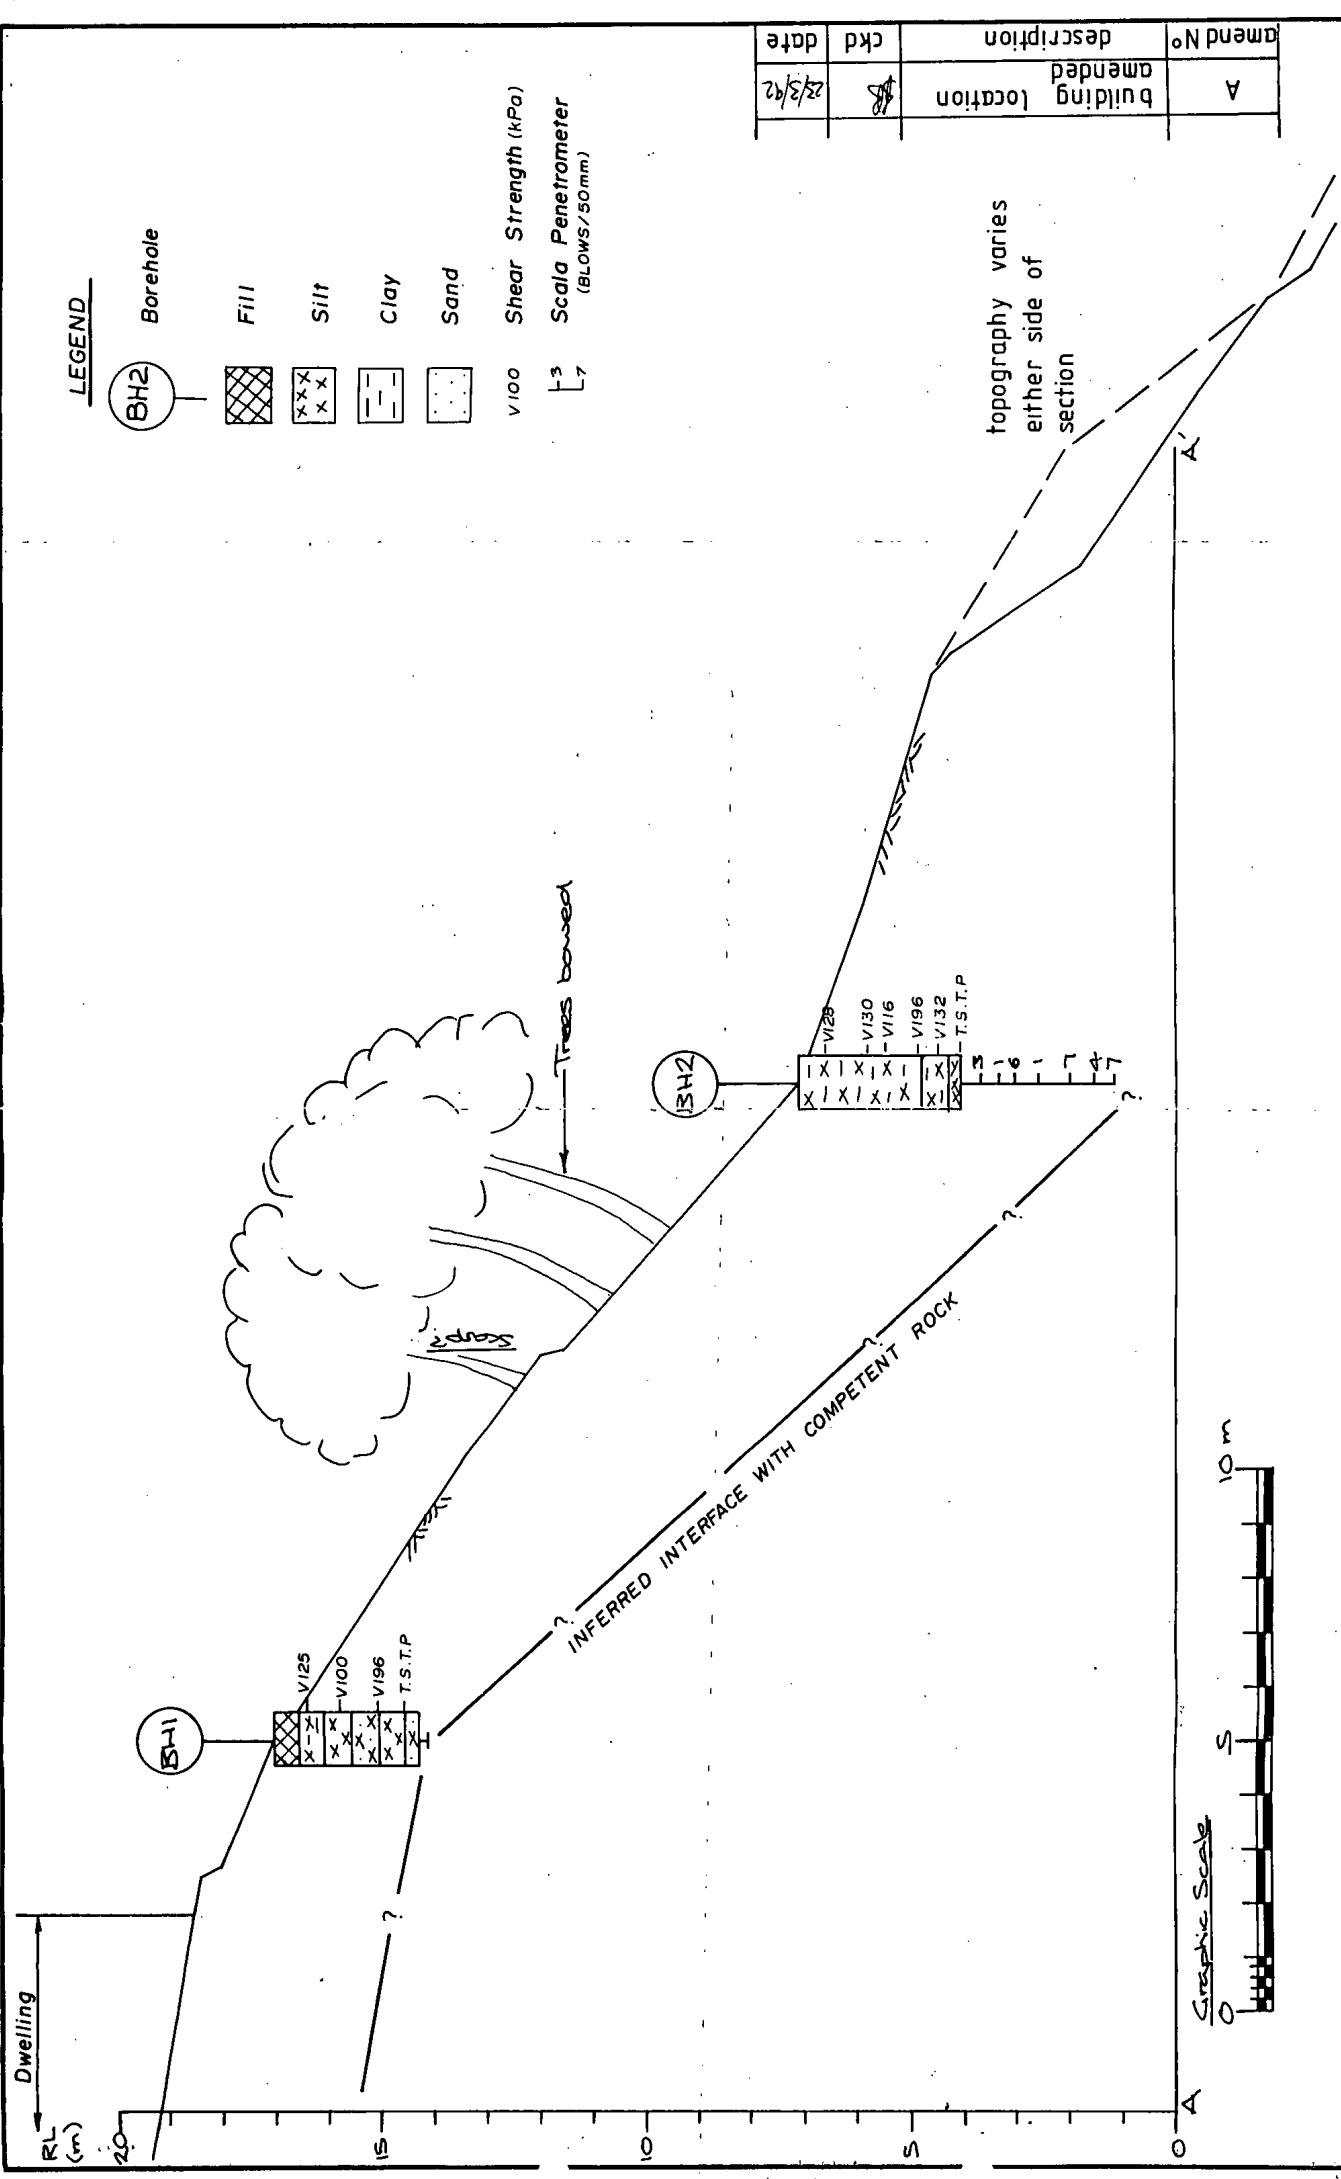

LEGEND

- Borehole
- Fill
- Silt
- Clay
- Sand
- Shear Strength (kPa)
- Scala Penetrometer (BLOWS/50mm)

amend No	amended	description	ckd	date
A		building location		23/3/92



Drawing No.	91142-2A
Date	OCT 1991


SITE INVESTIGATION
Tairua Rd Tairua
Cross Section A-A'

Scale	1:100
Drawn	BB/PA
Checked	BB

For
Mr K. Heatherington

Prepared by
RILEY CONSULTANTS LTD
P.O. Box 100253
NORTH SHORE MAIL CENTRE

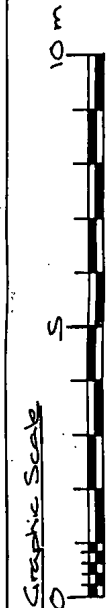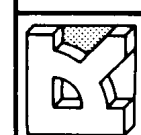

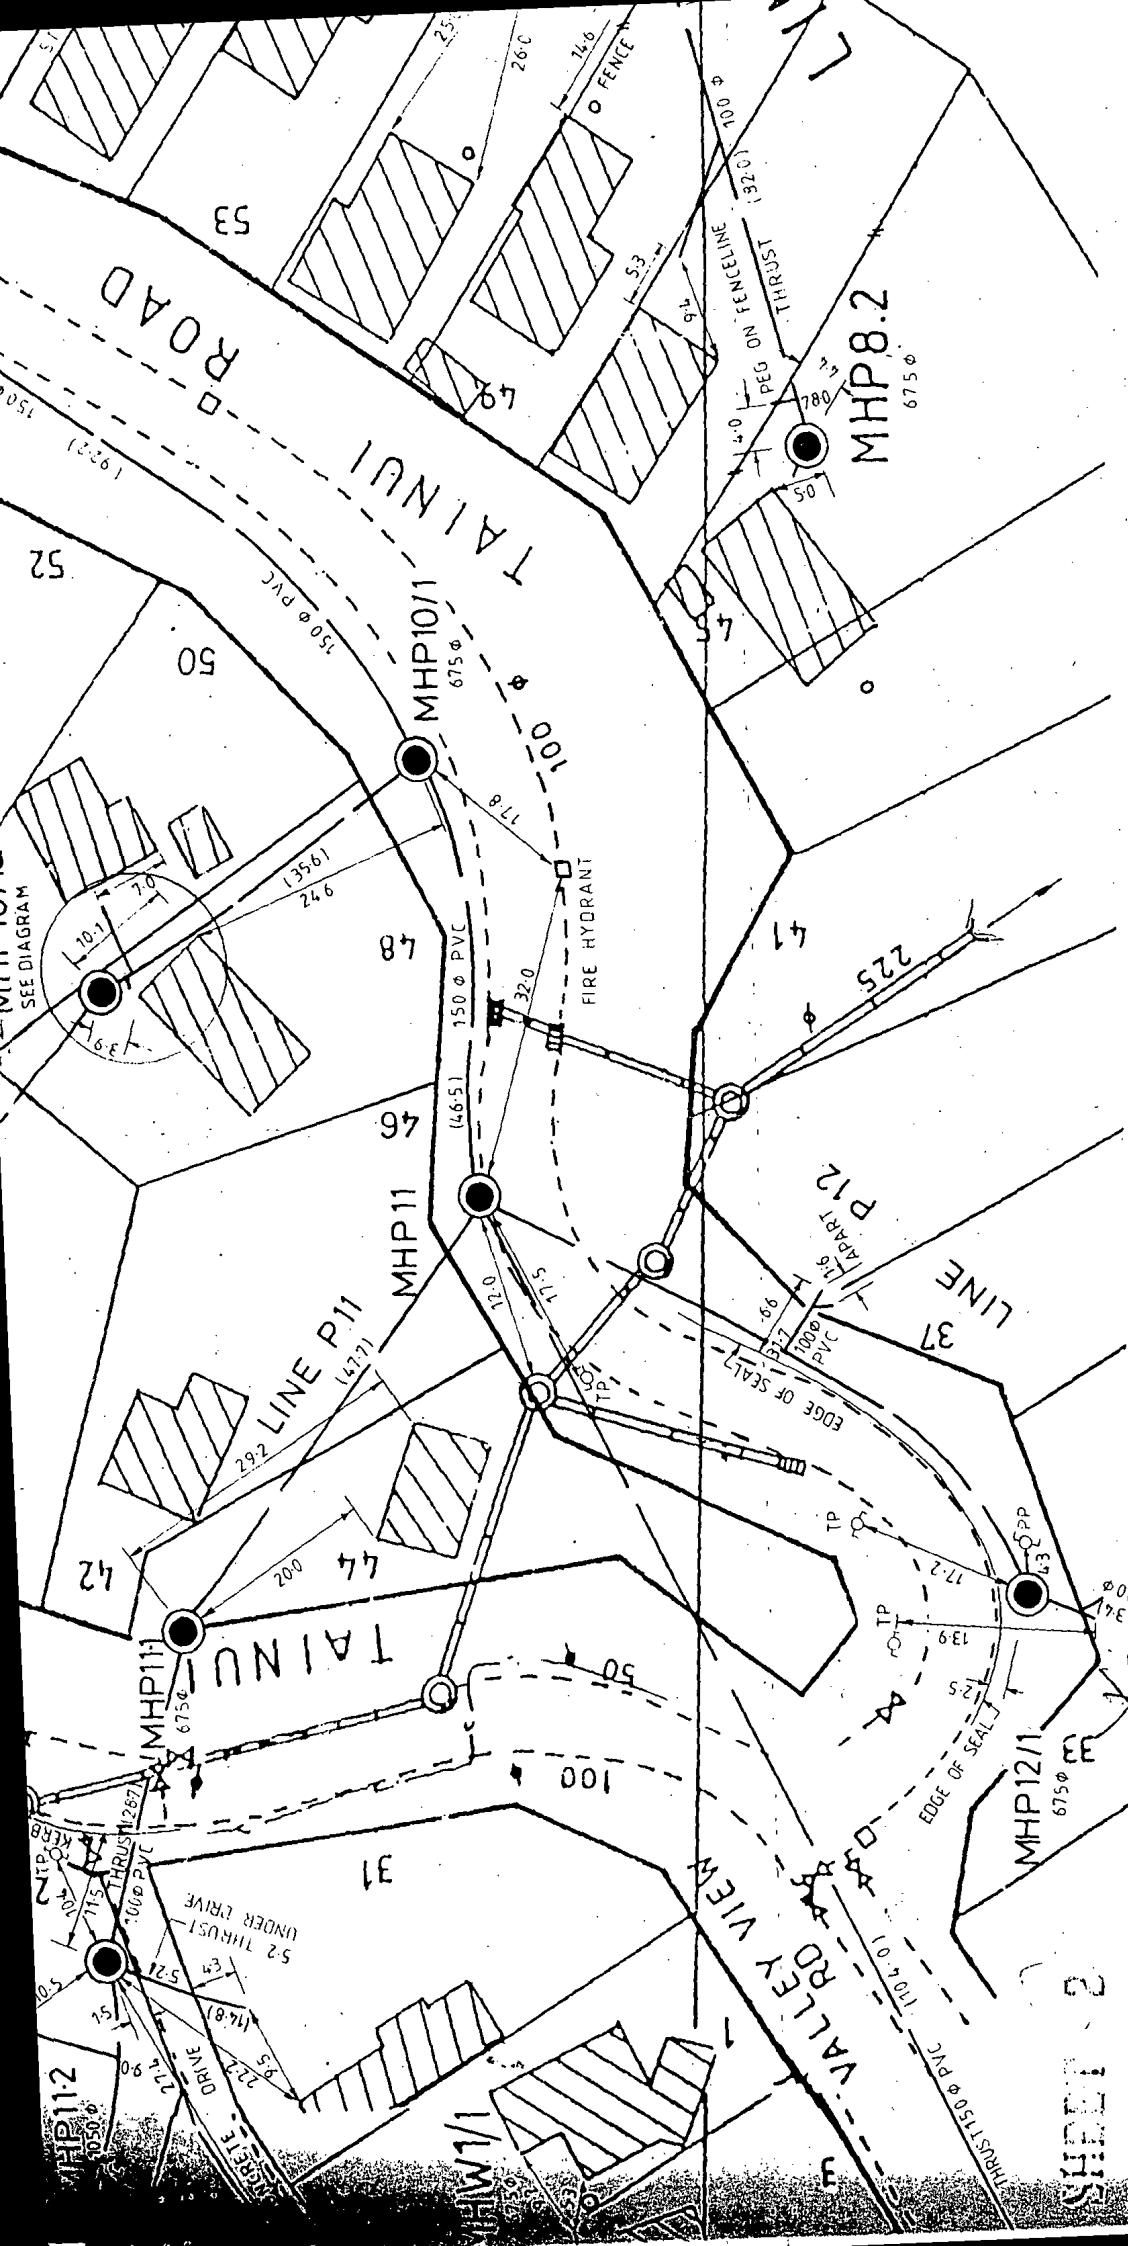

DATE		AMENDMENTS		DATE		WORKS MANAGER	
		AS BUILT DATA ADDED					
		A & S CONSULTANTS (A/ELLS)			2/190		

WAITEMATA CITY
 SOUTH TITIRANGI SEWERAGE
 WAIMA B
 AS BUILT