



Approvals

REGD. PROPRIETORS

LESSEE

PURSUANT TO SECTION 314 OF THE LOCAL GOVERNMENT ACT 1974 I HEREBY CERTIFY THAT FLAT '1' HEREON WAS CONSTRUCTED BEFORE 1 APRIL 1979 AND WAS PROVIDED WITH SUCH SAFEGUARDS AGAINST FIRE AND MEANS OF ESCAPE IN CASE OF FIRE AS WERE REQUIRED BY THE BY-LAWS OF THE BOROUGH COUNCIL APPLYING ON THIS DATE.

DATED THIS 3 DAY OF Feb 1987

AUTHORISED OFFICER

BOUNDARIES OF AREAS TO BE LEASED ARE CENTRE OF INTERNAL WALLS (FLOORS & CEILINGS) AND THE EXTERNAL FACES OF EXTERIOR WALL STRUCTURES AND ROOFS UNLESS SHOWN OTHERWISE.

NOTE: AREAS MARKED 'A' TO BE SUBJECT TO A RESTRICTIVE COVENANT

Total Area

Comprised in C.T. 2C/849

I, Selwyn Raymond Colwell LIGHT
Registered Surveyor and holder of an annual practising certificate (or who may act as a registered surveyor pursuant to the proviso to section 33(2) of the Surveyors Act 1966) hereby certify that Flat 1 shown hereon is erected in the position shown and is situated within the boundaries of C.T. 2C/849 and the plan is correct.

Dated at MOTUEKA this day of 19 Signature

Field Book p. Traverse Book p.
Reference Plans


Examined Correct

Approved for the purpose of leasing flats only.

/ / Chief Surveyor

Deposited this day of 19
For the purpose of leasing flats only.
District Land Registrar

File
Received
Instructions

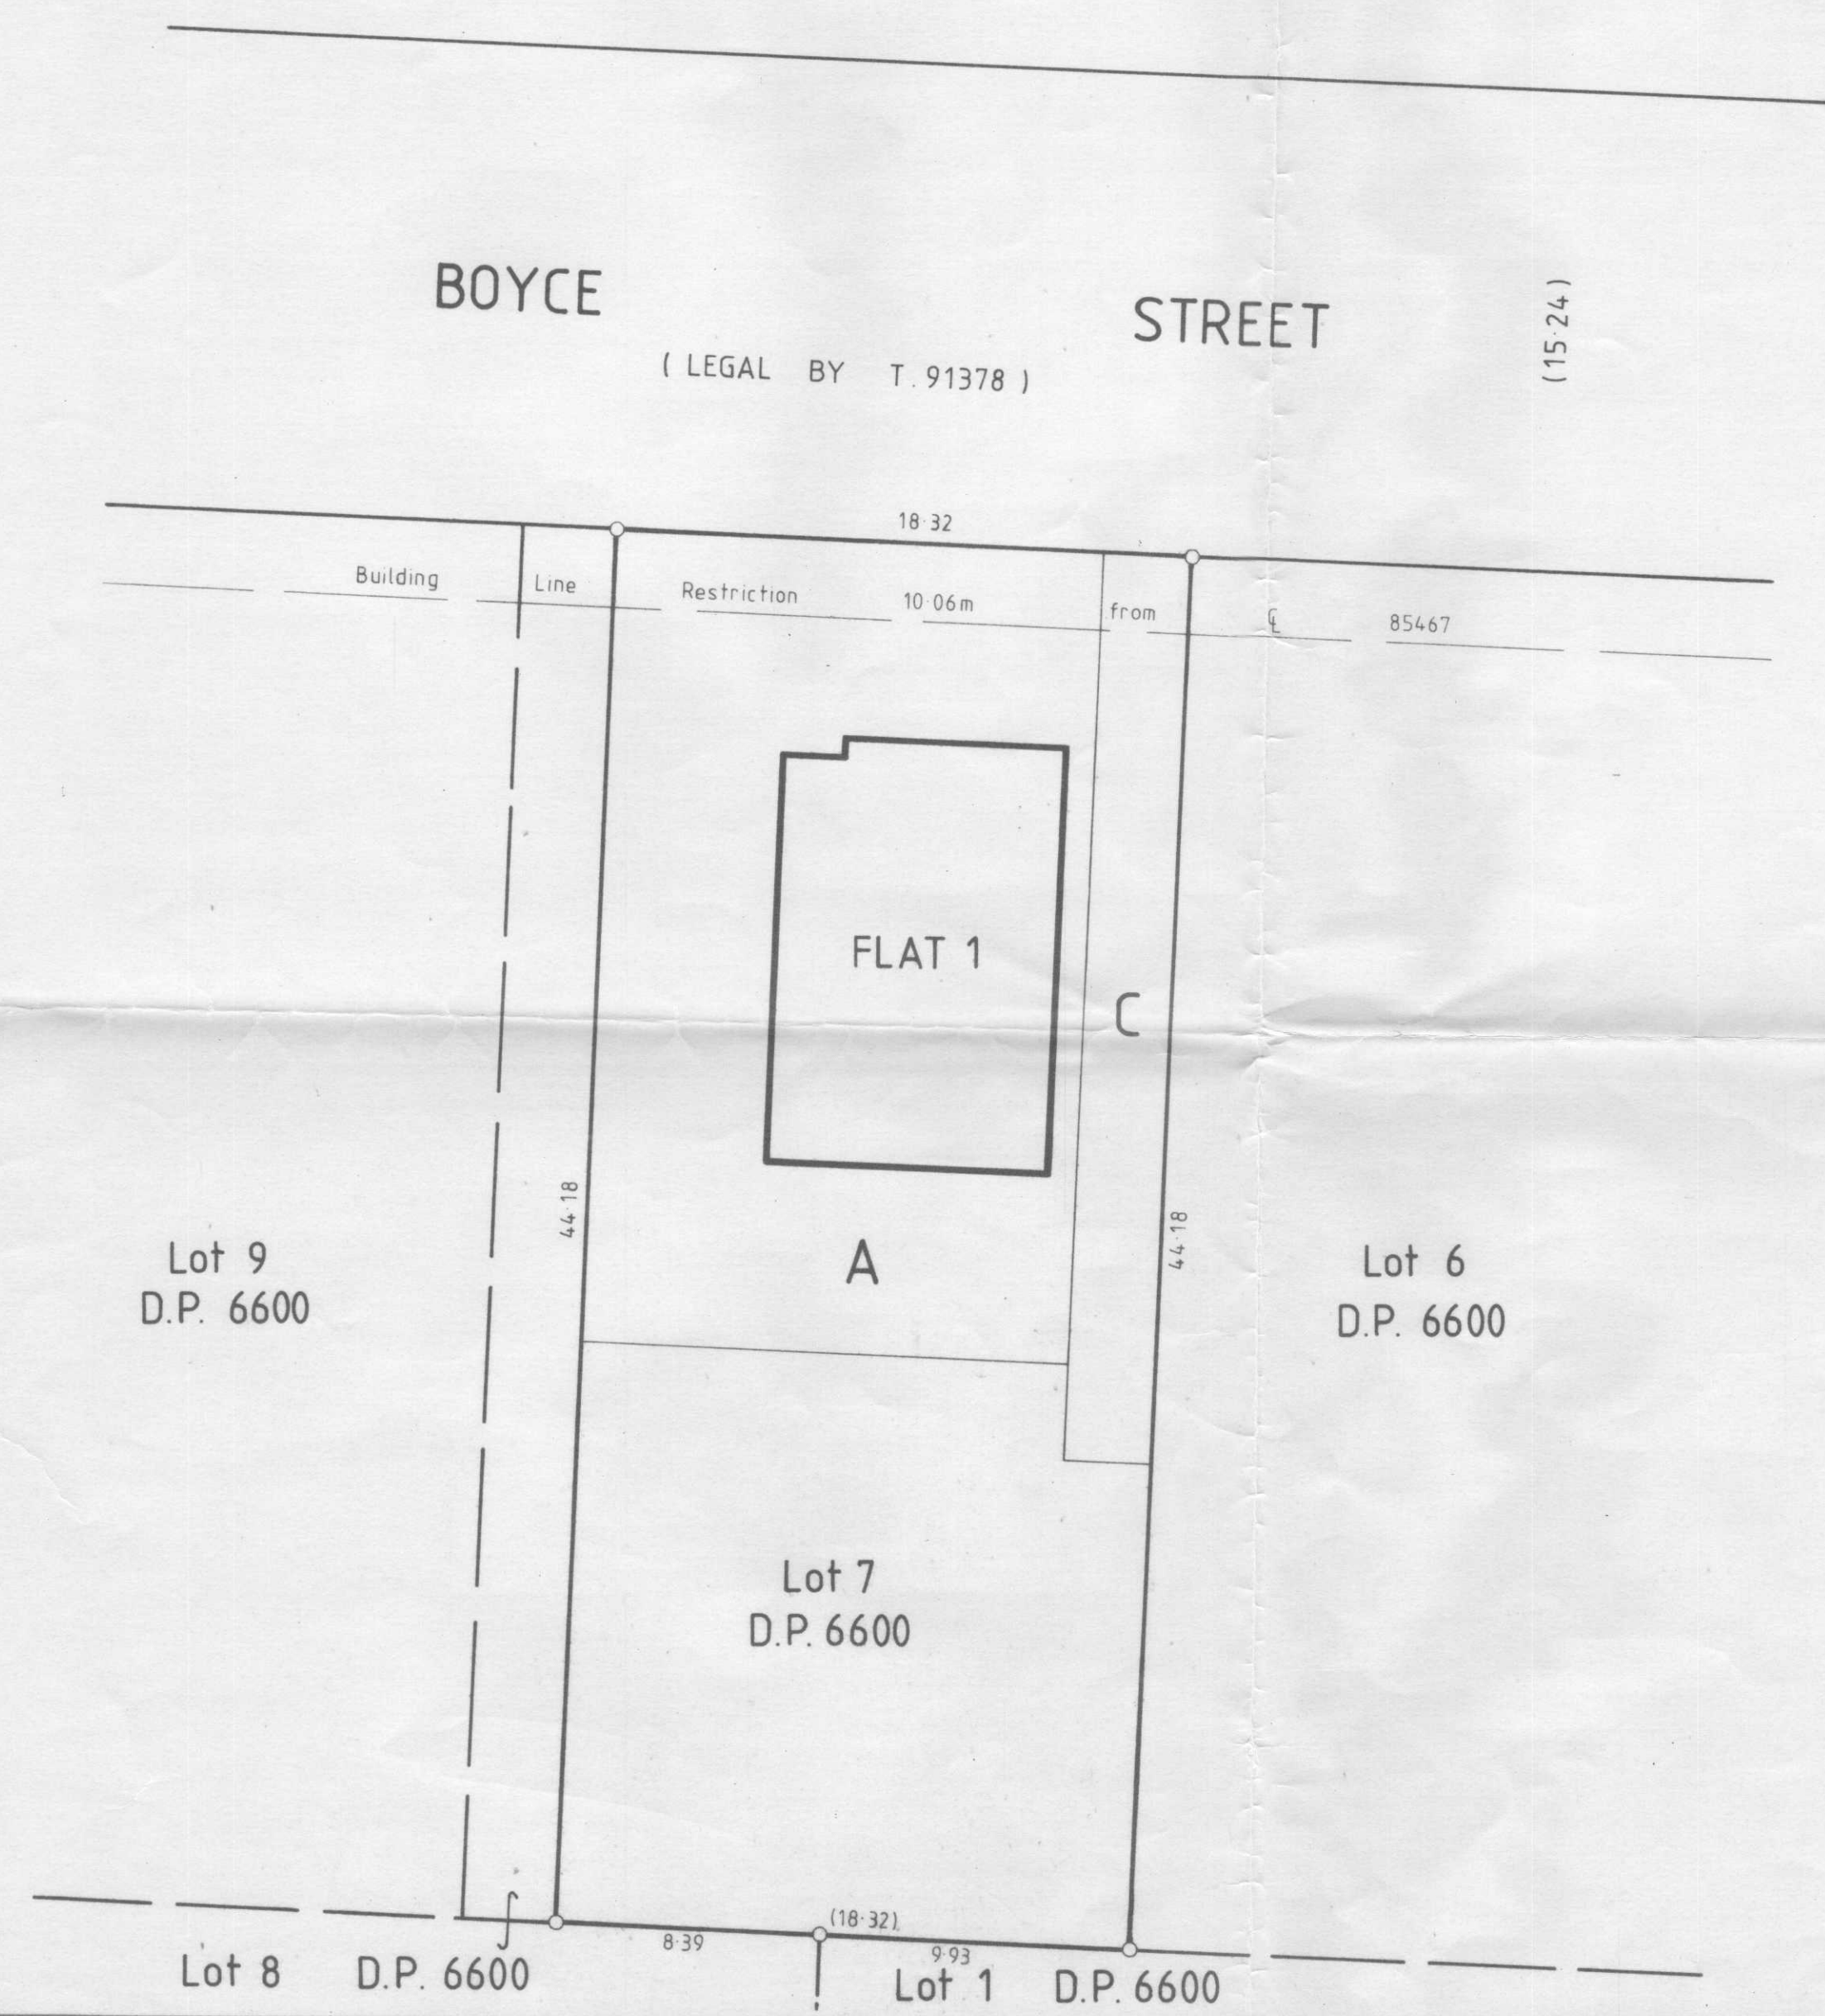

LAND DISTRICT Nelson
SURVEY BLK. & DIST. IV Motueka
NZMS 261 SHT N. 26 RECORD MAP No 43-39

FLAT 1 ON LOT 7 D.P. 6600

TERRITORIAL AUTHORITY Motueka Borough
Prepared by Cotton & Light 1381
Scale 1:200 Date December 1987