



BOROUGH OF TAURANGA

Plumbing, Drainage and Water Service Block Plan

All Buildings and Drains to be drawn to the scale of 1/8" or 1/16" = 1 ft. and to have all measurements shown.

New Drains in Solid Red Line
Old Drains in Dotted Red Line
Stormwater Drains in Green
Water Connection in Blue (show to 1st branch off service pipe)

REFERENCE.—G.T. means Gully Trap
T.V. means Terminal Vent
B.V. means Back Vent
I.P. means Inspection Pipe
I.C. means Inspection Chamber
F.A.I. means Fresh Air Inlet
T.B. means Toby Box

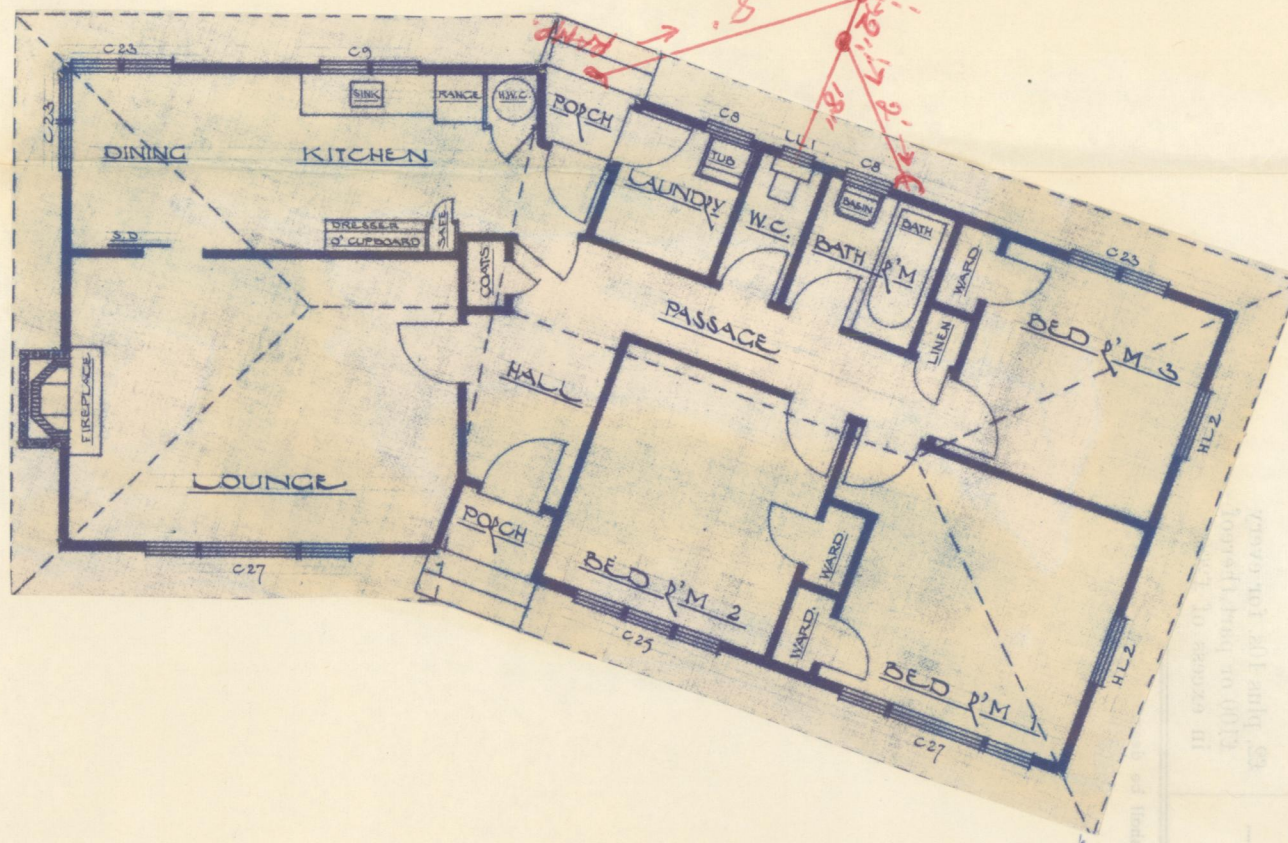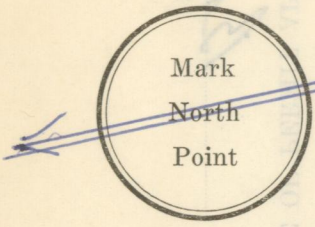

ROAD FRONTAGE (State name of Street, Road or Avenue)

TC547922

