



RRD001PCZV

Document Number: RDC-186494

Date Registered: 21/04/2011

BUILDING UNIT

## AS BUILT DRAINAGE PLAN

5646

Street: NIKAU No: 34

Lot: 130 DPS: 392624

Owner: Patterson

Drainlayer: N. Morris

Inspector: Mr Lamb


Reg No: 0-7935

Date of Inspection: 24/11/10

Consent No: 85805

## DRAINLAYER PLEASE FILL IN ALL DETAILS

The building consent must be onsite for all inspections.

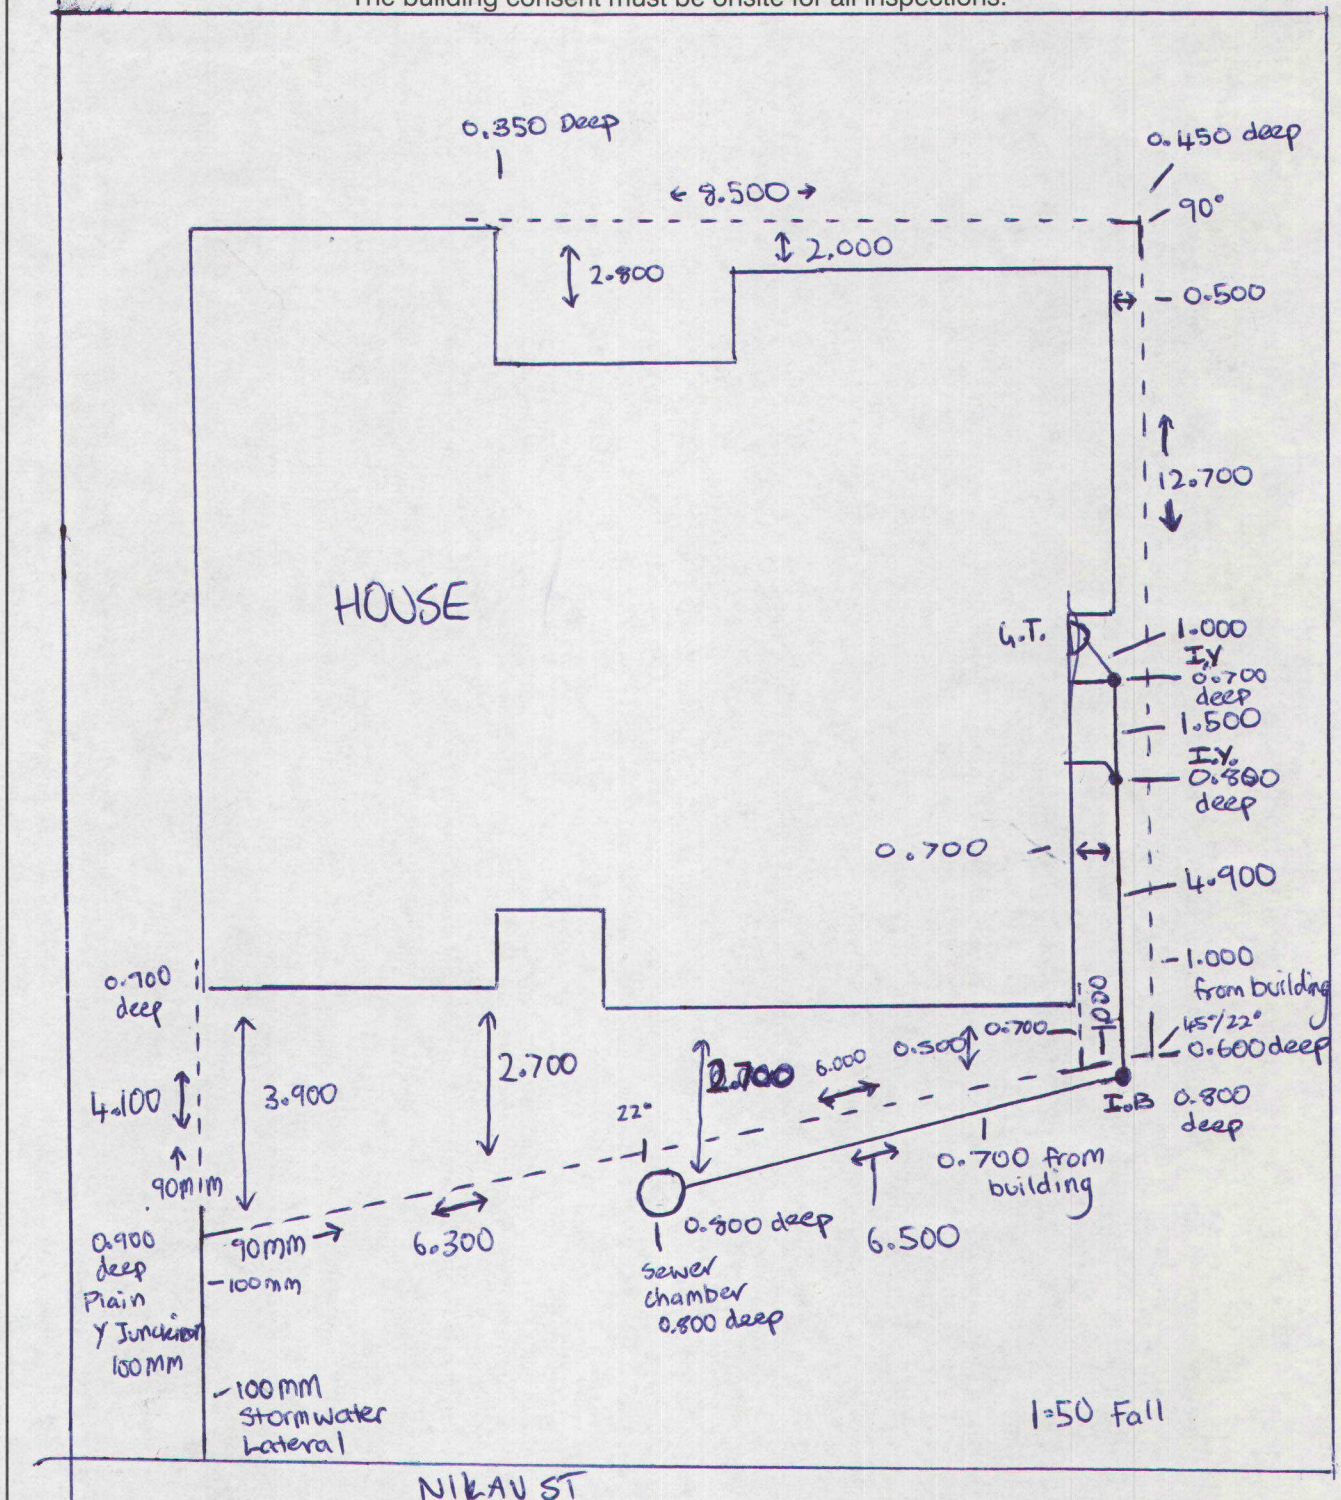

Drainlayer's Signature:

Date: 24-11-10