

DESTINATION ROTORUA ROTORUA DISTRICT COUNCIL	ROTORUA DISTRICT COUNCIL APPLICATION FOR WATER CONNECTION	Water Application No: <u>21595</u> Valuation No: <u>06533/171.00 PT</u> Water Supply: <u>Control.</u>
--	--	---

SECTION 1 APPLICANT TO COMPLETE - Please Refer to Notice on Reverse

Name of Property Owner/Company NZ Sems Ltd

Street Address (new connection to be installed) Crn 18 Salisbury St and Neil Road

Postal Address (*note 1 - see bottom of page) P.O. Box 10088

Name & Address for Metered Accounts Rotorua

(if different to above)

Full Legal Description (Lot No, DPS, SD, Blk No) Lot 1 DP 34509 Part Lot 1

Day Time Contact Name and Phone No _____

Reason for Connection Redevelopment new home supply

(new house, subdivision, separating services etc)

What is the purpose of connection

Domestic ☒ 0m²-2000m² Domestic ☐ over 2001m² Commercial ☐ Industrial ☐ Agricultural ☐ Fire Supply ☐

Is the property already supplied with water (Y/N)

☐ N

Lot 1 HAS OWN WITH CONNECTION
NEEDS NEW CONNECTION.

Were any buildings demolished to which water was supplied (Y/N)

☐ N

Connection Size - ID (specify - standard size is 20mmID)

20

EXISTING CONNECTION IS TO SERVICE LOT 2

Preferred location of the connection (mark on site plan) 19 meters from LEFT RIGHT side of boundary

(note: The left and right hand boundaries are as viewed facing the property from the street) Neil Road

I acknowledge the general conditions on the reverse of this form and hereby make application for the above water connection and agree to meet such fees, water rates, and/or conditions as may apply from time to time in respect to the Rotorua District Council Water Services & Trade Wastes Bylaws 2004.

Signature of Property Owner _____

Date 07/01/08

SECTION 2 OFFICE USE ONLY

CASHIERS

Administration Fee Due \$ 90.00 (Inclusive of GST and Payable on Application)Cashier Receipt No R94148

Recorded by _____

Receipt Date 7/1/08

ACCOUNTING DEPARTMENT

Application noted in Corp.V ☐

Water Billing A/c Opened ☐

Recorded by _____

WB A/c No _____

Date 1/1/

Consumer Class No 11

ENGINEERING DEPT

Scheme Contribution req'd ☐

Amount \$ _____

Additional Connection Requirements

☐ Meter (Size) _____

☐ Backflow Preventer (Medium/High) _____

☐ Flow Restrictor (litres/min) _____

CONNECTION

Approved ☒On Hold ☐Declined ☐

DRAWING OFFICE

CHECKED HANSEN: _____

Plan No 12-8-8

If required

Designation CHECKED G.I.S.Date 17/1/08

Signed by _____

Signed _____

Date 1/1/

As Built records updated by _____

Signed _____

Date _____

Water Service Provider: _____ Intended Date of Installation: _____

*note 1: The Approved Water Service Provider information will be sent to this postal address - if you want the information to go to a builder/plumber or other persons please enter their postal details.

Application No.
21595

APPROVED WATER CONNECTION DETAILS/RECORD SHEET

DESTINATION
ROT@RUA
Rotorua District Council

PROPERTY DETAILS

Applicant Name **NZ GEMS LTD**
Installation Address **18A SALISBURY ROAD**
Legal Description **Lot: PROPOSED LOT1 - DPS: 34509**

SERVICE CONNECTION DETAILS

Approval Date **17/01/08**

(application valid for 90 days from approval date)

Installation Date **17/1/08**

Watermain/Rider Size **100** mm ID Type **AC** Depth **0.900** Dist. to Bdy **3.410**
Service Line Size **20** mm ID Type **MDPE** Length **2.9M**

Water/Rider Main IDs

Hansen ID									
WN	0	1	0	7	1	5			
WL	0	0	0	5	8	7			
WL	1	6	1	9	6	6			

CONNECTION INFORMATION

Toby/Manifold Size **20 mm ID** Type/Brand **Acu flow**

Preferred Location: **19 METERS FROM RIGHT SIDE OF BOUNDARY**

Actual Location: **13.8** mtrs LHS / RHB **0.350** mtrs Inside Bndry / Outside Bndry

Dimensions


*note: All measurements must be taken from a legal boundary peg.

Pressure **550** (K/Pa) Flow **36** (l/min)

(Pressure & Flow must be recorded prior to the installation of any flow restrictor)

Time **2 : 50** pm

(Please record time pressure & flow was taken)

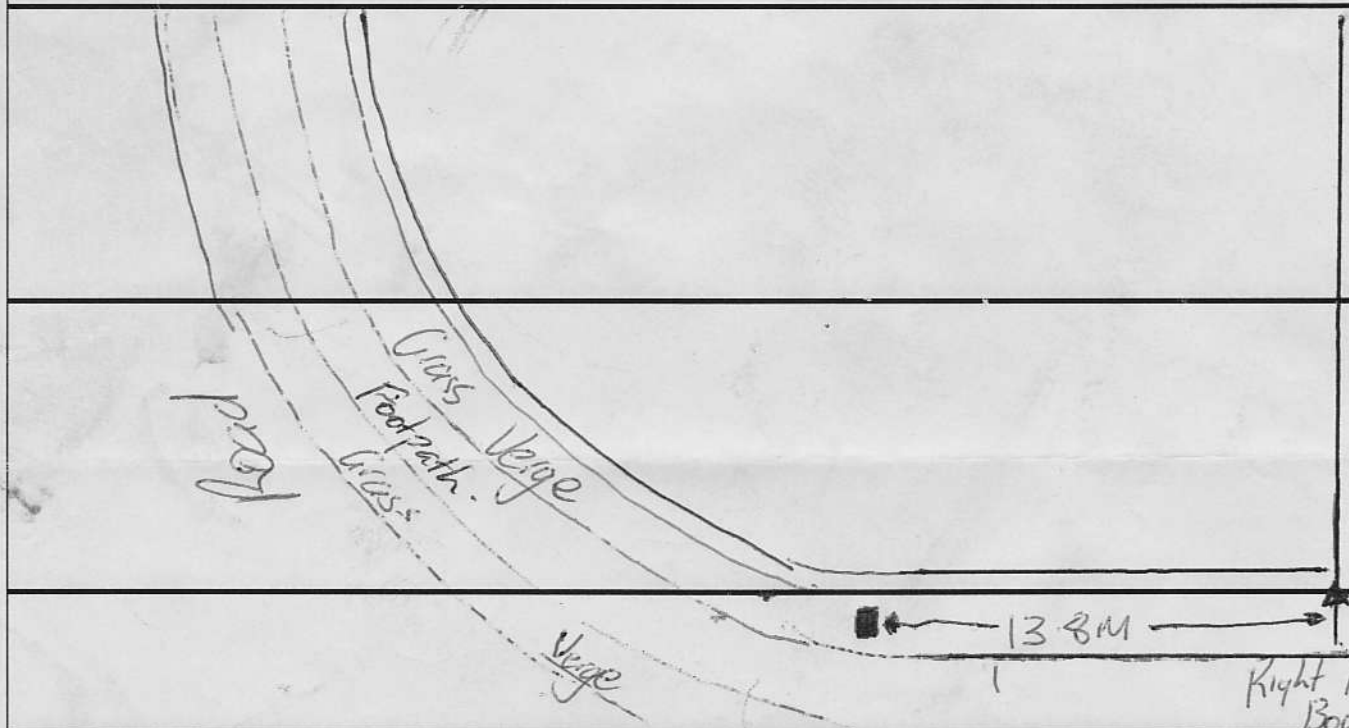

PLEASE SUPPLY A SITE DRAWING (see over page..)

CERTIFICATION

I certify all the information on this form as being complete and correct, and that all materials and works are in accordance with the specifications for connections as all relevant documents.

Name **JONATHAN LEWIS** Signed **[Signature]** Date **17.01.08**

Water Service Provider Name **Backflow Prevention Ltd.**

Total Value of

(GST Exclusive)

Road Opening
Notice
required? ☒