
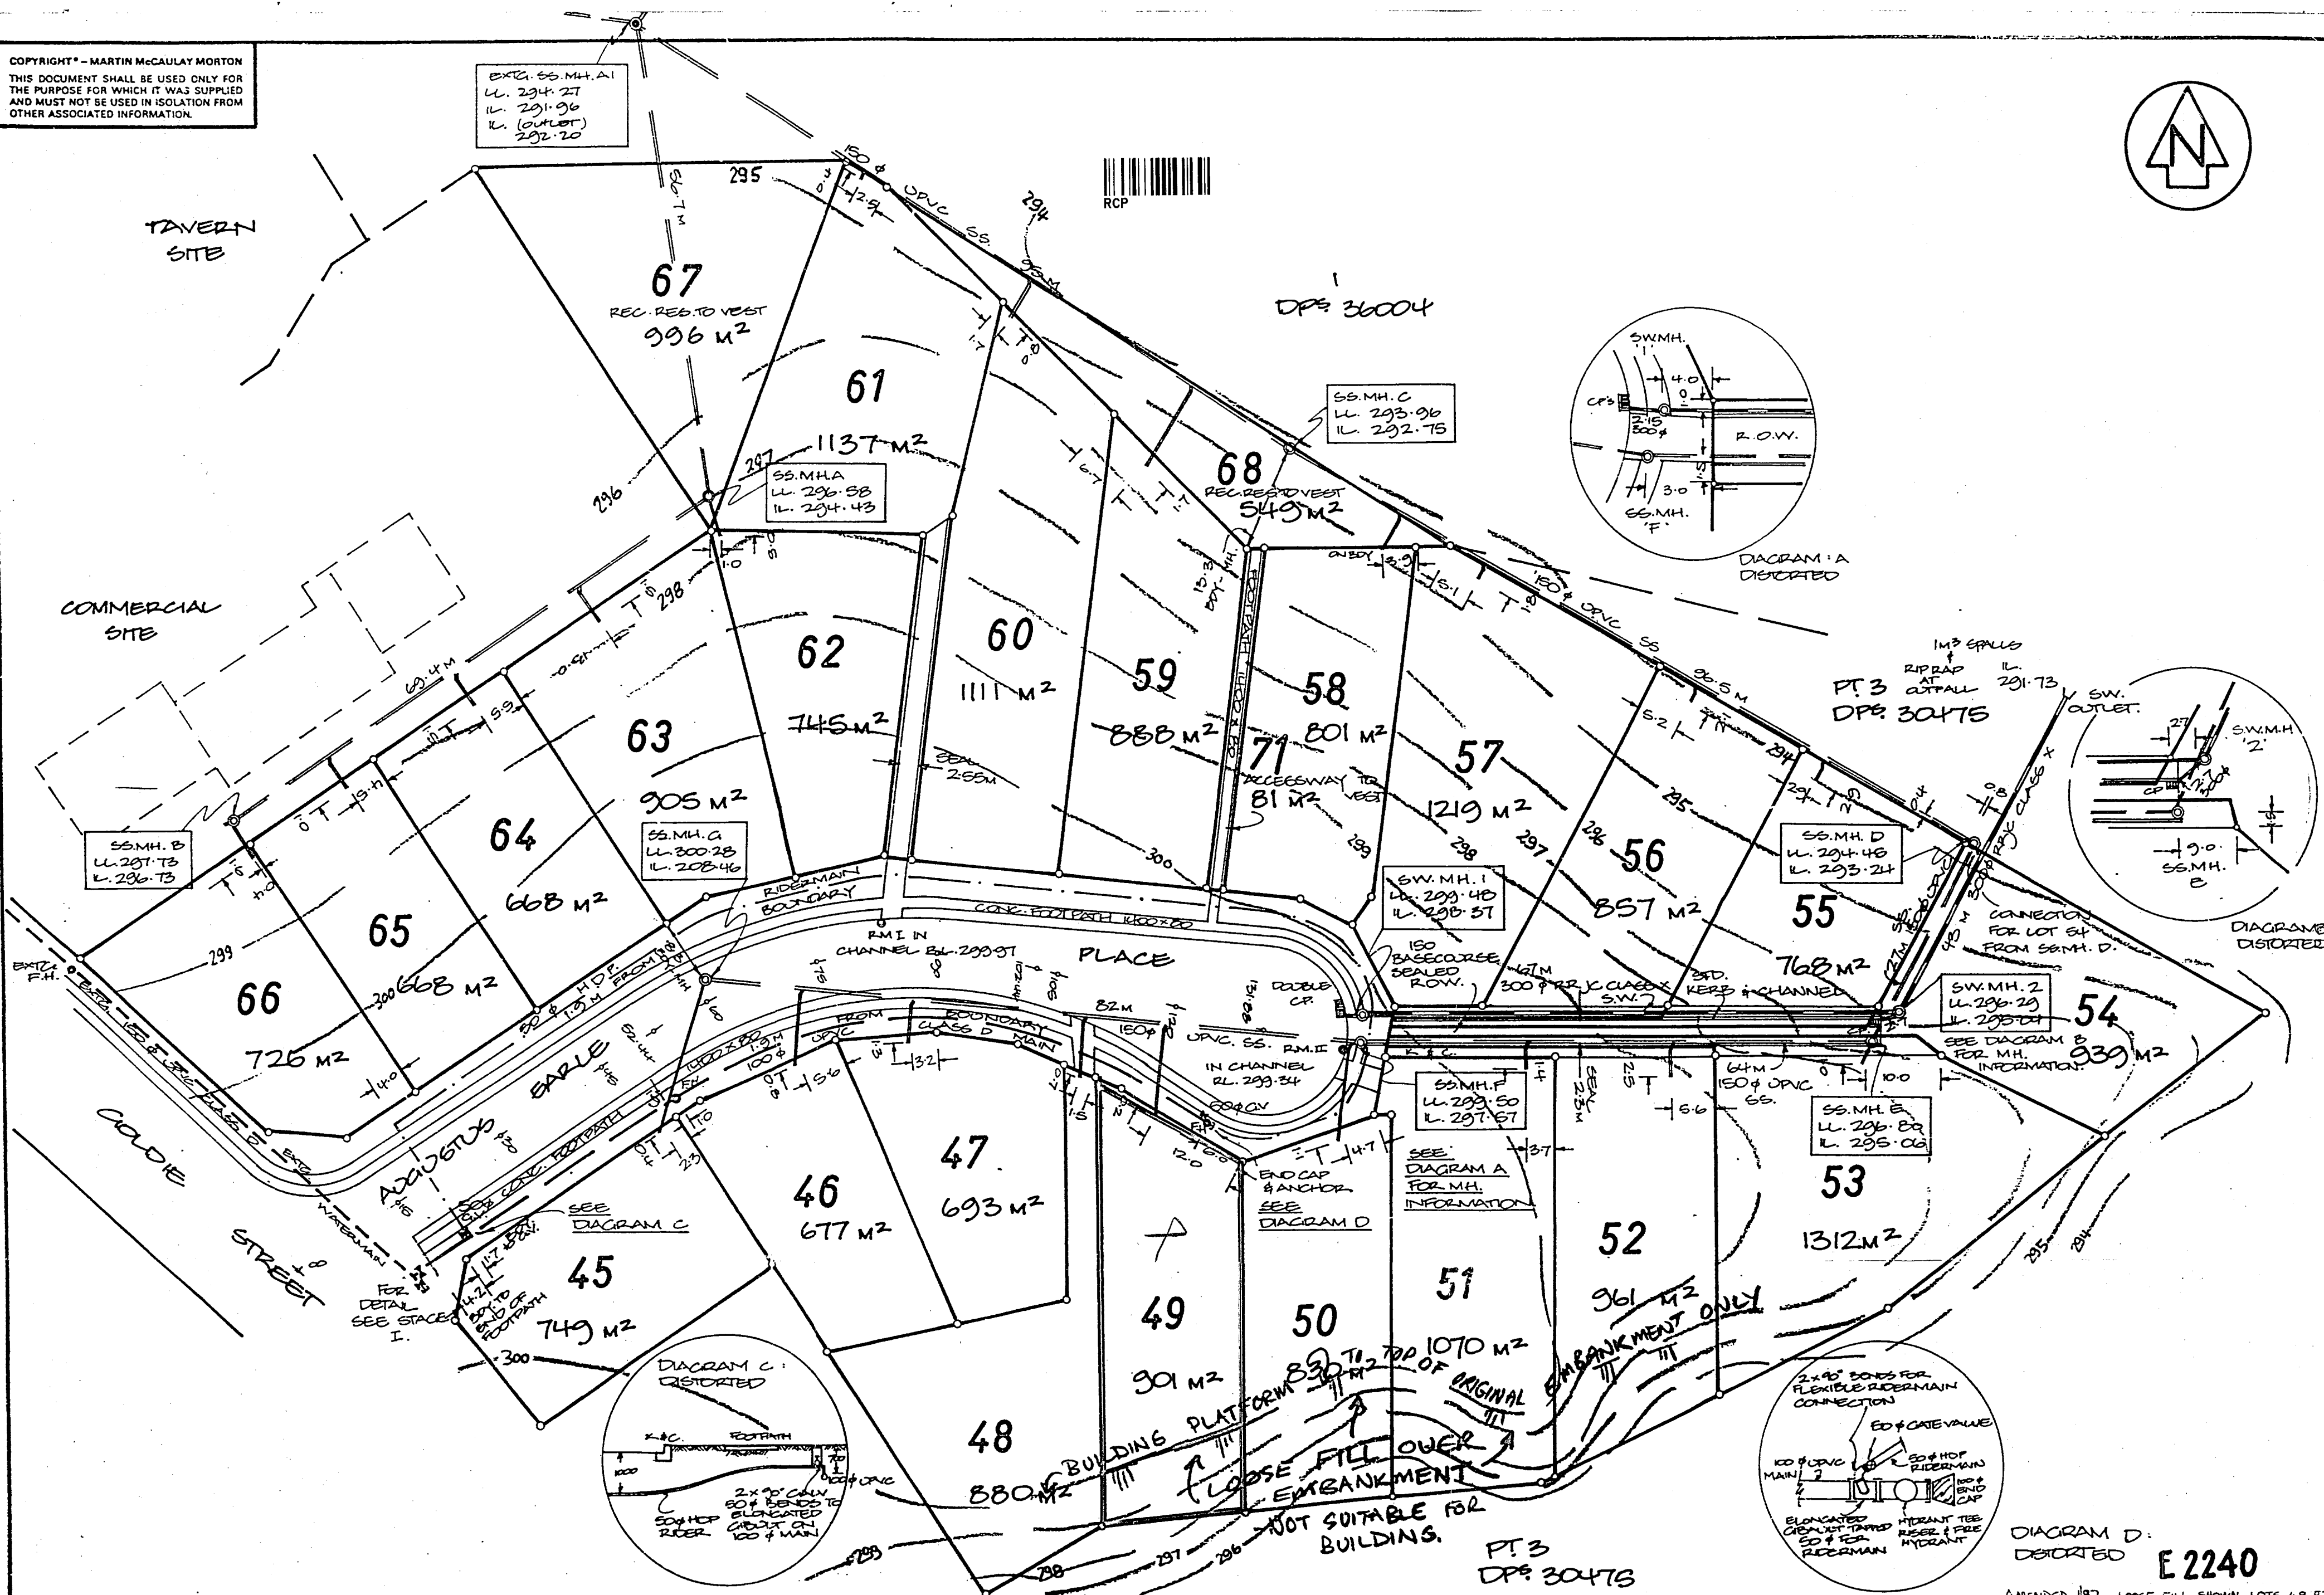


COPYRIGHT © - MARTIN McCaULAY MORTON
THIS DOCUMENT SHALL BE USED ONLY FOR
THE PURPOSE FOR WHICH IT WAS SUPPLIED
AND MUST NOT BE USED IN ISOLATION FROM
OTHER ASSOCIATED INFORMATION.

EXG. SS.MH. A1
LL. 294.27
IL. 291.96
IL. (OUTLET)
292.20

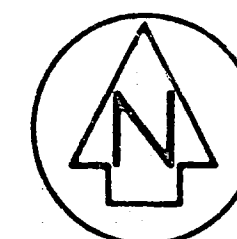

MARTIN McCaULAY MORTON
REGISTERED SURVEYORS CIVIL ENGINEERS TOWN PLANNERS

QUADRANT HOUSE
77 KAMPAPA STREET
DUNEDIN
P.O. BOX 978
PHONE (077) 477-640

PROFESSIONAL CHAMBERS
BLUETT STREET
DUNEDIN
P.O. BOX 96
PHONE (077) 86-127

CHIEF BUILDING
77 JULIODE STREET
TE PUKE
P.O. BOX 301
PHONE (078) 27-717

SUITE 5
89 DUNLOP STREET
DUNEDIN
PHONE (078) 384

subdivision of Pt Lot 3 DP# 30475
AS BUILT PLANS : roading , water supply,
stormwater & sewers.

SCALE
1:500

DATE
RECEIVED
1986

DRAWN
AB

CHECKED
AM.M.

FILE
22144/7
SHEET 1 OF 1

DIAGRAM D:
DISTORTED
E 2240

AMENDED 187 - LOOSE FILL SHOWN LOTS 48-52