



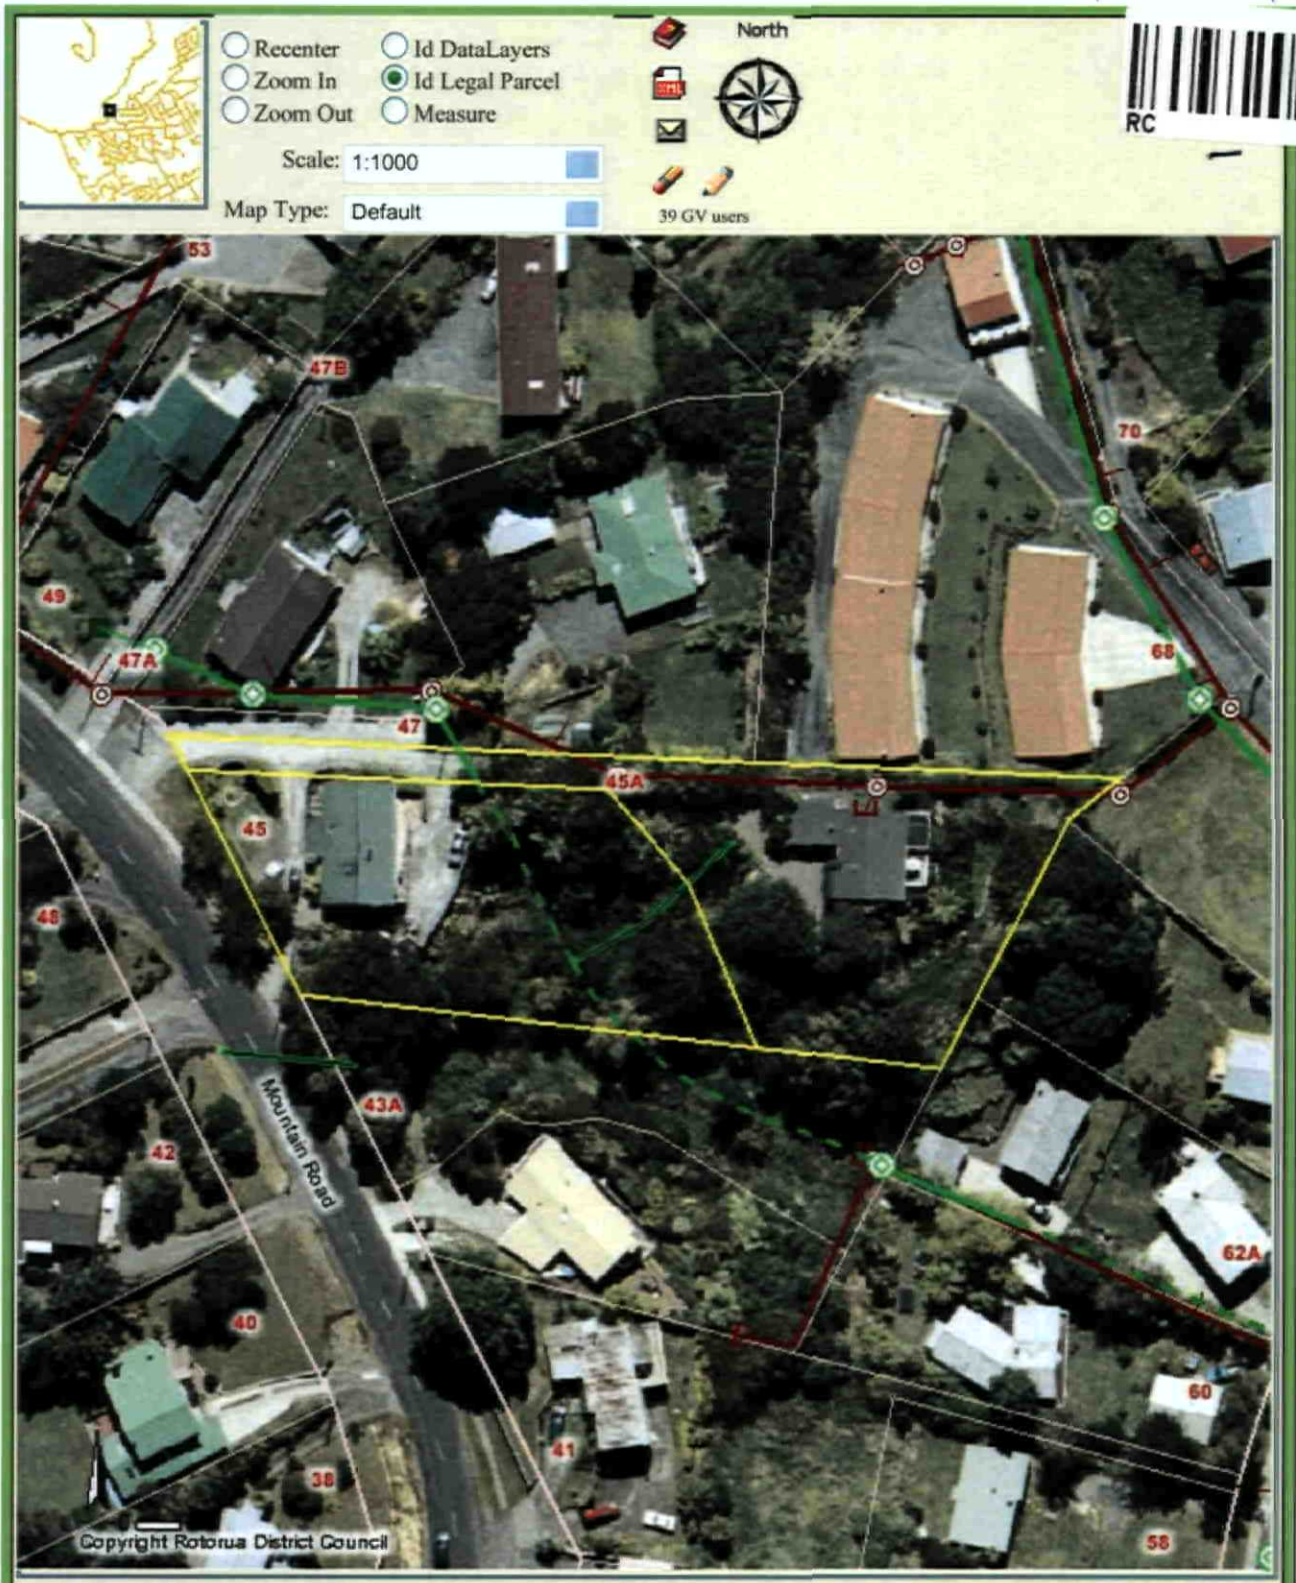

FILE

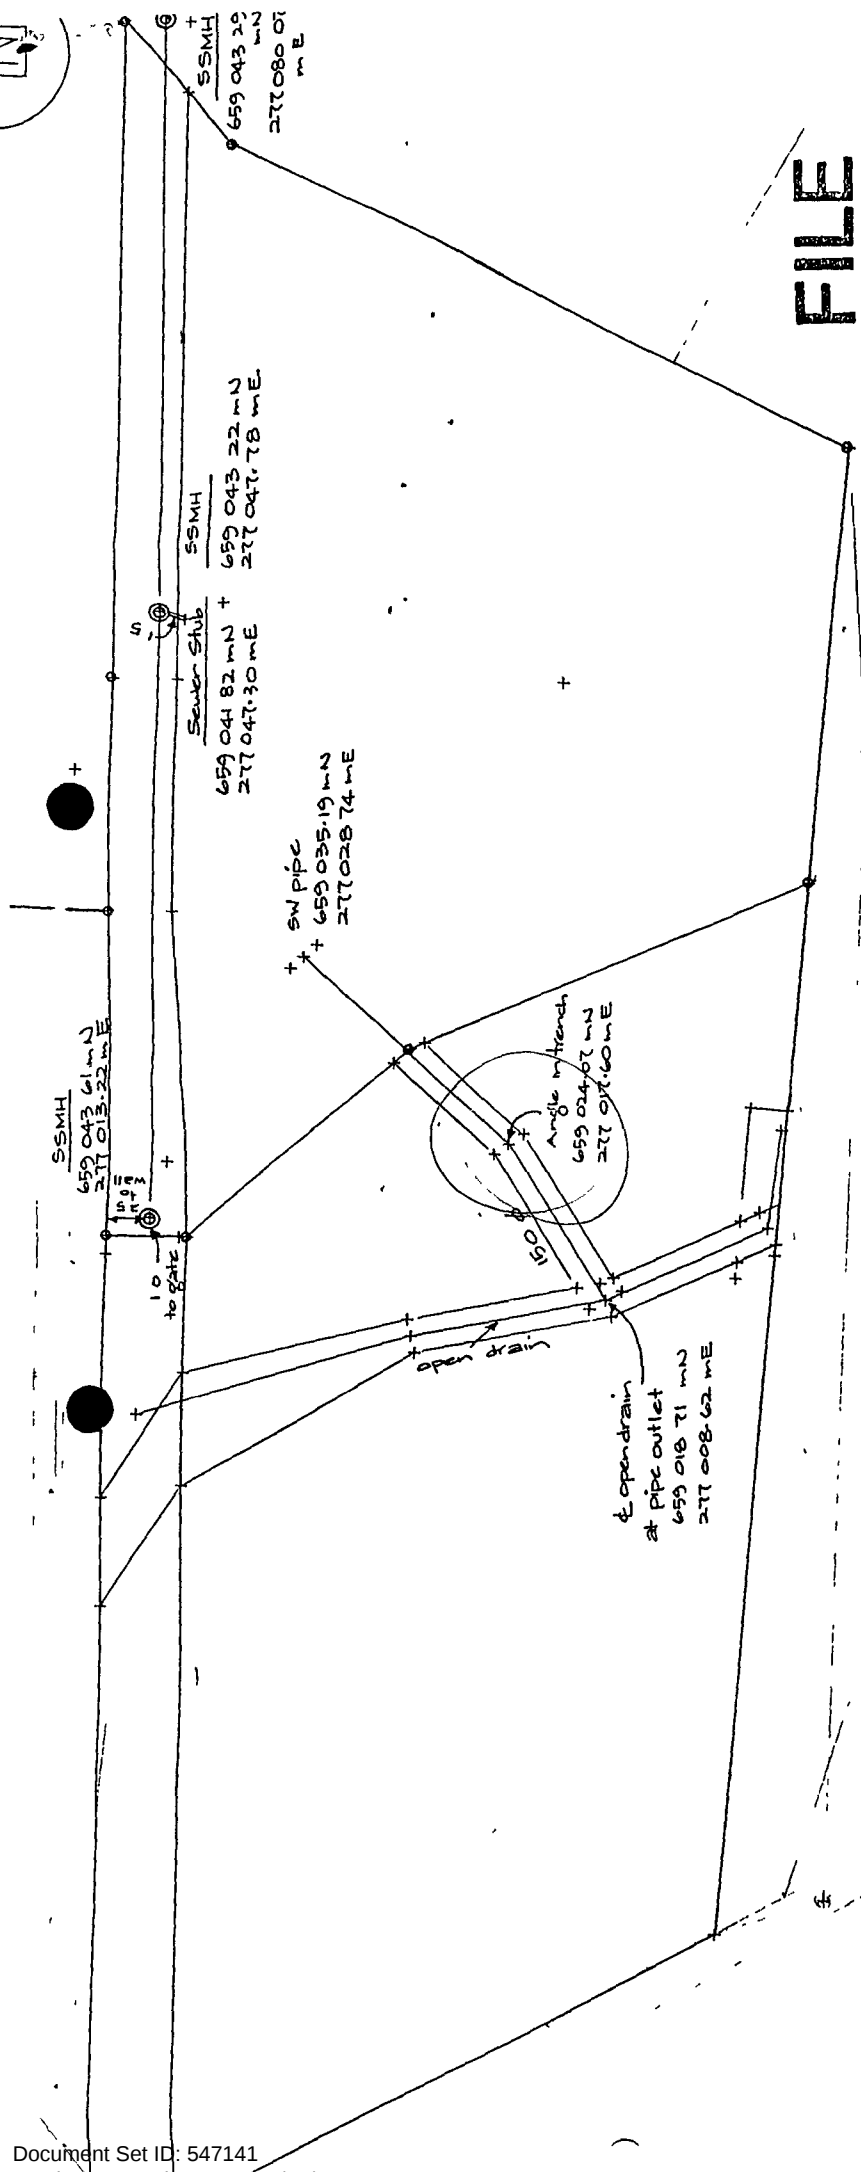

We suggest you edit this to suit your own specific needs and plotter

AS BUILT INFORMATION FOR SUBDIVISION OF LOT 233 DP55333 45 MOUNTAIN ROAD

Scale - 1 300

P26.5-45

P26.5-46

RD

TAUPO

TANGATARUA

LAKE

3 6680
DPS 61460

Grz No 161 pg 3345 8/10/92
Land acquired for recreation Res

205


1
12.1625
DPS 61460

✓ Board 6589/2
✓ No. 6589/205
Old Taupo Road
Lot 1 & 2 DPS 61460

PT 2
0245

[Handwritten signature]

On board 6580/4 (see attached)

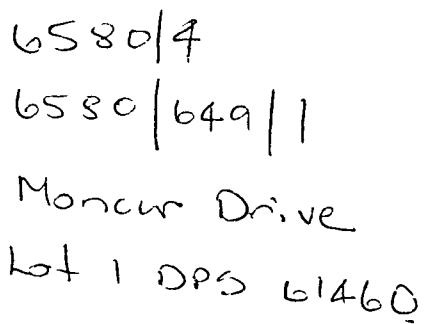

Document Set ID: 547141
Version: 1, Version Date: 09/03/2009