

Date 22-11-76 Locality _____
Sec B1c Lot 16 D.P. 11 Street Trafford
Owner P Shallard
Builder H Walker Plumber E B Hale
Work New Value 3,500
Area _____ Foundations _____ Walls _____ Roof _____
Permit No. Bldg. H12838 Pl. Dr. 7
Remarks Street Connection inspected
26/4/77 - Satisfactory.
Drain tested - satisfactory.
29/4/77.

"As Built" Plan to be submitted
14.2.78

DRAINAGE

Date of Final Inspection 29/4/77
Maximum Number of occupants _____
Occupation Certificate No. D. Morrison

House Connection Plan-Drainage

All drawings must be correct to Scale, in INK, and show Compass direction, load boundaries and all necessary information.

Scale: 1/4" to 1 ft.


To be submitted in DUPLICATE.

REFERENCES—

AB Access Bend
AP Access Pipe
AY Access Y Junction
BV Back Vent
DP Down Pipe
New Sewer Drains: RED

FAI Fresh Air Inlet
GA Grease Arrester
GT Gulley Trap
IC Inspection Chamber
New Stormwater Drains:
DOTTED BLACK

MV Main Vent
S Saddle
TV Terminal Vent
WC Water Closet
Old Drains: FULL BLACK

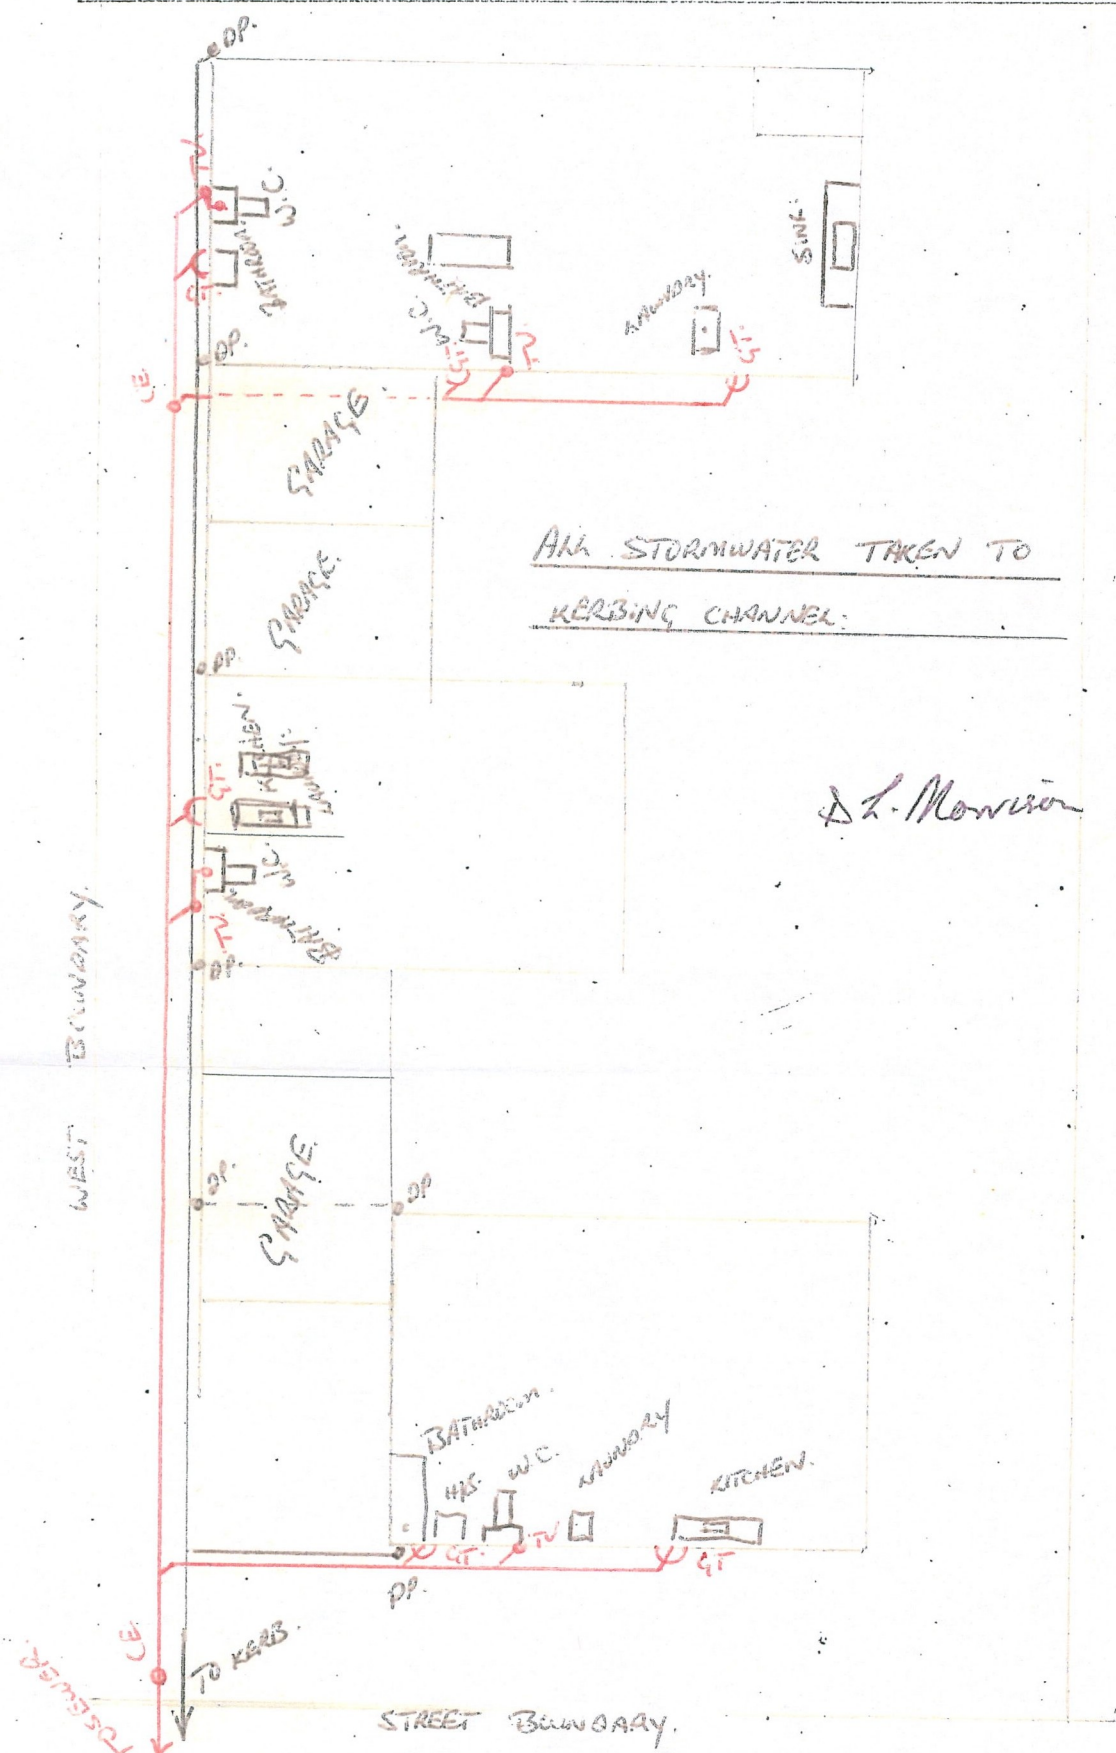

Name of Owner H. A. WALKER: Street 10 TRAFFORD ST. SORE.

Lot or Section No. 16 Block No. 11