


Property File: 1580-179-1

179 DICKSON RD

NEW CONNECTION  
GIS RECORDED

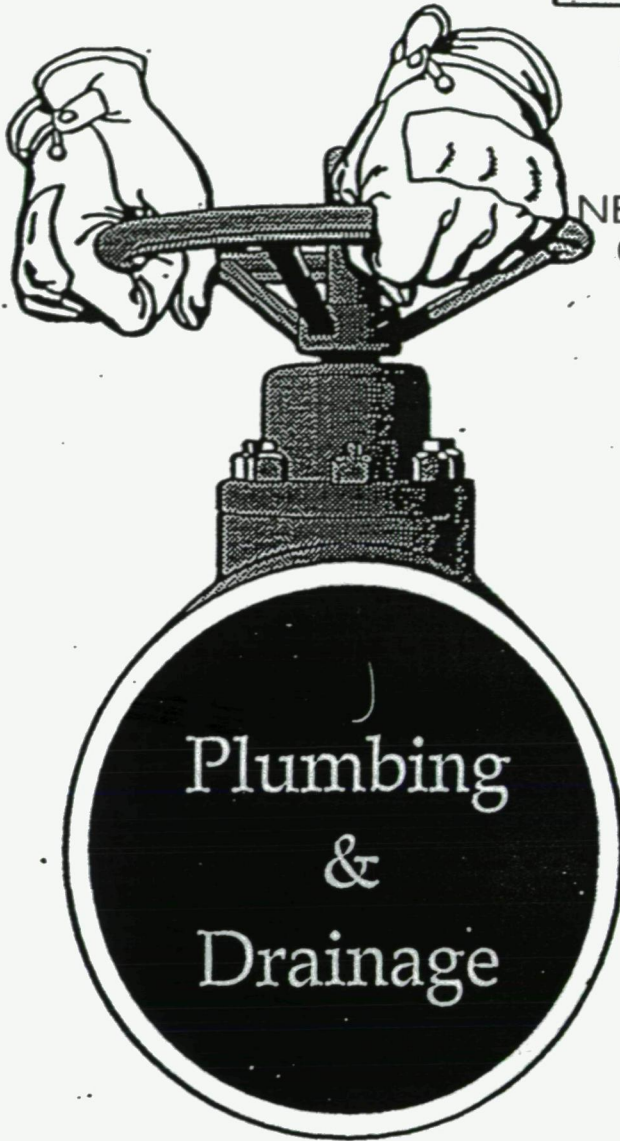

179B



TAURANGA  
DISTRICT COUNCIL

As  
Built  
Drainage  
Plan

# As Built Drainage Plan

Drainage plan for:

Street No: 179

Street DICKSON RD

Lot 166 D.P. 21830

Suburb PAPAMORA

Owner GOODWIN

Type of Building HOUSE

Drainlayer HESFORD

Date of Inspection 27-9-96

Inspector D GLOVER

Drainage Permit No. 96/2232


**NOTE: Plan to be drawn in black ballpoint on graph opposite.**

---

## Plan to include:


1. The correct position of the drains in relation to the building and boundaries.
2. The position of the street frontage.
3. Depth of drains at connection point.
4. Both foulwater and stormwater drains to be drawn.
5. Clearly define all inspection openings, with accurate measurements from two points.
6. Clearly define all buildings and boundaries.
7. Refer to example drain plan back page.



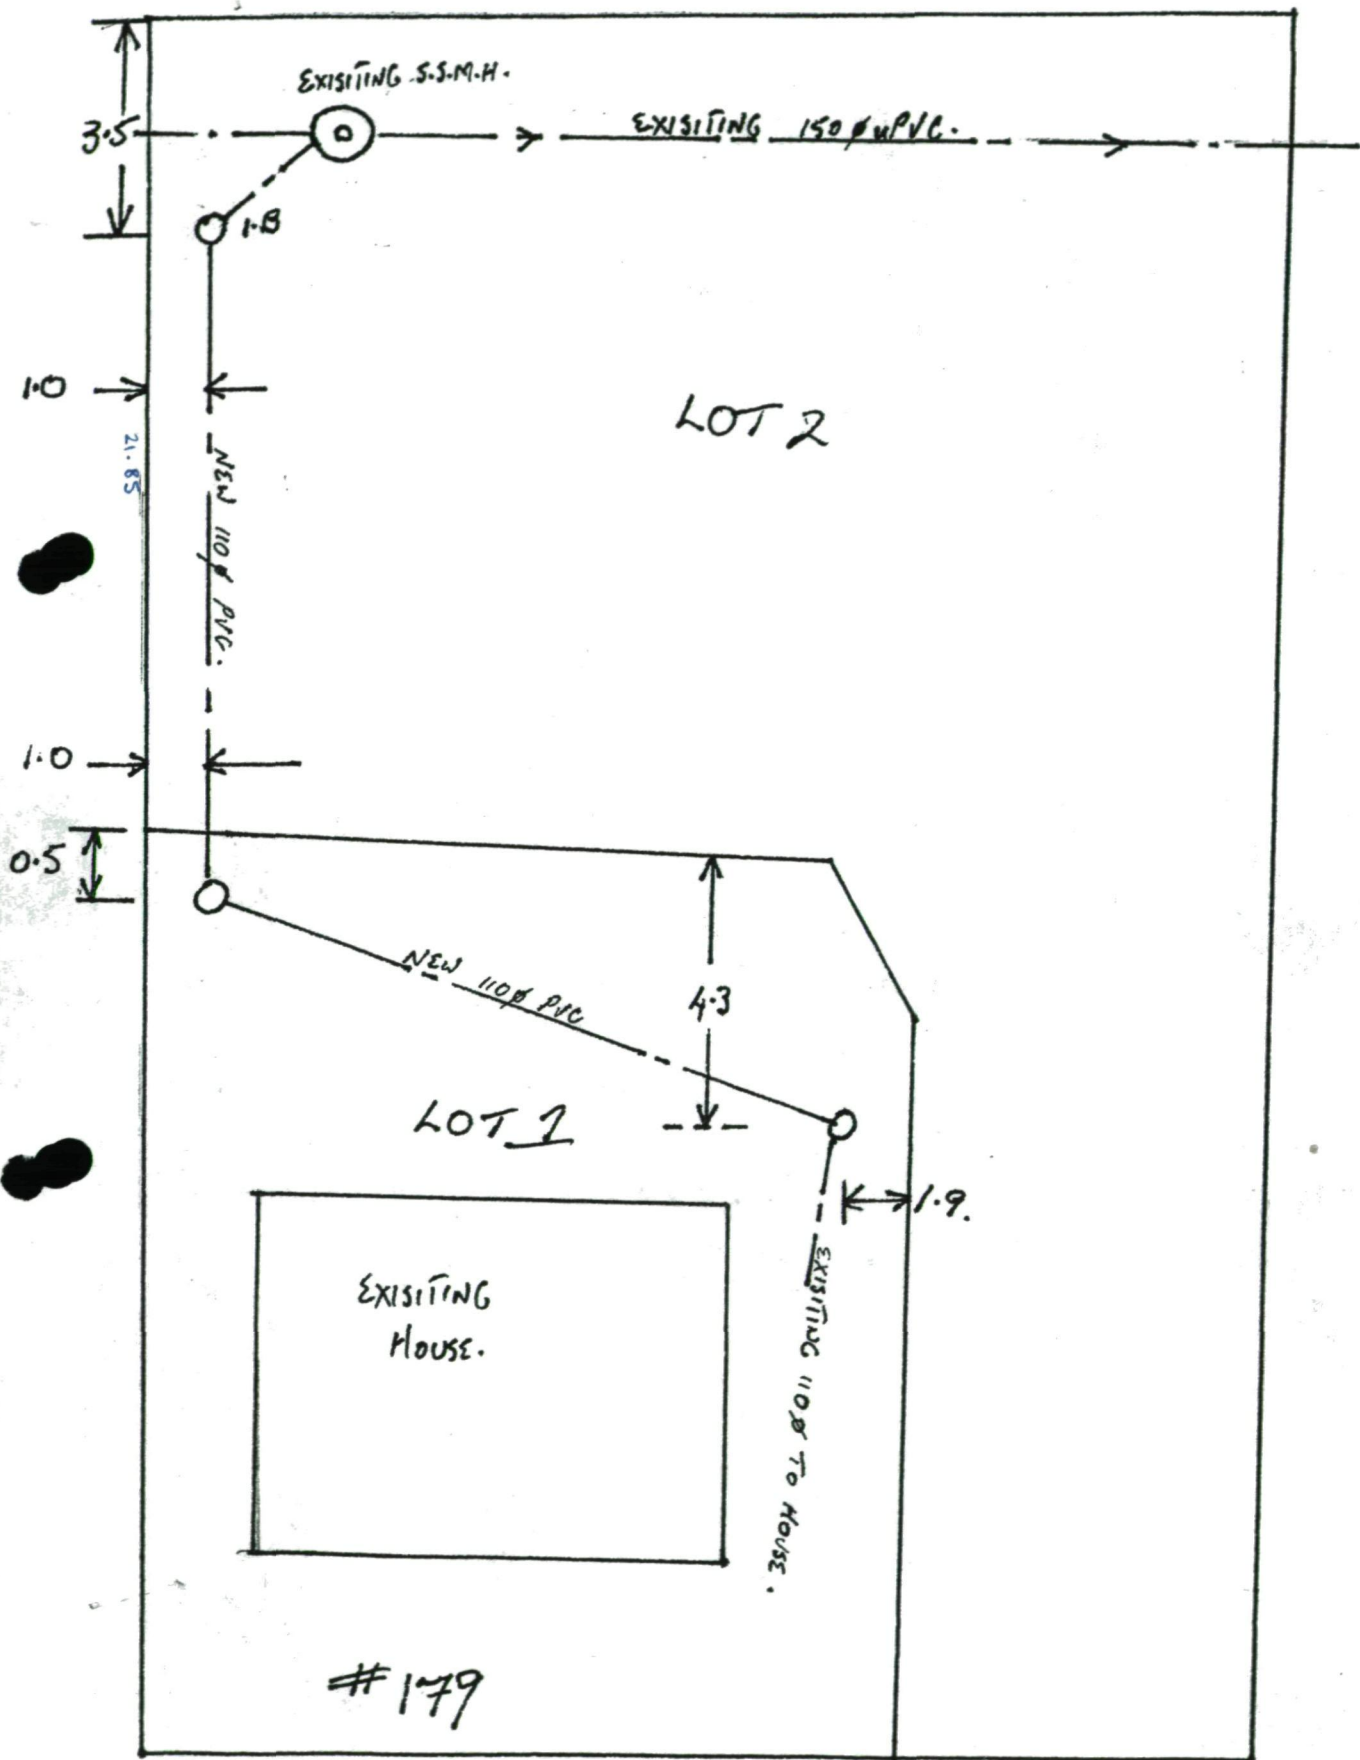

Lot 166 DP 21830 GOODWIN

Dickson Ro

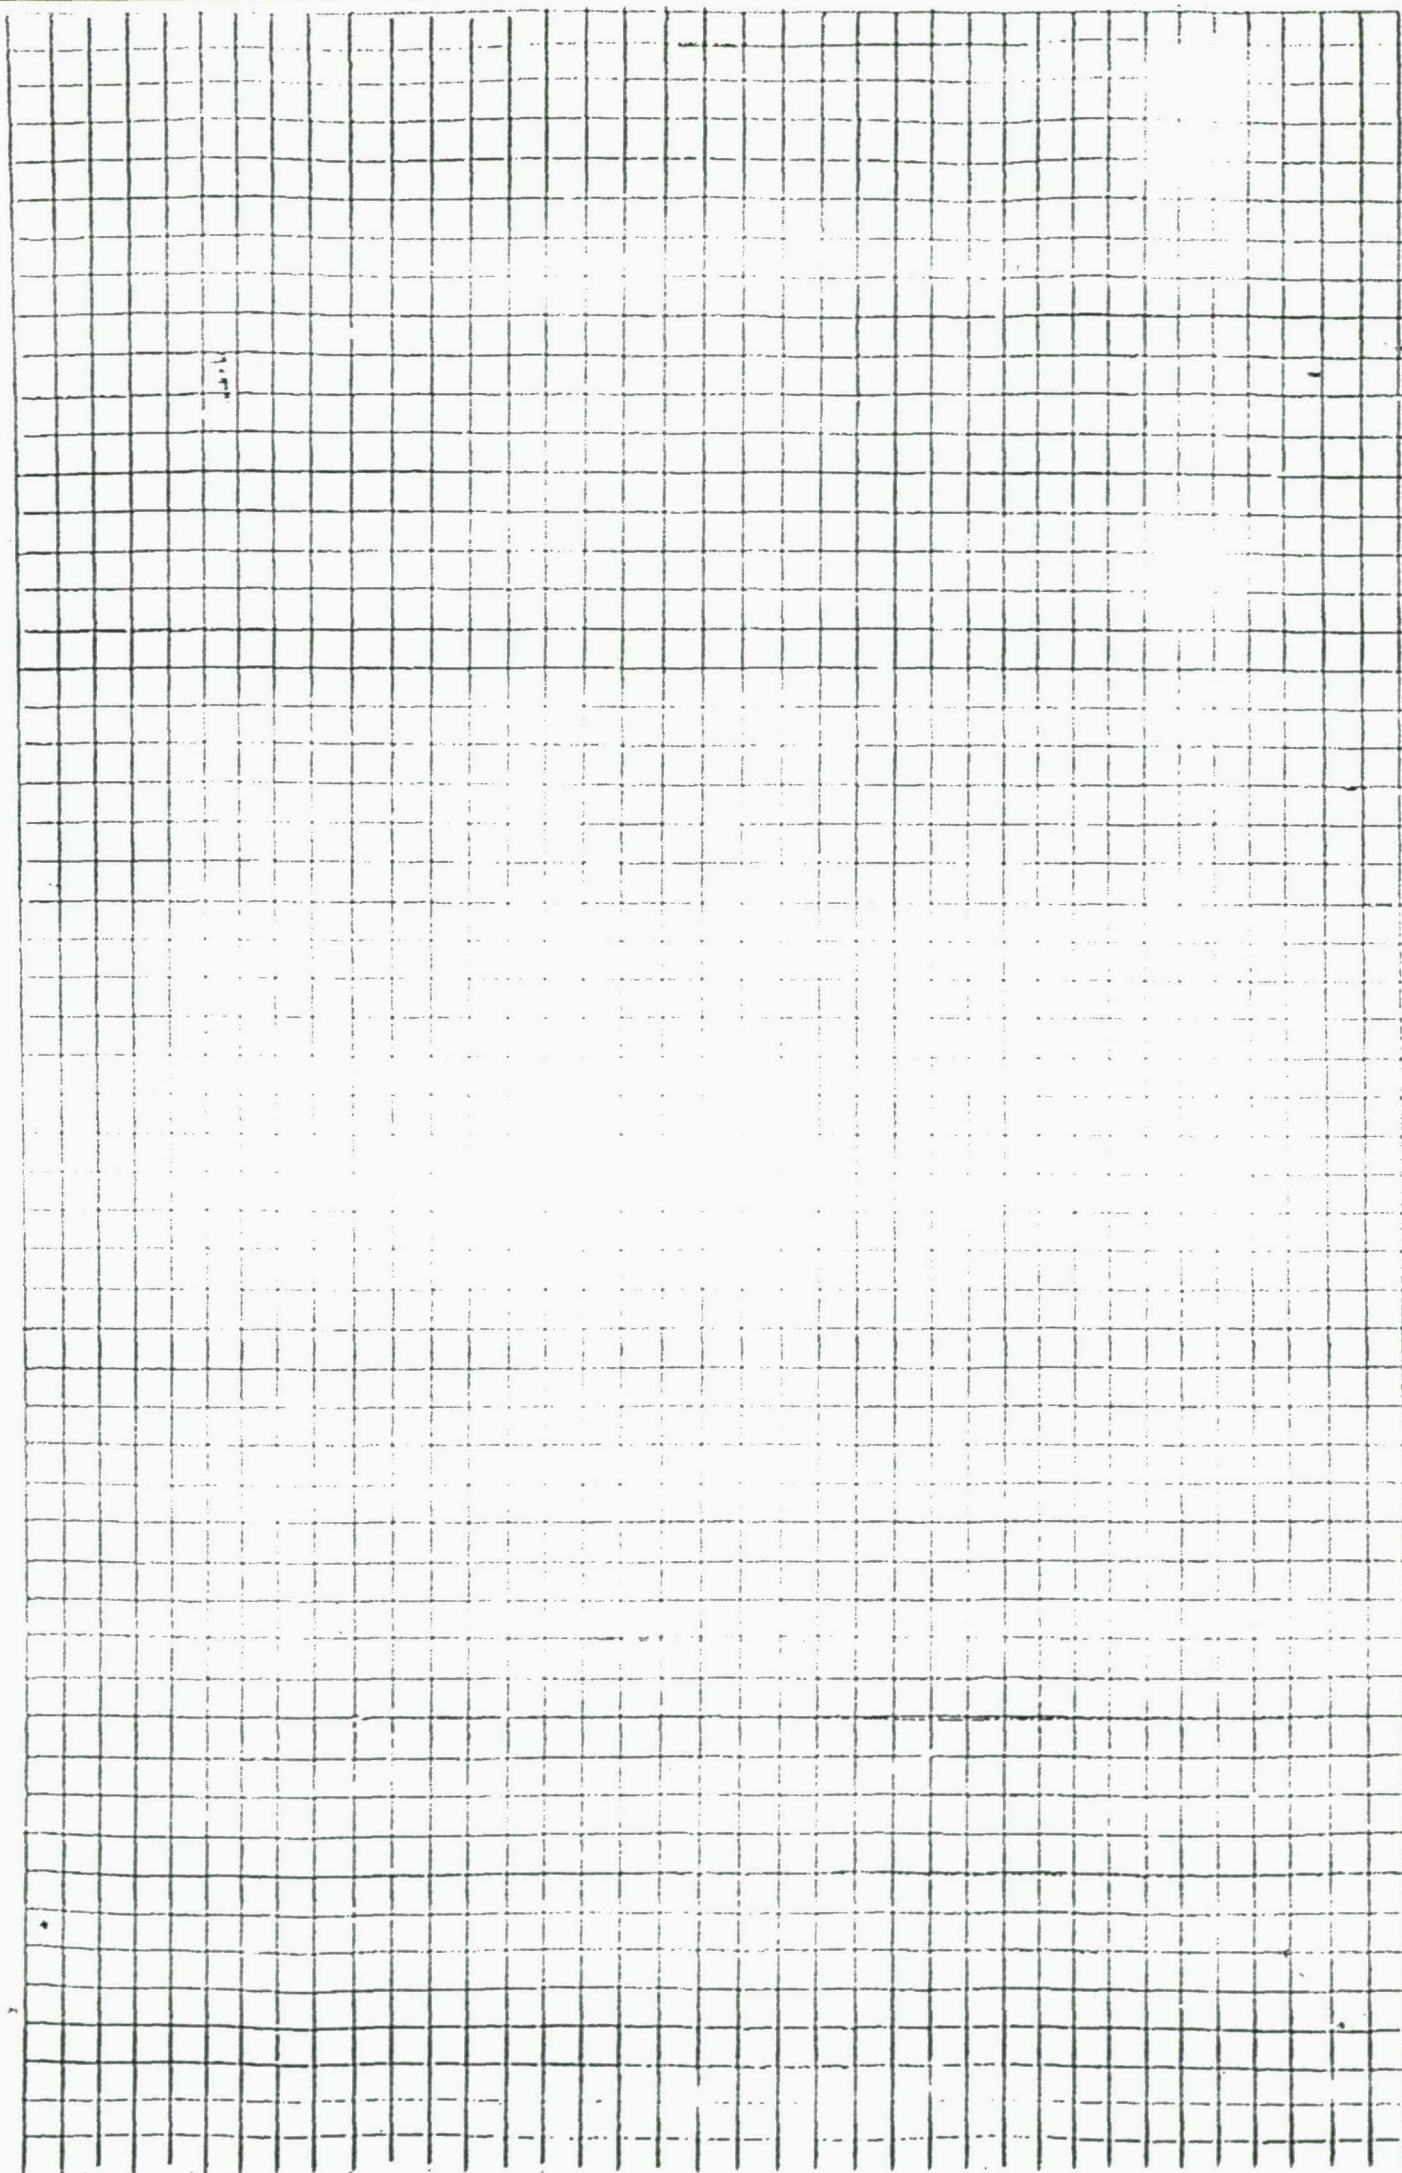



# Plan Example

