

Application No 3183

ROTORUA DISTRICT COUNCIL

Valuation No 6997/146pt

APPLICATION FOR PERMIT TO CARRY OUT SANITARY PLUMBING AND DRAINAGE WORK

I the undersigned hereby apply for permission to have the work described herein and set out on the plans attached hereto carried out in accordance with the provisions of the Drainage and Plumbing Regulations 1978 and Amendments at premises situated at

Address 11 ORCHARD PL - LYNMORE

Legal Description

Lot No 12

Deposited Plan No -

Section No

Block No

Description of WorkSEWER DRAINAGE TO
TWO UNITS**NUMBER OF SANITARY FITTINGS**

Toilet Pans 2 / UNIT

Urinals

Name and address of person for whom work is to be carried out

Jimmy FLYNN - 472 BREHANGI RD

Name and address of Craftsman Plumber

Name and address of Registered Drainlayer


17 WYCHWOODS CR

CHESTER BEES

	Value	Fees
Plumbing	\$ ---	\$ ---
Drainage	\$ 300	\$ 41-80
TOTAL FEES		\$ 41-80
GST INCLUSIVE		

Signature

Date

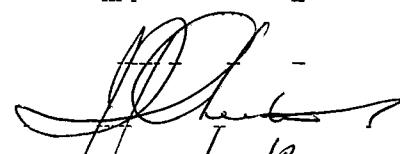
 11/2/87
FOR OFFICE USE ONLY

Receipt Number

361234

Fee Paid

\$41-80

Date Paid

11 2 87

Issue Approved

WR7.

Date Approved

11-2-87

Permit No

601

See reverse for Fees and Notes

FOR OFFICE USE ONLY

FEES PAYABLE ON THE ISSUE OF ANY PLUMBING OR DRAINAGE PERMIT

according to the Estimated Value of Work

Value of work (excluding value of fittings)				
Value of Work		Permit Fee	G S T	Total
Up to \$50		\$15	\$1 50	\$16 50
\$51	\$100	\$20	\$2 00	\$22 00
\$101	\$200	\$32	\$3 20	\$35 20
\$201	\$300	\$38	\$3 80	\$41 80
\$301	\$400	\$44	\$4 40	\$48 40
\$401	\$500	\$50	\$5 00	\$55 00
\$501	\$600	\$56	\$5 60	\$61 60
\$601	\$700	\$62	\$6 20	\$68 20
\$701	\$800	\$68	\$6 80	\$74 80
\$801	\$900	\$75	\$7 50	\$83 50
\$901	\$1000	\$80	\$8 00	\$88 00

\$1001 and over \$7 extra for every \$200 or part thereof in excess of \$1000 plus G S T

NOTE G S T applies to fees payable on or after 1 October 1986

IMPORTANT

INSPECTION AND TESTING REQUIREMENTS

DRAINAGE WORK Drainlayers are required to notify the Plumbing and Drainage Inspector when all work is completed This includes **effluent disposal** systems for septic tanks All drains will be tested with a 1.5 m head of **water** To implement this test it will be necessary for persons undertaking drainage work to have sufficient drain plugs to fill all sections of the drain prior to the Plumbing and Drainage Inspector arriving on the job also to have available a stand pipe to apply the 1.5 m head pressure

This form of testing is essential to exclude the possibility of ground water infiltration with its attendant increase in pumping charges and overloading of the sewers and treatment plant

PLUMBING WORK Plumbers are required to notify the Plumbing and Drainage Inspector when work is ready for inspection as follows

- (a) When the building has been initially piped out and wastes are installed (before wall linings are fixed and floors laid)
- (b) When work is complete

Plans of Drainage and Plumbing Work

In the case of single houses a preliminary drainage plan will not be required In all other cases however plans of the preliminary proposal are to be submitted at the time of application for a permit In all instances however an as laid plan must be available on site as a prerequisite to a test of the work

In commercial buildings full plans and elevations of plumbing stacks must be provided at the time of application for a permit

ROTORUA DISTRICT COUNCIL

Permit 0601

Sanitary Plumbing and Drainage Permit

Cheater Bros

APP No 383File No 6997/146/02

ESTIMATED VALUE OF WORK

\$ 300-Fee \$ 38-GST \$ 380Rec \$ 361234Date 11 2 87ADDRESS 11 Orchard PlaceLOT 12 DPS _____ SEC _____ Blk _____

Mr Cheater a craftsman plumber (or licensed drainlayer) is hereby authorised to carry out the work described herein on the premises owned (or occupied) by J Flynn

DESCRIPTION OF WORK

Sanitary drainage to 2 new units.

Such work to be carried out in strict accordance with the Drainage and Plumbing Regulations 1978

PP Engineer
PP Engineer

DATE

10-2-87

Drains inspected & tested to first unit
Soakholes installed for stormwater
2nd unit section sold off unit not to
go ahead.

Plans **MUST** show dimensions and distances from section boundaries in metric units



Rotorua District Council

NEW SEWERAGE DRAINS—RED
STORMWATER—DOTTED BLACK
OLD DRAINS—FULL BLACK

DRAINAGE PLAN

6997/146pt

23-5-05

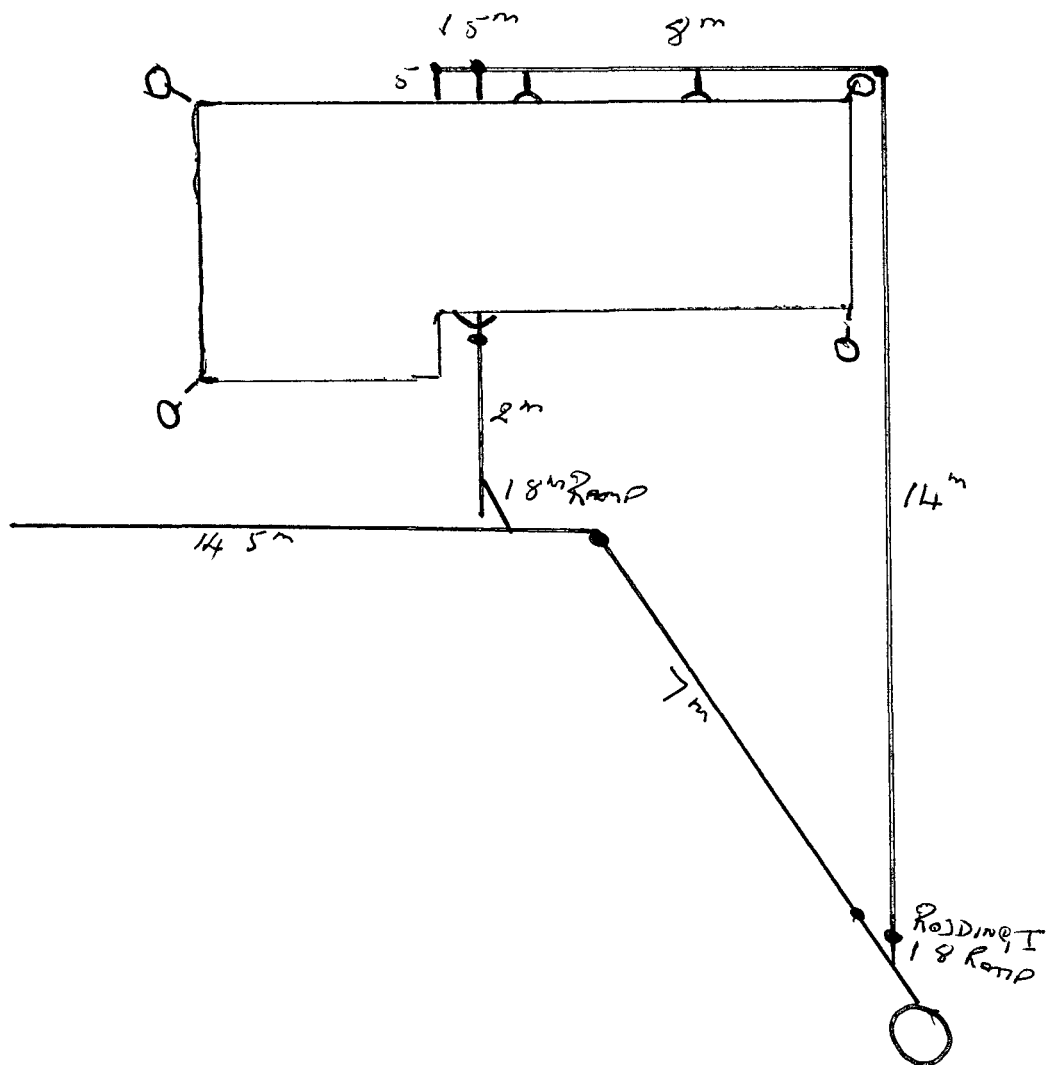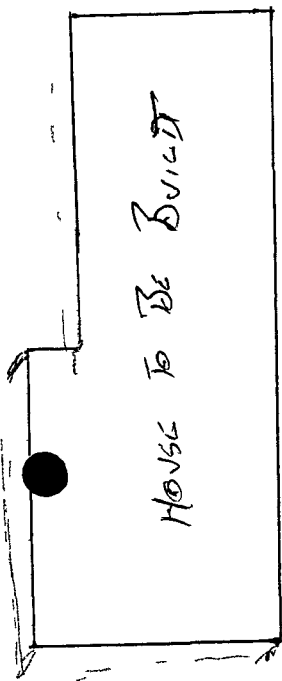

ROAD

OWNER T FLINN

LOT 12 SEC _____ BL _____

No _____ STREET ORCHARD PL

SIGNATURE OF DRAINLAYER [Signature] DATE 10-2-07