


AS BUILT
DRAINAGE PLAN

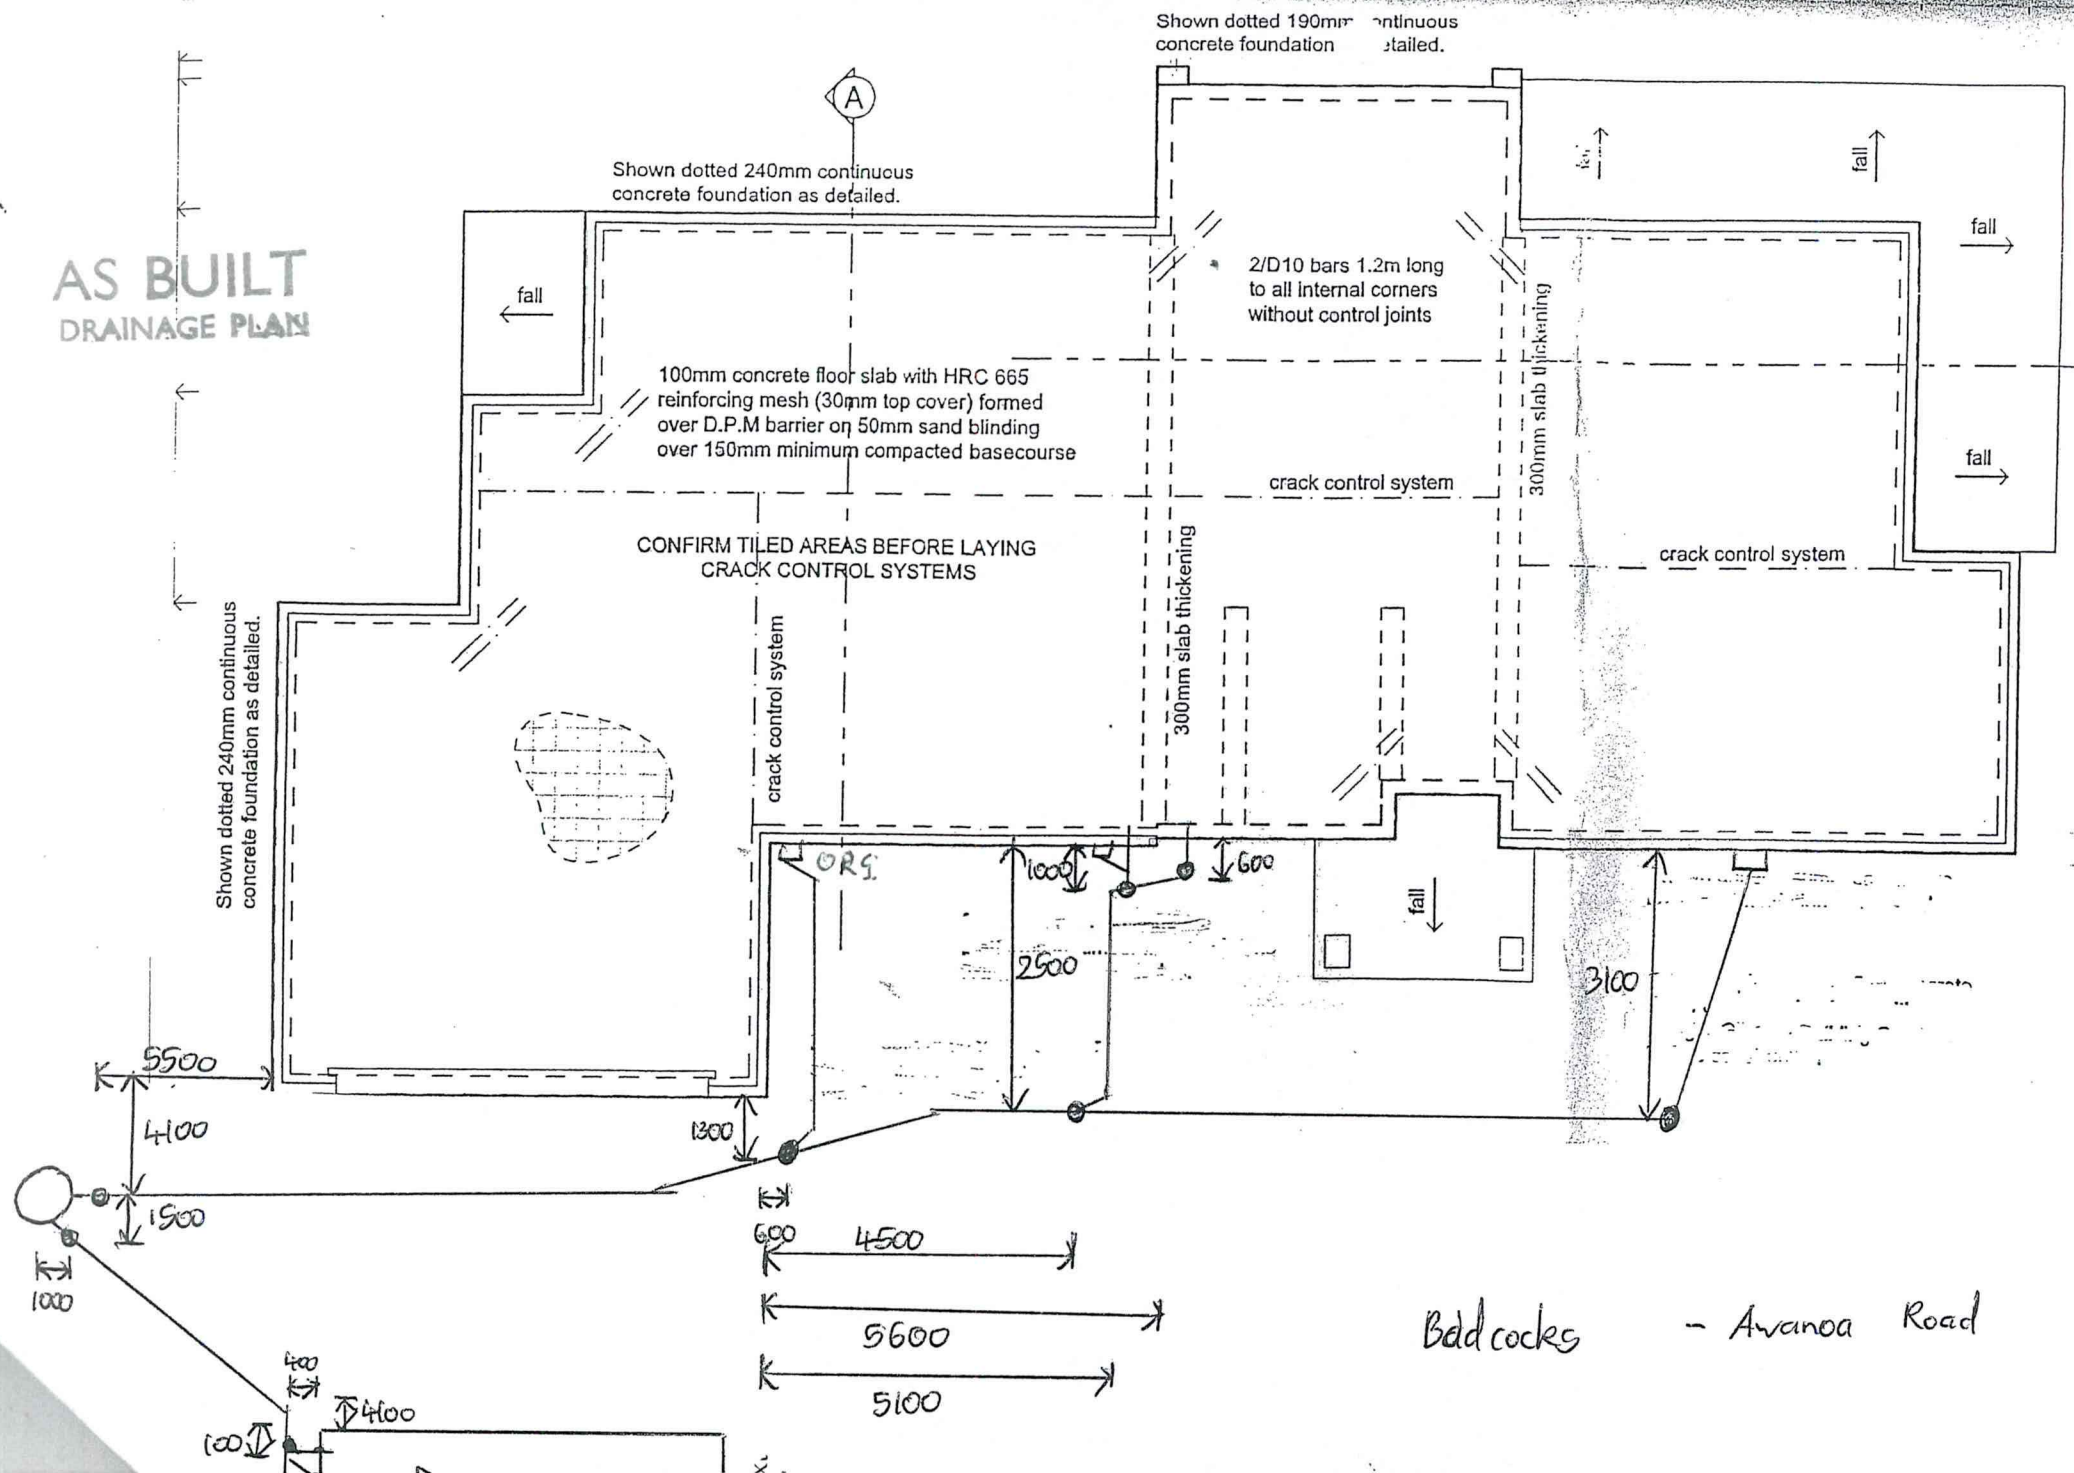

Badcock's - Avanaoa Road

COPIES