

WHAKATANE DISTRICT COUNCIL

As Built Drainage Plan


Lot D.P.

Road



GEN

County Town

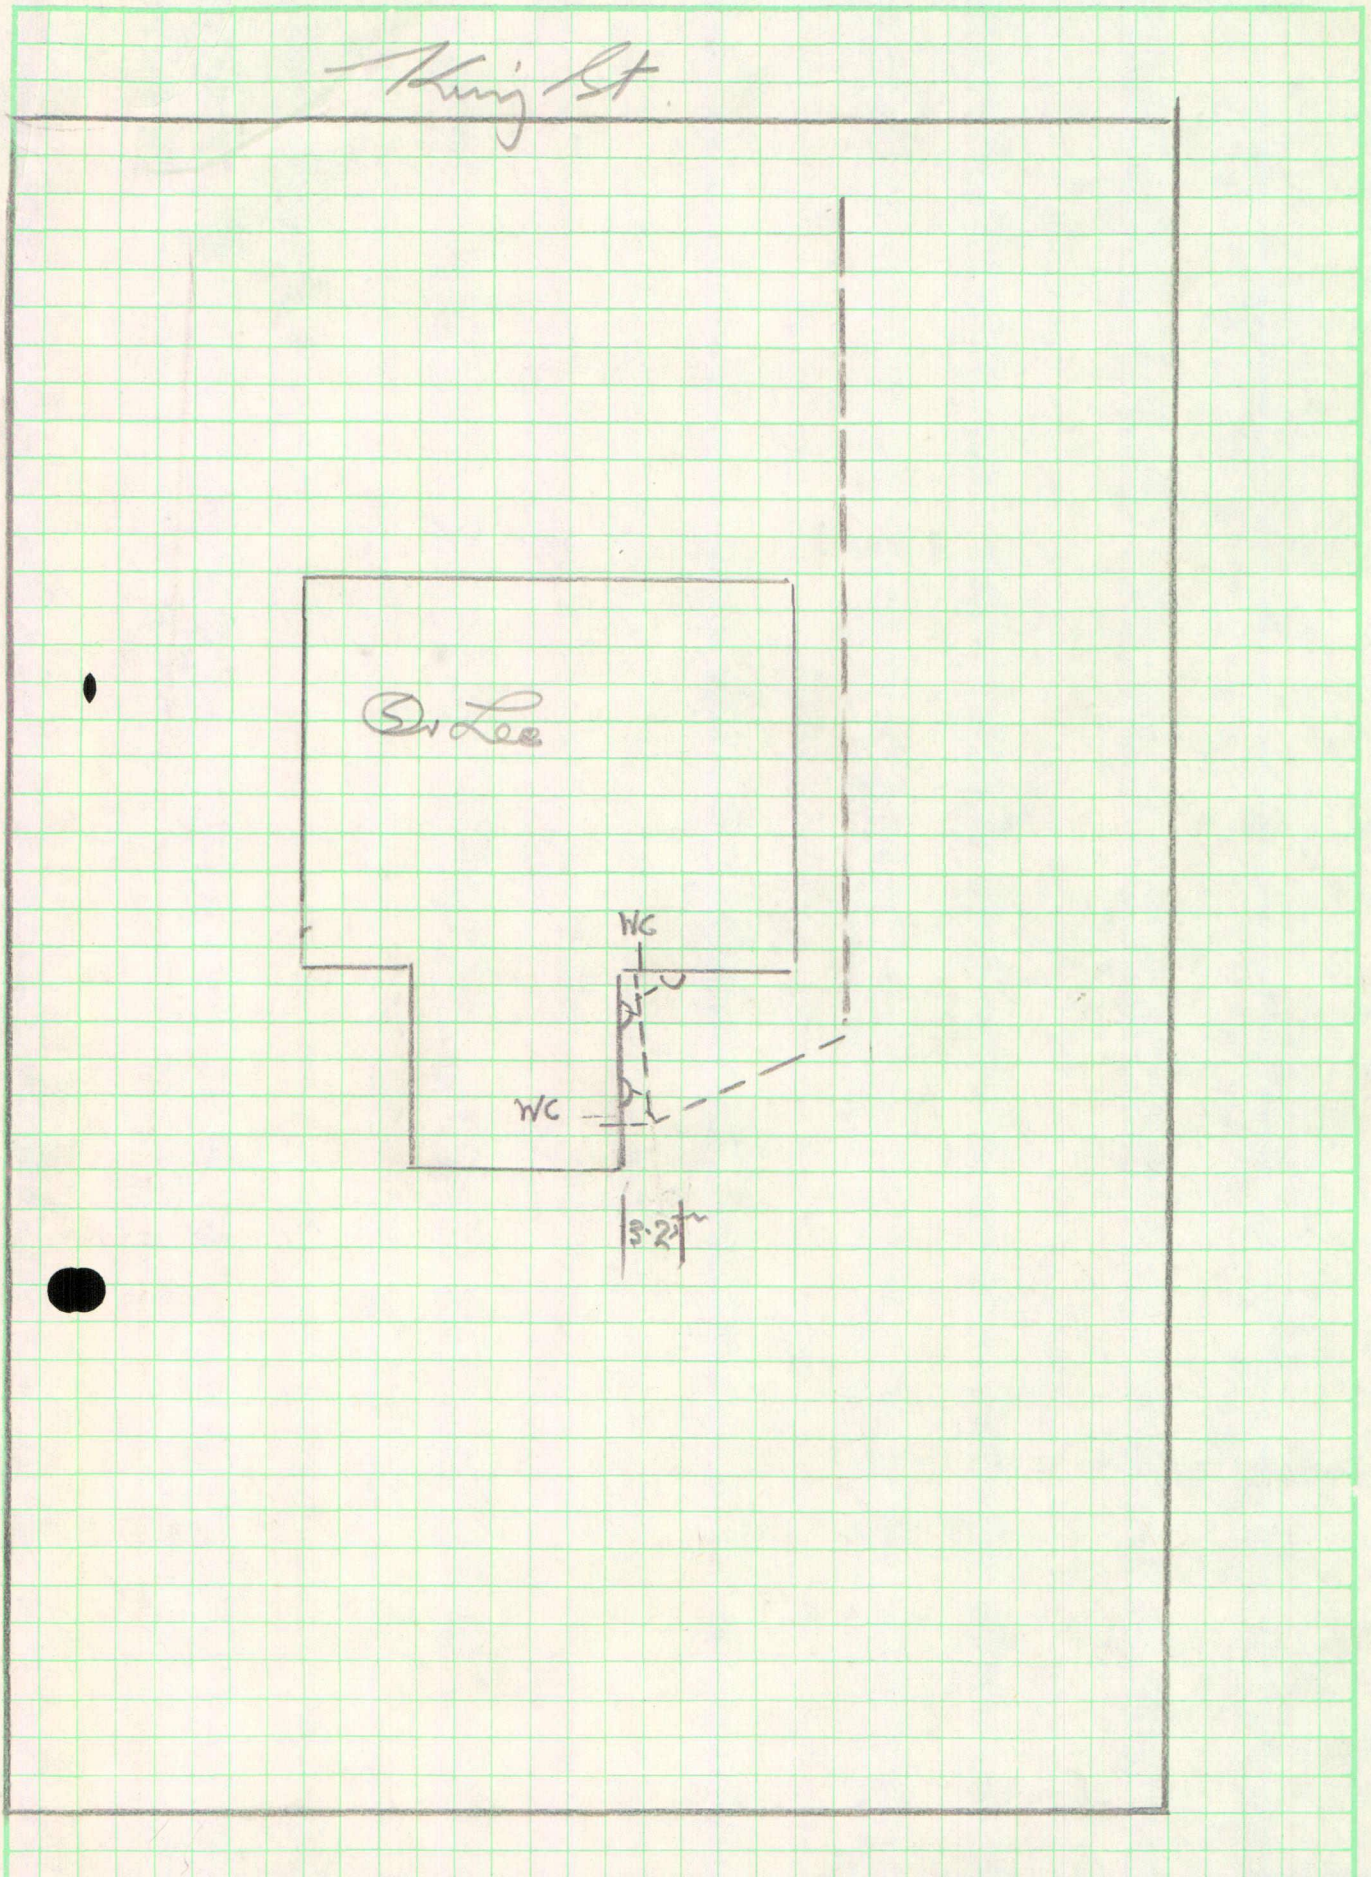

ROAD

For Office Use Only

Permit No.

Infiltration Sources.

Date Connected

Scale 1 : 100

1 : 200


Whakatane Printers Limited

LOCALITY & DRAINAGE PLAN

Showing Boundaries and position of Building on Allotment
Drainage will be plotted by Drainage Inspector.

Boundary Lines to be shown . . .

Buildings may be erected on the Boundary Line, only if the Boundary wall is constructed with 4 Hour Fire Resisting Rating.

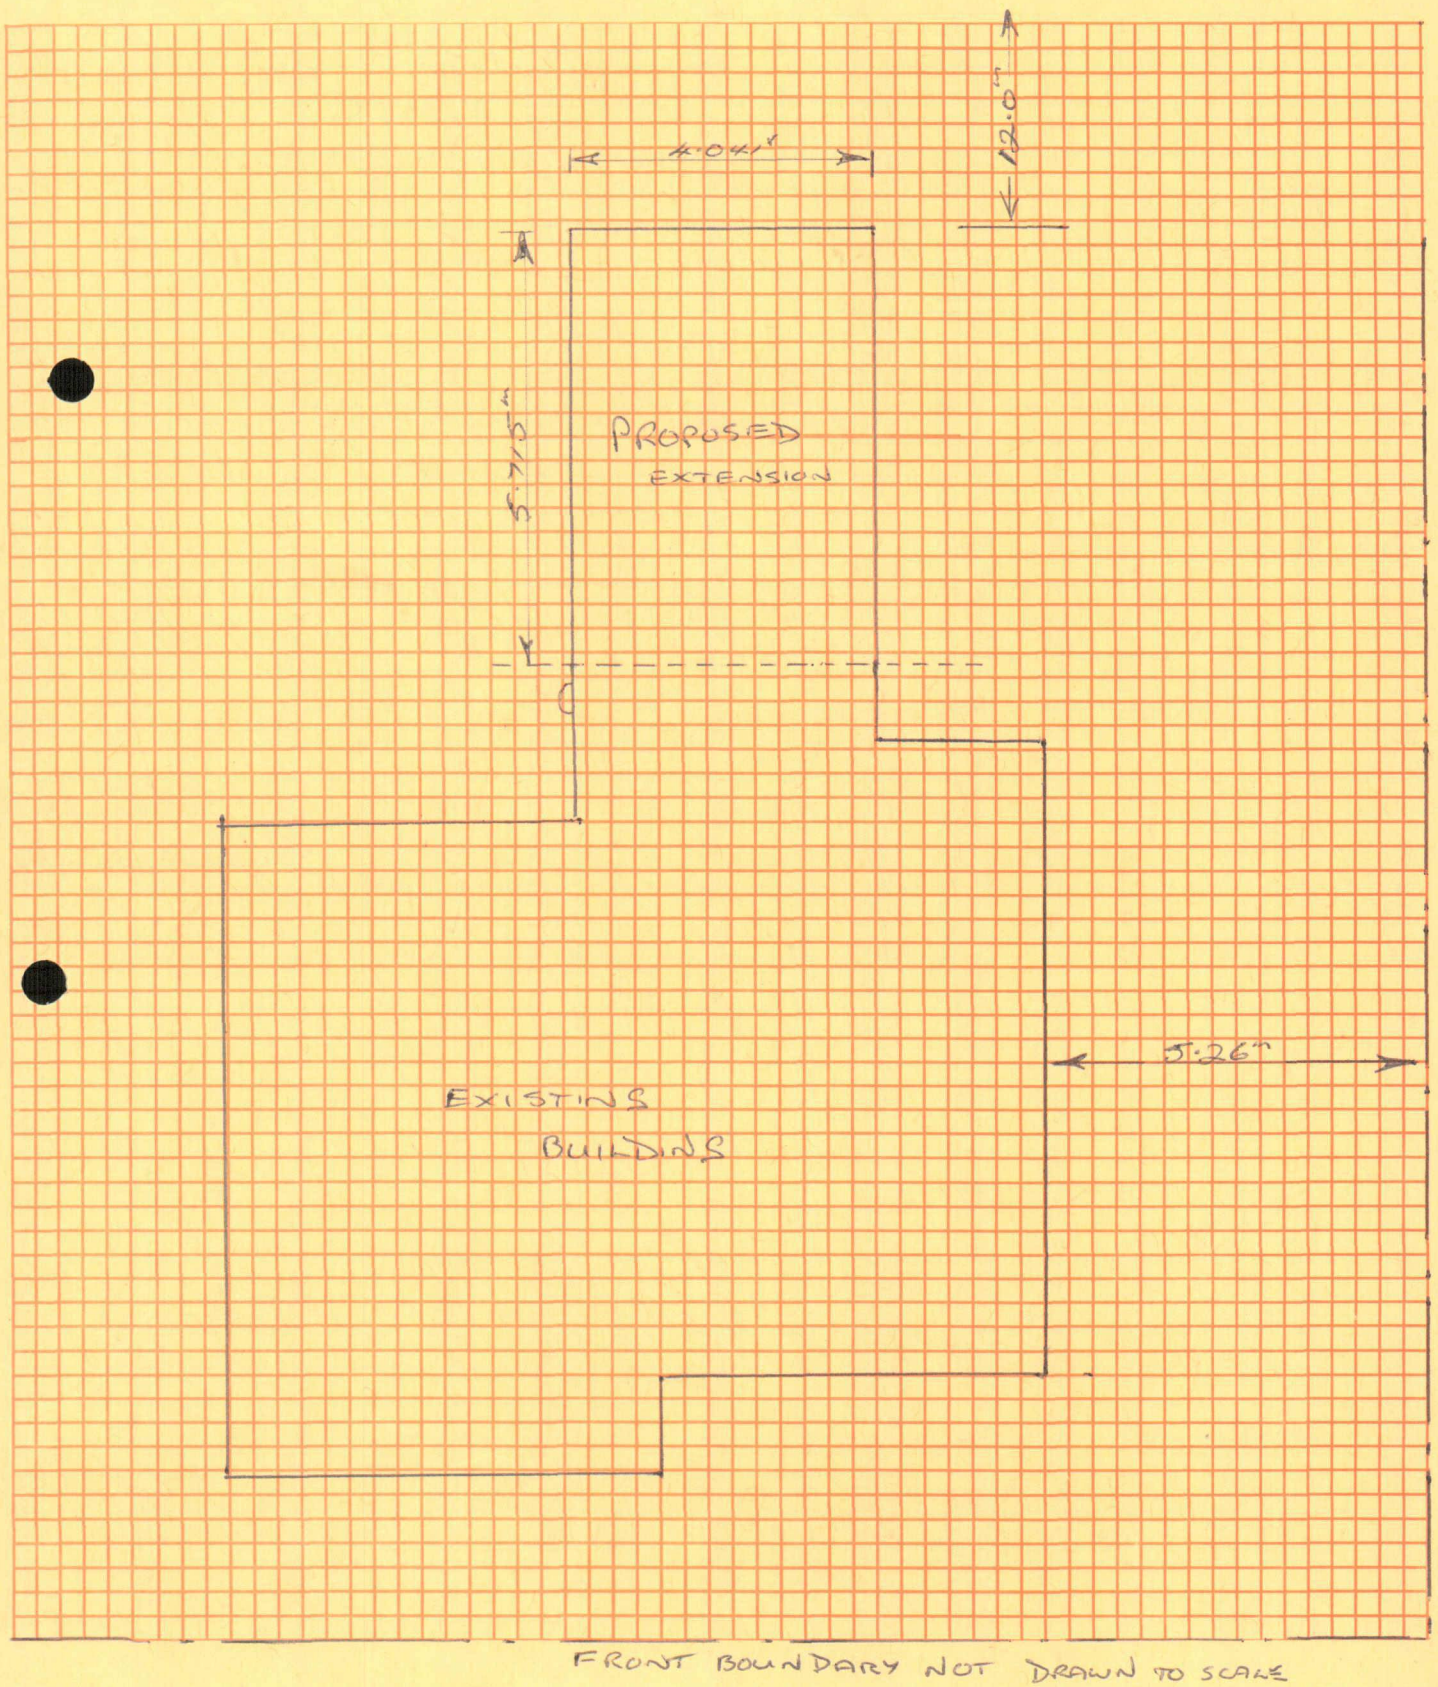

ARRANGEMENTS TO BE MADE re

SEWER DRAINAGE.....GRADIENT

STORMWATER DRAINAGE.....

PERMANENT FOOTPATH CROSSING.....

SCALE OF FEES

Estimated Value of Work:

Over	and not exceeding	
	\$ 500	\$5
\$ 500	\$ 1 000	\$8
\$ 1 000	\$ 2 000	\$13
\$ 2 000	\$ 3 000	\$18
\$ 3 000	\$ 4 000	\$23
\$ 4 000	\$ 5 000	\$28
\$ 5 000	\$ 6 000	\$32
\$ 6 000	\$ 7 000	\$36
\$ 7 000	\$ 8 000	\$40
\$ 8 000	\$ 9 000	\$43
\$ 9 000	\$ 10 000	\$46
\$ 10 000	\$ 15 000	\$60
\$ 15 000	\$ 20 000	\$74
\$ 20 000	\$ 25 000	\$85
\$ 25 000	\$ 30 000	\$95
\$ 30 000	\$ 40 000	\$110
\$ 40 000	\$ 50 000	\$125
\$ 50 000	\$ 60 000	\$140
\$ 60 000	\$ 70 000	\$155
\$ 70 000	\$ 80 000	\$170
\$ 80 000	\$ 90 000	\$185
\$ 90 000	\$ 100 000	\$200
\$ 100 000	\$ 120 000	\$212
\$ 120 000	\$ 140 000	\$224
\$ 140 000	\$ 160 000	\$236
\$ 160 000	\$ 180 000	\$248
\$ 180 000	\$ 200 000	\$250
\$ 200 000	\$ 400 000 *	
\$ 400 000		**

* \$260 plus \$10 for each \$20 000 or part thereof.

** \$360 plus \$ 6 for each \$20 000 or part thereof.

NOTE: A further 25% is payable on the above fees where a structural check is required.

Chapter 2, second Schedule is amended by substituting the updated schedule of fees:

For inspection required in the case of proposed structural alterations before drawings and other documents are submitted for approval. \$5.00

For inspecting old timber before reusing the same in a new building. \$5.00

For inspection that may be deemed necessary in connection with any building or work in respect of which no fee has otherwise been paid. \$3.00

For searching drawings and other documents after completion of work. \$2.00

NOTE WELL: If any dispute as to value, the Building Inspector shall have absolute determination of the value of the proposed work or building.

The estimate must be of the completed building and to include all labour costs.