



Company Details

D & B Drainage and Excavation

139 Merton Road, Fernside

dandb@dandbdrainage.co.nz

Michael Boulton 0276305726

Richard Tapp 0274249918

Producer Statement

Building Consent Number: 240494

Issued By: Richard Tapp, Drainage Reg #24836 & Michael Boulton Drainage Reg #29791

To: Oakridge Homes

To be supplied to: Selwyn District Council

At: 5 Nirmal Way

Lot Number: 44 Lemonwood Estate

We have been engaged by the owner/developer/council referred to above to provide drainage and construction in respect of the requirements of G13 Drainage and E1 Surface Water of the building code for part only of the proposed work.

This is to confirm that this is done to clause G13 Foul Water AS3500 and E1 Surface Water under the building code and is in conjunction with the specifications on the consented plans for the property stated above. I confirm a water test was applied and held. We have attached working drawings and specifications of the above job. I believe that on reasonable grounds that all work as specified in the attached particulars of the building work under the building consent has been completed to the extent required by that building consent.

Signed: 

Date:

4-6-24


Date of installation:

30-5-24


Please Tick Soak Hole Type And Fill In All Relevant Info

☐

ENGINEER OR STANDARD SOAKHOLE

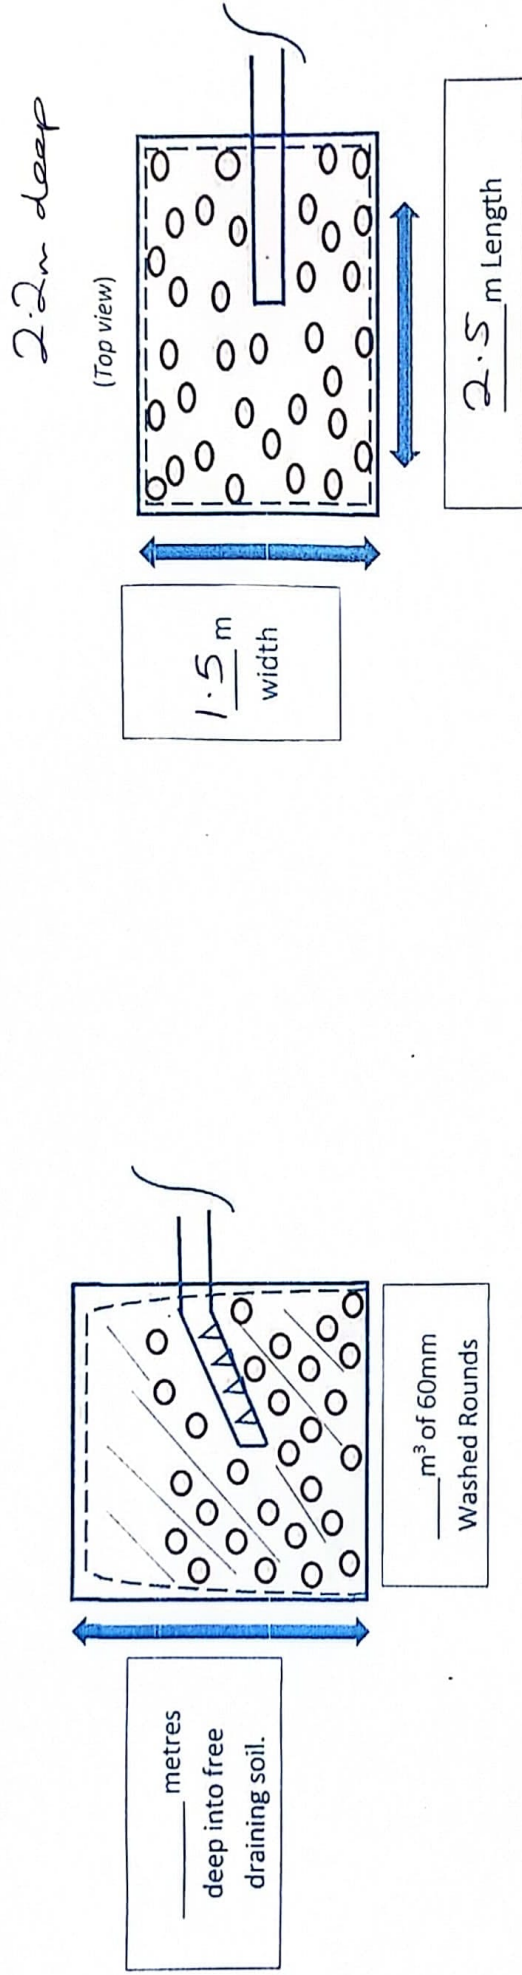
☐

BOREHOLE

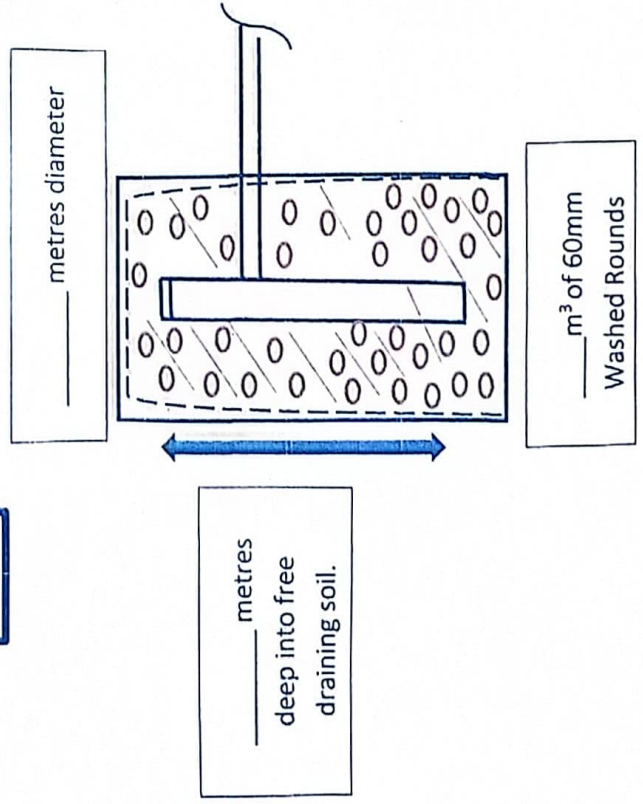

Extra Notes / helpful info:

BC 240494

Lot 44 / 5 Nirral Way
Lemonwood Estate

Soak hole was excavated 1.5m wide by 2.5m long and 2.2m deep. Soak hole was then lined with filter cloth and back-filled with 150mm washed rounds.