


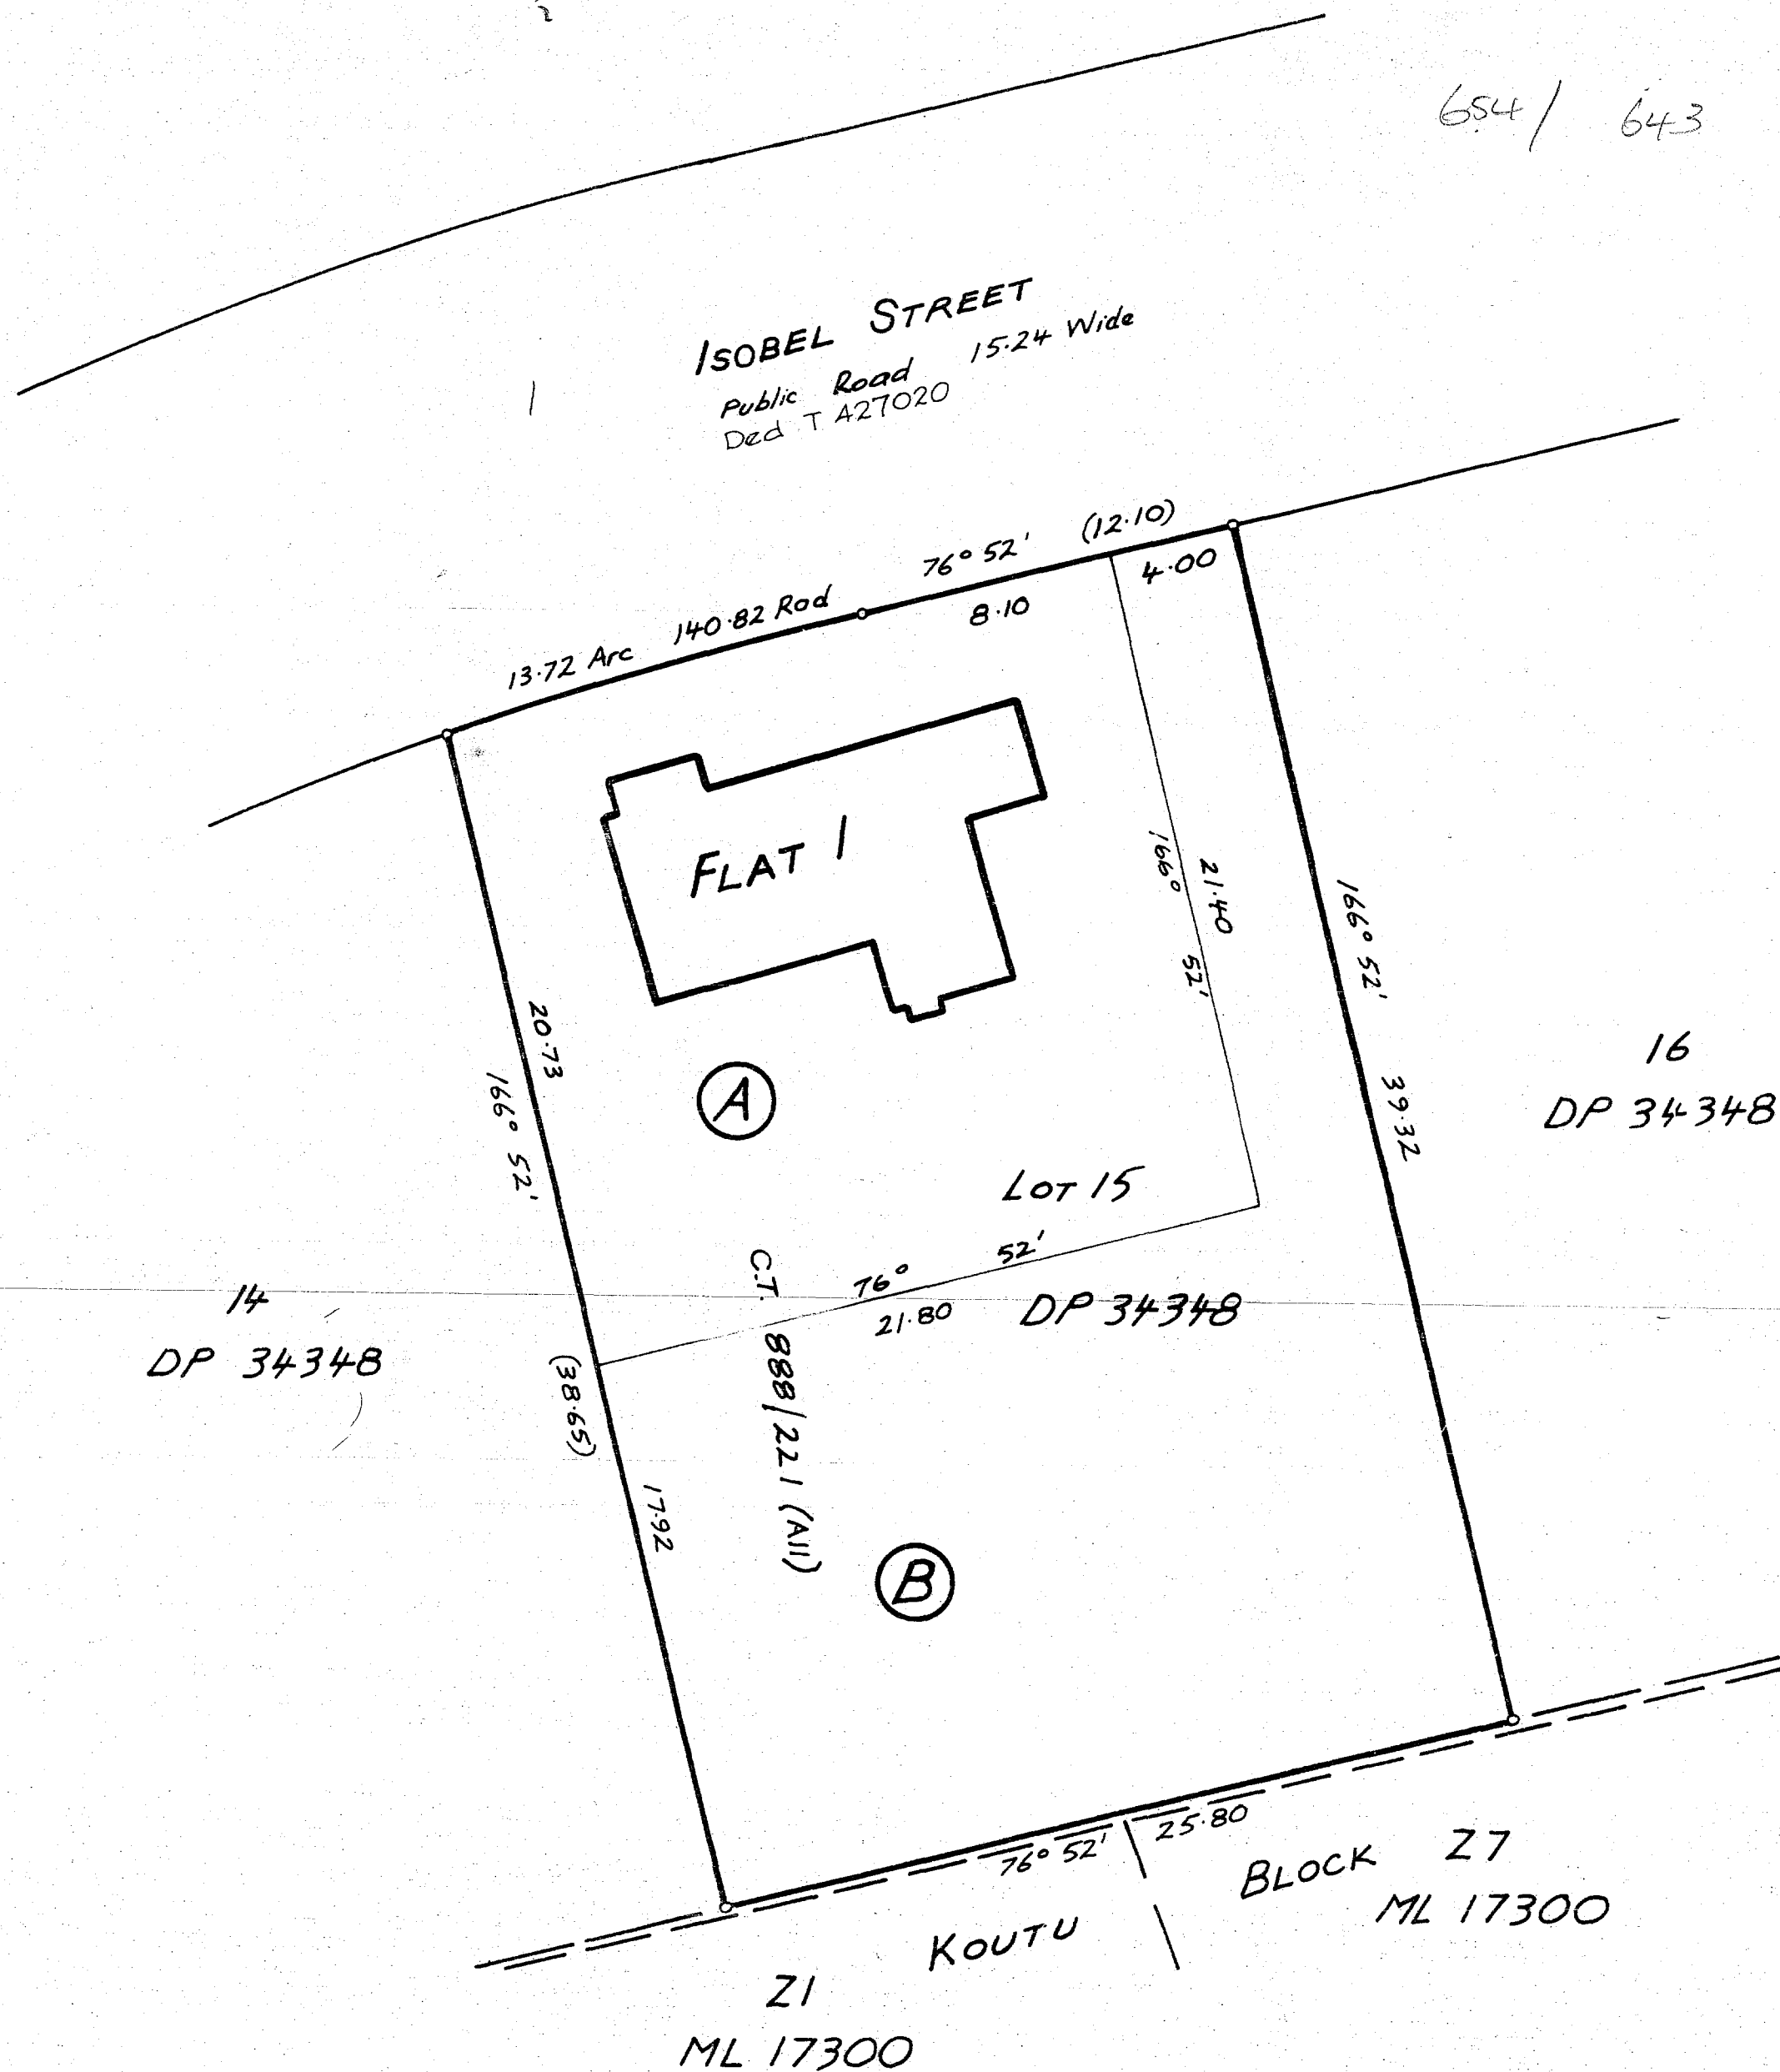

✓ Board 654012
 ✓ B sheet
 map 26

LAND DISTRICT SOUTH AUCKLAND

SURVEY BLK. & DIST. XVI, ROTORUA

NZMS 281 SHT U16 RECORD MAP No 47.03

PLAN OF FLAT SITUATED ON LOT 15 DP 34348
 BEING PT KAWAHA N°2 BLOCK

TERRITORIAL AUTHORITY ROTORUA DISTRICT

Surveyed by HARRISON GRIERSON CONSULTANTS LTD

Scale 1:200 Date JULY 1986



Approvals

I.L. Rountree
 I.L. ROUNTREE
 Registered Owners

S.M.T. Rountree
 S.M.T. ROUNTREE
 Registered Owners

Pursuant to Section 314 of the Local Government Act 1974 I hereby certify that the building depicted hereon was constructed before 1st April 1979 and was provided with such safeguards against fire and means of escape in case of fire as were required by the By-laws of the Rotorua District Council applying as at the date of this certificate.

Dated this 15 day of August 1986

[Signature]
 District Manager

I hereby certify that the building shown hereon is erected in the position shown and is within the boundaries of C.T. 888/221 Lot 15 DP 34348

[Signature]
 Registered Surveyor

Total Area 1011 m²

Comprised in C.T. 888/221 (All)

I, Fergus Campbell, Registered Surveyor and holder of an annual practising certificate (or who may act as a registered surveyor pursuant to the proviso to section 33(2) of the Surveyors Act 1966) hereby certify that this plan has been made from surveys executed by me or under my directions, that both plan and survey are correct and have been made in accordance with the Survey Regulations 1972.

Dated at Koutu this 27 day of JULY 1986 Signature *[Signature]*

Field Book p. Traverse Book p.

Reference Plans DP 34348

Examined *[Signature]* Correct *[Signature]*

Approved for Leasing Purposes Only.



12.1.86 LT Surveyor

Deposited this 15 day of SEPTEMBER 1986

[Signature]
 Asst. District Land Registrar

File Received 26-8-86 Instructions

DPS 42817

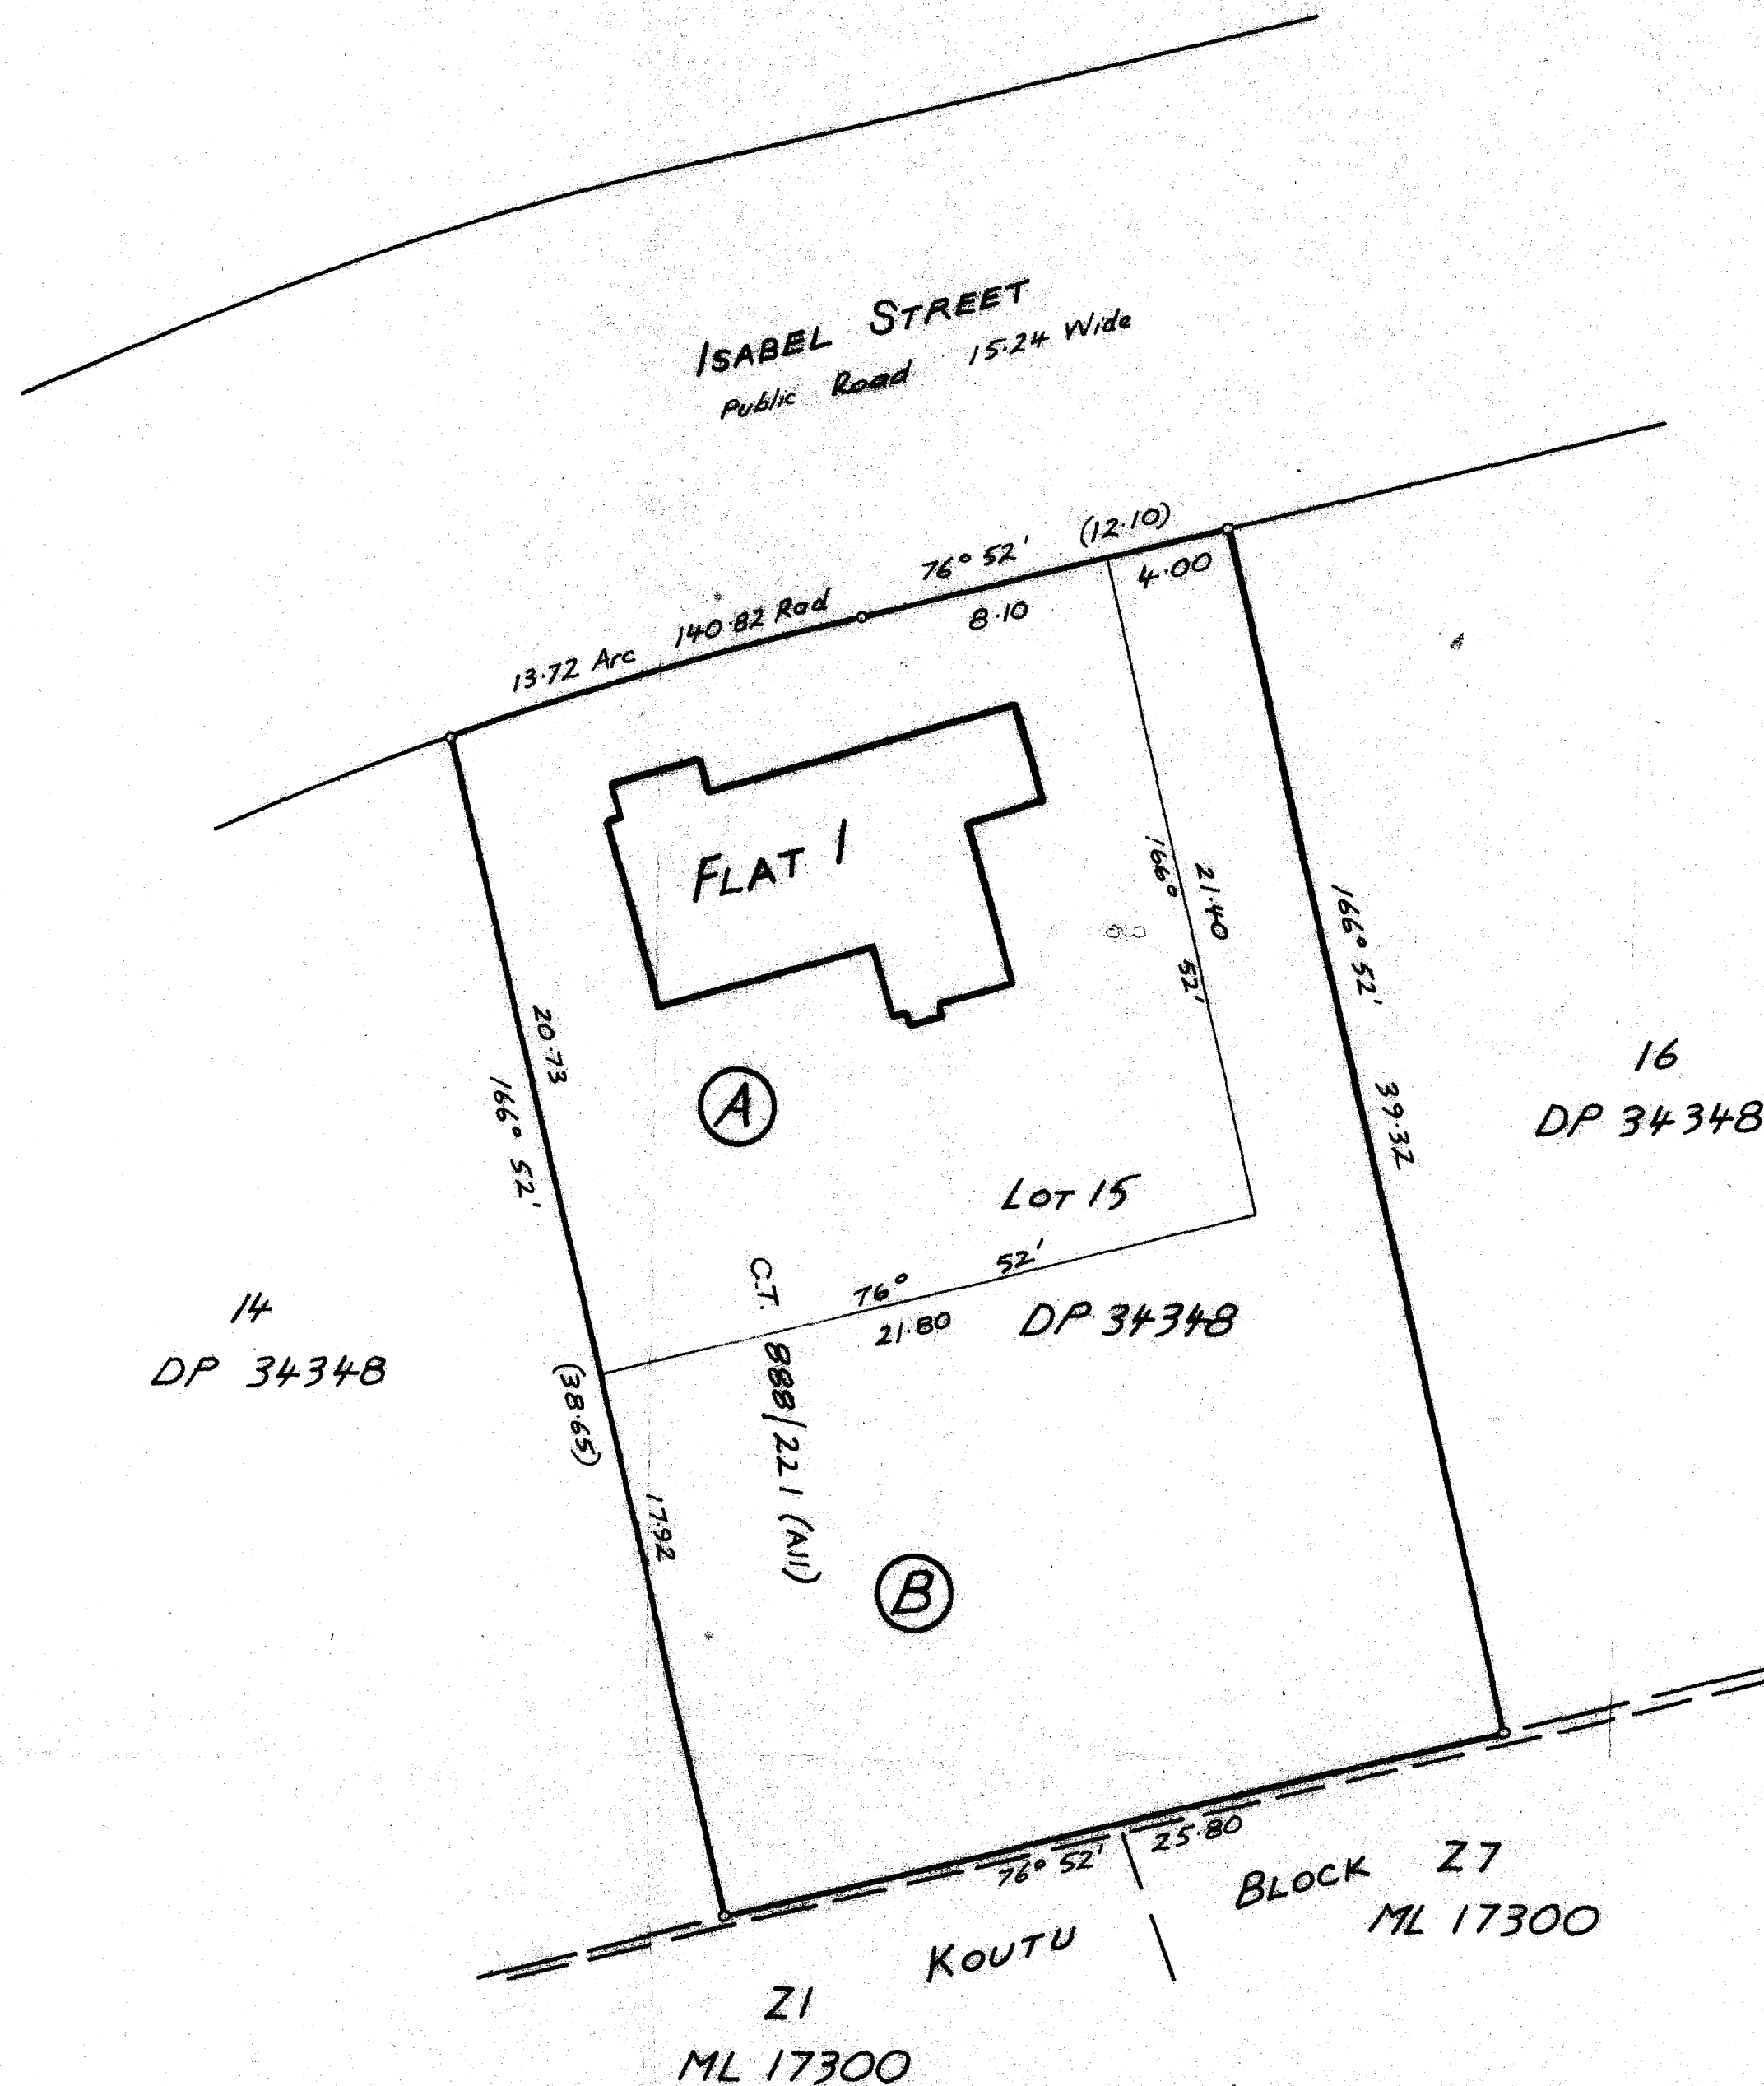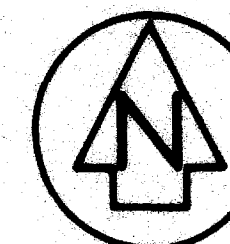

Approvals	
<i>I.L. Rountree</i> I.L. ROUNTREE	<i>S.M.T. Rountree</i> S.M.T. ROUNTREE
Registered Owners	
Pursuant to Section 314 of the Local Government Act 1974 I hereby certify that the building depicted hereon was constructed before 1st April 1979 and was provided such safeguards against fire and means of escape in case of fire as were required by the By-laws of the Rotorua District Council applying as of the date of this certificate.	
Dated this ___ day of _____ 1986	
District Manager	
I hereby certify that the building shown hereon is erected in the position shown and is within the boundaries of C.T. 888/221 Lot 15 DP 34348	
<i>[Signature]</i> Registered Surveyor	
Total Area 1011 m ²	
Comprised in C.T. 888/221 (All)	
I, Fergus Campbell, Cunningham, Registered Surveyor and holder of an annual practising certificate for who may act as a registered surveyor pursuant to the proviso to section 33(2) of the Surveyors Act 1966 hereby certify that this plan has been made from surveys executed by me or under my directions, that both plan and survey are correct and have been made in accordance with the Survey Regulations 1972.	
Dated at Rotorua this 27th day of JULY 1986 Signature <i>[Signature]</i>	
Field Book	Traverse Book
Reference Plans	DP 34348
Examined	Correct
Approved as to Survey	
Chief Surveyor	
Deposited this 27th day of JULY 1986	
Areas and Measurements subject to check	
Lands and Survey Dept.	

LAND DISTRICT SOUTH AUCKLAND	PLAN OF FLAT SITUATED ON LOT 15 DP 34348	TERRITORIAL AUTHORITY ROTORUA DISTRICT
SURVEY BLK. & DIST. XVI, ROTORUA	BEING PT KAWAHA No 2 BLOCK	File 303255
NZMS 261 SHT	RECORD MAP No	Surveyed by HARRISON GRIERSON CONSULTANTS LTD
		Scale 1:200 Date JULY 1986

