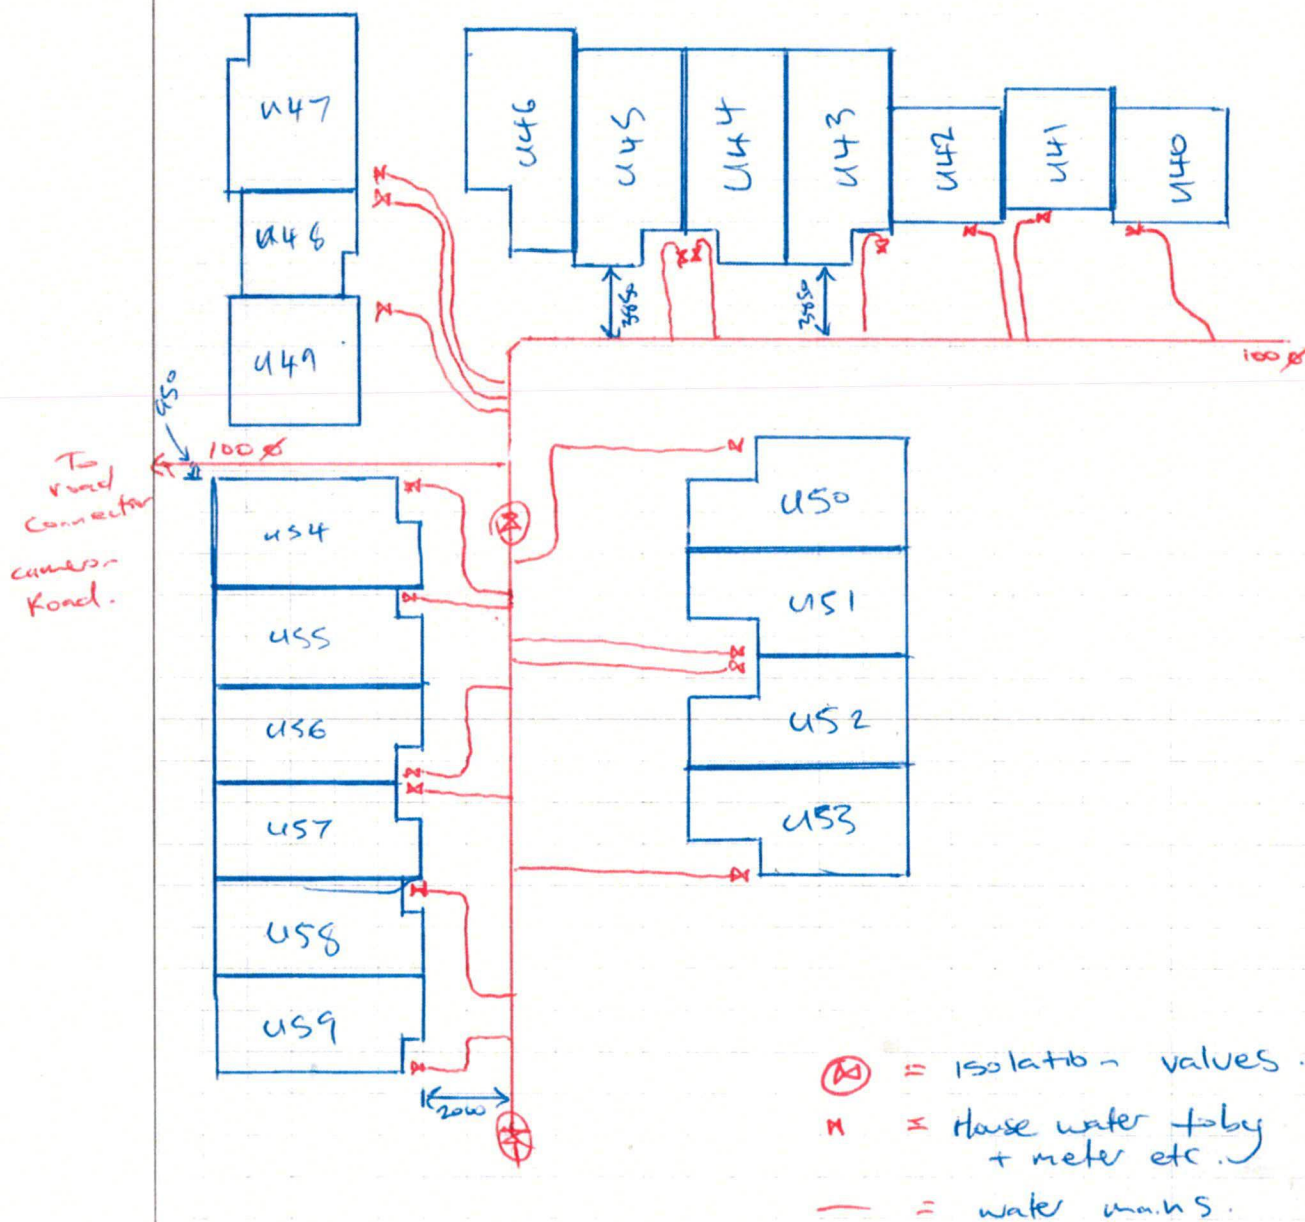


**As Laid Drainage**

Working Together

Building Consent Number: **2014/30895**Date: **5 / 2 / 15** No. of pages: **1**Address: **61 Cameron Rd.**Drain Layer Name: **Brad Kells**

[Please print clearly] Signature:

Registration Number: **12694**Business Name: **Laser Plumbing Ham West**To Council: [Tick] ☐ Hauraki ☐ Matamata Piako ☐ Waitomo ☐ Otorohanga ☐ Waipa ☐ Waikato ☒ Hamilton



As Laid Drainage

Working Together

Building Consent Number: 14 / 30895

Date: 30 / 1 / 15 No. of pages: 1

Building Address: 61 Cameron Rd


Drain Layer Name: A. Shepherd

[Please print clearly] Signature: *A. Shepherd*

Registration Number: 21608

Business Name: Titan Drainage

To Council: [Tick] ☐ Hauraki ☐ Matamata Piako ☐ Waitomo ☐ Otorohanga ☐ Waipa ☐ Waikato ☒ Hamilton

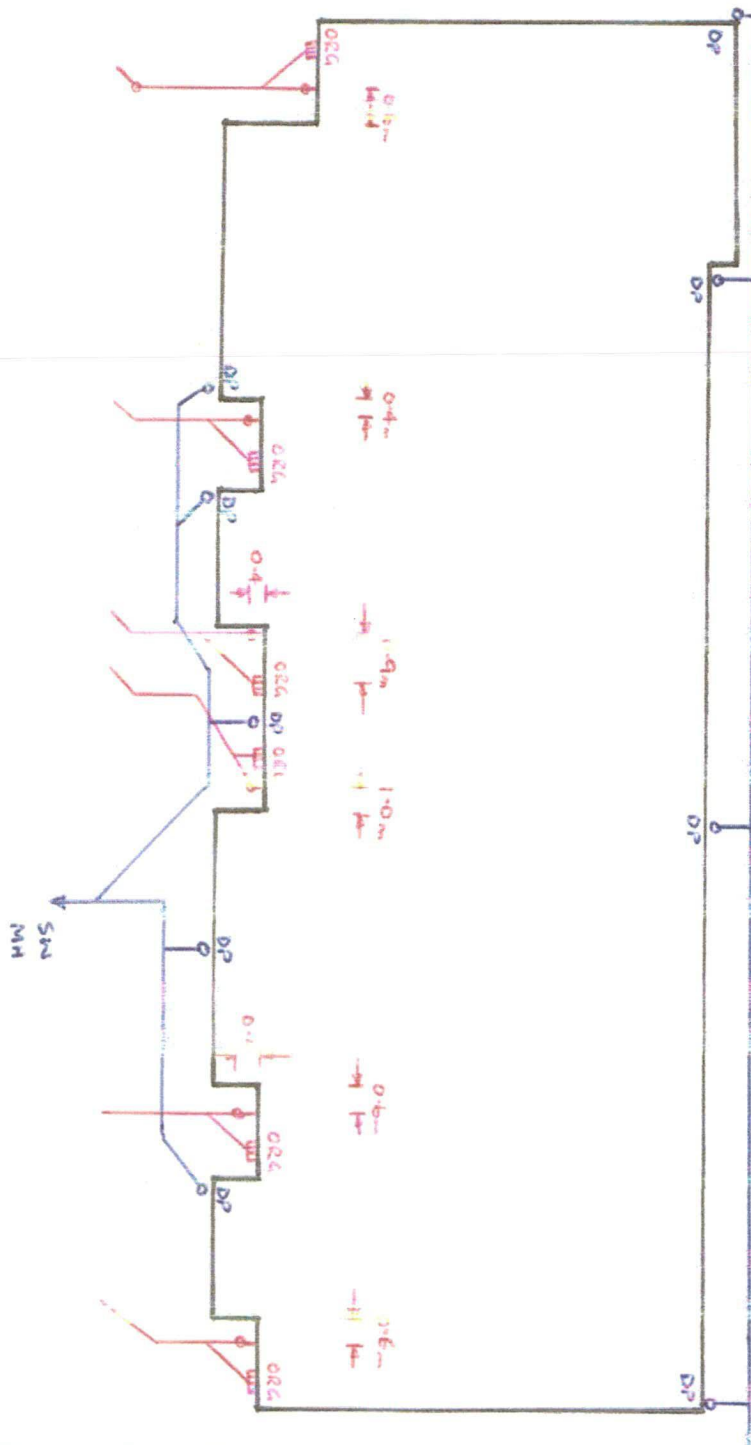

BLOCK
'A'



As Laid Drainage

Working Together

Building Consent Number: 14/30895

Date: 30 / 1 / 15 No. of pages: 1

Address: 61 Cameron Rd

Drain Layer Name: Allister Shepherd


[Please print clearly] Signature:

Allister Shepherd

Registration Number: 21608

Business Name: Titan Drainage

To Council: [Tick] ☐ Hauraki ☐ Matamata Piako ☐ Waitomo ☐ Otorohanga ☐ Waipa ☐ Waikato ☒ Hamilton

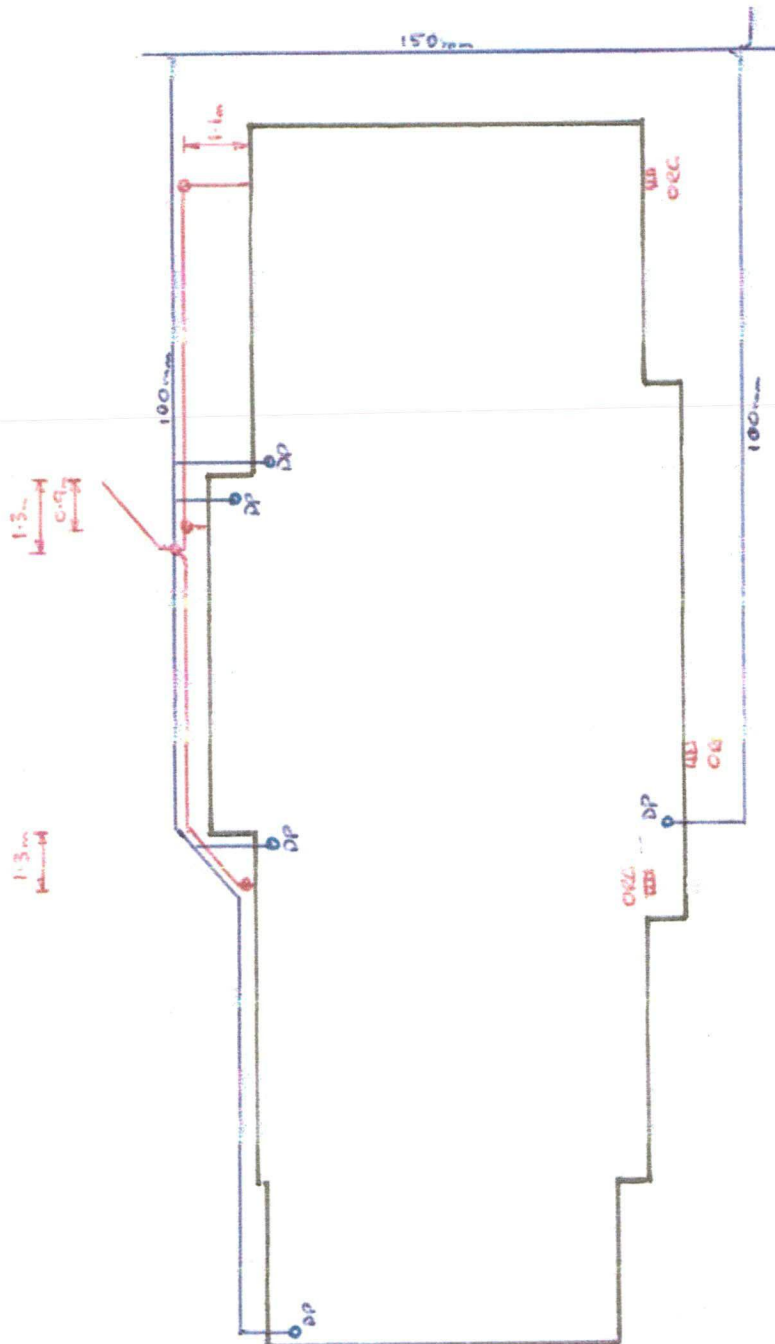



As Laid Drainage

Building Consent Number: 14/30895

Date: 30 / 1 / 15 No. of pages: 2 of 2

Building Address: 61 Cameron Rd

Drain Layer Name: A. Shepherd


[Please print clearly] Signature:

Registration Number: 21608

Business Name: Titan Drainage

To Council: [Tick] ☐ Hauraki ☐ Matamata Piako ☐ Waitomo ☐ Otorohanga ☐ Waipa ☐ Waikato ☒ Hamilton

BLOCK
'C'

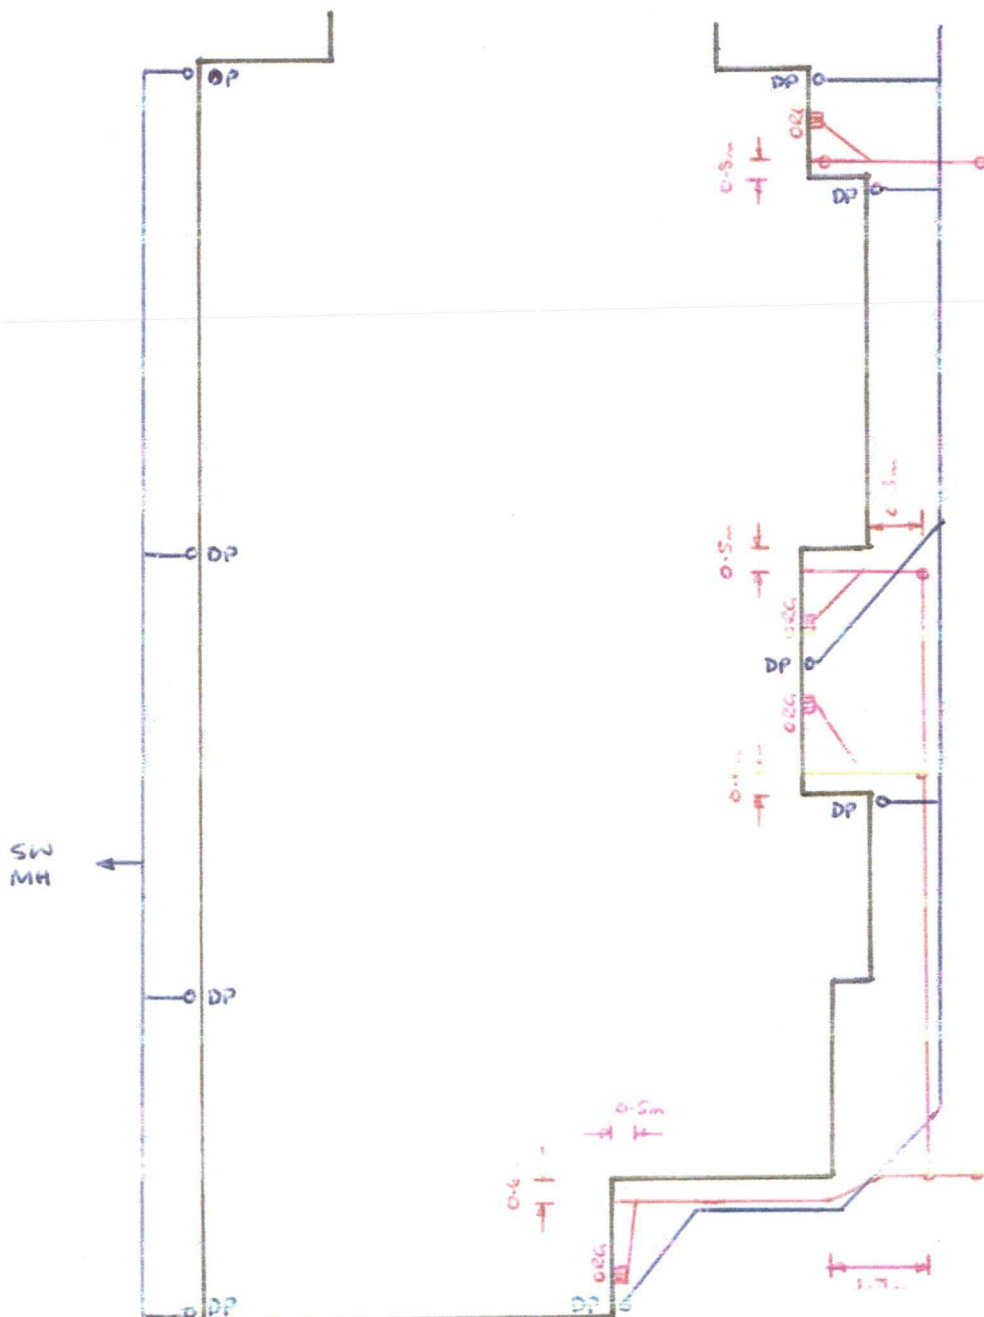



As Laid Drainage

Working Together

Building Consent Number: 14 / 30895
Building Address: 61 Cameron Rd
Drain Layer Name: A. Shepherd
Registration Number: 21608

Date: 30 / 1 / 15 No. of pages: 1 of 2

[Please print clearly] Signature: *A. Shepherd*
Business Name: Titan Drainage

To Council: [Tick] ☐ Hauraki ☐ Matamata Piako ☐ Waitomo ☐ Otorohanga ☐ Waipa ☐ Waikato ☒ Hamilton

BLOCK
'C'

