



July bin

1010

CITY OF ROTORUA

Valuation No. 654/756

APPLICATION FOR PERMIT TO CARRY OUT SANITARY PLUMBING AND DRAINAGE WORK
I, the undersigned, hereby apply for permission to have the work described herein and set out on the plans attached hereto, carried out in accordance with the provisions of the Drainage and Plumbing Regulations 1959 at premises situated at:

Address Corner Manahi Ave. & Teapara Cresc.

Legal Description:

8 Manahi Av.

Lot No. 10 ML 19427 Deposited Plan No.

Section No. Block No.

Description of Work: Plumbing & Drainage for residence

Name and address of Person for whom work is to be carried out:

Mr & Mrs P. I. L. AIKEN

Name and address of Registered Plumber: Mr F. Windner

Name and address of Registered Drainlayer: "

PLUMBING	1500.00	18.00
DRAINAGE	300.00	6.00
TOTAL	1800.00	24.00

Value of Work including Materials:

Plumbing: \$
Drainage: \$
Total: \$
Fee Enclosed: \$

See reverse for Fees and Notes.

Signature: P. I. L. Aiken

Date: 12. 7. 73

FOR OFFICE USE ONLY

Date Received

Fee Paid \$24.00 RCT 10339

Date Paid 23/7/73

Issue Approved

Date Approved 16/7/73

Permit No. 3374

Date Issued 24/7/73



FOR OFFICE USE ONLY

FEES PAYABLE ON THE ISSUE OF ANY PLUMBING OR DRAINAGE PERMIT
according to the Estimated Value of Work

Value of work (including value of fittings)

Dollars		Dollars
up to	100	1.50
101 -	200	3.00
201 -	400	6.00
401 -	600	8.00
601 -	800	10.00
801 -	1000	12.00
1001 -	1200	14.00
1201 -	1400	16.00
1401 -	1600	18.00
1601 -	1800	20.00
1801 -	2000	22.00

2001 and over, 1 dollar extra for every \$200 or part thereof in excess
of 2000 dollars.

IMPORTANT

INSPECTION & TESTING REQUIREMENTS

Drainage Work: Drainlayers are required to notify the Plumbing and Drainage Inspector when all work is completed. This includes effluent disposal systems for septic tanks. All drains will be tested with a 5ft head of water. To implement this test it will be necessary for persons undertaking drainage work to have sufficient drain plugs to fill all sections of the drain prior to the Plumbing and Drainage Inspector arriving on the job, also to have available a stand pipe to apply the 5ft head pressure.

This form of testing is essential to exclude the possibility of ground water infiltration with its attendant increase in pumping charges and overloading of the sewers and treatment plant.

Plumbing Work: Plumbers are required to notify the Plumbing and Drainage Inspector when work is ready for inspection as follows:

- (a) When the building has been initially piped out and wastes are installed (before wall linings are fixed and floors laid).
- (b) When work is complete.

Plans of Drainage and Plumbing work:

In the case of single houses a preliminary drainage plan will not be required. In all other cases, however, plans of the preliminary proposal are to be submitted at the time of application for a permit. In all instances, however, an "as laid" plan must be available on site as a prerequisite to a test of the work.

In commercial buildings full plans and elevations of plumbing stacks must be provided at the time of application for a permit.

Plans MUST show figured dimensions
and distances from section boundaries


Rotorua City Council

DRAINAGE PLAN

SCALE: IN. TO A FOOT

NEW SEWERAGE DRAINS—RED
STORMWATER—DOTTED BLACK
OLD DRAINS—FULL BLACK

654/756.

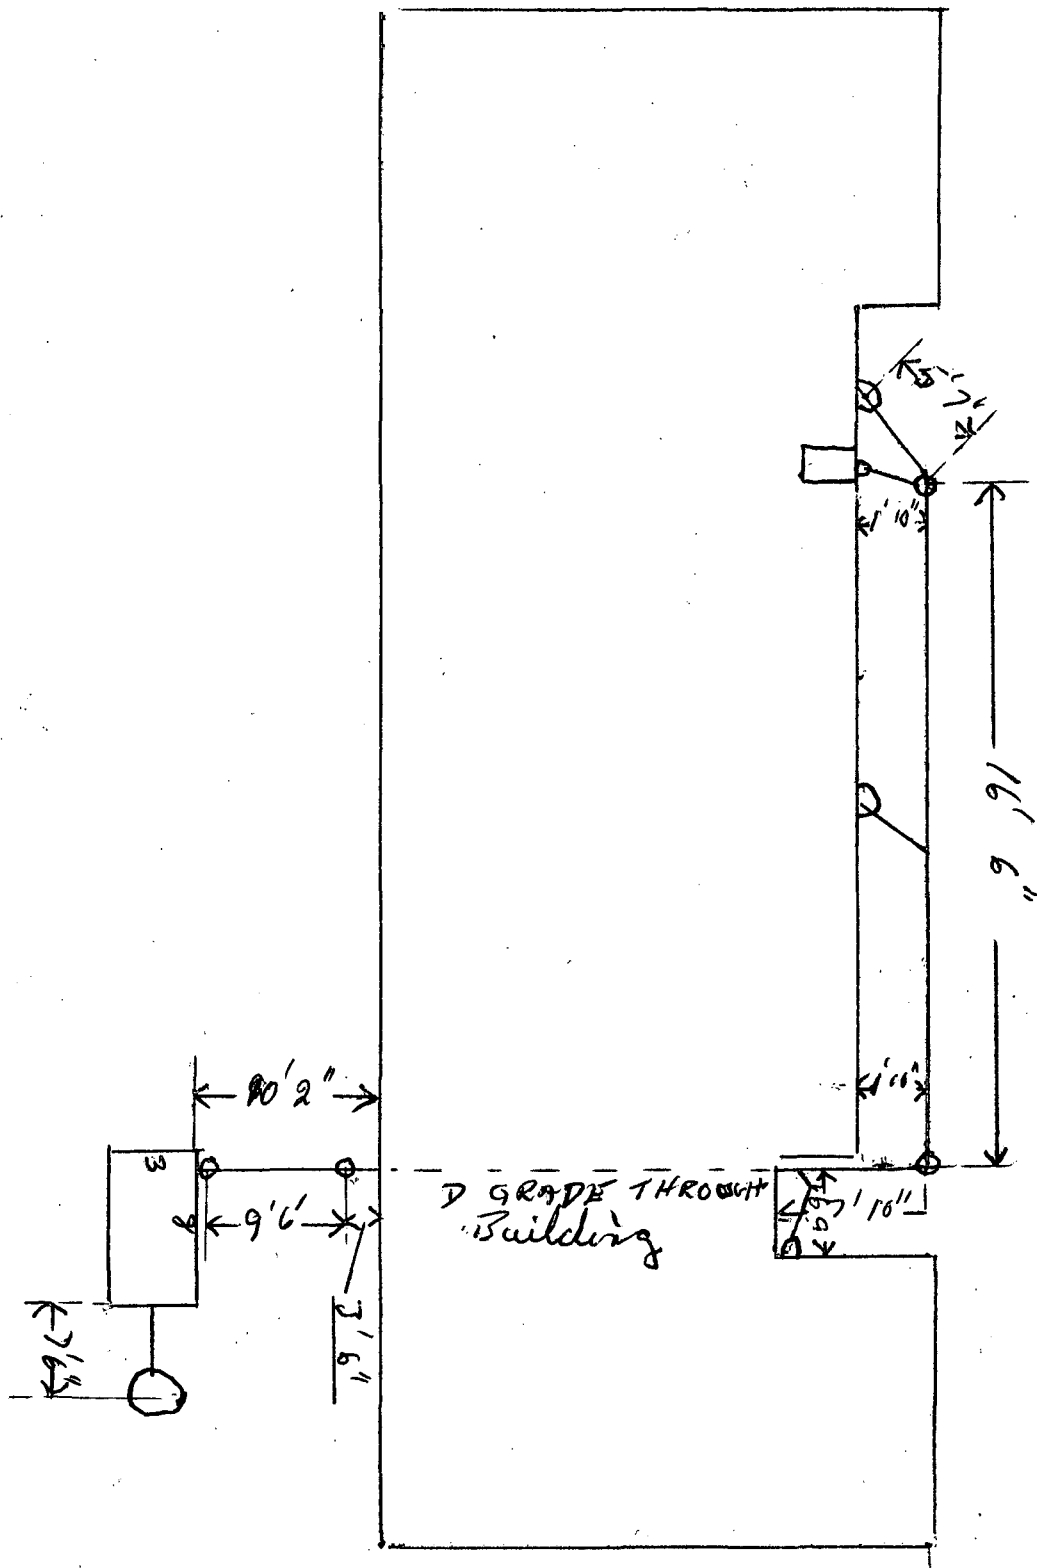

OWNER

P. ATKIN

No.

8

STREET

Monash Ave

LOT

10

SIGNATURE

OF DRAINLAYER

M.L. 19427

BL.

DATE

31-1-74