


Jubilee Flats.

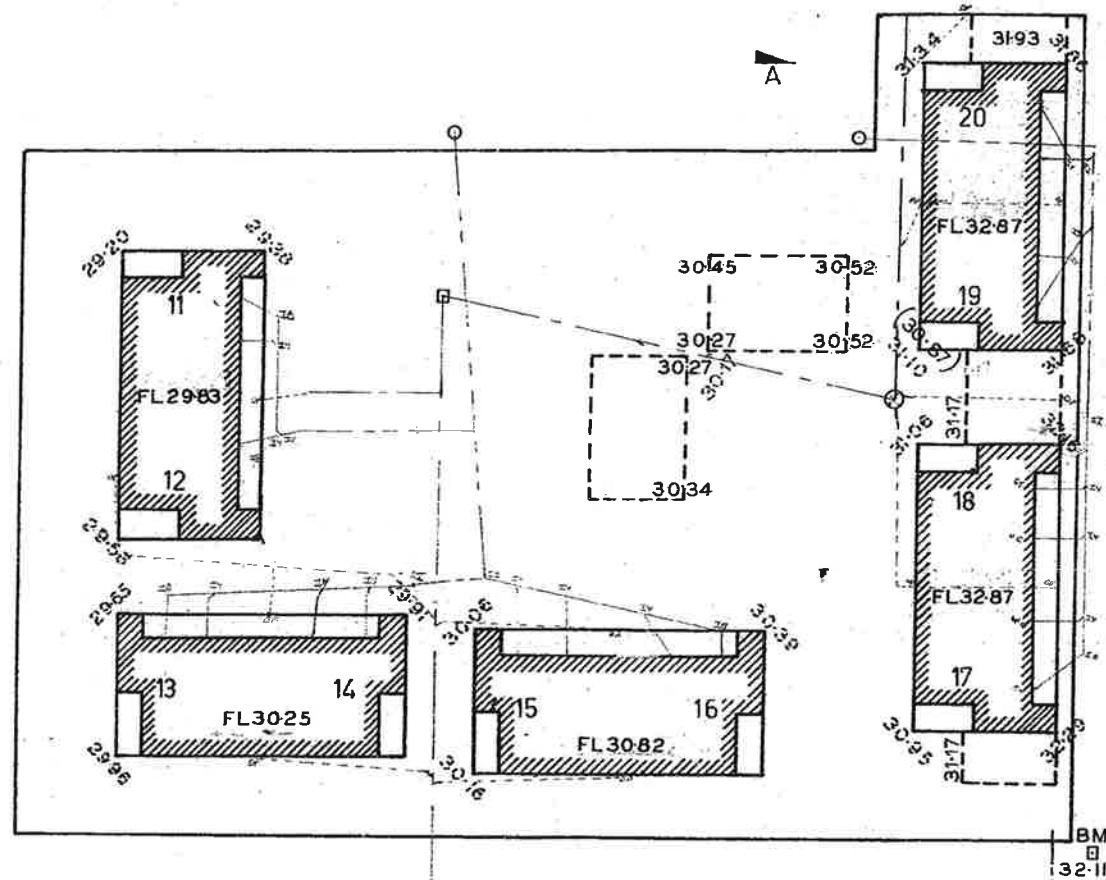

LEGEND

FINISHED CONCRETE LEVEL	30.25
FINISHED GROUND LEVEL	(30.67)
EXISTING GROUND OR PEG LEVEL	30.39
SANITARY SEWER	AS BUILT
STORMWATER	AS BUILT

NOTE

ELEVATIONS SCHEMATIC ONLY & NOT TO BE USED FOR BLOCK NUMBERS. NO FOOTINGS SHOWN.

A


B

C

D

E

F

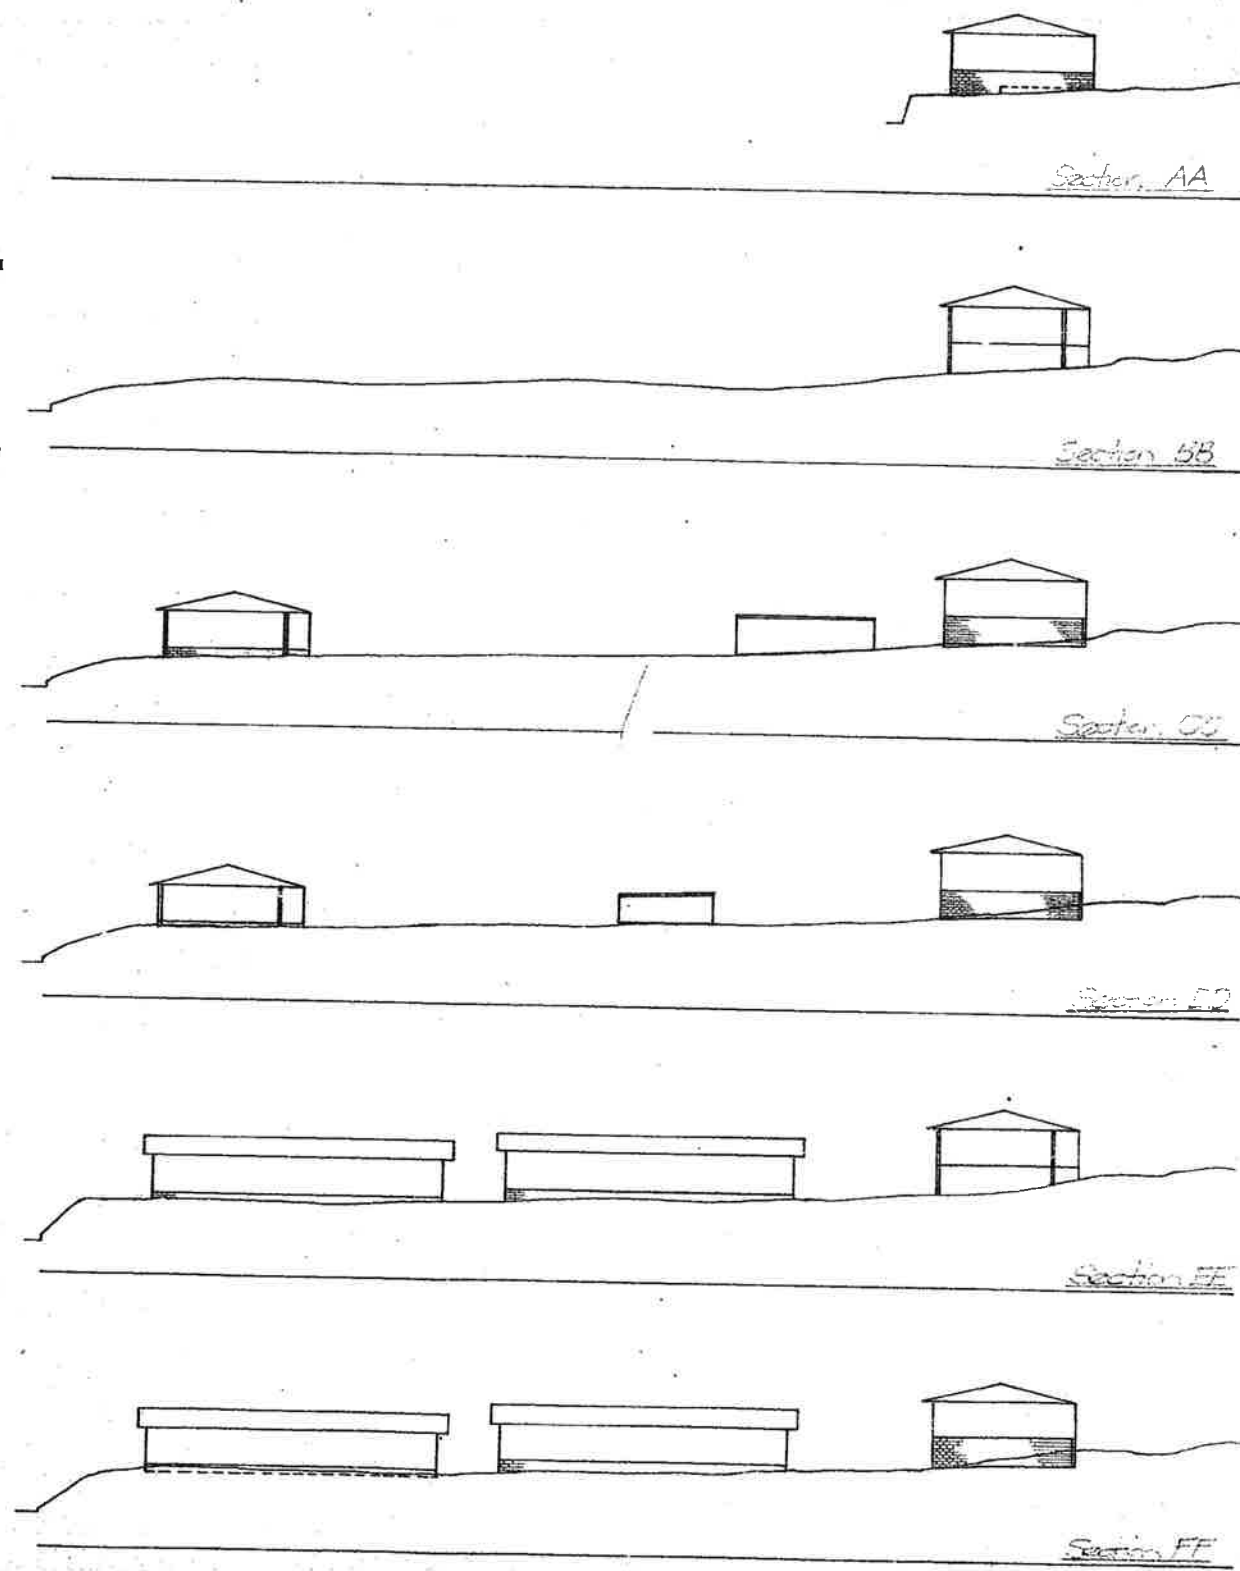

SURVEYED	2/77
DRAWN	2/77
DESIGNED	2/77
TRACED	2/77
CHECKED	2/77
APPROVED	2/77
REFERENCES	

PIAKO COUNTY COUNCIL

P.O. BOX 26 TE AROHA

F.W. Norton COUNTY ENGINEER

AMENDMENTS INITIAL DATE

SILVER JUBILEE FLATS

SITE PLAN

STAGE II

SHEET No. 2
OF 6 SHEETS

P.C.C. 982

SCALES
1:250

ORIGINAL LINE LENGTH BEFORE REDUCTION - 250mm