


AS BUILT SERVICES PLAN

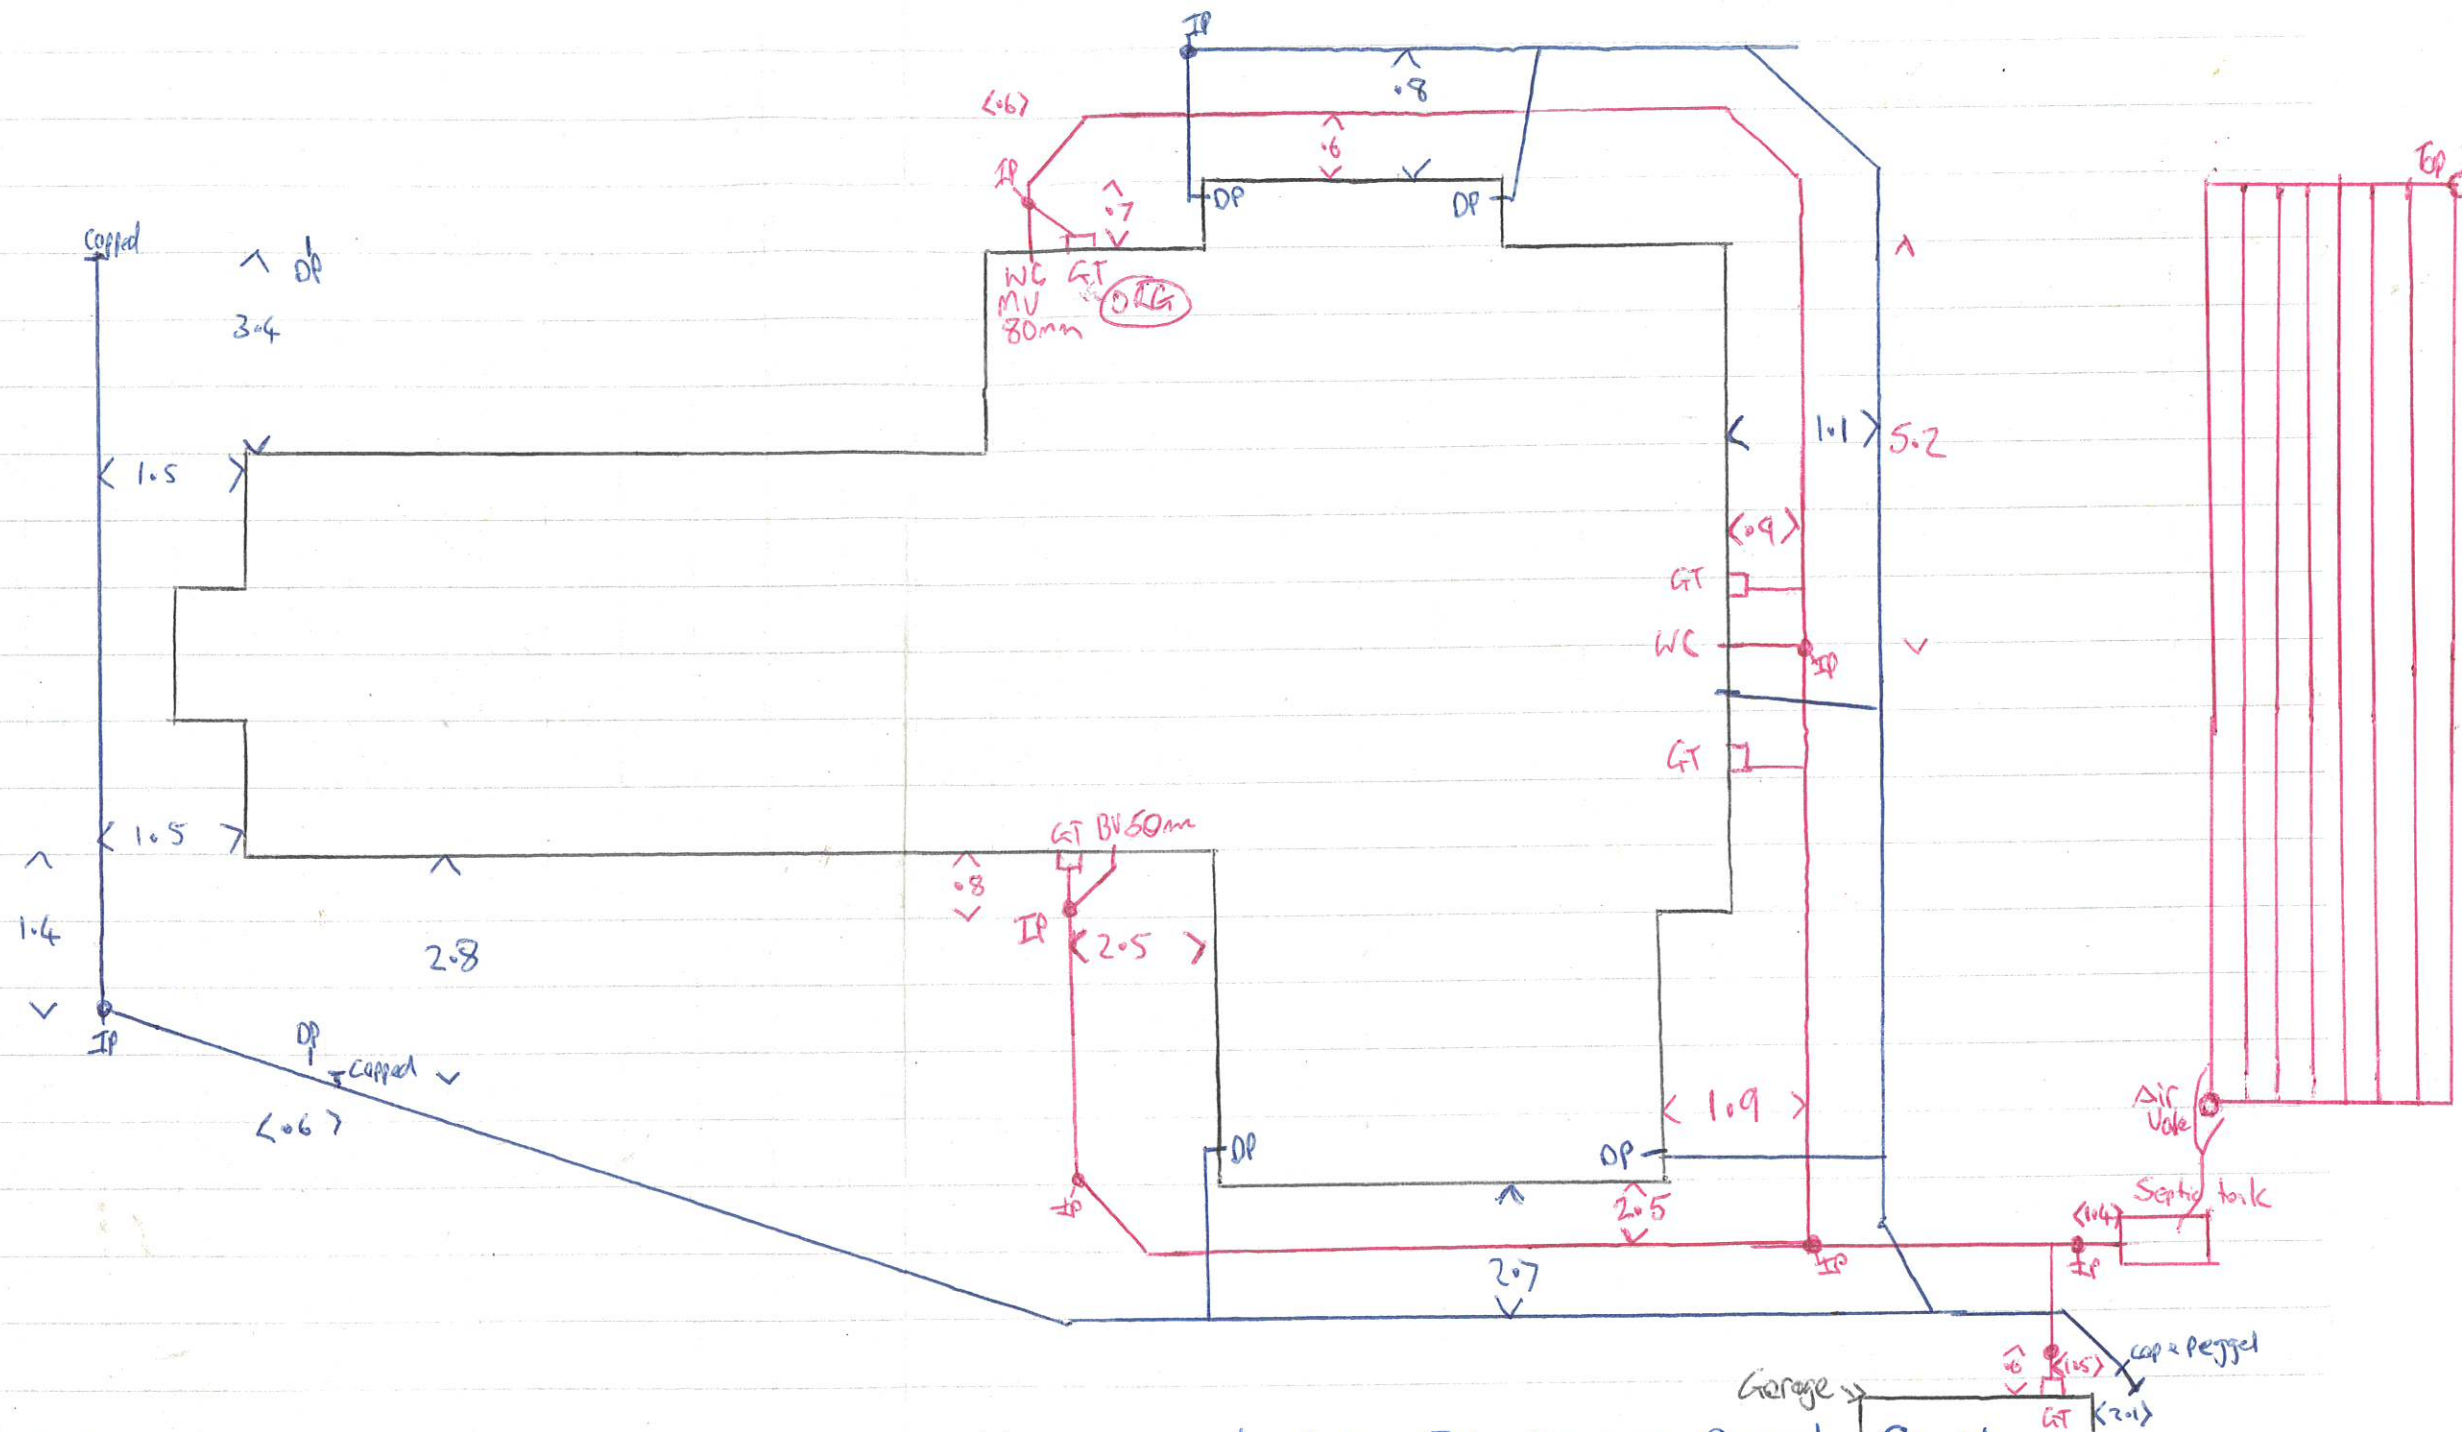

Client Name: Barry Walsh

Address: Lot 1, 71 Davis Road, Cust

Date: 7.12.23 Building Consent No: 230501

Gradient: Sewer 1:90 Stormwater 1:90

Drainlayer: _____ Registration #: _____

Certifying Drainlayer: Rene Paviell Registration #: 26217

Soak Hole Dimensions: 1. _____ L _____ W _____ D 2. _____ L _____ W _____ D 3. _____ L _____ W _____ D 4. _____ L _____ W _____ D

Peter Hansen
DRAINAGE LTD.