

SCALE
1/8 Inch to a Foot

BOROUGH OF KAWERAU
DRAINAGE PLAN

For Office Use

Permit No. 262
Date 1/4/57
Receipt No. _____
Amount £ 4 2

BOROUGH SEWER DRAIN - BLACK INK. STORMWATER - DOTTED BLACK INK. NEW DRAINS - RED INK. WATER CONNECTIONS - GREEN INK.
(Show Outside Taps—Red X Over Green)


OWNER _____ ADDRESS 32 Vogel Street, Section 15.

N.B. Plumber or Drainlayer.
Please use Standard Drawing
Ink. NOT a Ball Point Pen.

LEGAL DESCRIPTION
OF PROPERTY _____

Signature of Plumber _____
and/or Drainlayer H. J. O'Connell
Date of Application 14 JAN 1957
Signature of Inspector Allock
Date of Inspection _____

ROAD BOUNDARY OF SITE

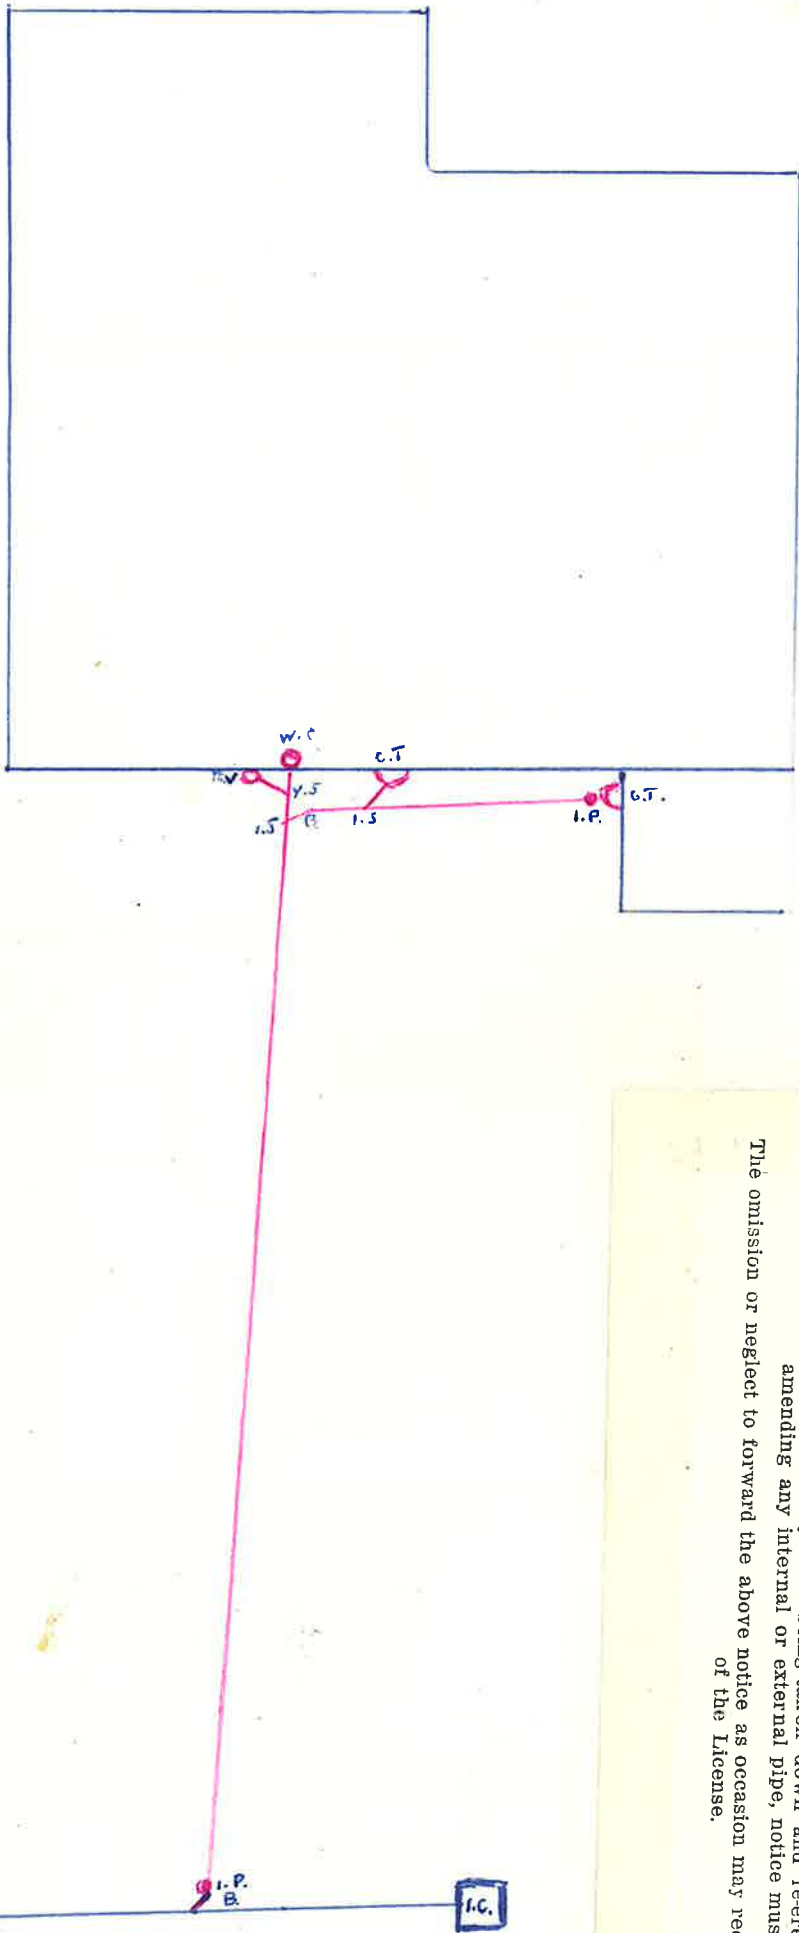

BOUNDARY OF SITE

**BOROUGH OF KAWERAU
SANITARY DEPARTMENT**

Permit No. 262
Plan No. _____

NOTICE OF INTENTION TO DO SANITARY
AND APPLICATION FOR PERMIT
DRAINAGE
PLUMBING

To the SANITARY INSPECTOR, Borough Offices, Kawerau.

I GIVE YOU NOTICE that I intend to carry out SANITARY DRAINAGE PLUMBING Work as under,
and hereby make Application for the necessary Permit.

Premises situated at No. 32 Vogel Street, Section No. 15

Owner, M _____ Address _____

Date on which work will be commenced _____ / _____ / 1957
Specification of Work Sanitary Sewer Draining
Value of Work £ 4 2 Fee herewith £ 10/-

Date 14 JAN 1957 (Signed) H. J. O'Connell Licensee.

Note—Should a stoppage involve any work being taken down and re-erected, or the breaking into and
amending any internal or external pipe, notice must be given.
The omission or neglect to forward the above notice as occasion may require will lead to the cancellation
of the License.