

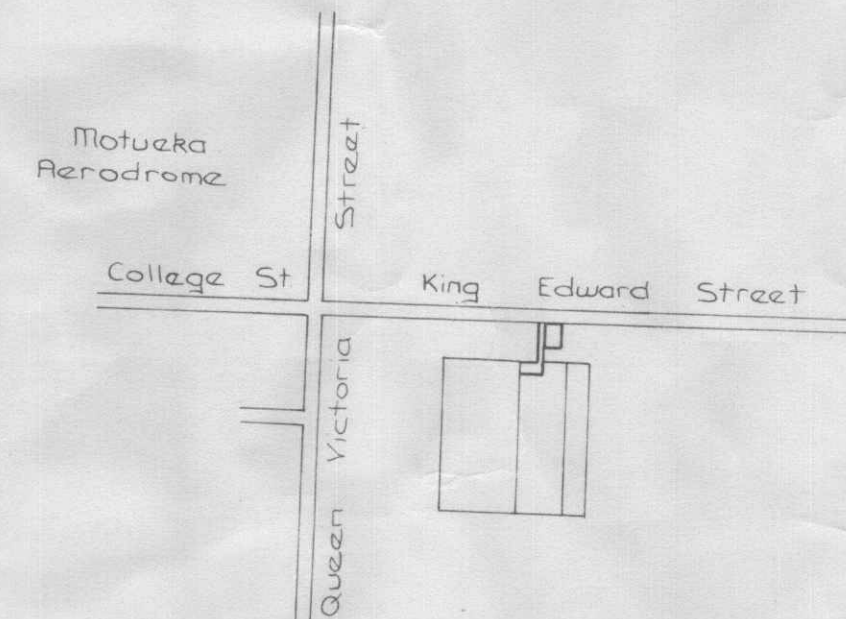
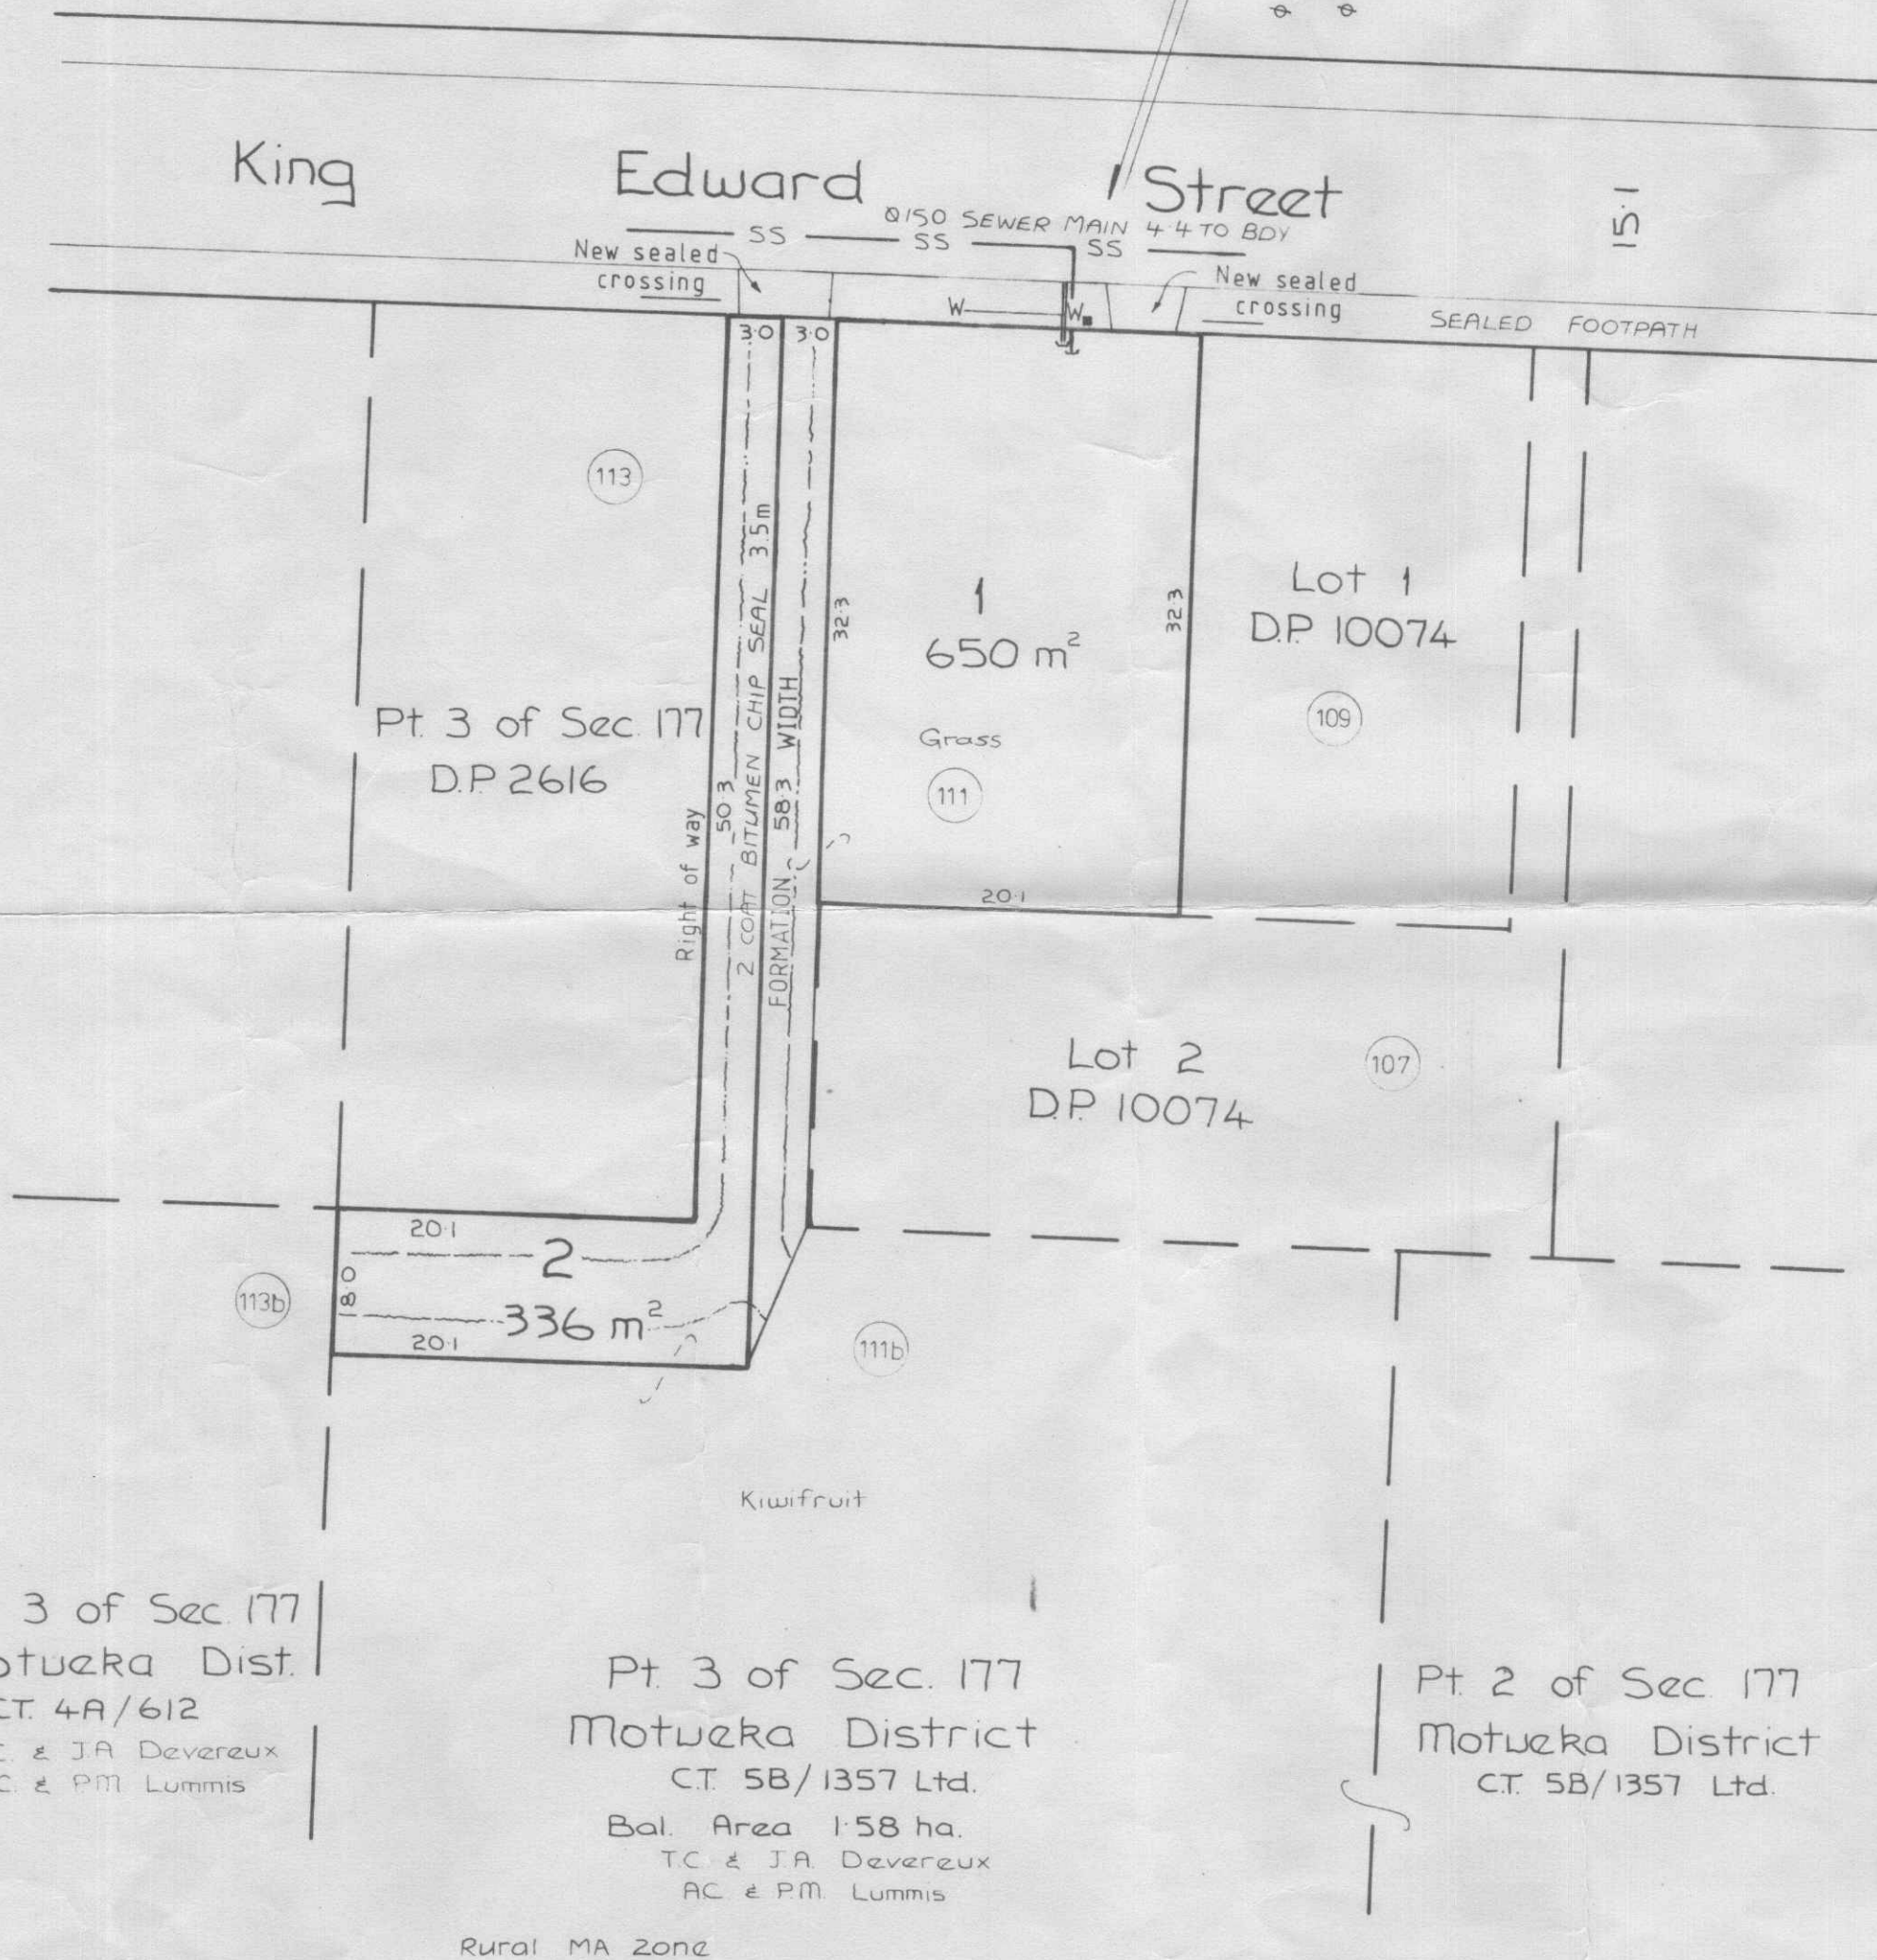


Distorted Diagram

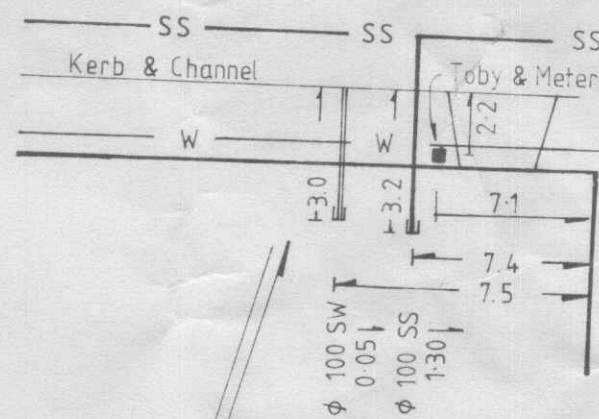

Location Diagram
Scale 1:10000

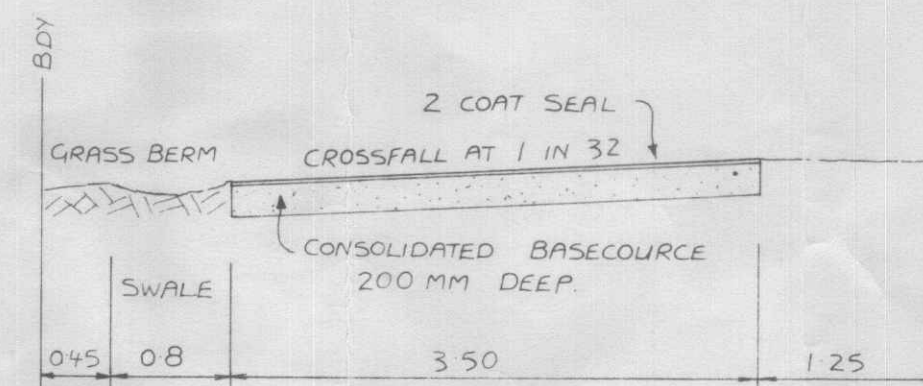

TYPICAL CROSS SECTION THROUGH R.O.W.

Pt 3 of Sec 177
Motueka Dist.
CT. 4A/612
T.C. & J.A. Devereux
A.C. & P.M. Lummis

Pt 3 of Sec. 177
Motueka District
CT. 5B/1357 Ltd.
Bal. Area 1.58 ha.
T.C. & J.A. Devereux
A.C. & P.M. Lummis

Pt 2 of Sec 177
Motueka District
CT. 5B/1357 Ltd.

Rural MA Zone

I hereby certify that this application for a
subdivision consent has been prepared in
accordance with Section 88 of the Resource
Management Act 1991.

Registered Surveyor
Registered Surveyor

'As - Built'

TDC Tasman District Council
Robinson MAY 95.
ENGINEERING MANAGER

TDC 2181

The subdivision was approved as a
activity on the day
of 19 subject to the
conditions noted in file

Subdivisions Officer

NOTES

- (1) Verify all dimensions on site.
- (2) Do not scale from drawing.

WARNING !

This Plan has been prepared for the purposes
of a Resource Consent Application only.
It is not a precise survey plan. As areas and
dimensions are likely to vary upon survey it
should not be attached to sale & purchase
agreements without an appropriate condition
to cover such variations.

Proposed Easement

Purpose	Shown	Subservient Tenement	Dominant Tenement
Right of Way	A	Lot 2 hereon	Pt 3 of Sec 177 CT 5B/1357 Ltd
	B	Pt 3 of Sec 177 CT 5B/1357 Ltd	Pt 3 of Sec 177 CT 4A/612

Nº Amendment Date

24 TUDOR ST
PO BOX 278 MOTUEKA
PHONE 0-3-528 7089
FAX 0-3-528 7089



STAIG & SMITH
(MOTUEKA) LIMITED

SURVEYORS • PLANNERS & RESOURCE MANAGERS

Proposed Amalgamation

Lot 2 hereon with Pt 3 of Sec. 177
Motueka Dist. CT. 4A/612.



Design
Drawn *BRC*
Checked
Approved *Signature*
Date May 1994

job title

Comprised in CT. 5B/1357 Ltd.

drawing title

'As-Built' for Subdn. of
Pt. 3 of Sec. 177
Motueka District

scale
1:400

job Nº 2060

sheet