



Hamilton City Council

Te kaunihera o Kirikiriroa

Private Bag 3010, Hamilton, New Zealand.

FAX: (07) 838 6684

BUILDING UNIT

AS LAID DRAINAGE PLAN

STREET: Arlington Court No: 5

LOT: 51 DPS

OWNER: Generation Homes

DRAINLAYER: DRAINAGE Systems


INSPECTOR: D. Hunt

REG No: 15635

DATE OF INSPECTION: 8.10.03

CONSENT No: 7452/2003

DRAINLAYER PLEASE FILL IN ALL DETAILS

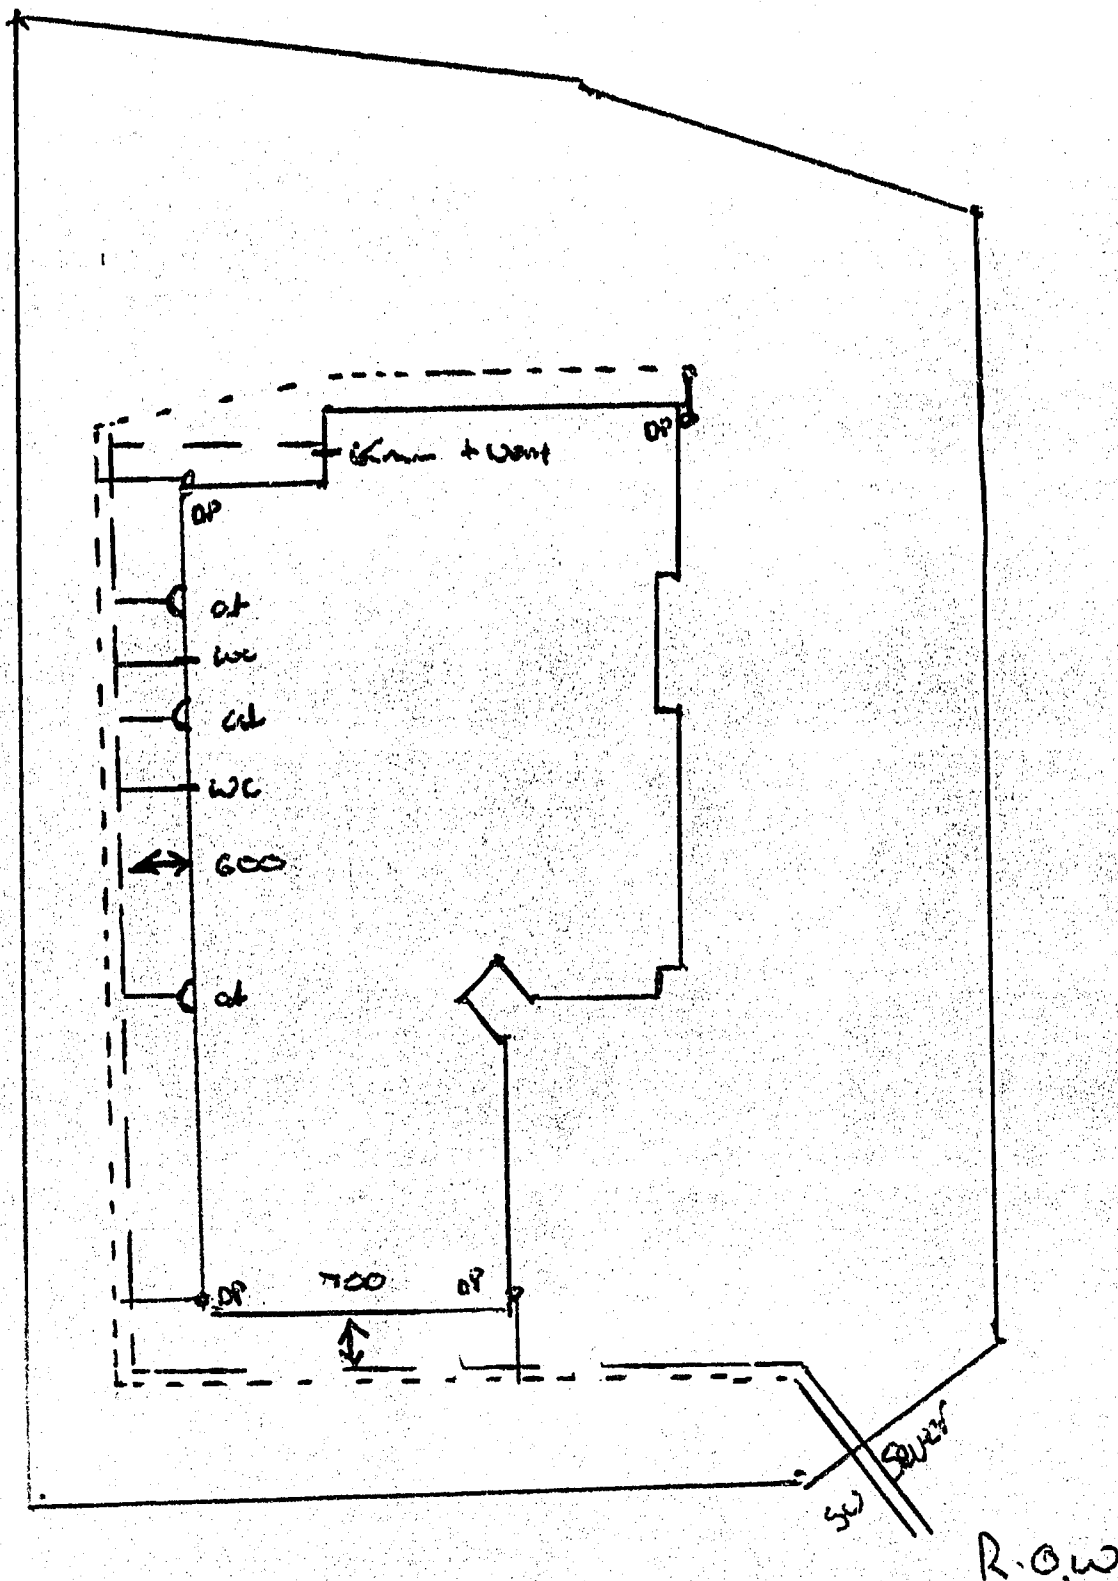

DRAINLAYER'S SIGNATURE: [Signature]

DATE: 8.10.03