

SITE SKETCH - STANDARD DRAINS

Customer Address

425 Armagh St
Lincolnton

Customer EQC Claim #


Assessment Date

2010/067031
2011/083517
2011/185021



Sketch Type (Circle Applicable)
As Built (Damage) / Proposed Repair

- Key**
- Existing Sewer Line
 - Existing Stormwater Line
 - Pavers / Driveway
 - Earthquake Damage
 - Tree
 - Kerb Outlet
 - Downpipe / Toilet Vent
 - SUMP
 - Non Earthquake Damage
- Abbreviations**
- Kerb Outlet - KO
 - SUMP
 - Down Pipe (S/W) - DP
 - Boundary Inspection Pipe
 - Type of Material
 - Earthenware - EW
 - Poly Vinyl Chloride - PVC
 - C/I - Cast Iron
 - Bends - show upstream direction
 - Left hand bend - LHB
 - Right Hand Bend - RHB
 - Inspection Bend - IB
 - Left Hand Inspection Bend - LHIB
 - Right Hand Inspection Bend - RHIB
 - Junction
 - Left Hand Junction - LHJ
 - Right Hand Junction - RHJ
 - Inspection Junction - IJ
 - Inspection Left Junction - ILJ
 - Inspection Right Junction - IRJ
 - Fixtures
 - Gully Trap - GT
 - Terminal Vent - TV
 - Main Vent - MV
 - Toilet - WC

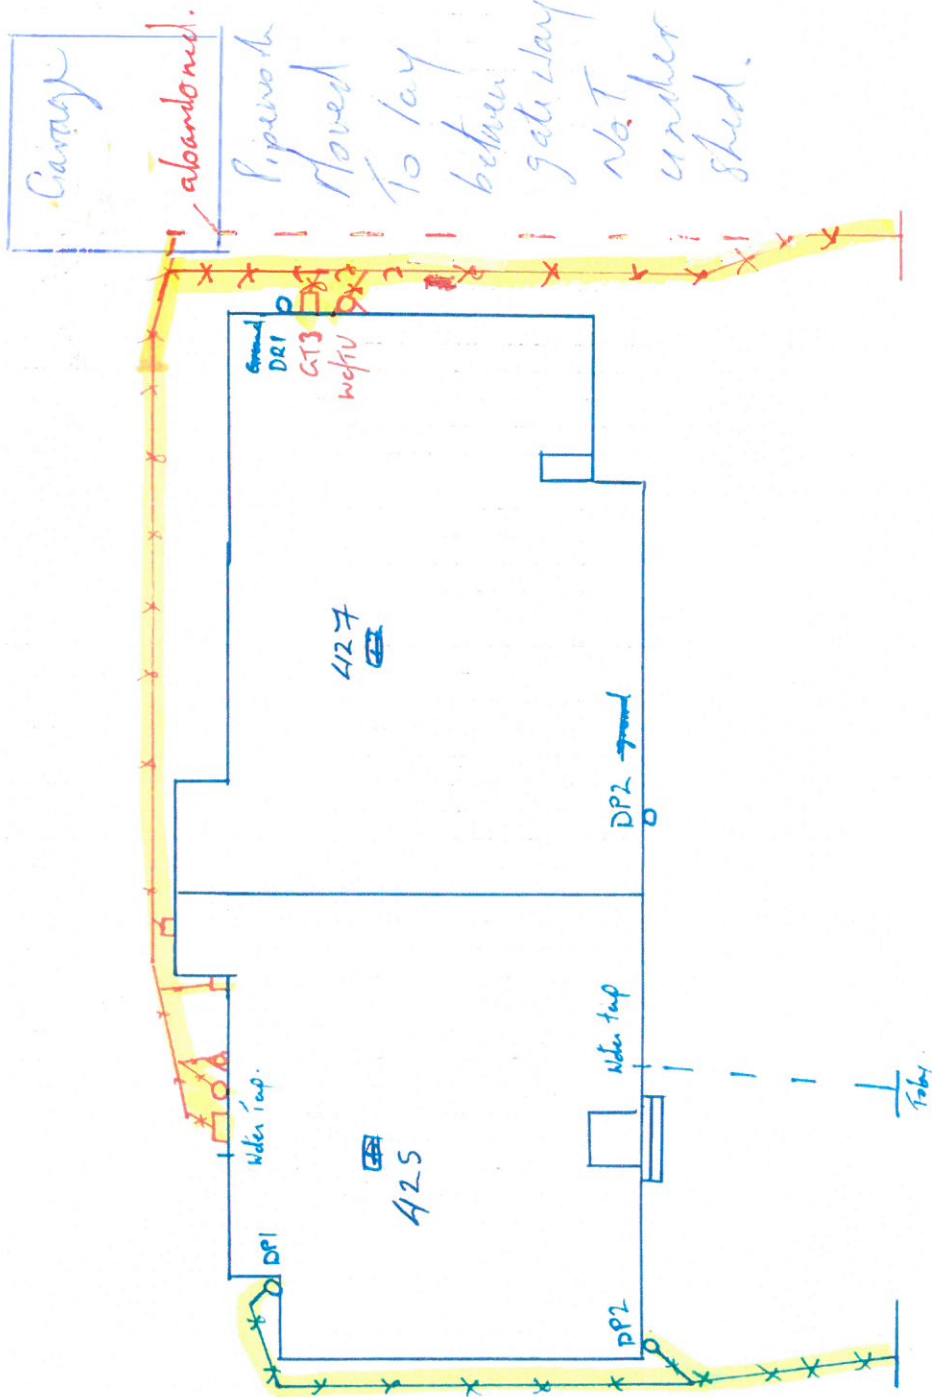

SITE SKETCH - STANDARD DRAINS

Customer Address

425 Armagh St
Lin. board

Customer EQC Claim #

2010/067031
2011/083517
2011/185021

Assessment Date



Sketch Type (Circle Applicable)

As Built (Damage) / Proposed Repair

Key

- Existing Sewer Line
- Existing Stormwater Line
- Pavers / Driveway
- Earthquake Damage
- Tree
- Kerb Outlet
- Downpipe / Toilet Vent
- SUMP
- Non Earthquake Damage

Abbreviations


- Kerb Outlet - KO
- SUMP
- Down Pipe (S/W) - DP
- Boundary Inspection Pipe
- Type of Material
- Earthenware - EW
- Poly Vinyl Chloride - PVC
- C/I - Cast Iron
- Bends - show upstream direction
- Left hand bend - LHB
- Right Hand Bend - RHB
- Inspection Bend - IB
- Left Hand Inspection Bend - LHB
- Right Hand Inspection Bend - RHB

Junction

- Left Hand Junction - LHJ
- Right Hand Junction - RHJ
- Inspection Junction - IJ
- Inspection Left Junction - ILJ
- Inspection Right Junction - IRJ

Fixtures

- Gully Trap - GT
- Terminal Vent - TV
- Main Vent - MV
- Toilet - WC

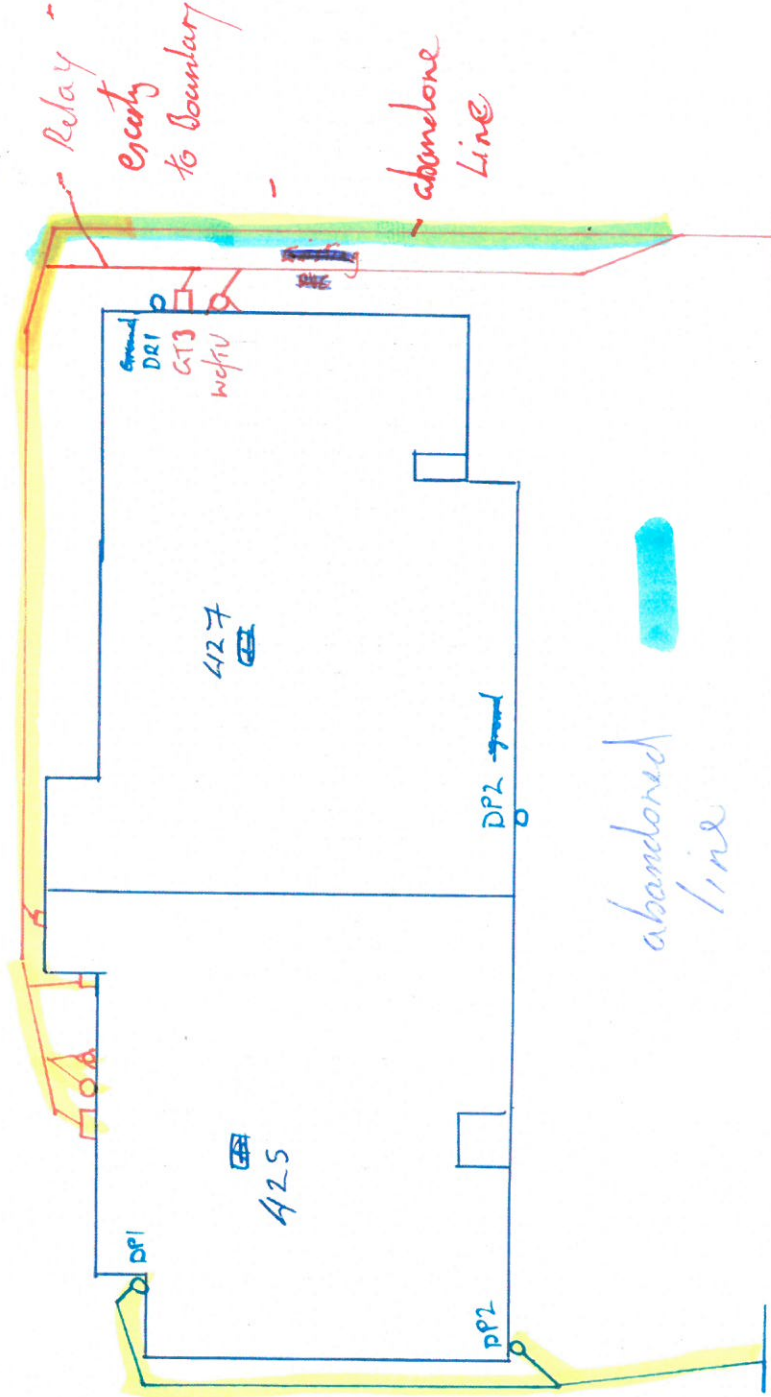

SITE SKETCH - STANDARD DRAINS

Customer Address

425 Armagh St

Lincoln

Customer EQC Claim #

2011/083517

Assessment Date

2011/11/18/2011



Sketch Type (Circle Applicable)

As Built (Damage) / Proposed Repair

Surface

Key

- Existing Sewer Line
- Existing Stormwater Line
- Pavers / Driveway
- Earthquake Damage
- Tree
- Kerb Outlet
- Downpipe / Toilet Vent
- SUMP
- Non Earthquake Damage

Abbreviations

- Kerb Outlet - KO
- SUMP
- Down Pipe (S/W) - DP
- Boundary Inspectionm Pipe
- Type of Material
- Earthenware - EW
- Poly Vinyl Chloride - PVC
- C/I - Cast Iron
- Bends - show upstream direction
- Left hand bend - LHB
- Right Hand Bend - RHB
- Inspection Bend - IB
- Left Hand Inspection Bend - LHIB
- Right Hand Inspection Bend - RHIB
- Junction
- Left Hand Junction - LHJ
- Right Hand Junction - RHJ
- Inspection Junction - IJ
- Inspection Left Junction - ILJ
- Inspection Right Junction - IRJ
- Fixtures
- Gully Trap - GT
- Terminal Vent - TV
- Main Vent - MV
- Toilet - WC

