


Lot D.P. *ATAWHAI* *DRIVE* Street No. *834*

Owner	Insp. Date	Description of Work	Inspector
	<i>19/5/92</i>	<i>SEWER TO NEW HOUSE.</i>	<i>BRUCE PARKER.</i>

LOPPER INTERNAL PIPING TESTED.

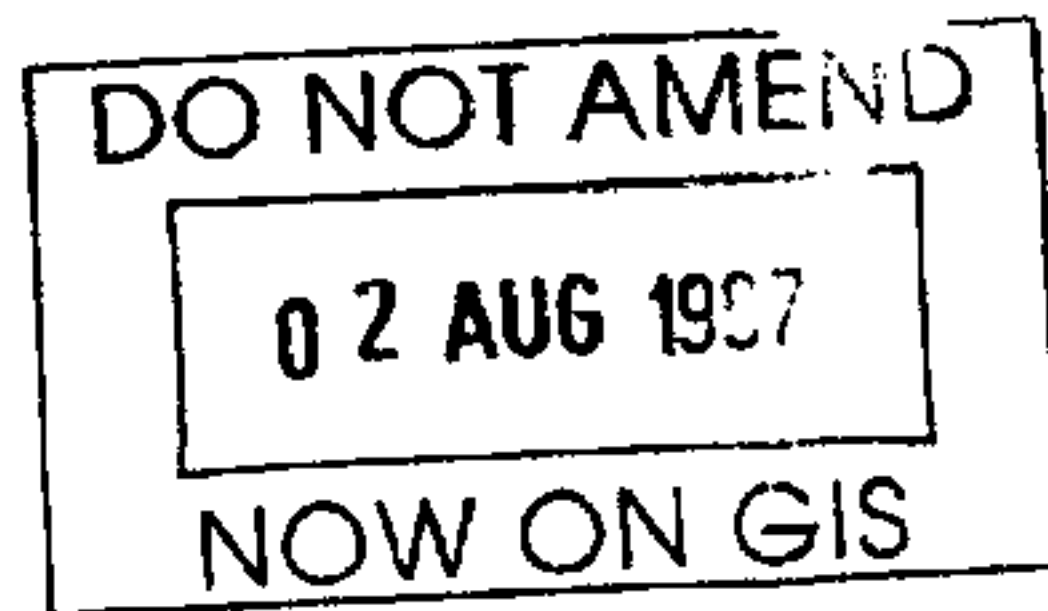

Drainlayer *N. LING* *PLUMBER - R. COOPER*

Drainage Card, Nelson City Council

Bdy

NEW
HOUSE.

GT
.5
.3
.5
.6
.7
(.4)

3.4

1.8

6.4

EXIST

1.3

EXISTING 2
FLATS.

EXIST

ATAWHAI CRES.