




NEW PLYMOUTH  
DISTRICT COUNCIL  
newplymouthnz.com

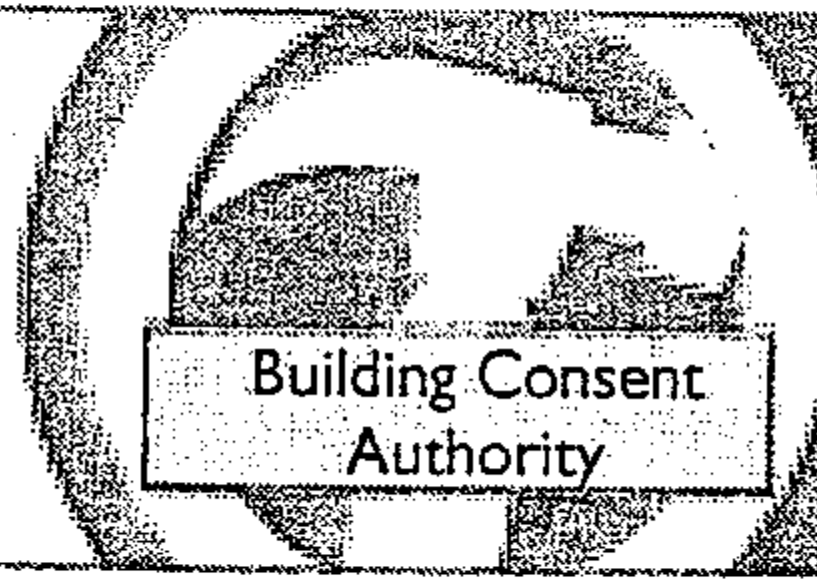


## AS-BUILT DRAINAGE PLAN

Building consent BC: 09/108312 Address: 39 BELT RD NEW PLYMOUTH.

Drainlayer: Tobias Drainage Registration No. 19543

Date: 25.11.09

PI 016168

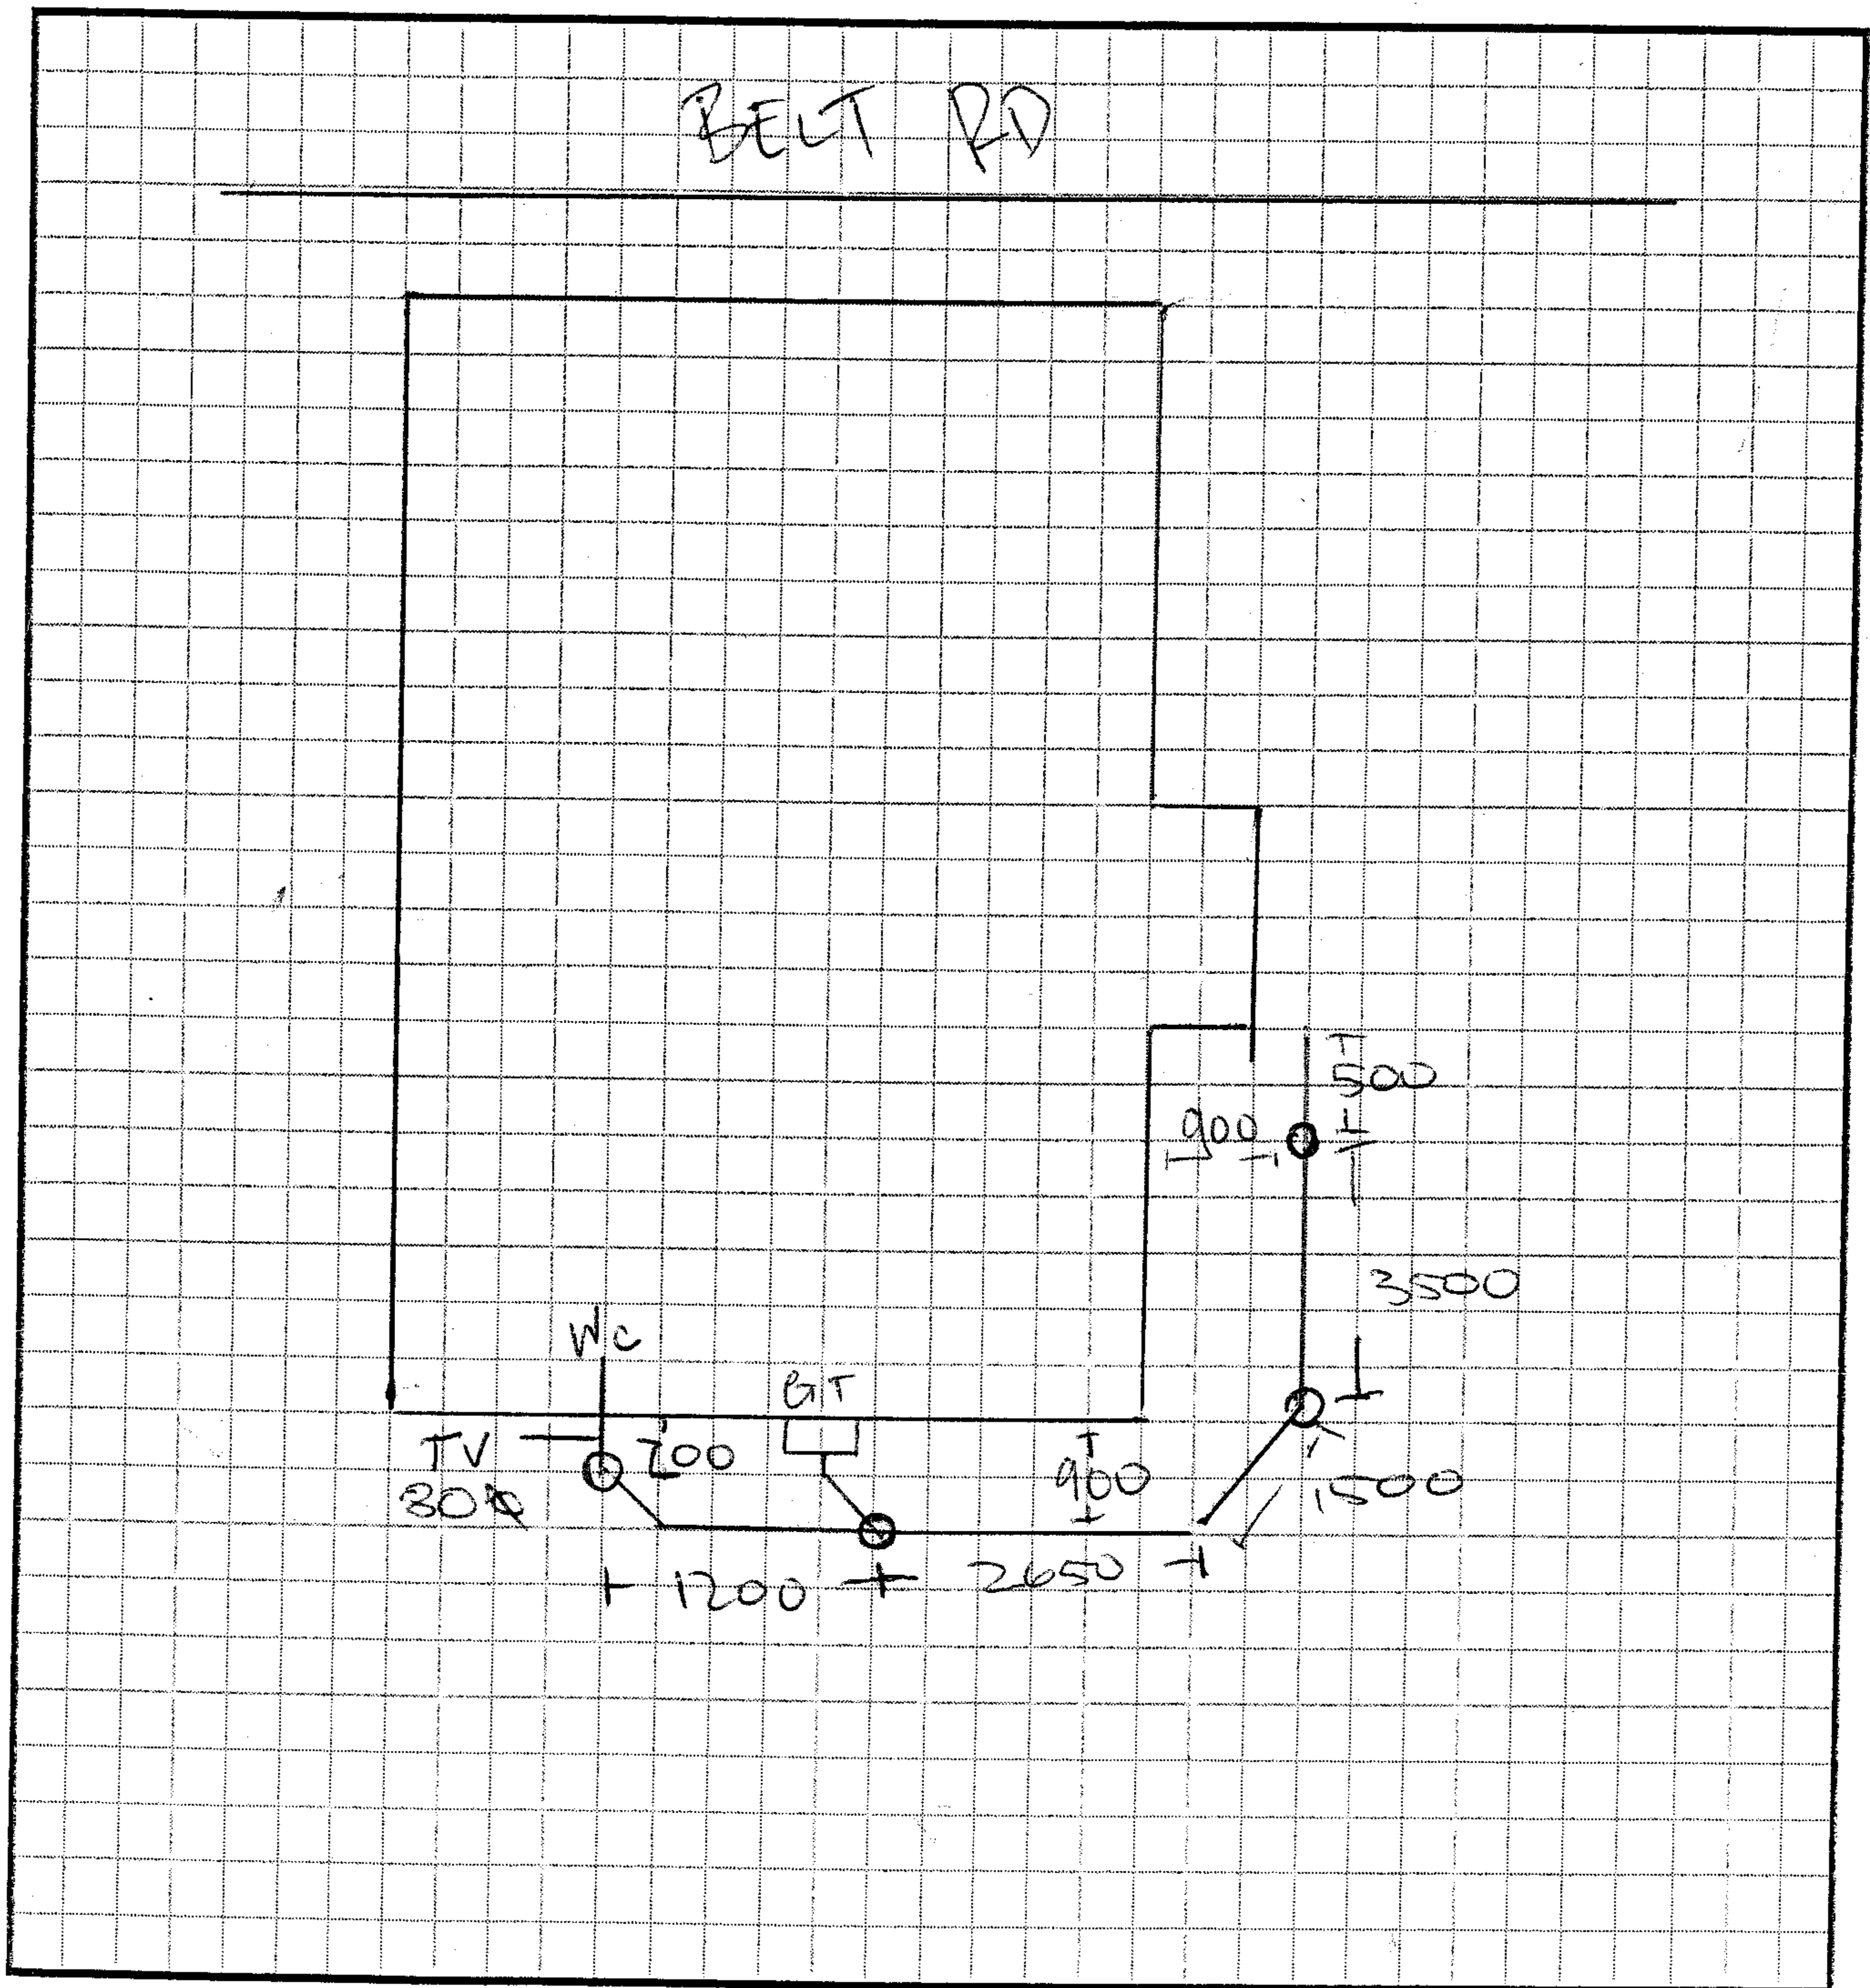

Specify system used:



G13/AS1



AS/NZS: 3500

Note: Show terminal vent size, location,  
and all relevant dimensions to inspection points

Receipt by the NPDC of this record does not imply endorsement of its accuracy.