

As Built

Drainage Plan



Tauranga City

Property File: P 4965/11/1

ENTERED

Tauranga City Council
Private Bag 12-022 Tauranga
Phone 07 577 7000
Fax 07 577 7034
Website www.tauranga.govt.nz



11 Palomino



Environmental Services

As Built

Drainage Plan



Tauranga City

Drainage Plan for


Tauranga City Council
Private Bag 12-022 Tauranga
Phone 07 577 7000
Fax 07 577 7034
Website www.tauranga.govt.nz

Street Number 11 Street Name Palamiro
Lot 158 DP 324280
Suburb Flansfeld
Owner Prime Ten Ltd
Type of Building House
Drainlayer AK Drainage Ltd
Date of Inspection Inspector
Drainage Permit No ~~1038~~ 14902

Note : Plan to be drawn in black ballpoint on graph opposite

Plan to include:

1. The correct position of the drains in relation to the building and boundaries.
2. The position of the street frontage.
3. Depth of drains at connection point.
4. Both foulwater and stormwater drains to be drawn.
5. Clearly define all inspection openings, with accurate measurements from two points.
6. Clearly define all buildings and boundaries.
7. Refer to example drain plan back page.

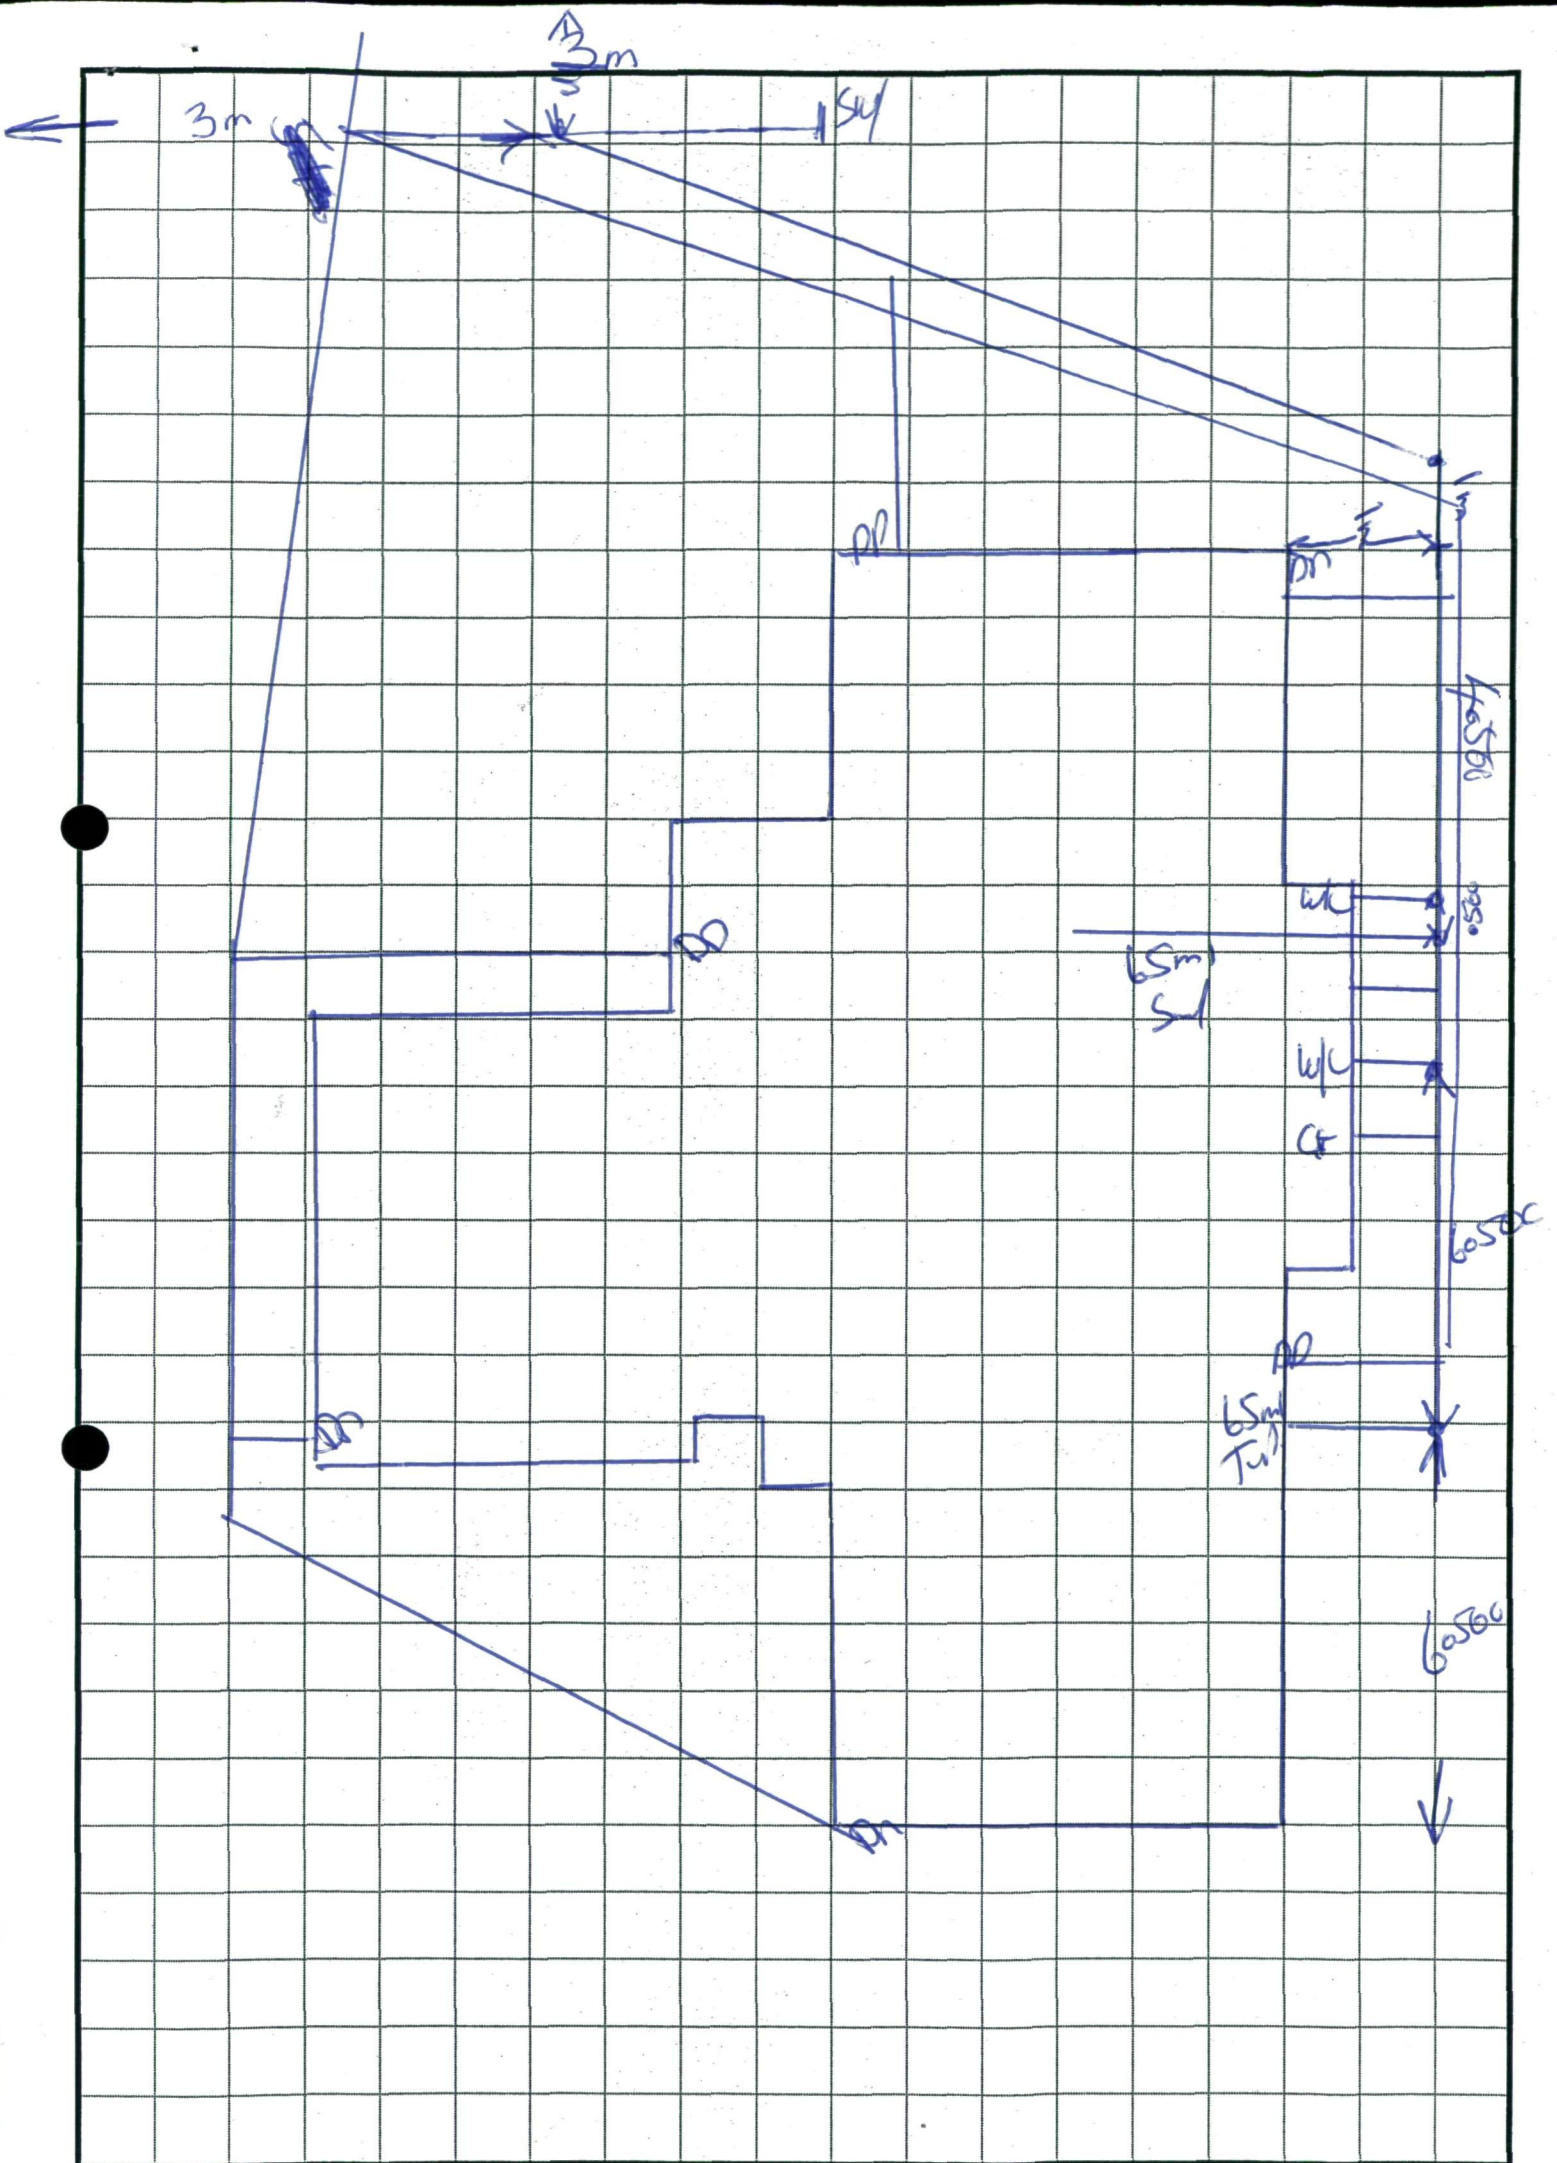

As Built

Drainage Plan

Plan Example

