

Contents

Dunedin City Council – Land Information Memorandum	1
Property Address: 6 Martin Close Waikouaiti	1
Prepared for: Priscilla Seixas Brum Wilding	1
Prepared on: 19-May-2026	1
Property Details:	1
Disclaimer:	1
s44A(2)(a) Information identifying any special feature or characteristics of the land	4
District Plan Hazard Information	4
Other Natural Hazard Information	4
Flood Hazards	4
Land Stability Hazards	4
Coastal Hazards	4
Seismic Hazards	4
Other Natural Hazards	4
Otago Regional Council Hazard Information	5
Contaminated Site, Hazardous Substances and Dangerous Goods	5
Contaminated Site Information	5
Historic Dangerous Goods Licence(s)	5
Hazardous Substances	5
s44A(2)(b) Information on private and public stormwater and sewerage drains	5
Drainage	5
Foul Sewer and Waste Water	5
Public Sewer Sheets	6
Dunedin City Council Private Drainage plans incomplete	6
s44A(2)(bb) Information Council holds regarding drinking water supply to the land	6
Water Supply	6
s44A(2)(c) Information relating to any rates owing in relation to the land	6
Rates Details	6
Rates Assessment Details	6
s44A(2)(d) Consents, Certificates, Notices, Orders or Requisitions affecting the land or any buildings on the land	7
(da) the information required to be provided to a territorial authority under section 362T(2) of the Building Act 2004:s44A and	7
(2)(e) Information concerning any Certificate issued by a Building Certifier pursuant to the Building Act 1991 or the Building Act 2004	7
Building and Drainage Consents	7
Building and Drainage Permits	8
Building Notices	8
Resource Consents	8
Consent Notices	9
Alcohol Licensing	9
Health Licensing	9
s44A(2)(ea) Information notified under Section 124 of the Weathertight Homes Resolution Services Act 2006	9
s44A (2)(f) Information relating to the use to which the land may be put and any conditions attached to that use	9
District Plan	9

District Plan Map	10
s44A(2)(g) Information regarding the land which has been notified to Council by another statutory organisation.....	10
s44A(2)(h) Information regarding the land which has been notified to Council by any network utility operator pursuant to the Building Act 1991 or Building Act 2004	10
Section 44A(3) Information concerning the land as the authority considers, at its discretion, to be relevant.....	10
Building Information.....	10
Drainage	10
Minimum Floor Levels	11
Planning.....	11
Resource Consents within 50m of 6 Martin Close Waikouaiti	11
Other Planning Comments	18
3 Waters	20
Information Regarding Watercourses	20
Transport	20
Glossary of Terms and Abbreviations.....	21
Consent, Permit, Licence & Complaint types	21
Terms used in Permits & Consents.....	21
General terms.....	22
Appendices	23

s44A(2)(a) Information identifying any special feature or characteristics of the land

District Plan Hazard Information

Refer to District Plan for Natural Hazards Information *section: s44A (2)(f) Information relating to the use to which the land may be put and any conditions attached to that use.*

Other Natural Hazard Information

Flood Hazards

No information.

Land Stability Hazards

EXPANSIVE SOILS

Expansive Clays Area 2H

Description: Expansive clays occur in this area. If expansive clay is present on the site, then foundations must be specifically designed to accommodate shrink/swell movement. The areas were captured from Soil map of Waikouaiti County, Otago, New Zealand / soil survey by I. B. Campbell ; F. J. Tindall, chief cartographer ; drawn by Margaret P. Francis. Date: 1971 , New Zealand Soil Bureau map ; 76. Department of Scientific and Industrial Research. The captured areas only limited to the Excerpt published.

Reference Number: 10108

Coastal Hazards

No information.

Seismic Hazards

FAULT

Silver Stream - Merton

Description: This report presents a general outline of the locations and character of active geological faults and folds in the Clutha and Dunedin City districts. The work described in this report is based on a desktop review of information from regional-scale geological mapping and from more detailed published or open-file geological studies relevant to understanding active faults in the two districts. This project involved the compilation of a Geographic Information System (GIS) dataset that gives the locations of active faults and folds delineated in the two districts. The interpretations and geographic positionings of the faults and folds were aided, where available, by topographic information from airborne LiDAR scans (laser radar) and from satellite, aerial or ground-based photographic archives.

Barrell, D.J.A. (2021). *General distribution and characteristics of active faults and folds in the Clutha and Dunedin City districts, Otago*. GNS Science.

<https://www.orc.govt.nz/media/10002/active-faults-folds-in-the-clutha-and-dunedin-city-districts-otago-2021.pdf>

Commissioned by: Otago Regional Council

Purpose: To describe the general distribution and characteristics of active faults and folds in the Clutha and Dunedin City districts of Otago, to assist with the identification and assessment of earthquake hazard for land-use planning purposes.

Scope of report: The Clutha District and Dunedin City District areas of Otago Region

Reference Number: 12094

Other Natural Hazards

No information.

Otago Regional Council Hazard Information

The Regional Council is required to provide information that it holds on Natural Hazards:

<https://www.orc.govt.nz/managing-our-environment/natural-hazards/otago-natural-hazards-database>

Contaminated Site, Hazardous Substances and Dangerous Goods

Contaminated Site Information

No information.

Historic Dangerous Goods Licence(s)

No information.

Hazardous Substances

No information.

WARNING – Change in legislation and management of hazardous substances

On 1 April 2004, all Dunedin City Council Dangerous Goods Licences expired. From this date they became the responsibility of the Environmental Protection Authority (EPA) under the Hazardous Substances and New Organisms Act 1996.

All new licences for hazardous substances were issued by independent Test Certifiers approved by the EPA. The Council no longer holds current information on the use of hazardous substances at these premises and hazardous substances may be present without the Council's knowledge.

The Council was advised by the EPA in 2016 that Worksafe had taken over responsibility for managing Location Test certificates under the Hazardous Substances and New Organisms Act 1996. The EPA no longer hold any information in relation to Location Test Certificates. If you have any questions, please contact Worksafe.

s44A(2)(b) Information on private and public stormwater and sewerage drains

Drainage

Drainage plans on file are indicative only.

Obtaining your own independent review may be required before commencing drainage works.

Foul Sewer and Waste Water

Drainage Reticulation Plans

A copy of the Dunedin City Council's drainage infrastructure in the vicinity of the subject property is attached. Public foul sewers are shown in red and stormwater sewers in green. All public drainage services are available to receive connections from the property and limited flows of stormwater may also be discharged to the street channel or an approved outfall.

Hawkesbury Village

All wastewater infrastructure within Hawkesbury Village is privately owned and maintained. Wastewater from this property likely discharges to the private Hawkesbury Wastewater Treatment Plant. There is no drainage charge levied by the Dunedin City Council to this property but there may be a wastewater charge levied by the Hawkesbury Village Management Board of Directors. It is recommended that the applicant check the property for the specific connection information, as the Council has no record of wastewater service to individual properties.

Public Sewer Sheets

WARNING. Please note that public sewer reticulation sheets are scaled in either Imperial feet or Metric metres. Please check with the Duty Drainage Inspector if in doubt.

Dunedin City Council Private Drainage plans incomplete

WARNING. The Dunedin City Council's private drainage records (plans) prior to 1 January 1993 may be incomplete or not clearly recorded. Owners therefore are advised to carry out work with due care to avoid damage to any private drain not detailed because of the lack of information filed in the Council's records.

s44A(2)(bb) Information Council holds regarding drinking water supply to the land

Water Supply

Hawkesbury Village water supply

The water supply for this property is fed from the Dunedin City Council water trunk line in McGraths Road into the metered private Hawkesbury water network. All water infrastructure within Hawkesbury Village is privately owned and maintained. Whilst no water charges are levied by Council to this property directly, there may be a water charge to the property from the Hawkesbury Village Management Board of Directors. It is recommended that the applicant check the property for the water connection as the Council has no record of the water service to individual properties.

s44A(2)(c) Information relating to any rates owing in relation to the land

Rates Details

Rates Assessment Details

Rate Account	2101873
Address	6 Martin Close Waikouaiti
Valuation Number	26520-02450-F
Latest Valuation Details	
Capital Value	\$385,000
Land Value	\$105,000
Value of Improvements	\$280,000
Area (Hectares)	
Units of Use	1

Current Rates

Current Rating Year Starting 01-Jul-2025
Dunedin City Council Rates \$1,772.13

Rates Outstanding for Year \$205.59

For further explanation on the rate account, or to enquire about information referred to on this page, please contact Rates Staff between 8:30am and 5:00pm weekdays at the enquiries counter on the Ground floor of the Civic Centre, 50 The Octagon, Dunedin, or by phoning 477 4000.

s44A(2)(d) Consents, Certificates, Notices, Orders or Requisitions affecting the land or any buildings on the land

(da) the information required to be provided to a territorial authority under section 362T(2) of the Building Act 2004:s44A and

(2)(e) Information concerning any Certificate issued by a Building Certifier pursuant to the Building Act 1991 or the Building Act 2004

Building and Drainage Consents

The following consents are recorded for this property:

Status Key:

BC	-	Building Consent Issued
CCC	-	Code Compliance Certificate Issued
Archived	-	In accordance with section 93(2)(b) of the Building Act, the consent was reviewed for code compliance after two years. Compliance with the Building Code could not be established and therefore the Code Compliance Certificate has been refused.
/CCC	-	
Refused	-	Work has not commenced and no extension of time applied for within 12 months of date of consent issue. Consent is of no further effect
Lapsed	-	

NOTE: This is not a comprehensive list of all building consent statuses

[ABA-1995-329618](#) Building Consent - Alter Villa F to Create 6 Units, Plumbing & Drainage

Lodgement Date 16-Jan-1995
Decision Granted
Decision Date 03-Apr-1995
Current Status **Archived**
Previous Number ABA950091
(Applications before 2007)

[ABA-1995-333177](#) Building Consent - Add to Garage

Lodgement Date 09-Nov-1995
Decision Granted
Decision Date 09-Nov-1995
Current Status **CCC Issued**
Previous Number ABA954644
(Applications before 2007)

[ABA-2015-591](#) Building Consent - Install Woodsman ECR Novo Freestanding Heater and Flue in

Dwelling

Lodgement Date	17-Apr-2015
Decision	Granted
Decision Date	21-Apr-2015
Current Status	CCC Issued
Previous Number	
<i>(Applications before 2007)</i>	

Building and Drainage Permits

[H-1968-230568](#) AAS1968 - No Permit Number - Upgrade of Cherry Farm Hospital, (Otago Hospital Board).
The permit was lodged on 23-May-1968.

Building Notices

Notice To Fix

The following is a list of Notices To Fix for this property.

Notice Number	NTF-2022-27
Status	Resolved
Description	Non-compliance with Schedule 1, Building Regulations 1992, Clause E1.3.3(a) - Drainage systems for the disposal of surface water shall be constructed to convey water to an appropriate outfall.
	The roof stormwater downpipe is being discharged through a gully trap into the foul drain.

Resource Consents

The following Resource Consent(s) are recorded for this property:

[RMA-1994-356548](#) - Resource Management Act (Historical Data)

Description	Subdivision of Hawksbury Village (OT14C/39, OT16D/662, Pt OT16C/1091 & 16C/359) into 68 lots Owner: Karitane Estate Limited
Lodgement Date	04-Aug-1994
Decision	Granted
Decision Date	06-Oct-1994
Current Status	Consent Issued

[RMA-1995-357186](#) - Resource Management Act (Historical Data)

Description	UNIT TITLE SUBDIVISION FOR 6 UNITS ON LOT 52
Lodgement Date	06-Mar-1995
Decision	Granted
Decision Date	06-Mar-1995
Current Status	Consent Issued

[RMA-1996-360014](#) - Resource Management Act (Historical Data)

Description	DELETION OF RIGHT-OF-WAY
Lodgement Date	20-Aug-1996
Decision	Granted
Decision Date	05-Sep-1996
Current Status	Consent Issued

Consent Notices

There are no Consent Notices recorded for this property. It is recommended that the applicant check the Record of Title for any notices or covenants that may affect the property.

Alcohol Licensing

There are no records of any Alcohol Licences for this property.

Health Licensing

There are no records of any Health Licences for this property.

s44A(2)(ea) Information notified under Section 124 of the Weathertight Homes Resolution Services Act 2006

No information.

s44A (2)(f) Information relating to the use to which the land may be put and any conditions attached to that use

District Plan

The information on district plan requirements is correct at the date this LIM is issued. Note that the Dunedin City Second Generation District Plan ("The 2GP") is subject to change at any time. To check whether any changes have occurred since the date this LIM was issued, consult the information and relevant planning maps in the 2GP, which can be found on our website at <https://www.dunedin.govt.nz/council/district-plan/2nd-generation-district-plan> as well as at all Dunedin City Council service centres and libraries.

SECOND GENERATION DISTRICT PLAN INFORMATION

Zoning

- Township and Settlement (refer Section 15, Residential)

Scheduled Items

- Nil

Overlay Zones

- Nil

Mapped Areas

- No DCC Reticulated Wastewater Mapped Area
- Wahi Tupuna
 - Name: Purakaunui to Hikaroroa to Huriawa
 - ID: 14

[Please note that some of the items above may only extend over part of the property. If there are multiple designations over the property, these may overlap.]

District Plan Map

The District Plan map is available [online here](#). Instructions on how to use the map are [available here](#).

You can also access the District Plan map and instructions by visiting the Dunedin City Council 2GP Website at:

<https://www.dunedin.govt.nz/council/district-plan/2nd-generation-district-plan>

s44A(2)(g) Information regarding the land which has been notified to Council by another statutory organisation

No information.

s44A(2)(h) Information regarding the land which has been notified to Council by any network utility operator pursuant to the Building Act 1991 or Building Act 2004

No information.

Section 44A(3) Information concerning the land as the authority considers, at its discretion, to be relevant.

Building Information

Drainage

No Code Compliance Certificate copy

This property contains building consent application/s where a copy of the code compliance certificate (Form 7) is not able to be provided.

This may be due to the age of the consent and/or processes that were in place at the time.

Form 5 (building consent) copy

This property contains building consent application/s where a copy of the building consent (Form 5) is not able to be provided.

This may be due to the age of the consent and/or processes that were in place at the time.

Hawksbury Village Steam Ducts

Properties within Hawksbury Village may contain underground concrete ducts, chambers or other structures that form a reticulated steam system that is no longer in use. The design of buildings over or within 1.0m of these structures will require engineering input. These structures are not owned by Hawksbury Village Management Limited. They can be demolished or removed; however, they may contain asbestos pipe insulation.

The handling of asbestos containing materials is covered by the Health and Safety at Work (Asbestos) Regulations 2016. These regulations require the licensing of asbestos removalists and asbestos assessors. Refer to the WorkSafe New Zealand website.

<https://worksafe.govt.nz/topic-and-industry/asbestos/working-with-asbestos/>

Please be warned that other services such as electricity or water may have been routed through sections of steam duct. Care should be taken if ducts are to be demolished or removed.

Any private property services plans enclosed have been provided to Council by a previous owner/agent. Their accuracy has not been verified.

Minimum Floor Levels

Clause E1.3.2 of the New Zealand Building Code requires that surface water, resulting from an event having a 2% probability of occurring annually, shall not enter buildings. This requirement applies to Housing, Communal Housing, Communal Residential and Communal non-residential buildings. For guidance when establishing minimum floor levels please refer to : <https://www.dunedin.govt.nz/services/building-services/minimum-floor-levels> and for links to specific areas:

<https://www.dunedin.govt.nz/services/building-services/minimum-floor-levels/mfl-guidance>

For further explanation on the current status of any building consent, or to enquire about information referred to in this section, please contact Building Services Staff between 8:30am and 5:00pm weekdays at the enquiries counter on the Ground floor of the Civic Centre, 50 The Octagon, Dunedin, or by phoning 477 4000.

Planning

Resource Consents within 50m of 6 Martin Close Waikouaiti

RESOURCE CONSENTS WITHIN 50 METRES OF 6 MARTIN CLOSE WAIKOUAITI

5044800 25 McGrath Road Waikouaiti

LUC-2017-145/A Land Use Consent s127 variation of change of conditions for LUC-2017-145. The outcome was s127 Upheld on 19/06/2019.

SUB-2016-111/A Subdivision Consent s127 variation of change of conditions for SUB-2016-111 subdivision consent creating two new lots. The outcome was s127 Upheld on 19/06/2019.

LUC-2017-145 Land Use Consent land use consent for the construction of a residential dwelling within the defined building platform with side yard breaches. The outcome was Granted on 04/04/2017.

SUB-2016-111 Subdivision Consent subdivision consent creating two new lots. The outcome was Granted on 04/04/2017.

LUC-2001-365251/A Land Use Consent Section 125 extension of time. The outcome was Granted on 04/02/2009.

RMA-2001-365251 Resource Management Act (Historical Data) TO CARRY OUT AN INDUSTRIAL ACTIVITY IN THE RURAL ZONE (Non-Notified - Non Complying). The outcome was Granted on 03/12/2001.

RMA-1992-355483 Resource Management Act (Historical Data) SUBDIVISION INVOLVING CT'S 5C/975, 266/156, 9C/437 Ownr:VJ & LA FUEHRER / App: VJ & LA FUEHRER PAT PITTS BOX 1083 (Non-Notified - Non Complying). The outcome was Granted on 05/02/1993.

5102465 1 Martin Close Waikouaiti

RMA-1994-356548 Resource Management Act (Historical Data) Subdivision of Hawksbury Village (OT14C/39, OT16D/662, Pt OT16C/1091 & 16C/359) into 68 lots Owner: Karitane Estate Limited (Non-Notified - Non Complying). The outcome was Granted on 06/10/1994.

RMA-1995-357186 Resource Management Act (Historical Data) UNIT TITLE SUBDIVISION FOR 6 UNITS ON LOT 52 (Non-Notified - Non Complying). The outcome was Granted on 06/03/1995.

RMA-1996-360014 Resource Management Act (Historical Data) DELETION OF RIGHT-OF-WAY (Non-Notified - Unrestricted Discretionary). The outcome was Granted on 05/09/1996.

5102466 2 Martin Close Waikouaiti

RMA-1994-356548 Resource Management Act (Historical Data) Subdivision of Hawksbury Village (OT14C/39, OT16D/662, Pt OT16C/1091 & 16C/359) into 68 lots Owner: Karitane Estate Limited (Non-Notified - Non Complying). The outcome was Granted on 06/10/1994.

RMA-1995-357186 Resource Management Act (Historical Data) UNIT TITLE SUBDIVISION FOR 6 UNITS ON LOT 52 (Non-Notified - Non Complying). The outcome was Granted on 06/03/1995.

RMA-1996-360014 Resource Management Act (Historical Data) DELETION OF RIGHT-OF-WAY (Non-Notified - Unrestricted Discretionary). The outcome was Granted on 05/09/1996.

5102467 3 Martin Close Waikouaiti

RMA-1994-356548 Resource Management Act (Historical Data) Subdivision of Hawksbury Village (OT14C/39, OT16D/662, Pt OT16C/1091 & 16C/359) into 68 lots Owner: Karitane Estate Limited (Non-Notified - Non Complying). The outcome was Granted on 06/10/1994.

RMA-1995-357186 Resource Management Act (Historical Data) UNIT TITLE SUBDIVISION FOR 6 UNITS ON LOT 52 (Non-Notified - Non Complying). The outcome was Granted on 06/03/1995.

RMA-1996-360014 Resource Management Act (Historical Data) DELETION OF RIGHT-OF-WAY (Non-Notified - Unrestricted Discretionary). The outcome was Granted on 05/09/1996.

5102468 4 Martin Close Waikouaiti

RMA-1994-356548 Resource Management Act (Historical Data) Subdivision of Hawksbury Village (OT14C/39, OT16D/662, Pt OT16C/1091 & 16C/359) into 68 lots Owner: Karitane Estate Limited (Non-Notified - Non Complying). The outcome was Granted on 06/10/1994.

RMA-1995-357186 Resource Management Act (Historical Data) UNIT TITLE SUBDIVISION FOR 6 UNITS ON LOT 52 (Non-Notified - Non Complying). The outcome was Granted on 06/03/1995.

RMA-1996-360014 Resource Management Act (Historical Data) DELETION OF RIGHT-OF-WAY (Non-Notified - Unrestricted Discretionary). The outcome was Granted on 05/09/1996.

5102469 5 Martin Close Waikouaiti

RMA-1994-356548 Resource Management Act (Historical Data) Subdivision of Hawksbury Village (OT14C/39, OT16D/662, Pt OT16C/1091 & 16C/359) into 68 lots Owner: Karitane Estate Limited (Non-Notified - Non Complying). The outcome was Granted on 06/10/1994.

RMA-1995-357186 Resource Management Act (Historical Data) UNIT TITLE SUBDIVISION FOR 6 UNITS ON LOT 52 (Non-Notified - Non Complying). The outcome was Granted on 06/03/1995.

RMA-1996-360014 Resource Management Act (Historical Data) DELETION OF RIGHT-OF-WAY (Non-Notified - Unrestricted Discretionary). The outcome was Granted on 05/09/1996.

5102471 46A Truby King Drive Waikouaiti

RMA-1993-356283 Resource Management Act (Historical Data) CONVERT VILLA G INTO 8 SELF-CONTAINED UNITS Ownr: KARITANE ESTATES / App: MR J CHILDS PO BOX 5463 AUCKLAND (Non-Notified - Non Complying). The outcome was Granted on 27/10/1993.

RMA-1994-356548 Resource Management Act (Historical Data) Subdivision of Hawksbury Village (OT14C/39, OT16D/662, Pt OT16C/1091 & 16C/359) into 68 lots Owner: Karitane Estate Limited (Non-Notified - Non Complying). The outcome was Granted on 06/10/1994.

RMA-1995-357187 Resource Management Act (Historical Data) UNIT TITLE SUBDIVISION FOR 8 UNITS ON LOT 53 (Non-Notified - Non Complying). The outcome was Granted on 06/03/1995.

RMA-1996-360014 Resource Management Act (Historical Data) DELETION OF RIGHT-OF-WAY (Non-Notified - Unrestricted Discretionary). The outcome was Granted on 05/09/1996.

5102476 46B Truby King Drive Waikouaiti

RMA-1993-356283 Resource Management Act (Historical Data) CONVERT VILLA G INTO 8 SELF-CONTAINED UNITS Ownr:KARITANE ESTATES / App: MR J CHILDS PO BOX 5463 AUCKLAND (Non-Notified - Non Complying). The outcome was Granted on 27/10/1993.

RMA-1994-356548 Resource Management Act (Historical Data) Subdivision of Hawksbury Village (OT14C/39, OT16D/662, Pt OT16C/1091 & 16C/359) into 68 lots Owner: Karitane Estate Limited (Non-Notified - Non Complying). The outcome was Granted on 06/10/1994.

RMA-1995-357187 Resource Management Act (Historical Data) UNIT TITLE SUBDIVISION FOR 8 UNITS ON LOT 53 (Non-Notified - Non Complying). The outcome was Granted on 06/03/1995.

RMA-1996-360014 Resource Management Act (Historical Data) DELETION OF RIGHT-OF-WAY (Non-Notified - Unrestricted Discretionary). The outcome was Granted on 05/09/1996.

5102478 46C Truby King Drive Waikouaiti

RMA-1993-356283 Resource Management Act (Historical Data) CONVERT VILLA G INTO 8 SELF-CONTAINED UNITS Ownr:KARITANE ESTATES / App: MR J CHILDS PO BOX 5463 AUCKLAND (Non-Notified - Non Complying). The outcome was Granted on 27/10/1993.

RMA-1994-356548 Resource Management Act (Historical Data) Subdivision of Hawksbury Village (OT14C/39, OT16D/662, Pt OT16C/1091 & 16C/359) into 68 lots Owner: Karitane Estate Limited (Non-Notified - Non Complying). The outcome was Granted on 06/10/1994.

RMA-1995-357187 Resource Management Act (Historical Data) UNIT TITLE SUBDIVISION FOR 8 UNITS ON LOT 53 (Non-Notified - Non Complying). The outcome was Granted on 06/03/1995.

RMA-1996-360014 Resource Management Act (Historical Data) DELETION OF RIGHT-OF-WAY (Non-Notified - Unrestricted Discretionary). The outcome was Granted on 05/09/1996.

5102480 46D Truby King Drive Waikouaiti

RMA-1993-356283 Resource Management Act (Historical Data) CONVERT VILLA G INTO 8 SELF-CONTAINED UNITS Ownr:KARITANE ESTATES / App: MR J CHILDS PO BOX 5463 AUCKLAND (Non-Notified - Non Complying). The outcome was Granted on 27/10/1993.

RMA-1994-356548 Resource Management Act (Historical Data) Subdivision of Hawksbury Village (OT14C/39, OT16D/662, Pt OT16C/1091 & 16C/359) into 68 lots Owner: Karitane Estate Limited (Non-Notified - Non Complying). The outcome was Granted on 06/10/1994.

RMA-1995-357187 Resource Management Act (Historical Data) UNIT TITLE SUBDIVISION FOR 8 UNITS ON LOT 53 (Non-Notified - Non Complying). The outcome was Granted on 06/03/1995.

RMA-1996-360014 Resource Management Act (Historical Data) DELETION OF RIGHT-OF-WAY (Non-Notified - Unrestricted Discretionary). The outcome was Granted on 05/09/1996.

5102481 46E Truby King Drive Waikouaiti

RMA-1993-356283 Resource Management Act (Historical Data) CONVERT VILLA G INTO 8 SELF-CONTAINED UNITS Ownr:KARITANE ESTATES / App: MR J CHILDS PO BOX 5463 AUCKLAND (Non-Notified - Non Complying). The outcome was Granted on 27/10/1993.

RMA-1994-356548 Resource Management Act (Historical Data) Subdivision of Hawksbury Village (OT14C/39, OT16D/662, Pt OT16C/1091 & 16C/359) into 68 lots Owner: Karitane Estate Limited (Non-Notified - Non Complying). The outcome was Granted on 06/10/1994.

RMA-1995-357187 Resource Management Act (Historical Data) UNIT TITLE SUBDIVISION FOR 8 UNITS ON LOT 53 (Non-Notified - Non Complying). The outcome was Granted on 06/03/1995.

RMA-1996-360014 Resource Management Act (Historical Data) DELETION OF RIGHT-OF-WAY (Non-Notified - Unrestricted Discretionary). The outcome was Granted on 05/09/1996.

5102482 46F Truby King Drive Waikouaiti

RMA-1993-356283 Resource Management Act (Historical Data) CONVERT VILLA G INTO 8 SELF-CONTAINED UNITS Ownr:KARITANE ESTATES / App: MR J CHILDS PO BOX 5463 AUCKLAND (Non-Notified - Non Complying). The outcome was Granted on 27/10/1993.

RMA-1994-356548 Resource Management Act (Historical Data) Subdivision of Hawksbury Village (OT14C/39, OT16D/662, Pt OT16C/1091 & 16C/359) into 68 lots Owner: Karitane Estate Limited (Non-Notified - Non Complying). The outcome was Granted on 06/10/1994.

RMA-1995-357187 Resource Management Act (Historical Data) UNIT TITLE SUBDIVISION FOR 8 UNITS ON LOT 53 (Non-Notified - Non Complying). The outcome was Granted on 06/03/1995.

RMA-1996-360014 Resource Management Act (Historical Data) DELETION OF RIGHT-OF-WAY (Non-Notified - Unrestricted Discretionary). The outcome was Granted on 05/09/1996.

5102483 46G Truby King Drive Waikouaiti

RMA-1993-356283 Resource Management Act (Historical Data) CONVERT VILLA G INTO 8 SELF-CONTAINED UNITS Ownr:KARITANE ESTATES / App: MR J CHILDS PO BOX 5463 AUCKLAND (Non-Notified - Non Complying). The outcome was Granted on 27/10/1993.

RMA-1994-356548 Resource Management Act (Historical Data) Subdivision of Hawksbury Village (OT14C/39, OT16D/662, Pt OT16C/1091 & 16C/359) into 68 lots Owner: Karitane Estate Limited (Non-Notified - Non Complying). The outcome was Granted on 06/10/1994.

RMA-1995-357187 Resource Management Act (Historical Data) UNIT TITLE SUBDIVISION FOR 8 UNITS ON LOT 53 (Non-Notified - Non Complying). The outcome was Granted on 06/03/1995.

RMA-1996-360014 Resource Management Act (Historical Data) DELETION OF RIGHT-OF-WAY (Non-Notified - Unrestricted Discretionary). The outcome was Granted on 05/09/1996.

5102484 46H Truby King Drive Waikouaiti

RMA-1993-356283 Resource Management Act (Historical Data) CONVERT VILLA G INTO 8 SELF-CONTAINED UNITS Ownr:KARITANE ESTATES / App: MR J CHILDS PO BOX 5463 AUCKLAND (Non-Notified - Non Complying). The outcome was Granted on 27/10/1993.

RMA-1994-356548 Resource Management Act (Historical Data) Subdivision of Hawksbury Village (OT14C/39, OT16D/662, Pt OT16C/1091 & 16C/359) into 68 lots Owner: Karitane Estate Limited (Non-Notified - Non Complying). The outcome was Granted on 06/10/1994.

RMA-1995-357187 Resource Management Act (Historical Data) UNIT TITLE SUBDIVISION FOR 8 UNITS ON LOT 53 (Non-Notified - Non Complying). The outcome was Granted on 06/03/1995.

RMA-1996-360014 Resource Management Act (Historical Data) DELETION OF RIGHT-OF-WAY (Non-Notified - Unrestricted Discretionary). The outcome was Granted on 05/09/1996.

5102540 14 Johnny Jones Drive Waikouaiti

SUB-2008-164 Subdivision Consent Three-lot residential 6 zone subdivision including creation of easements over Lot 51 DP 24963. This consent has since Lapsed.

RMA-1996-360251 Resource Management Act (Historical Data) ERECT RESIDENTIAL DWELLINGS ON EACH OF 44 NEW ALLOTMENTS (Non-Notified - Non Complying). The outcome was Granted on 16/01/1997.

RMA-1996-360250 Resource Management Act (Historical Data) SUBDIVISION OF FOUR SITES TO CREATE 45 NEW ALLOTMENTS (WITH 44 LOTS BEING FOR RESIDENTIAL PURPOSES) (Non-Notified - Non Complying). The outcome was Granted on 16/01/1997.

RMA-1999-363075 Resource Management Act (Historical Data) CHANGE OF CONSENT CONDITION OF RMA961142 (Other). The outcome was Declined on 26/07/1999.

RMA-1994-356548 Resource Management Act (Historical Data) Subdivision of Hawksbury Village (OT14C/39, OT16D/662, Pt OT16C/1091 & 16C/359) into 68 lots Owner: Karitane Estate Limited (Non-Notified - Non Complying). The outcome was Granted on 06/10/1994.

5102598 50 Truby King Drive Waikouaiti

BACT-2019-47 Boundary Activity Notice boundary activity consent to construct accessory building. The outcome was Issued on 03/07/2019.

LUC-2019-104 Land Use Consent land use consent for the operation of a commercial storage activity within 20 existing garages. The outcome was Granted on 07/05/2019.

RMA-1994-356548 Resource Management Act (Historical Data) Subdivision of Hawksbury Village (OT14C/39, OT16D/662, Pt OT16C/1091 & 16C/359) into 68 lots Owner: Karitane Estate Limited (Non-Notified - Non Complying). The outcome was Granted on 06/10/1994.

5106451 70 Truby King Drive Waikouaiti

RMA-1994-356548 Resource Management Act (Historical Data) Subdivision of Hawksbury Village (OT14C/39, OT16D/662, Pt OT16C/1091 & 16C/359) into 68 lots Owner: Karitane Estate Limited (Non-Notified - Non Complying). The outcome was Granted on 06/10/1994.

5110066 25 McGrath Road Waikouaiti

LUC-2017-145/A Land Use Consent s127 variation of change of conditions for LUC-2017-145. The outcome was s127 Upheld on 19/06/2019.

SUB-2016-111/A Subdivision Consent s127 variation of change of conditions for SUB-2016-111 subdivision consent creating two new lots. The outcome was s127 Upheld on 19/06/2019.

LUC-2017-145 Land Use Consent land use consent for the construction of a residential dwelling within the defined building platform with side yard breaches. The outcome was Granted on 04/04/2017.

SUB-2016-111 Subdivision Consent subdivision consent creating two new lots. The outcome was Granted on 04/04/2017.

5113028 7 Johnny Jones Drive Waikouaiti

RMA-2006-370693 Resource Management Act (Historical Data) SUBDIVISION OF LOT 54 DP 24963 INTO 4 LOTS. The outcome was Granted on 04/12/2006.

RMA-1996-360251 Resource Management Act (Historical Data) ERECT RESIDENTIAL DWELLINGS ON EACH OF 44 NEW ALLOTMENTS (Non-Notified - Non Complying). The outcome was Granted on 16/01/1997.

RMA-1996-360250 Resource Management Act (Historical Data) SUBDIVISION OF FOUR SITES TO CREATE 45 NEW ALLOTMENTS (WITH 44 LOTS BEING FOR RESIDENTIAL PURPOSES) (Non-Notified - Non Complying). The outcome was Granted on 16/01/1997.

RMA-1999-363075 Resource Management Act (Historical Data) CHANGE OF CONSENT CONDITION OF RMA961142 (Other). The outcome was Declined on 26/07/1999.

RMA-1994-356548 Resource Management Act (Historical Data) Subdivision of Hawksbury Village (OT14C/39, OT16D/662, Pt OT16C/1091 & 16C/359) into 68 lots Owner: Karitane Estate Limited (Non-Notified - Non Complying). The outcome was Granted on 06/10/1994.

RMA-1996-360386 Resource Management Act (Historical Data) ERECT DWELLING (Non-Notified - Non Complying). The outcome was Granted on 16/01/1997.

5113029 5 Johnny Jones Drive Waikouaiti

S243-2014-3 s243 Cancellation of Easement cancellation of easement. The outcome was Granted on 28/02/2014.

RMA-2006-370693 Resource Management Act (Historical Data) SUBDIVISION OF LOT 54 DP 24963 INTO 4 LOTS. The outcome was Granted on 04/12/2006.

RMA-1996-360251 Resource Management Act (Historical Data) ERECT RESIDENTIAL DWELLINGS ON EACH OF 44 NEW ALLOTMENTS (Non-Notified - Non Complying). The outcome was Granted on 16/01/1997.

RMA-1996-360250 Resource Management Act (Historical Data) SUBDIVISION OF FOUR SITES TO CREATE 45 NEW ALLOTMENTS (WITH 44 LOTS BEING FOR RESIDENTIAL PURPOSES) (Non-Notified - Non Complying). The outcome was Granted on 16/01/1997.

RMA-1999-363075 Resource Management Act (Historical Data) CHANGE OF CONSENT CONDITION OF RMA961142 (Other). The outcome was Declined on 26/07/1999.

RMA-1994-356548 Resource Management Act (Historical Data) Subdivision of Hawksbury Village (OT14C/39, OT16D/662, Pt OT16C/1091 & 16C/359) into 68 lots Owner: Karitane Estate Limited (Non-Notified - Non Complying). The outcome was Granted on 06/10/1994.

5113030 1 Johnny Jones Drive Waikouaiti

RMA-2006-370693 Resource Management Act (Historical Data) SUBDIVISION OF LOT 54 DP 24963 INTO 4 LOTS. The outcome was Granted on 04/12/2006.

RMA-1996-360251 Resource Management Act (Historical Data) ERECT RESIDENTIAL DWELLINGS ON EACH OF 44 NEW ALLOTMENTS (Non-Notified - Non Complying). The outcome was Granted on 16/01/1997.

RMA-1996-360250 Resource Management Act (Historical Data) SUBDIVISION OF FOUR SITES TO CREATE 45 NEW ALLOTMENTS (WITH 44 LOTS BEING FOR RESIDENTIAL PURPOSES) (Non-Notified - Non Complying). The outcome was Granted on 16/01/1997.

RMA-1999-363075 Resource Management Act (Historical Data) CHANGE OF CONSENT CONDITION OF RMA961142 (Other). The outcome was Declined on 26/07/1999.

RMA-1994-356548 Resource Management Act (Historical Data) Subdivision of Hawksbury Village (OT14C/39, OT16D/662, Pt OT16C/1091 & 16C/359) into 68 lots Owner: Karitane Estate Limited (Non-Notified - Non Complying). The outcome was Granted on 06/10/1994.

5113031 38 Truby King Drive Waikouaiti

LUC-2013-229 Land Use Consent construct two domestic storage sheds. The outcome was Granted on 17/07/2013.

SUB-2008-164 Subdivision Consent Three-lot residential 6 zone subdivision including creation of easements over Lot 51 DP 24963. This consent has since Lapsed.

RMA-2006-370693 Resource Management Act (Historical Data) SUBDIVISION OF LOT 54 DP 24963 INTO 4 LOTS. The outcome was Granted on 04/12/2006.

RMA-1996-360251 Resource Management Act (Historical Data) ERECT RESIDENTIAL DWELLINGS ON EACH OF 44 NEW ALLOTMENTS (Non-Notified - Non Complying). The outcome was Granted on 16/01/1997.

RMA-1996-360250 Resource Management Act (Historical Data) SUBDIVISION OF FOUR SITES TO CREATE 45 NEW ALLOTMENTS (WITH 44 LOTS BEING FOR RESIDENTIAL PURPOSES) (Non-Notified - Non Complying). The outcome was Granted on 16/01/1997.

RMA-1999-363075 Resource Management Act (Historical Data) CHANGE OF CONSENT CONDITION OF RMA961142 (Other). The outcome was Declined on 26/07/1999.

RMA-1994-356548 Resource Management Act (Historical Data) Subdivision of Hawksbury Village (OT14C/39, OT16D/662, Pt OT16C/1091 & 16C/359) into 68 lots Owner: Karitane Estate Limited (Non-Notified - Non Complying). The outcome was Granted on 06/10/1994.

5125073 25 McGrath Road Waikouaiti

LUC-2017-145/A Land Use Consent s127 variation of change of conditions for LUC-2017-145. The outcome was s127 Upheld on 19/06/2019.

SUB-2016-111/A Subdivision Consent s127 variation of change of conditions for SUB-2016-111 subdivision consent creating two new lots. The outcome was s127 Upheld on 19/06/2019.

LUC-2017-145 Land Use Consent land use consent for the construction of a residential dwelling within the defined building platform with side yard breaches. The outcome was Granted on 04/04/2017.

SUB-2016-111 Subdivision Consent subdivision consent creating two new lots. The outcome was Granted on 04/04/2017.

LUC-2001-365251/A Land Use Consent Section 125 extension of time. The outcome was Granted on 04/02/2009.

RMA-2001-365251 Resource Management Act (Historical Data) TO CARRY OUT AN INDUSTRIAL ACTIVITY IN THE RURAL ZONE (Non-Notified - Non Complying). The outcome was Granted on 03/12/2001.

RMA-1992-355483 Resource Management Act (Historical Data) SUBDIVISION INVOLVING CT'S 5C/975, 266/156, 9C/437 Ownr:VJ & LA FUEHRER / App: VJ & LA FUEHRER PAT PITTS BOX 1083 (Non-Notified - Non Complying). The outcome was Granted on 05/02/1993.

5130965 41 Truby King Drive Waikouaiti

SUB-2019-90 Subdivision Consent stage 1. The outcome was Staged Subdivision on 12/09/2019.

SUB-2019-90 Subdivision Consent staged subdivision creating 15 residential lots and a balance land title. The outcome was Granted on 12/09/2019.

S226-2014-4 S226 Application s226 application. The outcome was Granted on 10/06/2014.

SUB-2011-77 Subdivision Consent subdivision creating 2 lots. The outcome was Granted on 27/07/2011.

RMA-2005-369420 Resource Management Act (Historical Data) Subdivide two sites (CT OT18D/130 & OT18D/359) into 11 lots with four of the lots amalgamated as one site (Non-Notified - Restricted Discretionary). The outcome was Granted on 23/12/2005.

RMA-2007-371049 Resource Management Act (Historical Data) RESERVES CONTRIBUTION VARIATION OF RMA20050823. The outcome was s127 Upheld on 30/01/2007.

RMA-1997-361155 Resource Management Act (Historical Data) Boundary adjustment subdivision of Lots 56,59 & 62 RMA 94237 creating Lot 1 & Lot 59 DP 26720 (Lot 1 amalgamated with Lot 61 DP 24881) (Non-Notified - Non Complying). The outcome was Granted on 01/09/1997.

RMA-1994-356548 Resource Management Act (Historical Data) Subdivision of Hawksbury Village (OT14C/39, OT16D/662, Pt OT16C/1091 & 16C/359) into 68 lots Owner: Karitane Estate Limited (Non-Notified - Non Complying). The outcome was Granted on 06/10/1994.

5130966 43 Truby King Drive Waikouaiti

SUB-2019-90 Subdivision Consent stage 1. The outcome was Staged Subdivision on 12/09/2019.

SUB-2019-90 Subdivision Consent staged subdivision creating 15 residential lots and a balance land title. The outcome was Granted on 12/09/2019.

S226-2014-4 S226 Application s226 application. The outcome was Granted on 10/06/2014.

SUB-2011-77 Subdivision Consent subdivision creating 2 lots. The outcome was Granted on 27/07/2011.

RMA-2005-369420 Resource Management Act (Historical Data) Subdivide two sites (CT OT18D/130 & OT18D/359) into 11 lots with four of the lots amalgamated as one site (Non-Notified - Restricted Discretionary). The outcome was Granted on 23/12/2005.

RMA-2007-371049 Resource Management Act (Historical Data) RESERVES CONTRIBUTION VARIATION OF RMA20050823. The outcome was s127 Upheld on 30/01/2007.

RMA-1997-361155 Resource Management Act (Historical Data) Boundary adjustment subdivision of Lots 56,59 & 62 RMA 94237 creating Lot 1 & Lot 59 DP 26720 (Lot 1 amalgamated with Lot 61 DP 24881) (Non-Notified - Non Complying). The outcome was Granted on 01/09/1997.

RMA-1994-356548 Resource Management Act (Historical Data) Subdivision of Hawksbury Village (OT14C/39, OT16D/662, Pt OT16C/1091 & 16C/359) into 68 lots Owner: Karitane Estate Limited (Non-Notified - Non Complying). The outcome was Granted on 06/10/1994.

5130967 45 Truby King Drive Waikouaiti

SUB-2019-90 Subdivision Consent stage 1. The outcome was Staged Subdivision on 12/09/2019.

SUB-2019-90 Subdivision Consent staged subdivision creating 15 residential lots and a balance land title. The outcome was Granted on 12/09/2019.

S226-2014-4 S226 Application s226 application. The outcome was Granted on 10/06/2014.

SUB-2011-77 Subdivision Consent subdivision creating 2 lots. The outcome was Granted on 27/07/2011.

RMA-2005-369420 Resource Management Act (Historical Data) Subdivide two sites (CT OT18D/130 & OT18D/359) into 11 lots with four of the lots amalgamated as one site (Non-Notified - Restricted Discretionary). The outcome was Granted on 23/12/2005.

RMA-2007-371049 Resource Management Act (Historical Data) RESERVES CONTRIBUTION VARIATION OF RMA20050823. The outcome was s127 Upheld on 30/01/2007.

RMA-1997-361155 Resource Management Act (Historical Data) Boundary adjustment subdivision of Lots 56,59 & 62 RMA 94237 creating Lot 1 & Lot 59 DP 26720 (Lot 1 amalgamated with Lot 61 DP 24881) (Non-Notified - Non Complying). The outcome was Granted on 01/09/1997.

RMA-1994-356548 Resource Management Act (Historical Data) Subdivision of Hawksbury Village (OT14C/39, OT16D/662, Pt OT16C/1091 & 16C/359) into 68 lots Owner: Karitane Estate Limited (Non-Notified - Non Complying). The outcome was Granted on 06/10/1994.

Other Planning Comments

Consent Notices

The record of title for this property has a consent notice recorded against the supplementary record sheet of this unit title:

- CONO 889162

A copy of the consent notice is attached to this LIM. The condition(s) in the consent notice must be complied with on an ongoing basis.

The information provided with this LIM on District Plan requirements and resource consents has been verified by City Planning in relation to the subject property only. All information included in relation to other land surrounding the site is indicative.

Accuracy of Boundaries

Knowing the true location of the property boundaries on the ground is important in determining what can be carried out on the land under the District Plan and in determining whether the current activity complies with the District Plan or any resource consent. Please note that the Council's aerial photographs may not accurately depict the extent of the property. The Record of Title for the site should be checked in the first instance. A surveyor may need to be consulted to establish the true location of the title boundaries on the ground.

Access to Site

The legality of any access to the site is important in determining what can be carried out on the land under the District Plan and in determining whether the current activity complies with the District Plan or any resource consent. It is recommended that the Record of Title and/or a lawyer be consulted regarding the legality of any legal and/or physical access to the site (and the maintenance thereof).

Heritage New Zealand Pouhere Taonga Act 2014

The Heritage New Zealand Pouhere Taonga Act 2014 applies in addition to any protection provided to a building or site by the District Plan. The Heritage New Zealand Pouhere Taonga Act 2014 makes it unlawful for any person to destroy, or modify the whole or any part of an archaeological site, whether or not the land on which the site is located is designated, or a resource or building consent has been issued, without the prior authority of Heritage New Zealand. The Heritage New Zealand Pouhere Taonga Act 2014 defines an archaeological site as a place associated with pre-1900 activity, where there may be evidence relating to the history of New Zealand. Pre-1900 buildings are considered archaeological sites under the Heritage New Zealand Pouhere Taonga Act 2014 and are also often associated with subsurface archaeological remains that provide evidence of pre-existing use of the site. Council records may not necessarily identify the precise date upon which an existing building was constructed. Contact the Dunedin office of Heritage New Zealand for further information: infodeepsouth@heritage.org.nz; 03 477 9871.

Resource Management (National Environmental Standard for Assessing and Managing Contaminants in Soil to Protect Human Health) Regulations 2011

The Resource Management (National Environmental Standard for Assessing and Managing Contaminants in Soil to Protect Human Health) Regulations 2011 came into force on 1 January 2012. The National Environmental Standard applies to any piece of land on which an activity or industry described in the current edition of the Hazardous Activities and Industries List (HAIL) is being undertaken, has been undertaken or is more likely than not to have been undertaken. (The current edition of the HAIL is available on the Ministry for the Environment website at www.mfe.govt.nz.) Activities on HAIL sites may need to comply with permitted activity conditions specified in the National Environmental Standard and/or might require resource consent. (The Otago Regional Council should also be consulted for any rules it might have in regards to the use or development of contaminated sites.)

If a person wishes to establish whether a piece of land has had hazardous activities or industries conducted on it, and thus whether activities on that land are controlled by the National Environmental Standard, then the person must pay for a review of the information about the land held by the Council, or pay for a suitably qualified and experienced practitioner to undertake a preliminary site inspection. Formal confirmation from the Council that resource consent is not required under the National Environmental Standard can only be given through a certificate of compliance application.

If you would like a copy of any Resource Consent decision or advice on the current status and relevance of any planning matter referred to in the LIM, enquiries may be made at the Planning Enquiries desk on the Ground Floor of the Civic Centre, 50 The Octagon, or by phoning 477 4000 and asking for the Duty Planner. Planners are available at the Planning Enquiries desk to answer your enquiries between 8:30am and 5:00pm weekdays.

3 Waters

Information Regarding Watercourses

The controlling authority for all water and waterbodies in Dunedin City is the Otago Regional Council. The Regional Plan: Water addresses water take and use, diversions, damming, discharges and bed alteration under the Resource Management Act 1991. They are also responsible for the Flood Protection Management Bylaw 2012.

The controlling authority for watercourses in relation to stormwater drainage, and removal of obstructions in accordance with Local Government Act 1974 is the Dunedin City Council. The Council also issues building and resource consents for certain works around watercourses.

Not all watercourses within Dunedin City are recorded or known to the Council, therefore it is recommended that the applicant inspect the property for watercourses.

For further information on watercourses it is recommended the applicant read the Watercourse Information Sheet. A copy of this document is available on request or for download from the Dunedin City Council website www.dunedin.govt.nz.

Transport

DCC Transport has carried out a desktop inspection of this property and found the following:

Private Road/Street/Close/Drive

This properties vehicle access is via a private road Martin Close and Truby King Drive, DCC Transport does not own or maintain this private road/street/close/drive. It is advised if there isn't already one in place that a formal agreement be drawn up between the owners/users of all private accesses in order to clarify their maintenance responsibilities.

Encroachment on road reserve – privately owned vegetation/trees

On the property's frontage McGarth Road there are various privately owned plantings that appear to be located on road reserve. These may remain at the pleasure of Council. Council accepts this situation but accepts no liability. Maintenance is the responsibility of the property owner. The Council may require this to be addressed in the future.

Private stormwater lateral.

Private stormwater laterals collect stormwater from private properties guttering and runs under the footpath to the kerb and channel on the roadside. The stormwater laterals are private pipes and are the responsibility of the landowner who they service, the repair and maintenance of these pipe's rests solely with the property owner. As the landowner you must maintain your stormwater lateral to ensure that it doesn't become a safety hazard for pedestrians or other road users.

For further explanations on property owner obligations in regard to local road encroachments, vehicle entrances, vegetation management or retaining structures please refer to the Dunedin City Council website at <http://www.dunedin.govt.nz/services/roads-and-footpaths> or contact Transport on 477 4000.

For properties abutting the state highway, Waka Kotahi NZ Transport Agency is the Road Controlling Authority.

Glossary of Terms and Abbreviations

The following are abbreviations and terms that may appear as a part of a LIM.

Consent, Permit, Licence & Complaint types

AAB	DCC Building permit
AAD	DCC Drainage permit
AAG	Green Island drainage permit
AAH	Hyde permit
AAK	St Kilda permit
AAM	Mosgiel permit
AAP	Port Chalmers permit
AAS	Silverpeaks permit
AAT	Maniototo permit
ABA	Application Building Act 1991
AMD	Amendment to a Building Consent
BC	Building Consent
BCC	Building Compliance Certificate - Sale and Supply of Alcohol Act
BCM	Building Complaint
CER	Certifier
COA	Certificate of Acceptance
DGL	Dangerous Goods Licensing
ENV	Health complaint
HTH	Health licence
LIQ	Alcohol licence
NTF	Notice to Fix
NTR	Notice to Rectify
PIM	Project Information Memorandum
POL	Planning Other Legislation
RMA	Resource Management Act - Resource consent
RMC	Resource consent complaint
WOF	Building Warrant of Fitness

Terms used in Permits & Consents

ALT	Alteration
ADD	Addition
BD D/C	Board drain in common
BLD	Building
BLDNG	Building
BT	Boundary trap
B/T	Boiler tube
CCC	Code Compliance Certificate
DAP	Drainage from adjacent property
DGE	Drainage
DIC	Drain in common
DR	Drainage
DWG	Dwelling
FS	Foul sewer
HEA	Heater
ICC	Interim Code Compliance

MH	Manhole
PL	Plumbing
PLB	Plumbing
PTE	Private
SIS	Sewer in section
WC	Water course
WT	Water table
SW	Stormwater

General terms

RDMS Records and Document Management System



Appendices



Photographic Map

Scale at A4:

1:1,500

15/05/2026
8:00:24 PM




PARCEL LINES CAN VARY FROM
LEGAL PARCEL BOUNDARIES

This map is for illustration purposes only
and is not accurate to surveying, engineering
or orthographic standards. Every effort
has been made to ensure correctness and
timeliness of the information presented.

2018-2019 Urban. Copyright DCC/Aerial Surveys
Ltd. Rural, ORC/Aerial Surveys Ltd. CC BY 4.0 NZ

2013 Urban and rural photography Jan/Feb 2013.
Copyright DCC. CC BY 3.0 NZ.

2006/2007 Urban photography March 2007,
copyright NZAM. Rural photography March
2006, copyright Terralink International Ltd.

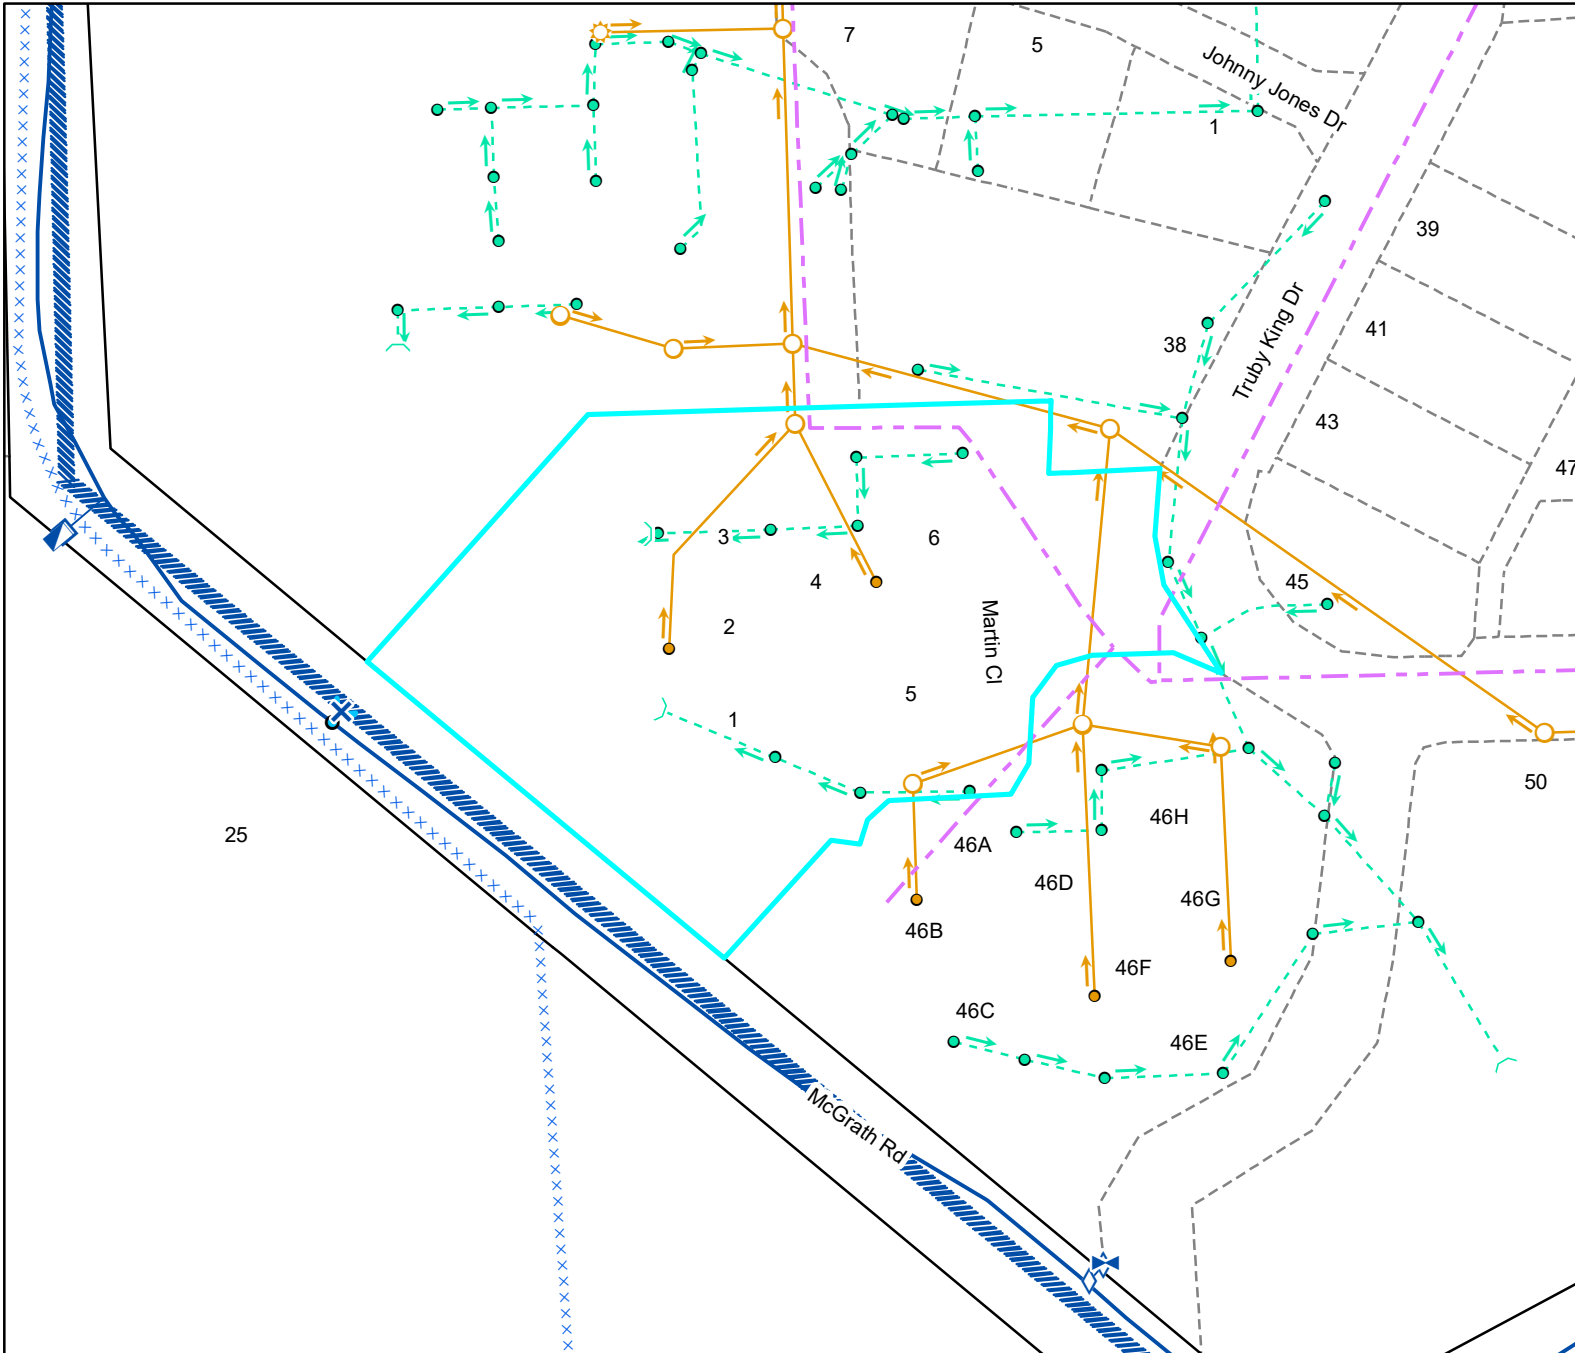

Legend

Water Supply

	Manifold Box		Water Non-Return Valve
	Water Meter		Water Pump Station
	Toby		Water Bore
	Meter without manifold box		Water Treatment Plant
	Retic Flow Meter		Water Storage Tank
	Combination Meter		Supply Main
	Manifold Box With Restrictor		Trunk Main
	Water Valve - Zone		Disused
	Non Return Valve		Reticulation
	Water Valve - Gate		Scour
	Water Valve - Sluice		Water Service Lateral
	Water Hydrant		Water Fire Service Lateral
	Water Backflow Preventor - RPZ		Water Critical Service Lateral
			Water Zone Boundary
			Water Reservoir
			Redundant Water Main

NOTE:
Private water services have the same symbols as those above, however they are coloured pink.

Foul Sewerage

	Standard Manhole		Pump Station
	Valve Chamber (pressurised)		Treatment Plant
	Boundary Kit		Vent
	Non-Return Valve		Foul Sewer Node
	Pump Station Domestic		Foul Drains in Common (public)
	Drop Manhole		Sewer
	Inspection Manhole		Trunk Sewer
	Inspection Opening		Vent Line
	Lamphole		Rising Main
	Outlet		Redundant Foul Sewer Pipe

NOTE:
Private foul drains have the same symbols as those above, however they are coloured orange.

Stormwater

	SW Bubble-up Tank		Roading Bubble-Up Tank
	SW Drop Manhole		Roading Mudtank
	SW Insp Chamber and Grating Inlet		Stormwater Main
	SW Inspection Manhole		Stormwater Trunk Main
	SW Inspection Opening		DCC Open Channel
	SW Lamphole		Piped WC
	SW Mudtank Inlet		Open WC
	SW Outlet		Culvert
	SW Pipe Inlet		Stormwater Mudtank Pipe
	SW Pressure Manhole		Redundant Stormwater Main
	SW Standard Manhole		SW Sump
	SW Stormwater Node		SW Pump Station

NOTE:
Private stormwater drains have the same symbols as those above, however they are coloured light green.

General

	DCC Water & Waste Structure		Parcel
	Railway Centreline		Hydro
			Motorway Parcels
			Strata
			Easment (where recorded)

Cadastral

	Road/Rail
	Motorway Parcels
	Easment (where recorded)

Full legend can be viewed at <https://www.dunedin.govt.nz/council-online/webmaps/waterservices>



Council Water & Drainage Services



Information shown is the best available at the time of publishing. The accuracy and completeness of This information is variable. Private assets are typically not mapped. Recent changes may not be reflected. Verify on site before commencing work. For all enquiries phone 03 477 4000.

Scale at A4:
1:1,500
15/05/2026
8:00:33 PM




PARCEL LINES CAN VARY FROM LEGAL PARCEL BOUNDARIES
This map is for illustration purposes only and is not accurate to surveying, engineering or orthophotographic standards. Every effort has been made to ensure correctness and timeliness of the information presented.

2019-2019 Urban. Copyright DCC/Aerial Surveys Ltd. Rural, ORC/Aerial Surveys Ltd. CC BY 4.0 NZ
2013 Urban and rural photography Jan/Feb 2013. Copyright DCC. CC BY 3.0 NZ.
2006/2007 Urban photography March 2007, copyright NZAM. Rural photography March 2006, copyright T erralink International Ltd.

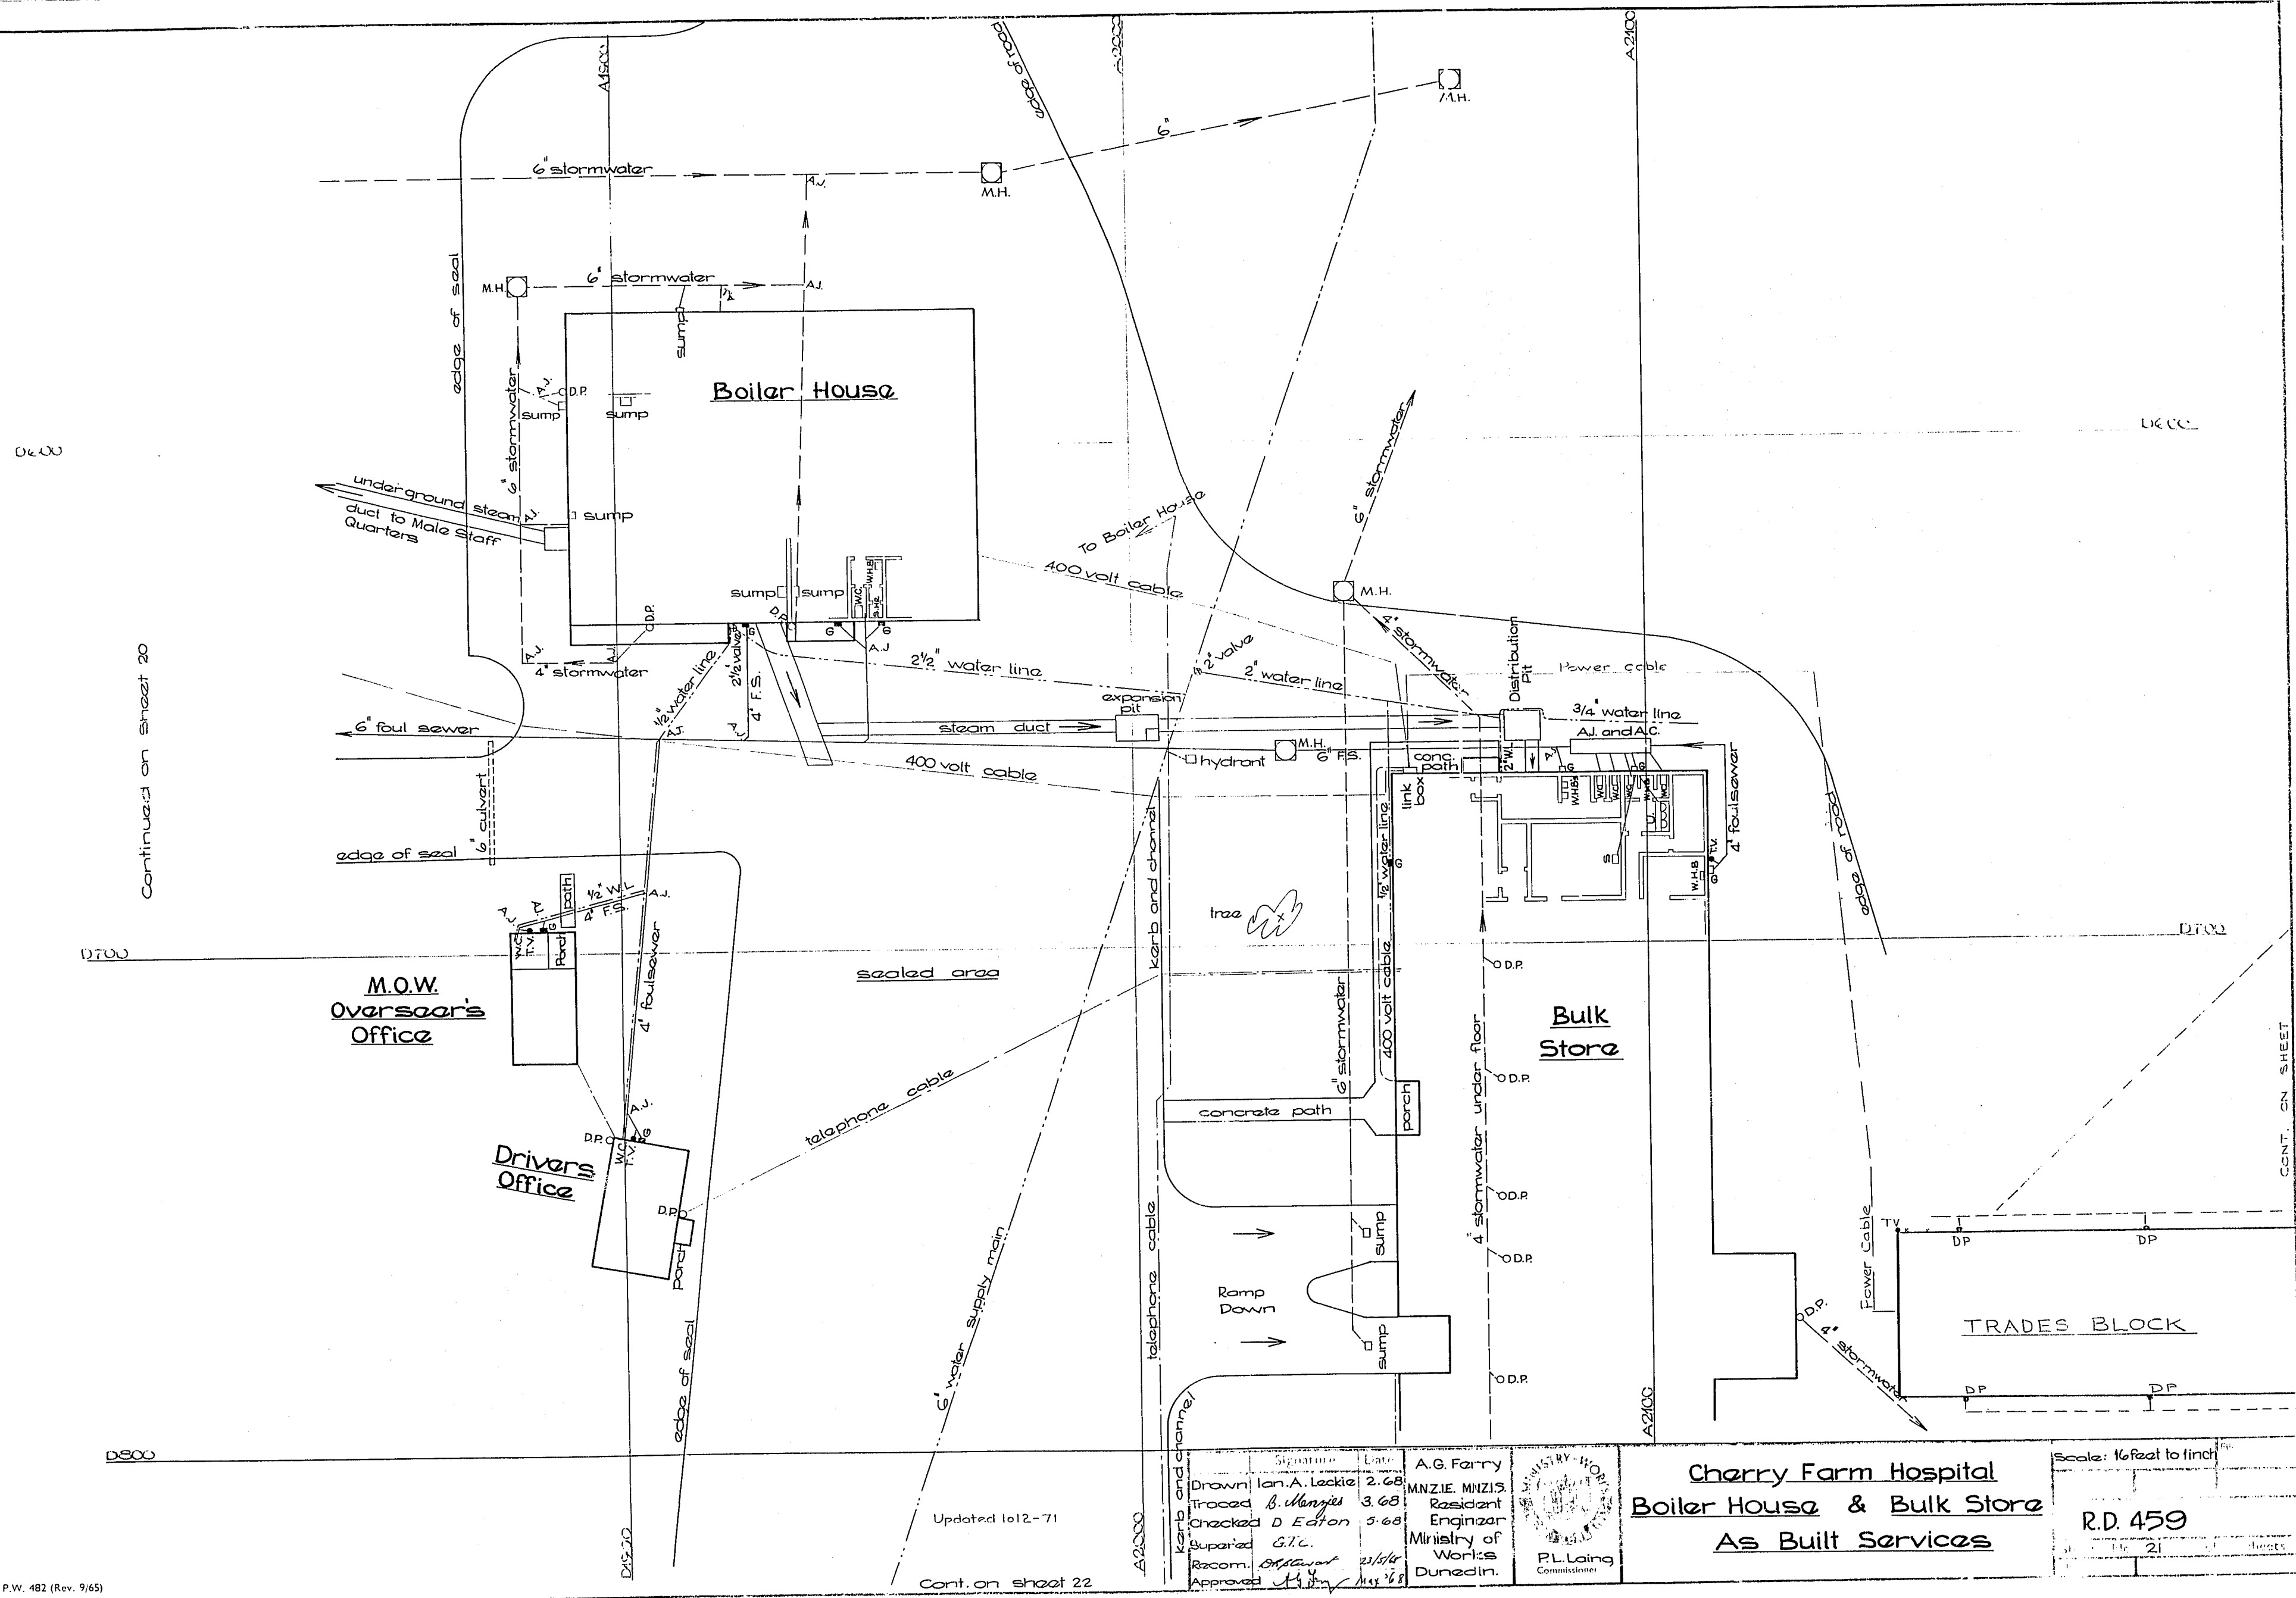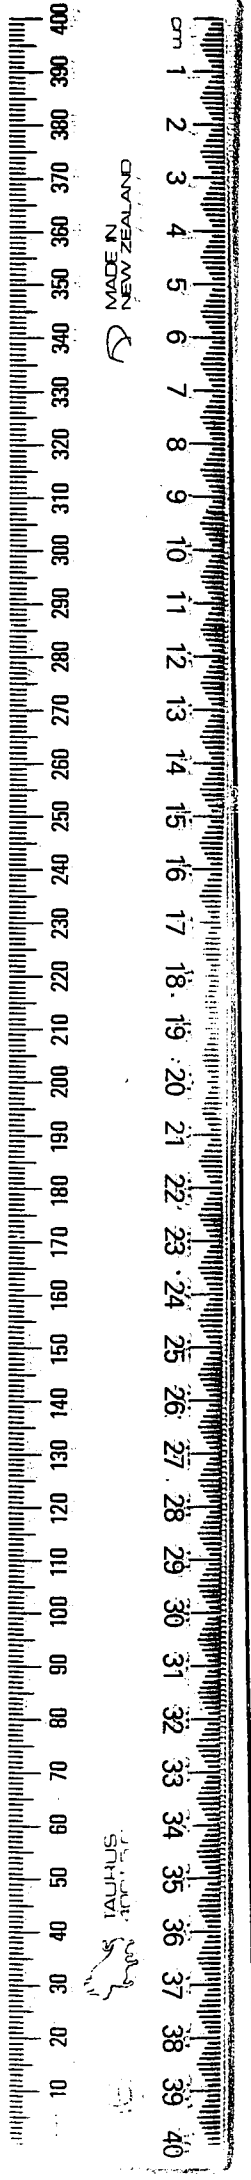



	Signature	Date
Drawn	Ian A. Lockie	2.68
Traced	B. Wengier	3.68
Checked	D. Edton	5.68
Supported	G.T.C.	
Recom.	B. Stewart	22/6/68
Approved	A. G. Farry	11/4/68

A.G. Farry
MINZIE, MINZIS
Resident
Engineer
Ministry of
Works
Dunedin.

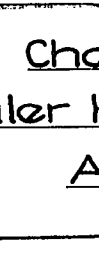

**Cherry Farm Hospital
Boiler House & Bulk Store
As Built Services**

Scale: 1/4" = 1' to 1/2" = 1'
R.D. 459
Sheet 2 of 2

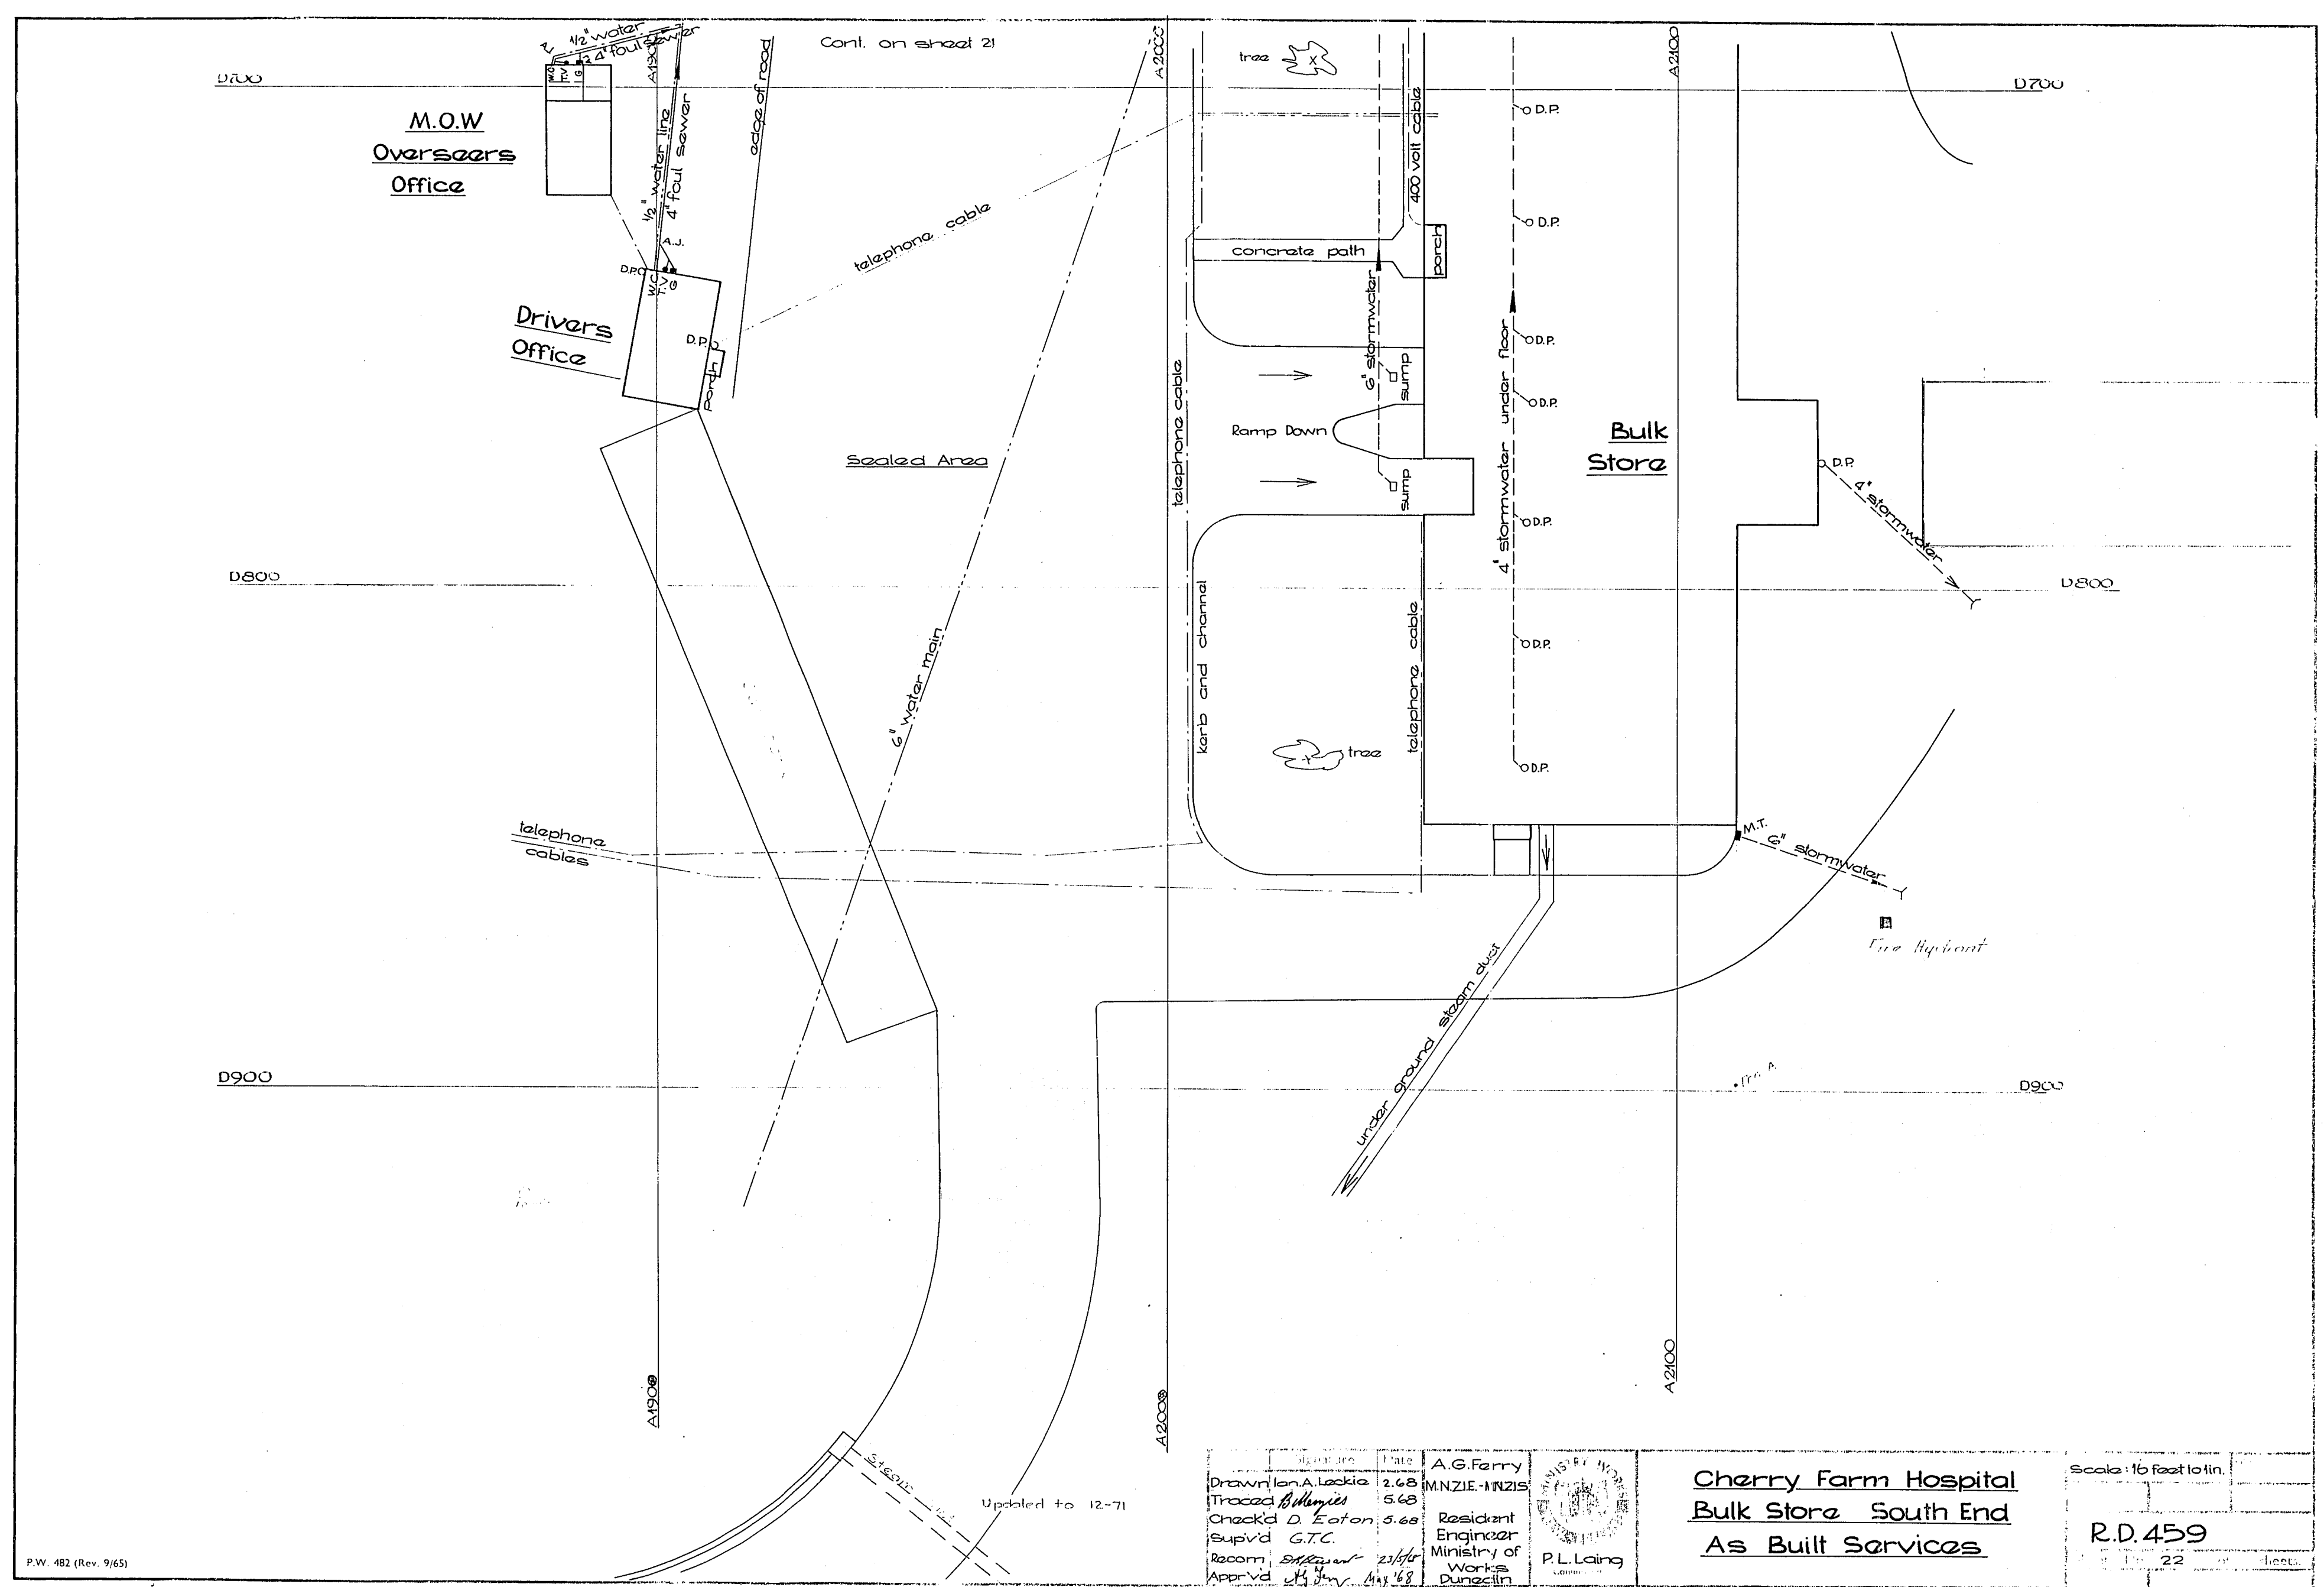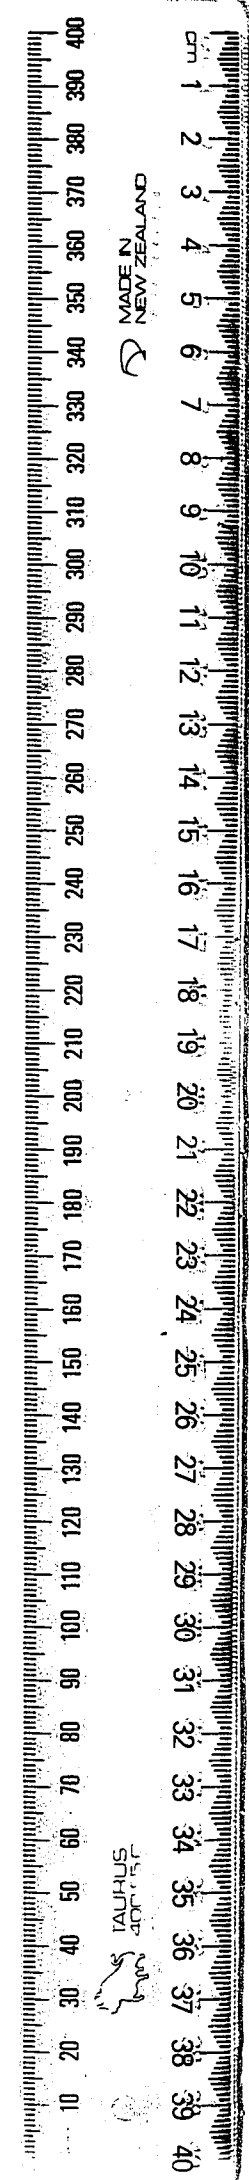

Drawn by	A. Leckie	Date	2.6.68
Traced by	M. Jones	Date	5.6.68
Checked by	D. Eaton	Date	5.6.68
Sup'd by	G.T.C.		
Recomm.	S. Jones	Date	21/5/70
App'd by	S. Jones	Date	11/5/68
Authorised	A.G. Ferry	Date	11/5/68
Engineer	MNZIE-11/215		
Resident Engineer	Ministry of Works		
Works Division	P.L. Laing		


Cherry Farm Hospital
Bulk Store South End
As Built Services

Scale: 1/6 inch to 1 foot

R.D. 459


22

1 2 3 4 5 6 7 8 9 10 11 12 13 14 15 16 17 18 19 20 21 22 23 24 25 26 27 28 29 30 31 32 33 34 35 36 37 38 39 40

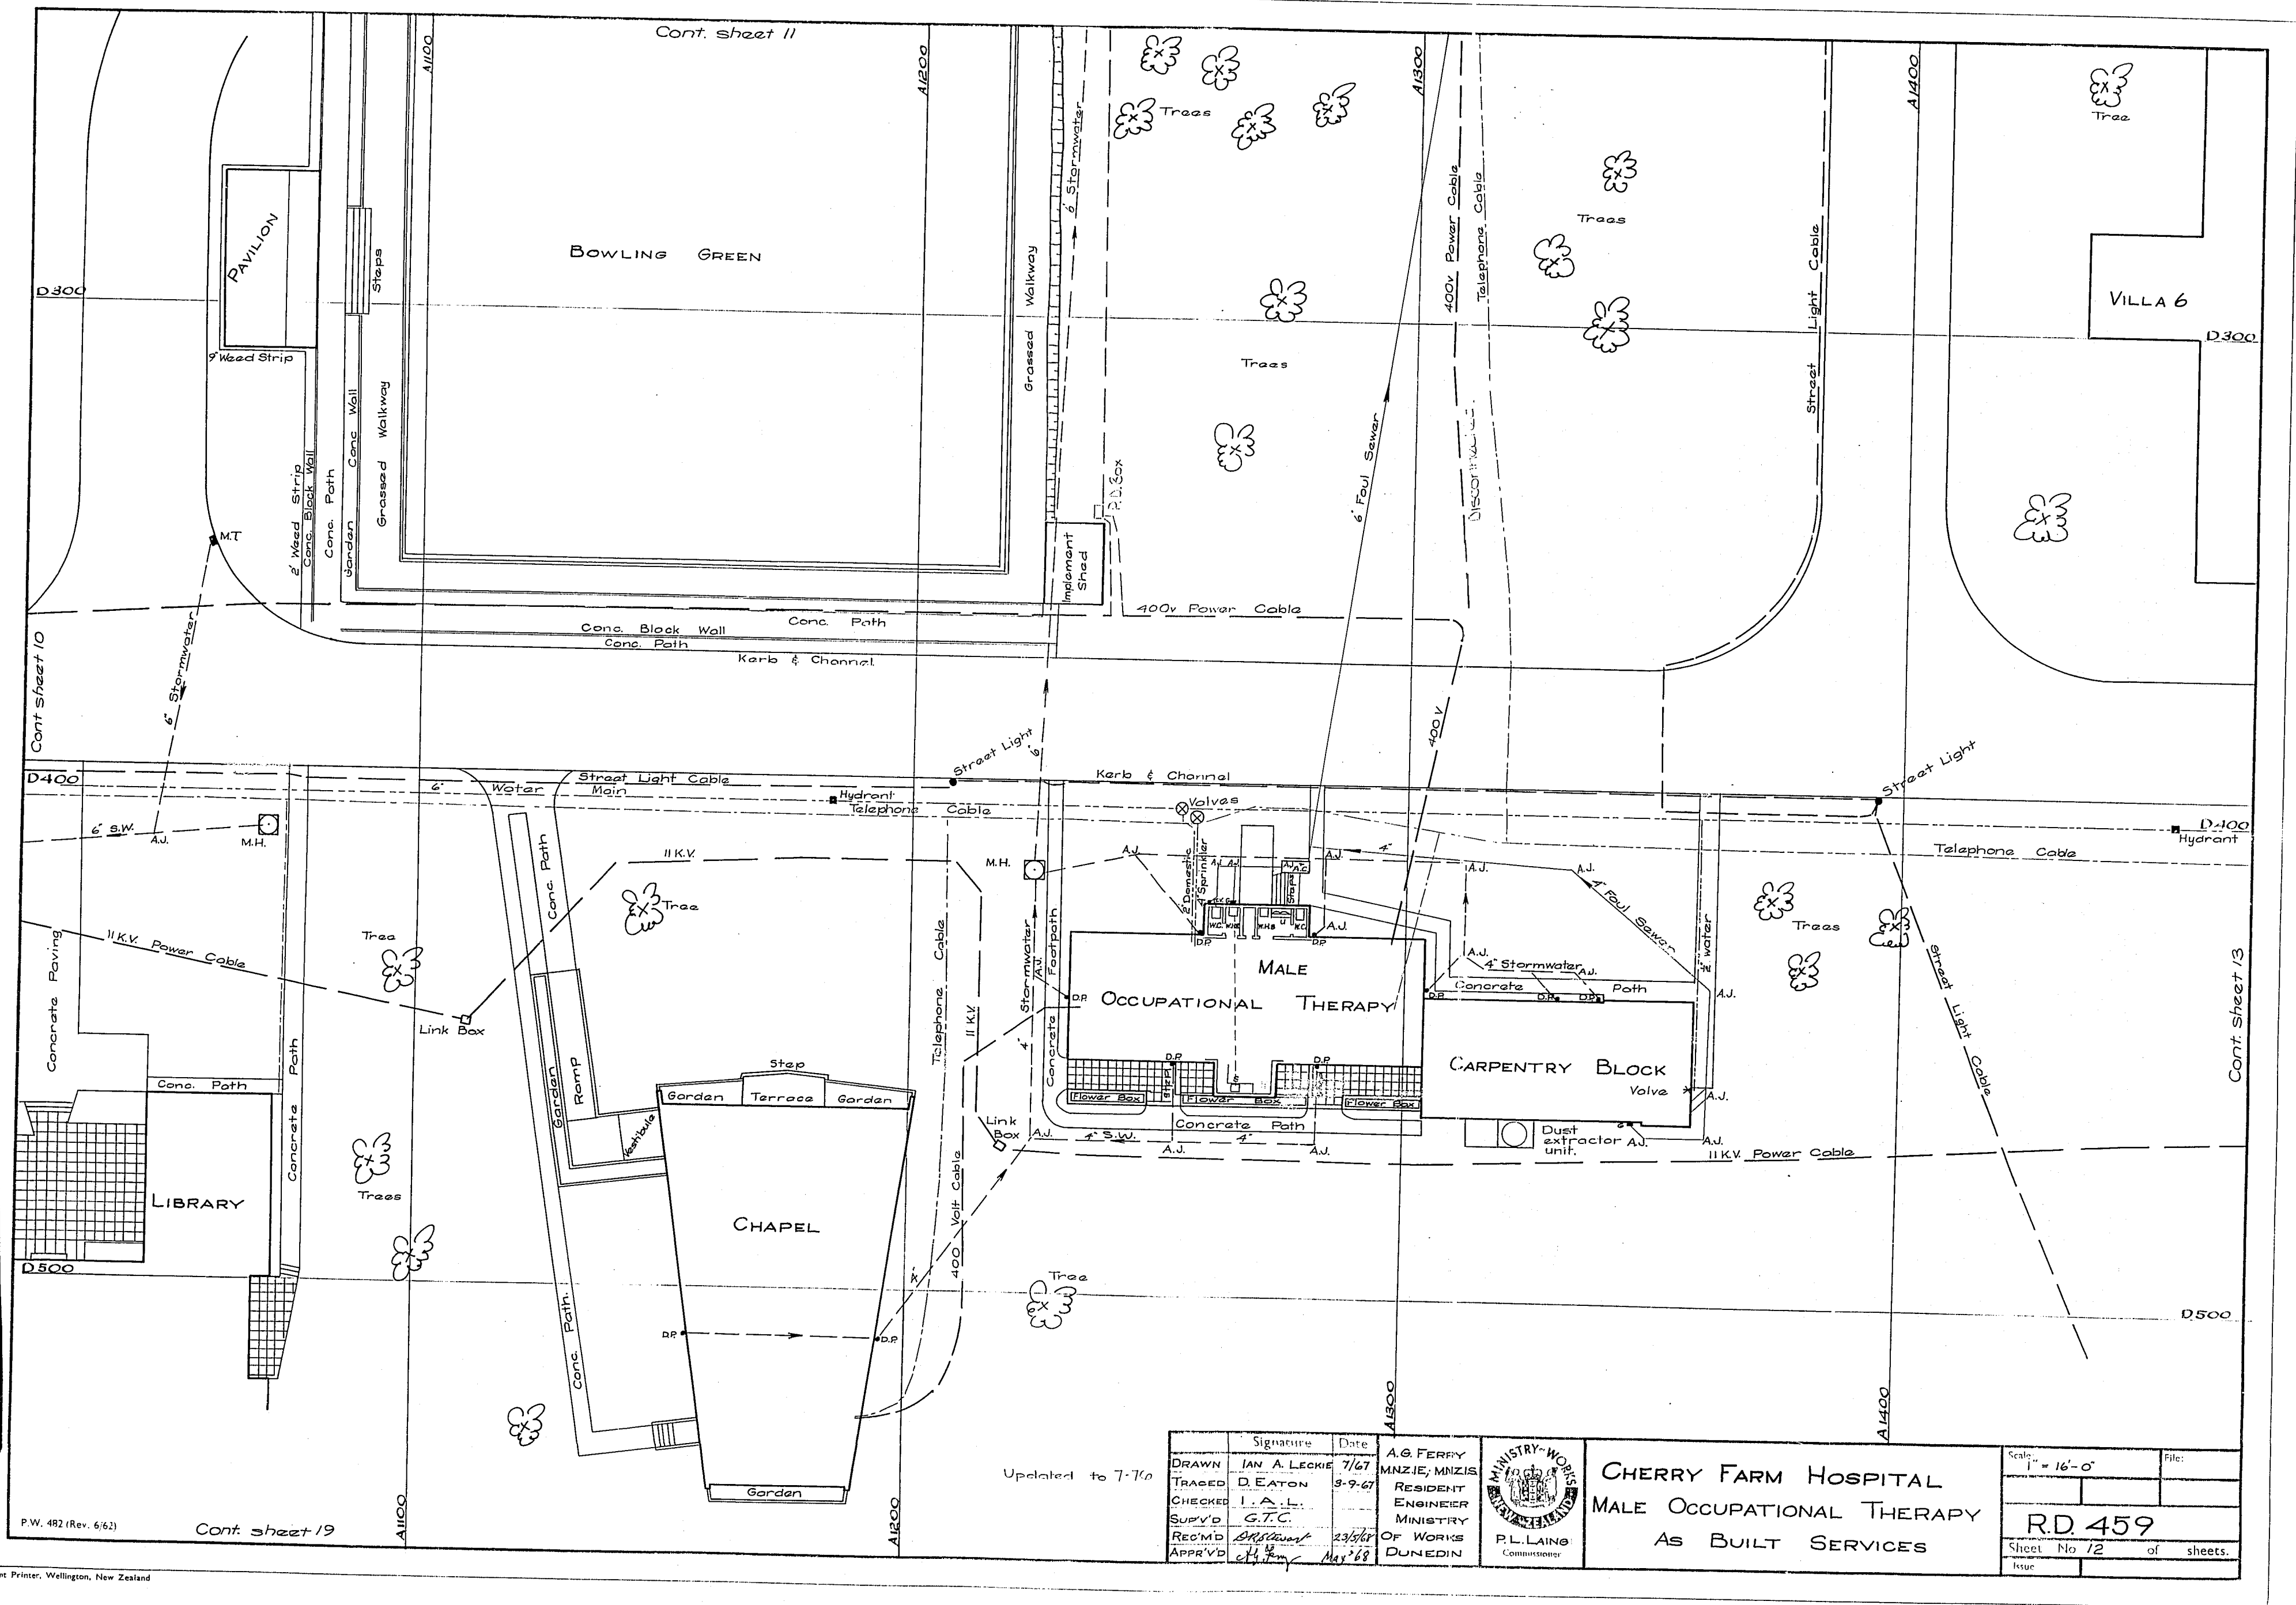


Updated to 7-7/60		Signature: <i>IAN A. LECKIE</i> Date: <i>7/67</i> A.G. FERRY MNZIE, MNZIS RESIDENT ENGINEER MINISTRY OF WORKS DUNEDIN		CHERRY FARM HOSPITAL MALE OCCUPATIONAL THERAPY AS BUILT SERVICES	Scale: 1" = 16'-0" File:
DRAWN: <i>IAN A. LECKIE</i> TRACED: <i>D. EATON</i> CHECKED: <i>L. A. L.</i> SUPV'D: <i>G.T.C.</i> REC'D: <i>23/67</i> APPR'D: <i>24/67</i>	Signature: <i>P.L. LAING</i> Date: <i>May '68</i> P.L. LAING Commissioner	R.D. 459 Sheet No 12 of sheets. Issue			

1 2 3 4 5 6 7 8 9 10 11 12 13 14 15 16 17 18 19 20 21 22 23 24 25 26 27 28 29 30 31 32 33 34 35 36 37 38 39 40

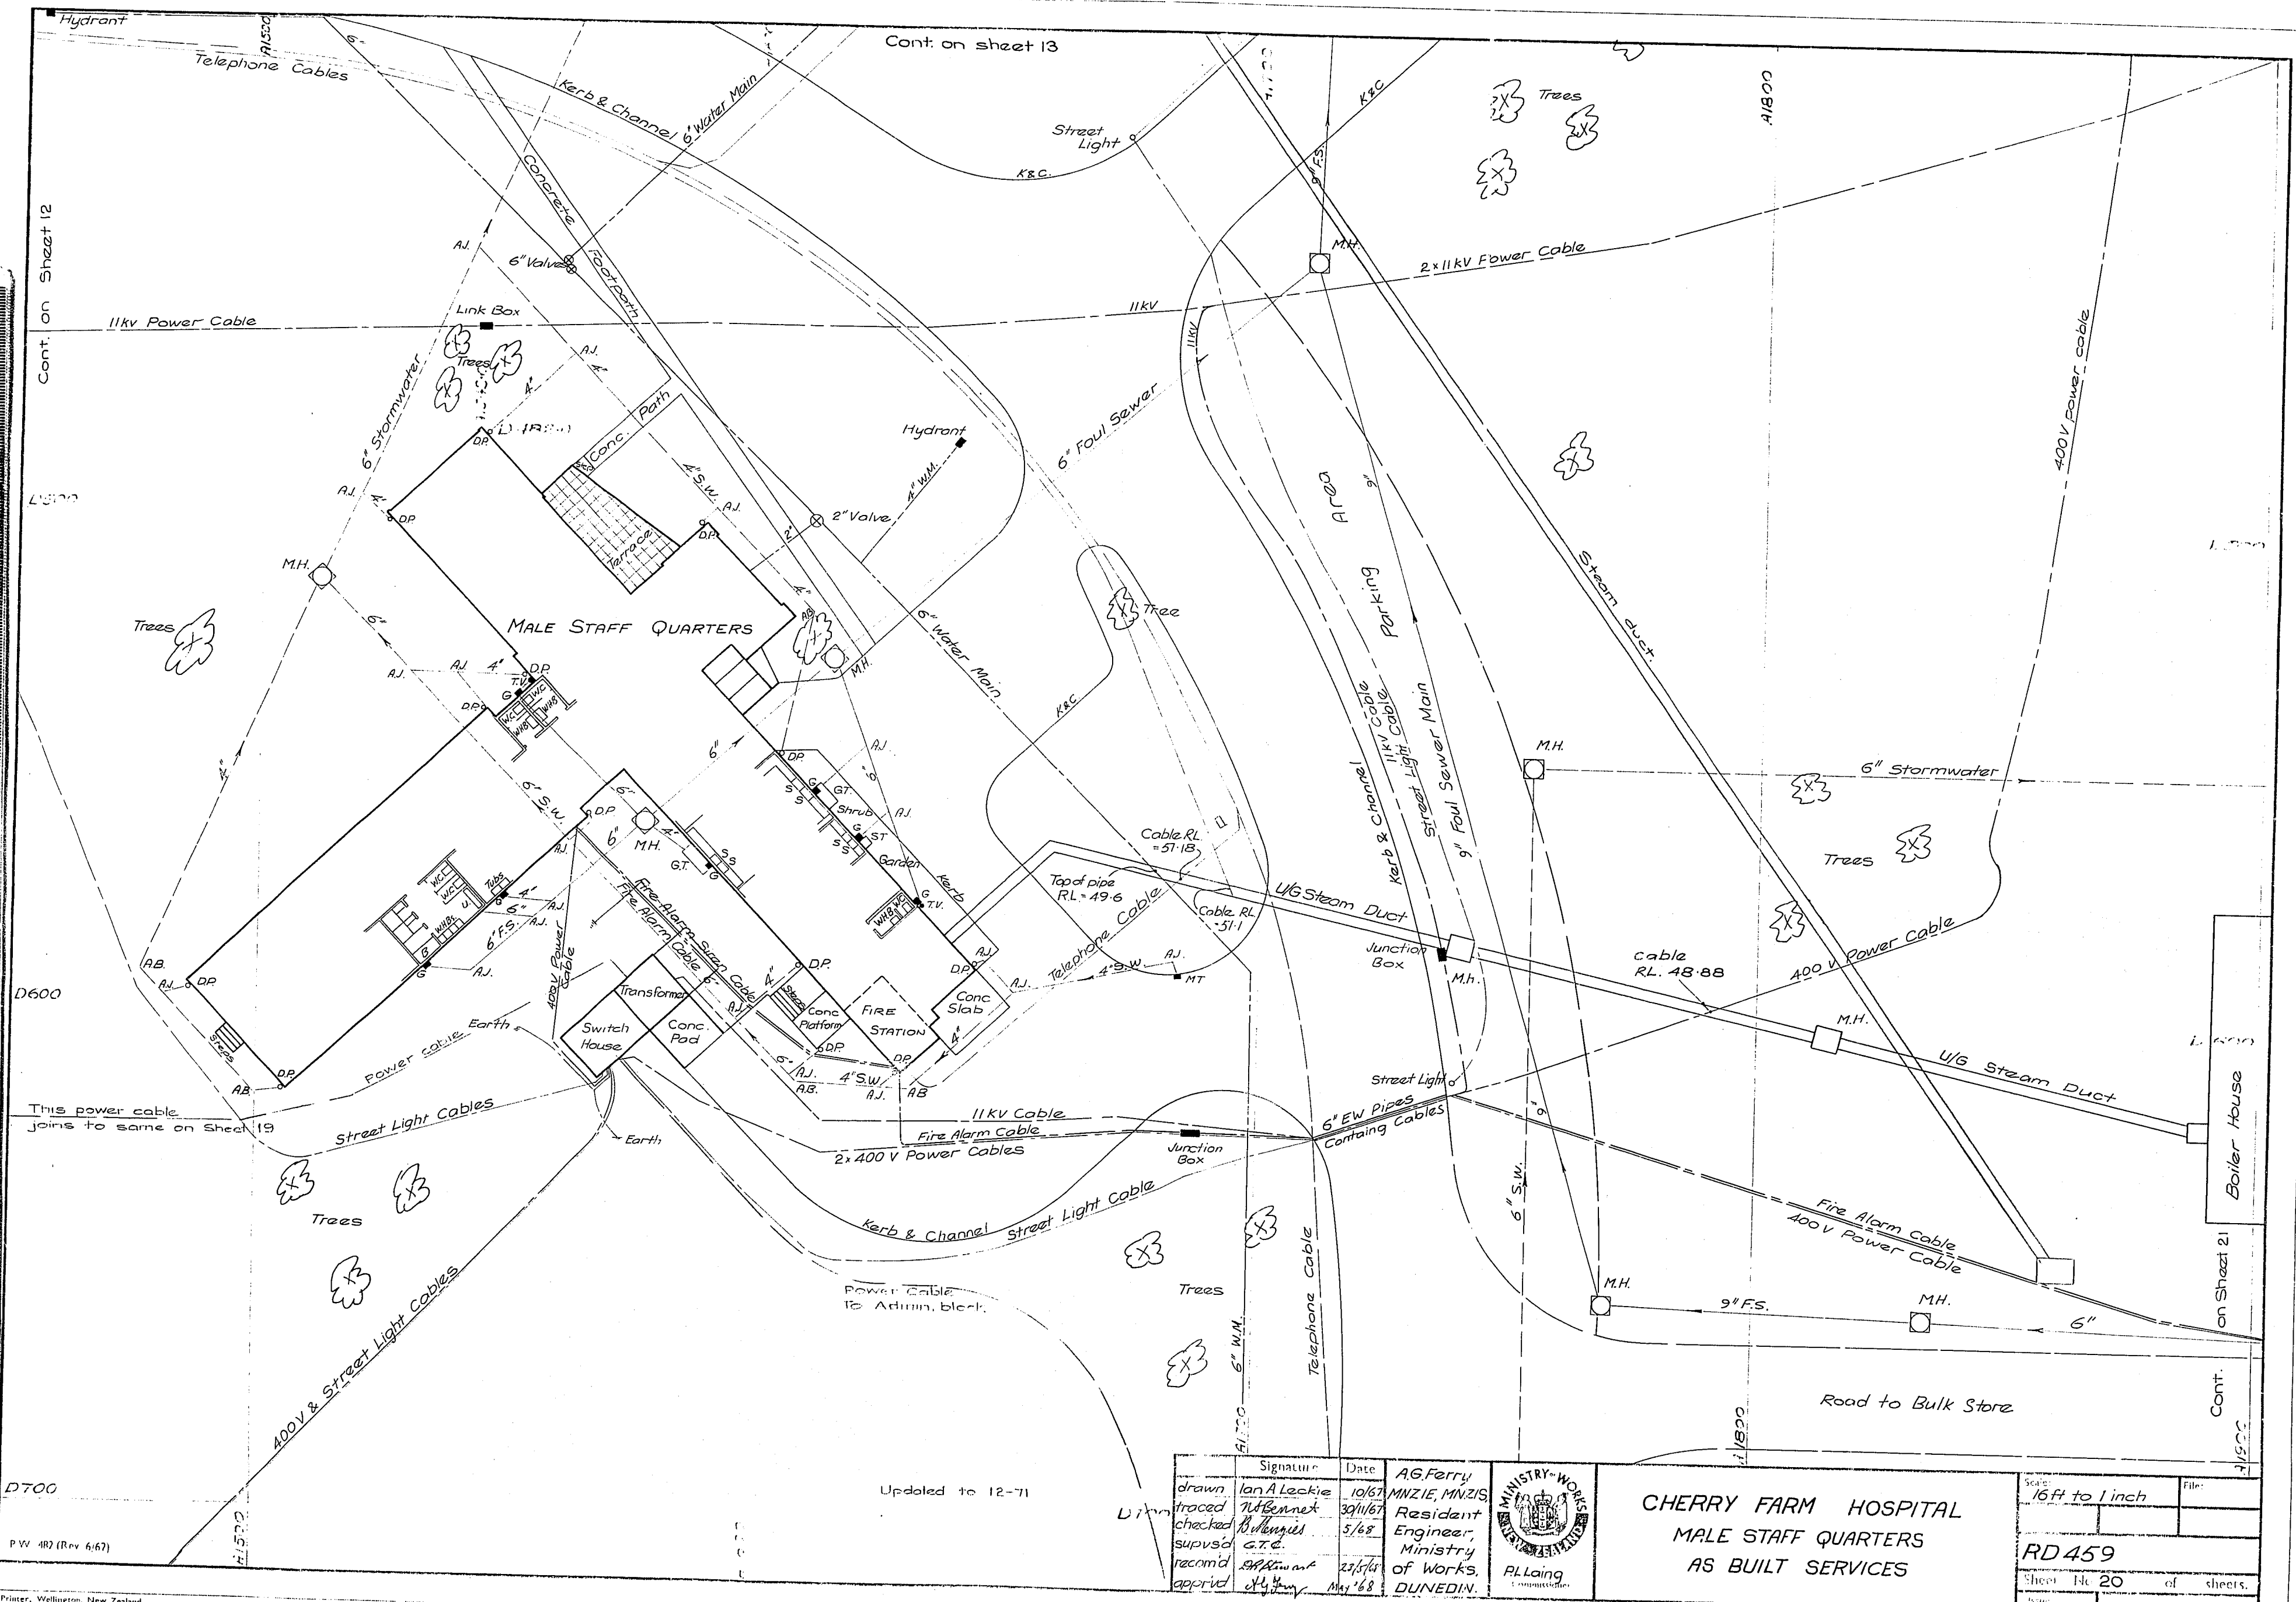

Signature	Date	AG. Ferry	 CHERRY FARM HOSPITAL MALE STAFF QUARTERS AS BUILT SERVICES	Scale:	16 ft to 1 inch
Drawn	10/67	MNZIE, MNZIS		Sheet	RD 459
Traced	3/11/67	Resident		of	20
Checked	5/68	Engineer,		of	
Supvised	G.T.C.	Ministry		of	
Record	23/6/68	of Works,			
Approved	May '68	DUNEDIN.			

10 20 30 40 50 60 70 80 90 100 110 120 130 140 150 160 170 180 190 200 210 220 230 240 250 260 270 280 290 300 310 320 330 340 350 360 370 380 390 400
 MADE IN NEW ZEALAND
 1 2 3 4 5 6 7 8 9 10 11 12 13 14 15 16 17 18 19 20 21 22 23 24 25 26 27 28 29 30 31 32 33 34 35 36 37 38 39 40
 1/4" = 1'

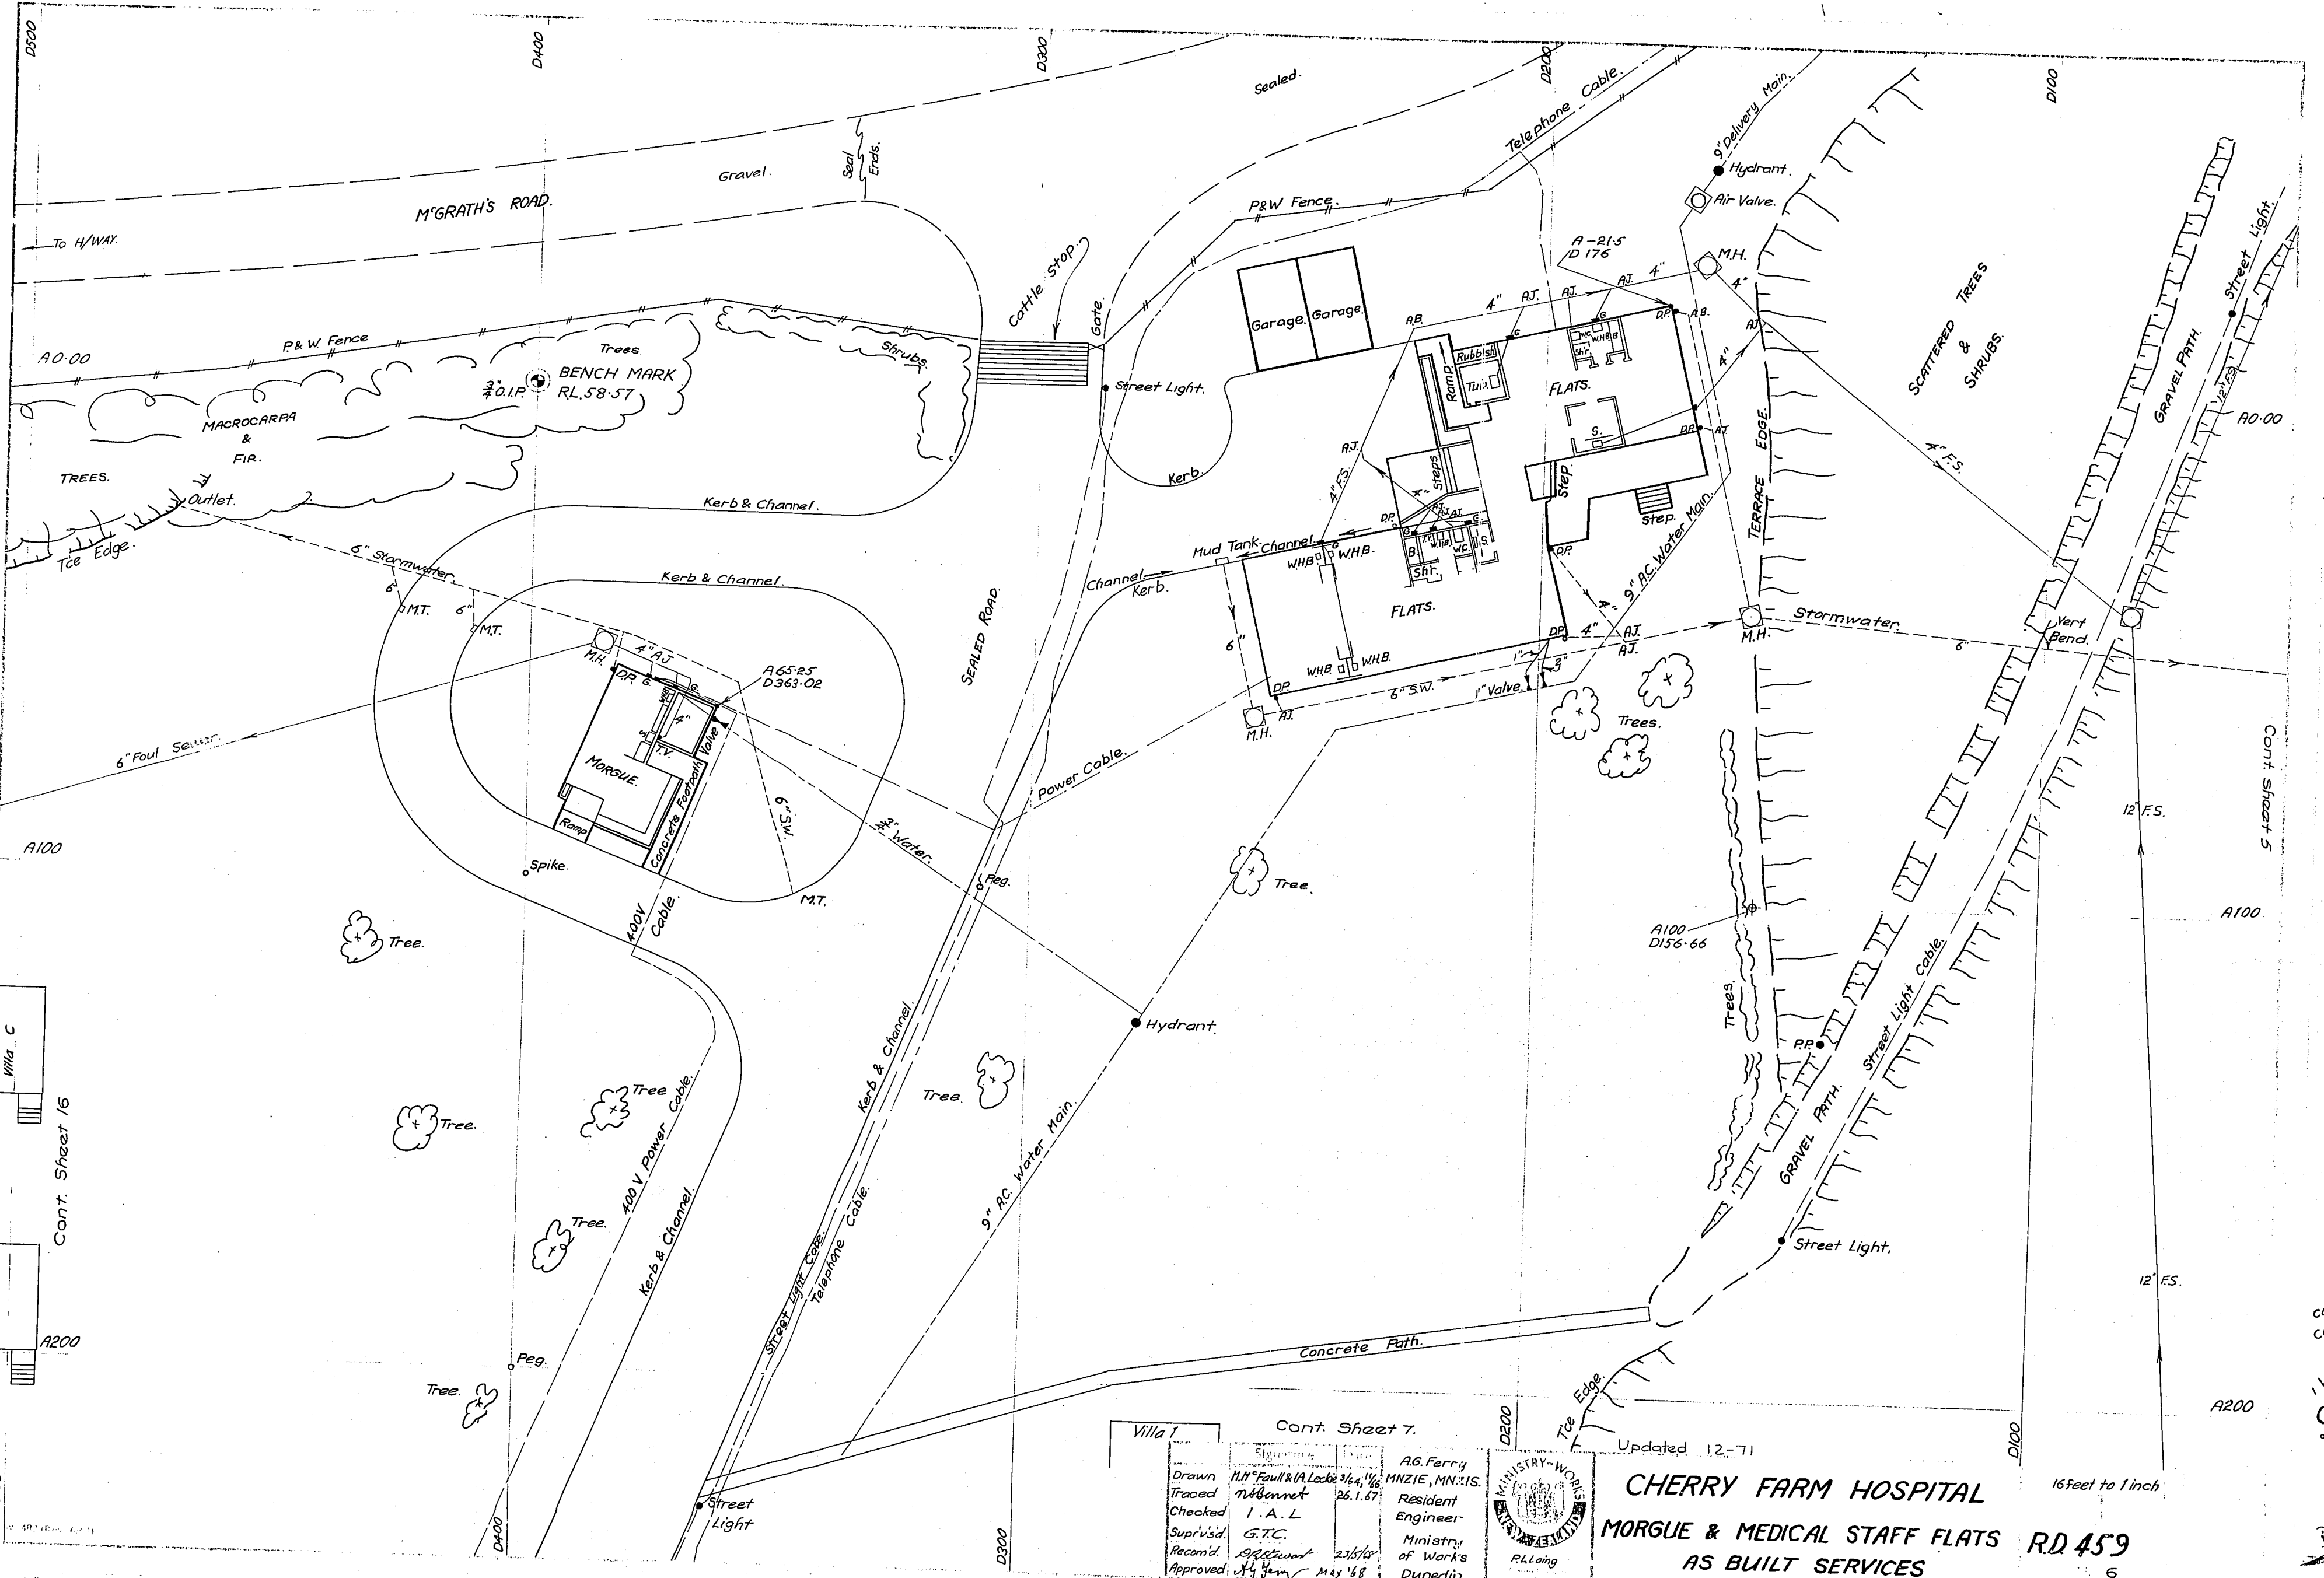

Cont. Sheet 7.


Drawn	M. H. Foulk	25.1.57
Traced	N. Bonnet	
Checked	I. A. L.	
Supervised	G. T. C.	
Revised	G. T. C.	23/6/58
Approved	M. H. Foulk	May '58

AG. Ferry
 MINZIE, M. H. S.
 Resident Engineer
 Ministry of Works
 Dunedin.



Updated 12-71
CHERRY FARM HOSPITAL
MORGUE & MEDICAL STAFF FLATS
AS BUILT SERVICES
R.D. 459
 6

AS

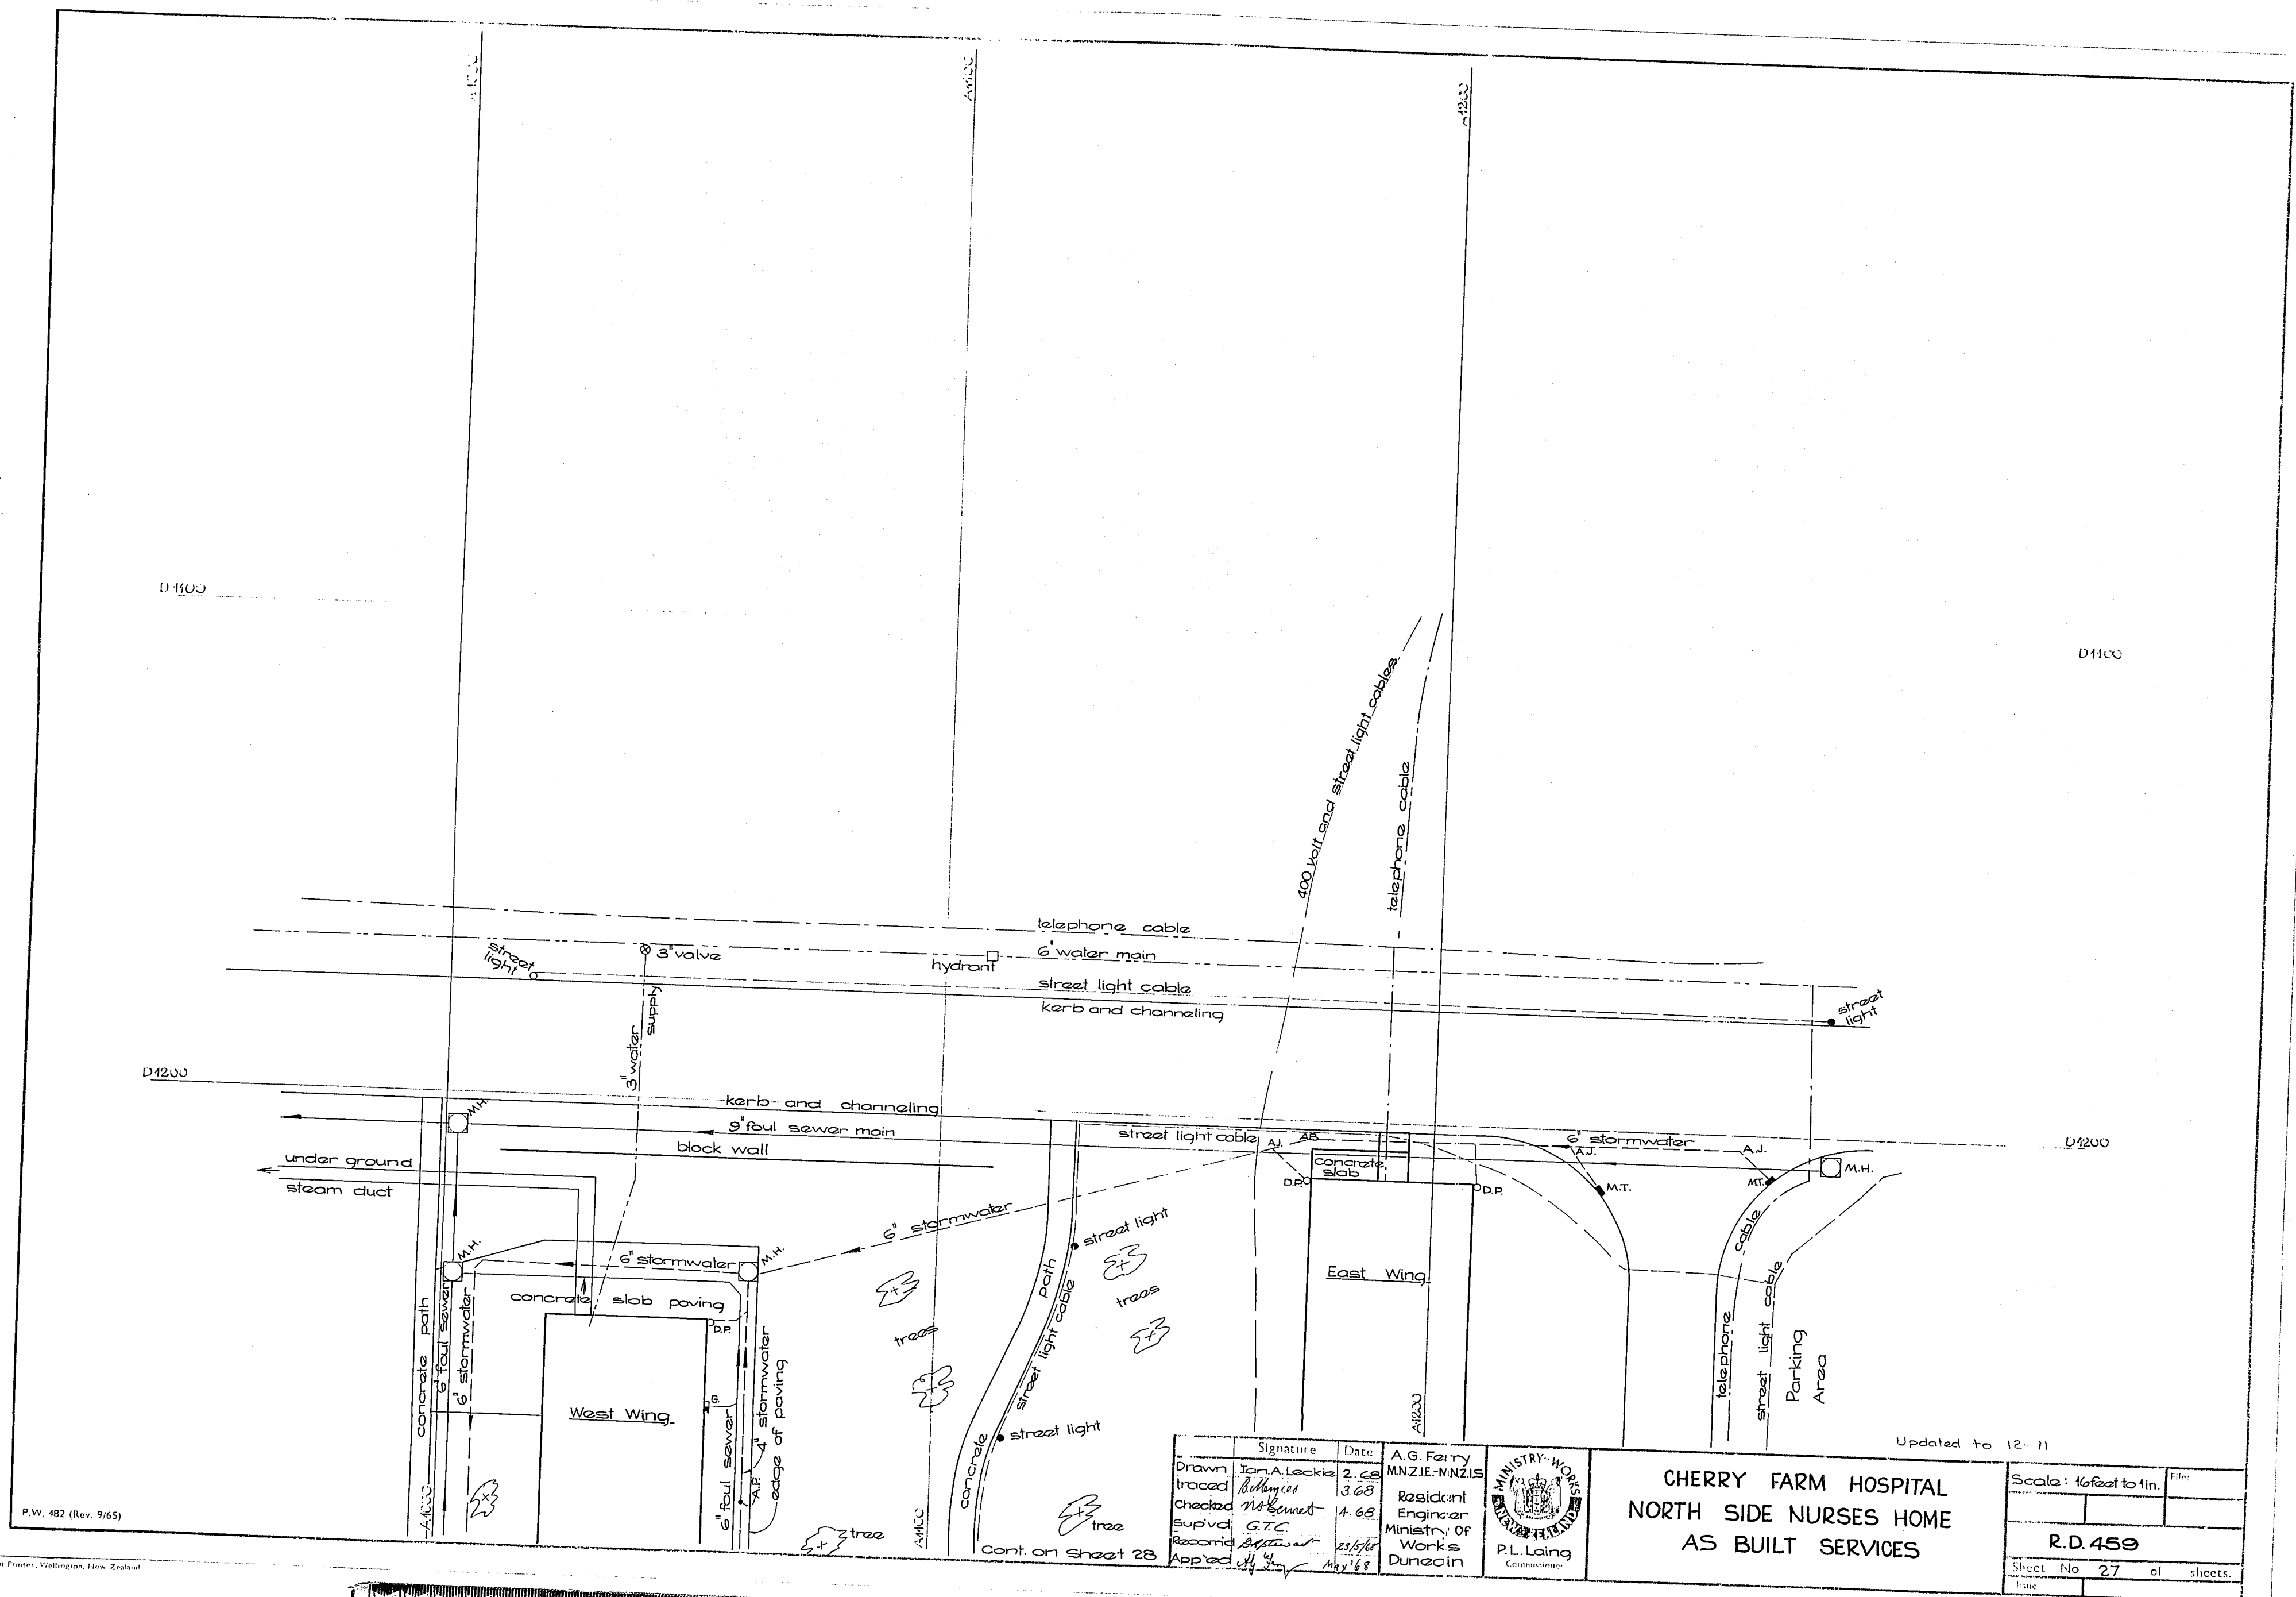



Signature	Date	Author
Drawn: Ian A. Leckie	2. 68	A.G. Fair
Traced: R. G. G. G.	3. 68	MNZIE-MNZIS
Checked: R. G. G. G.	4. 68	Resident Engineer
Sup'd: G.T.C.	25/6/68	Ministry of Works
Approved: R. G. G. G.	25/6/68	Dunedin



**CHERRY FARM HOSPITAL
NORTH SIDE NURSES HOME
AS BUILT SERVICES**

Scale: 1/4" = 1' 0"	File:
R.D. 459	
Sheet No 27 of sheets.	

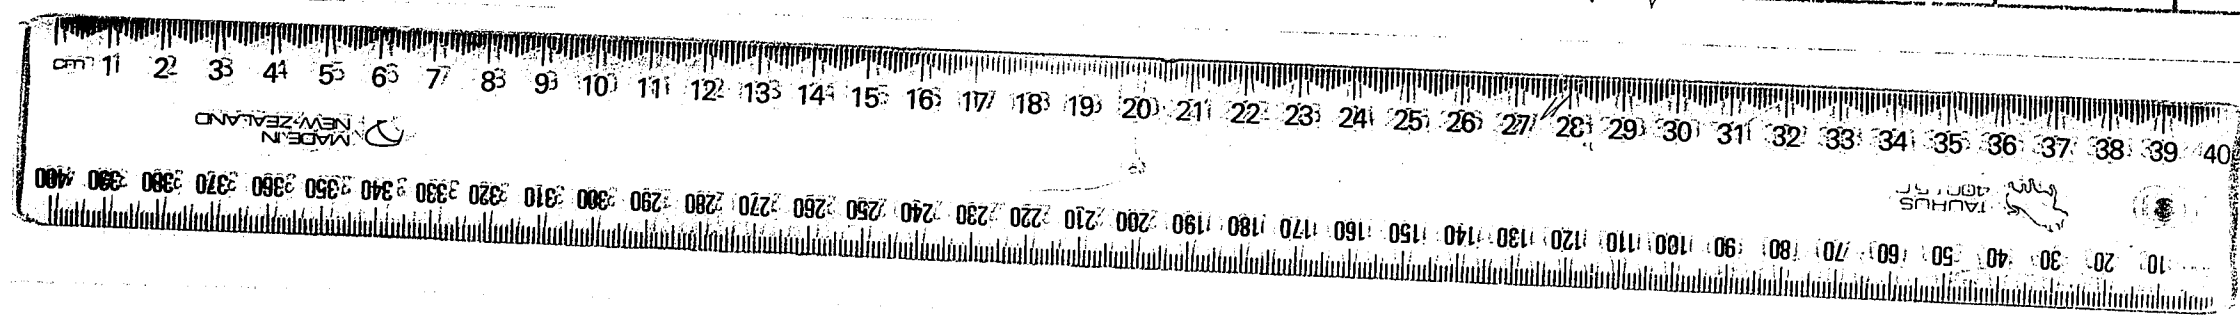

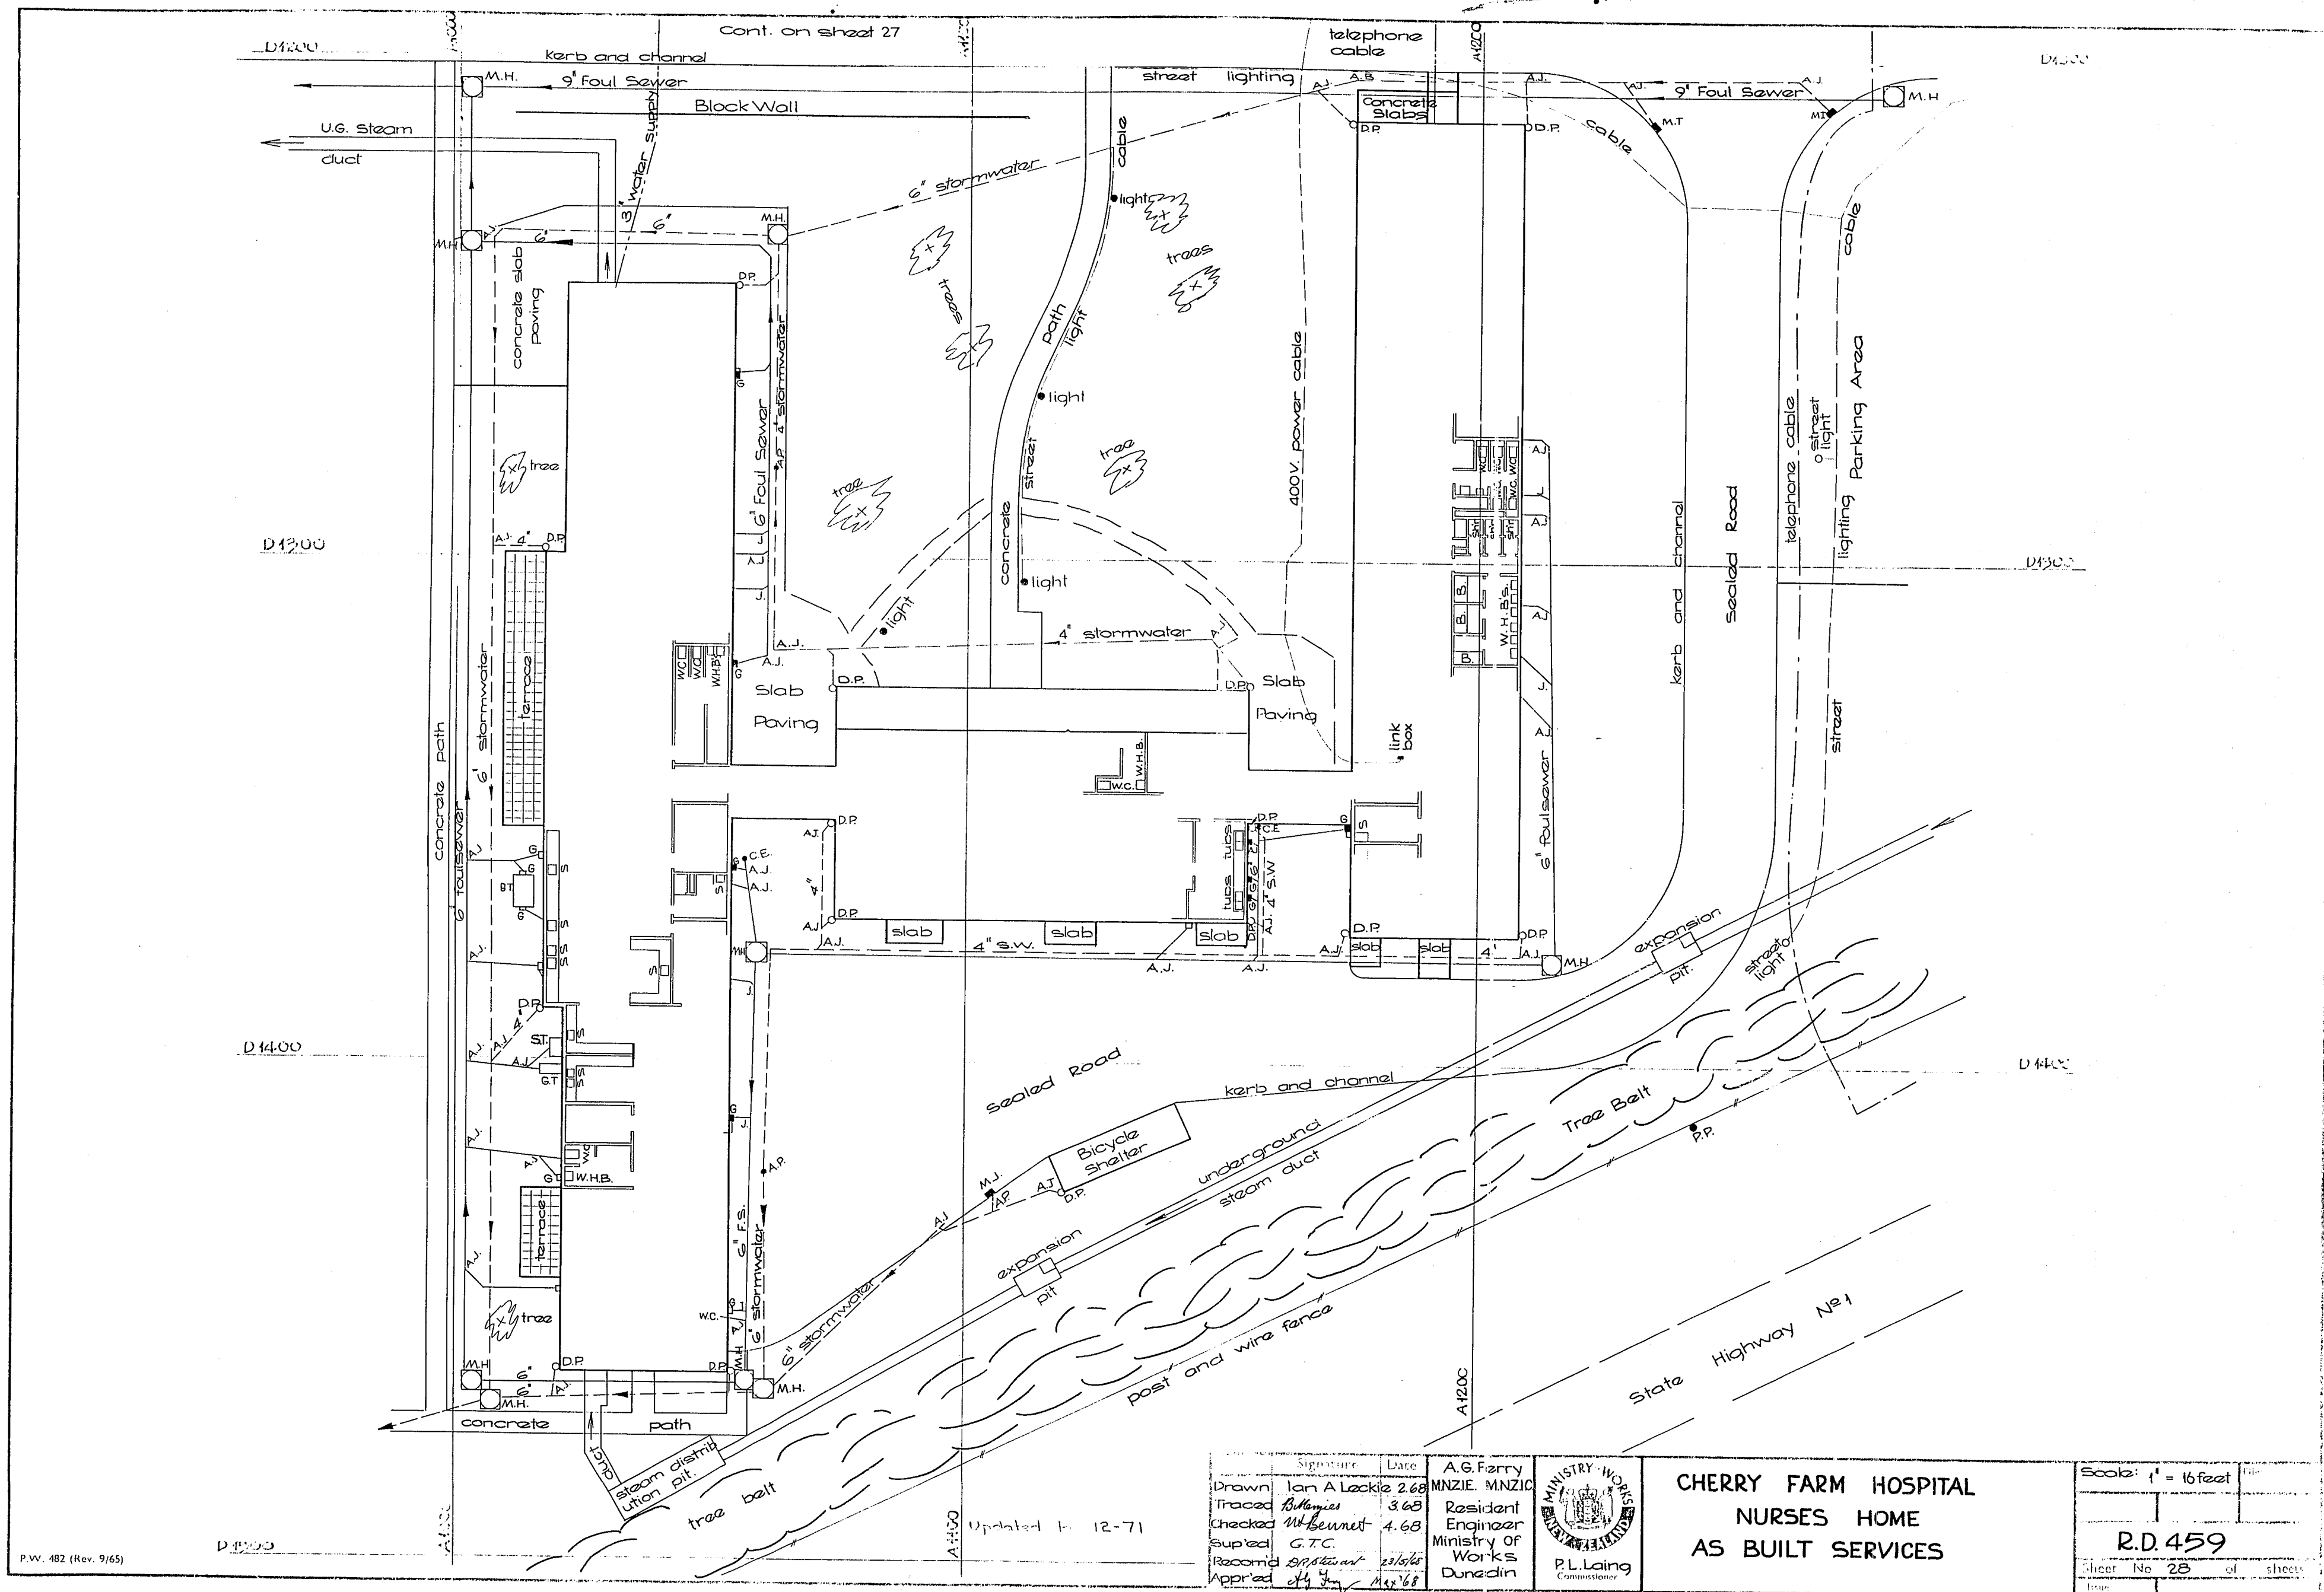


Signature	Date
Drawn Ian A. Lockie	2.6.68
Traced B. Hennessey	3.6.68
Checked W. Bennett	4.6.68
Supplied G.T.C.	
Revised 21/6/68	
Approved 24/6/68	



A.G. Ferry
 MNZIE, MNZIC
 Resident Engineer
 Ministry of Works
 Dunedin




**CHERRY FARM HOSPITAL
 NURSES HOME
 AS BUILT SERVICES**

Scale: 1" = 16 feet
R.D. 459
Sheet No. 28 of sheets

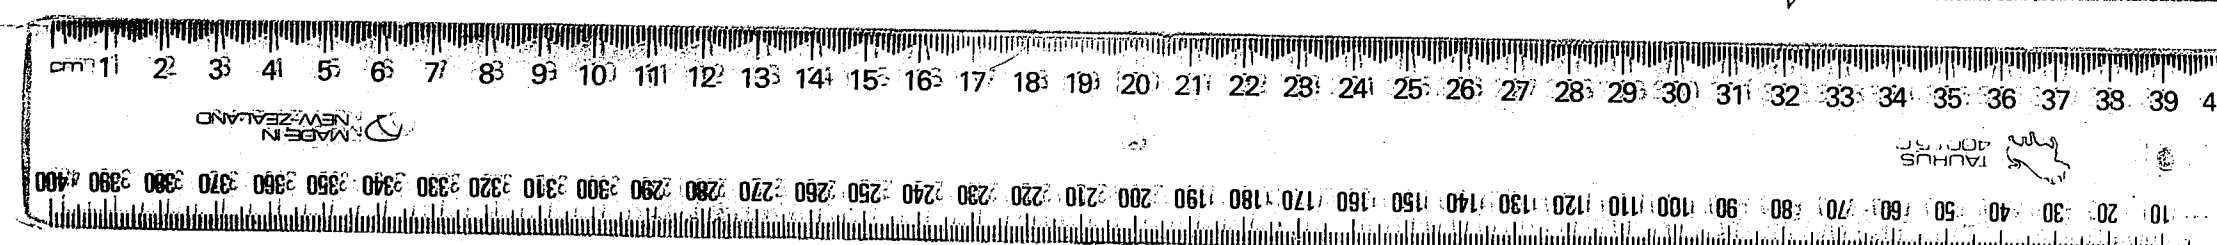

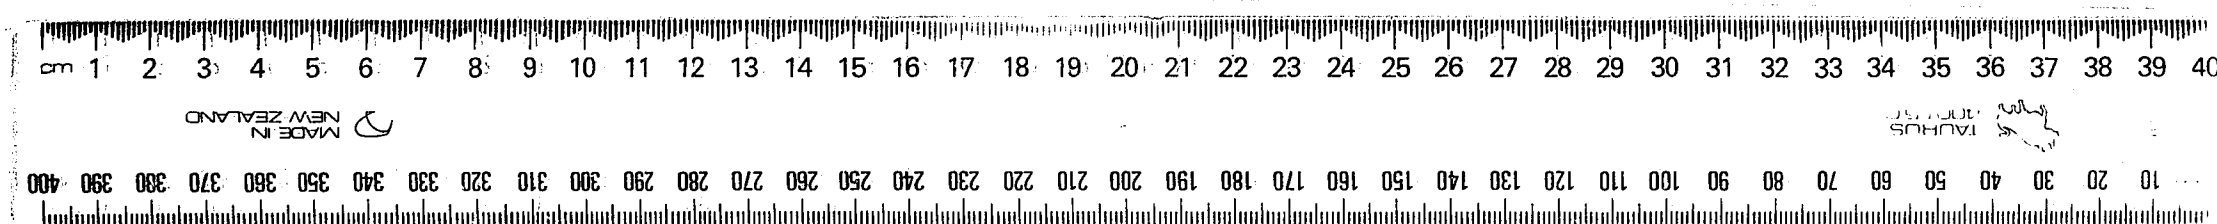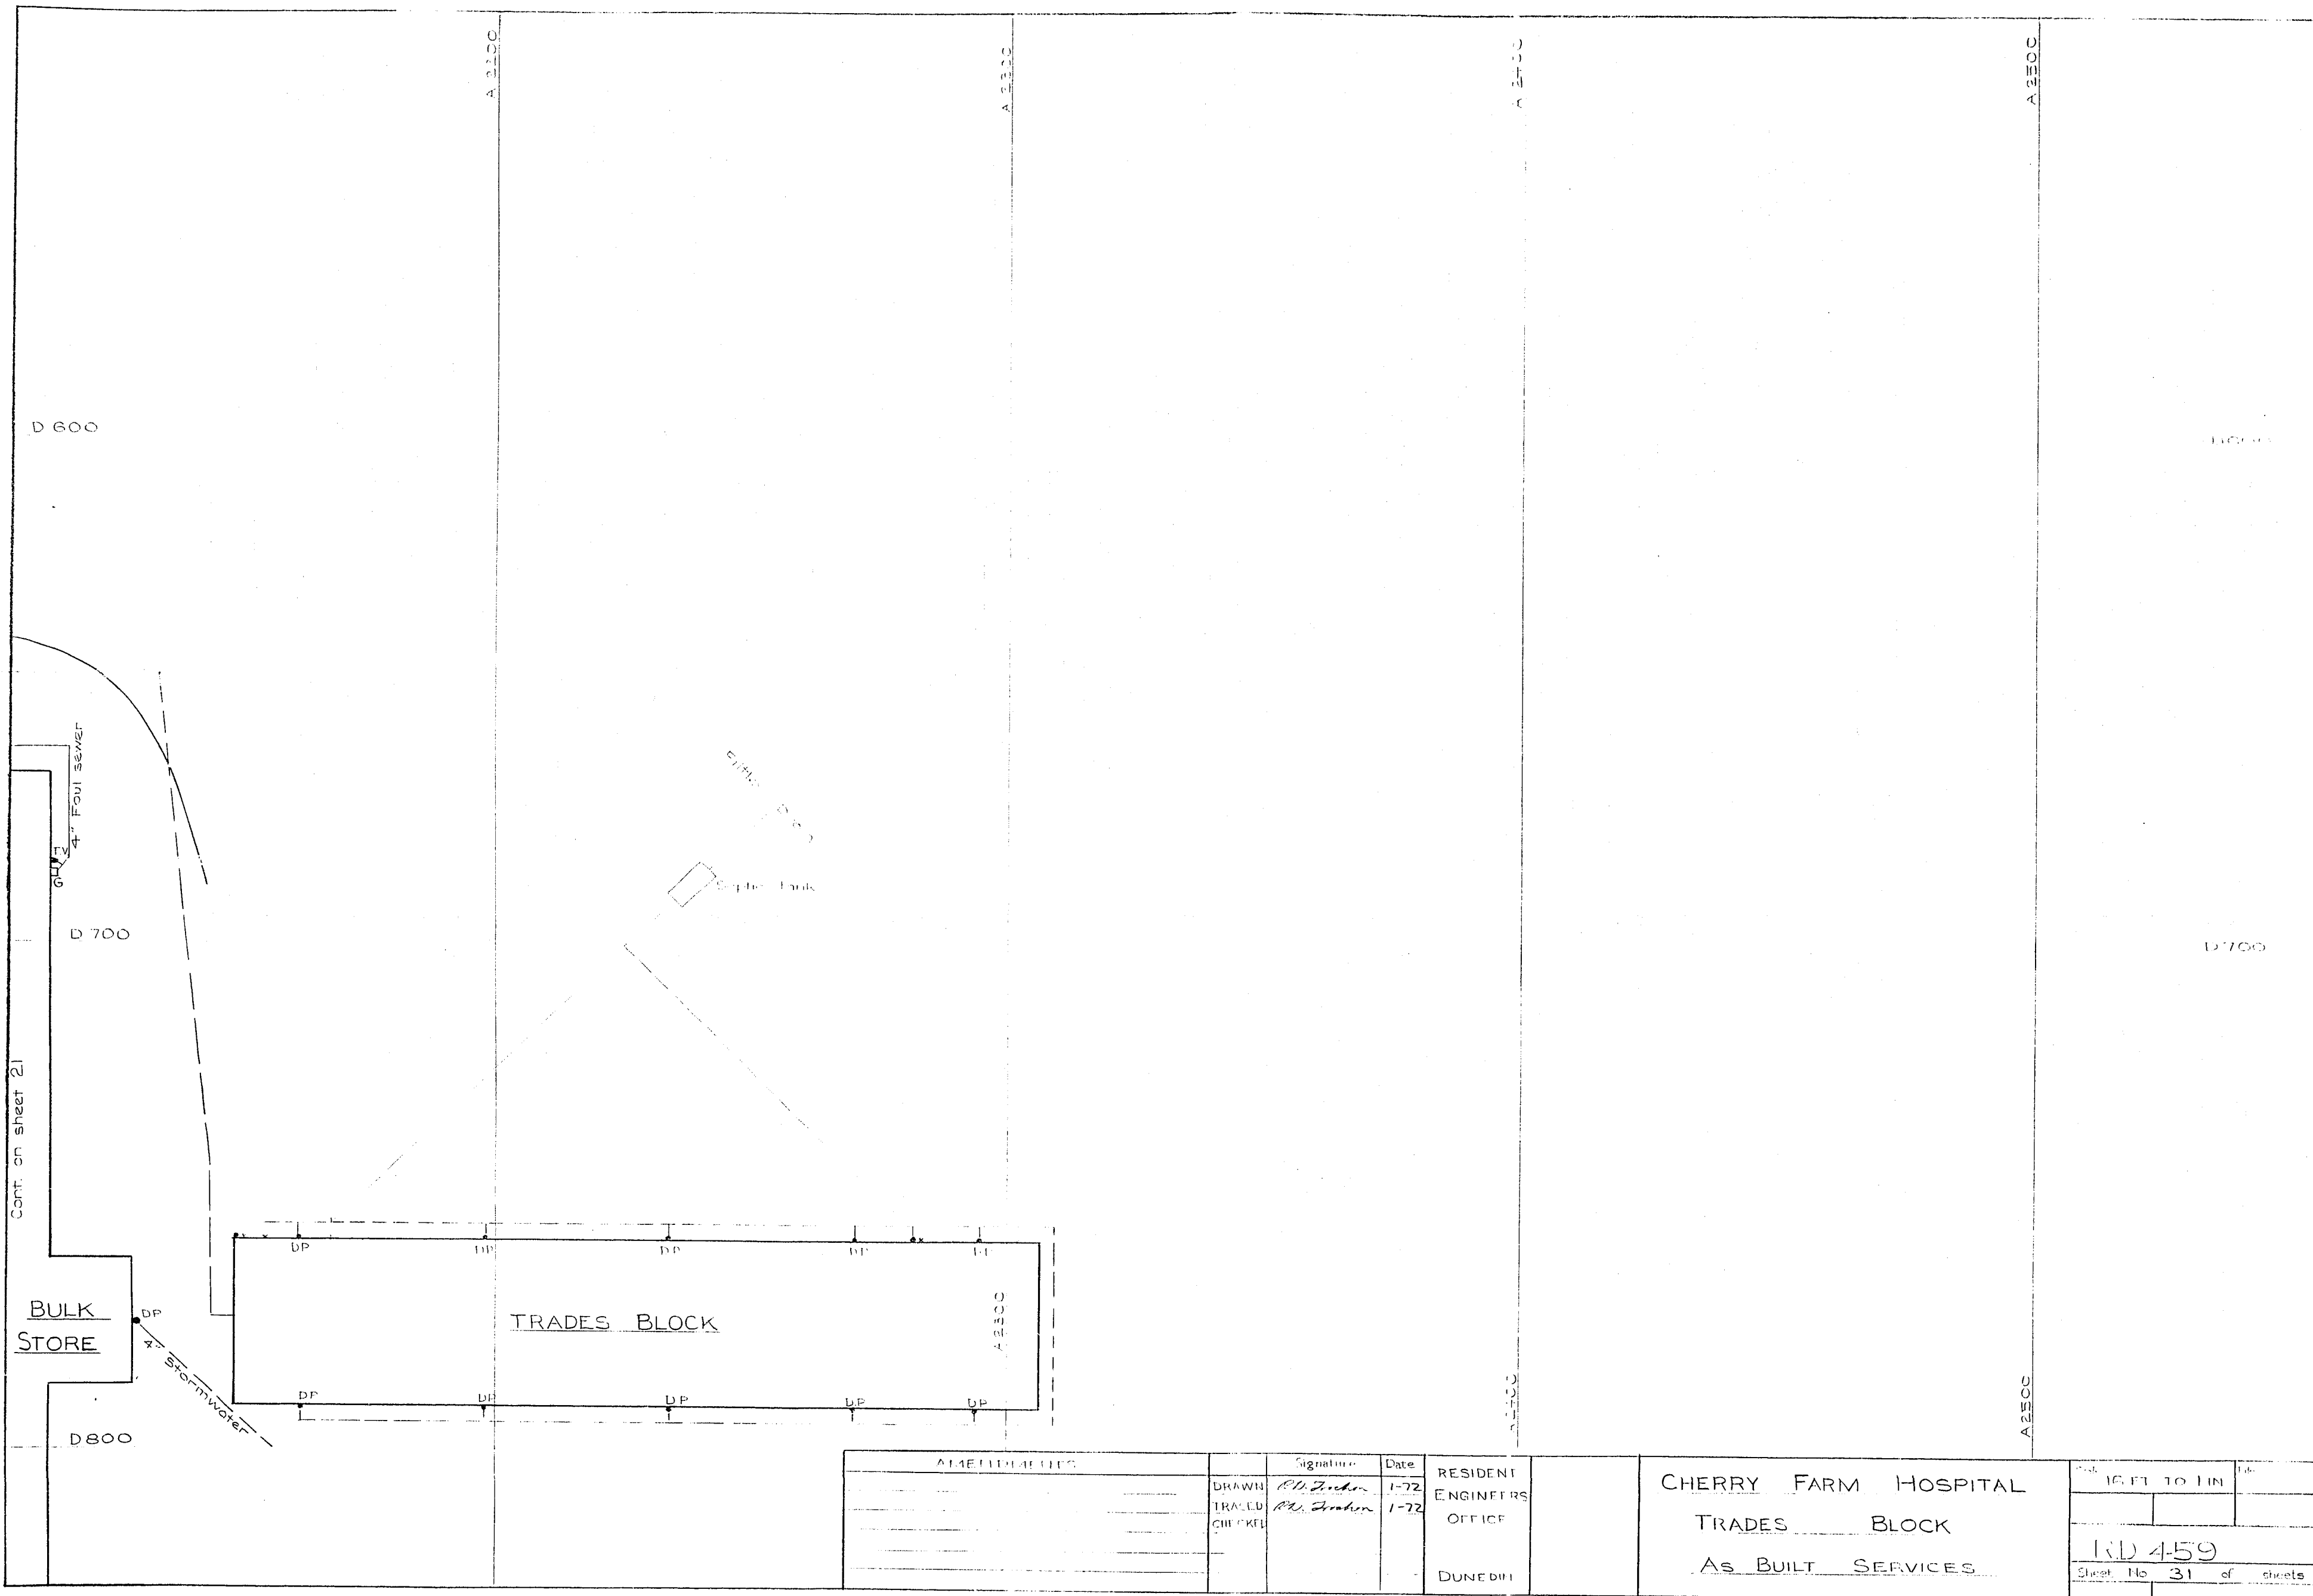


CHERRY FARM HOSPITAL		TRADES BLOCK		AS BUILT SERVICES	
DUNEDIN		ENGINEERS OFFICE		SHEET NO 31 OF 31	
DRAWN BY <i>R.D. Ziden</i>		DATE 1-72		SHEET NO 31 OF 31	
CHECKED BY <i>R.D. Ziden</i>		DATE 1-72		SHEET NO 31 OF 31	

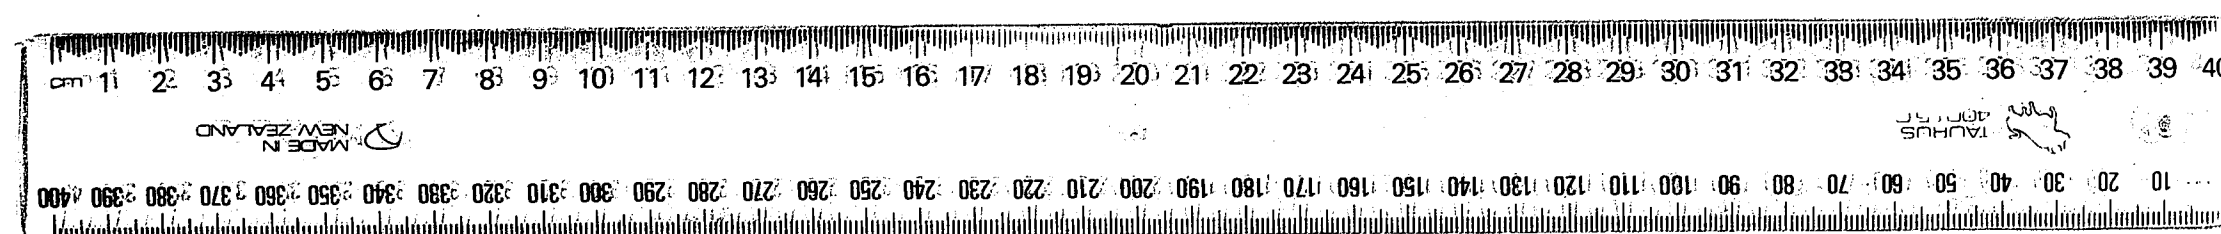

10 20 30 40 50 60 70 80 90 100 110 120 130 140 150 160 170 180 190 200 210 220 230 240 250 260 270 280 290 300 310 320 330 340 350 360 370 380 390 400


MADE IN NEW ZEALAND

1 2 3 4 5 6 7 8 9 10 11 12 13 14 15 16 17 18 19 20 21 22 23 24 25 26 27 28 29 30 31 32 33 34 35 36 37 38 39 40

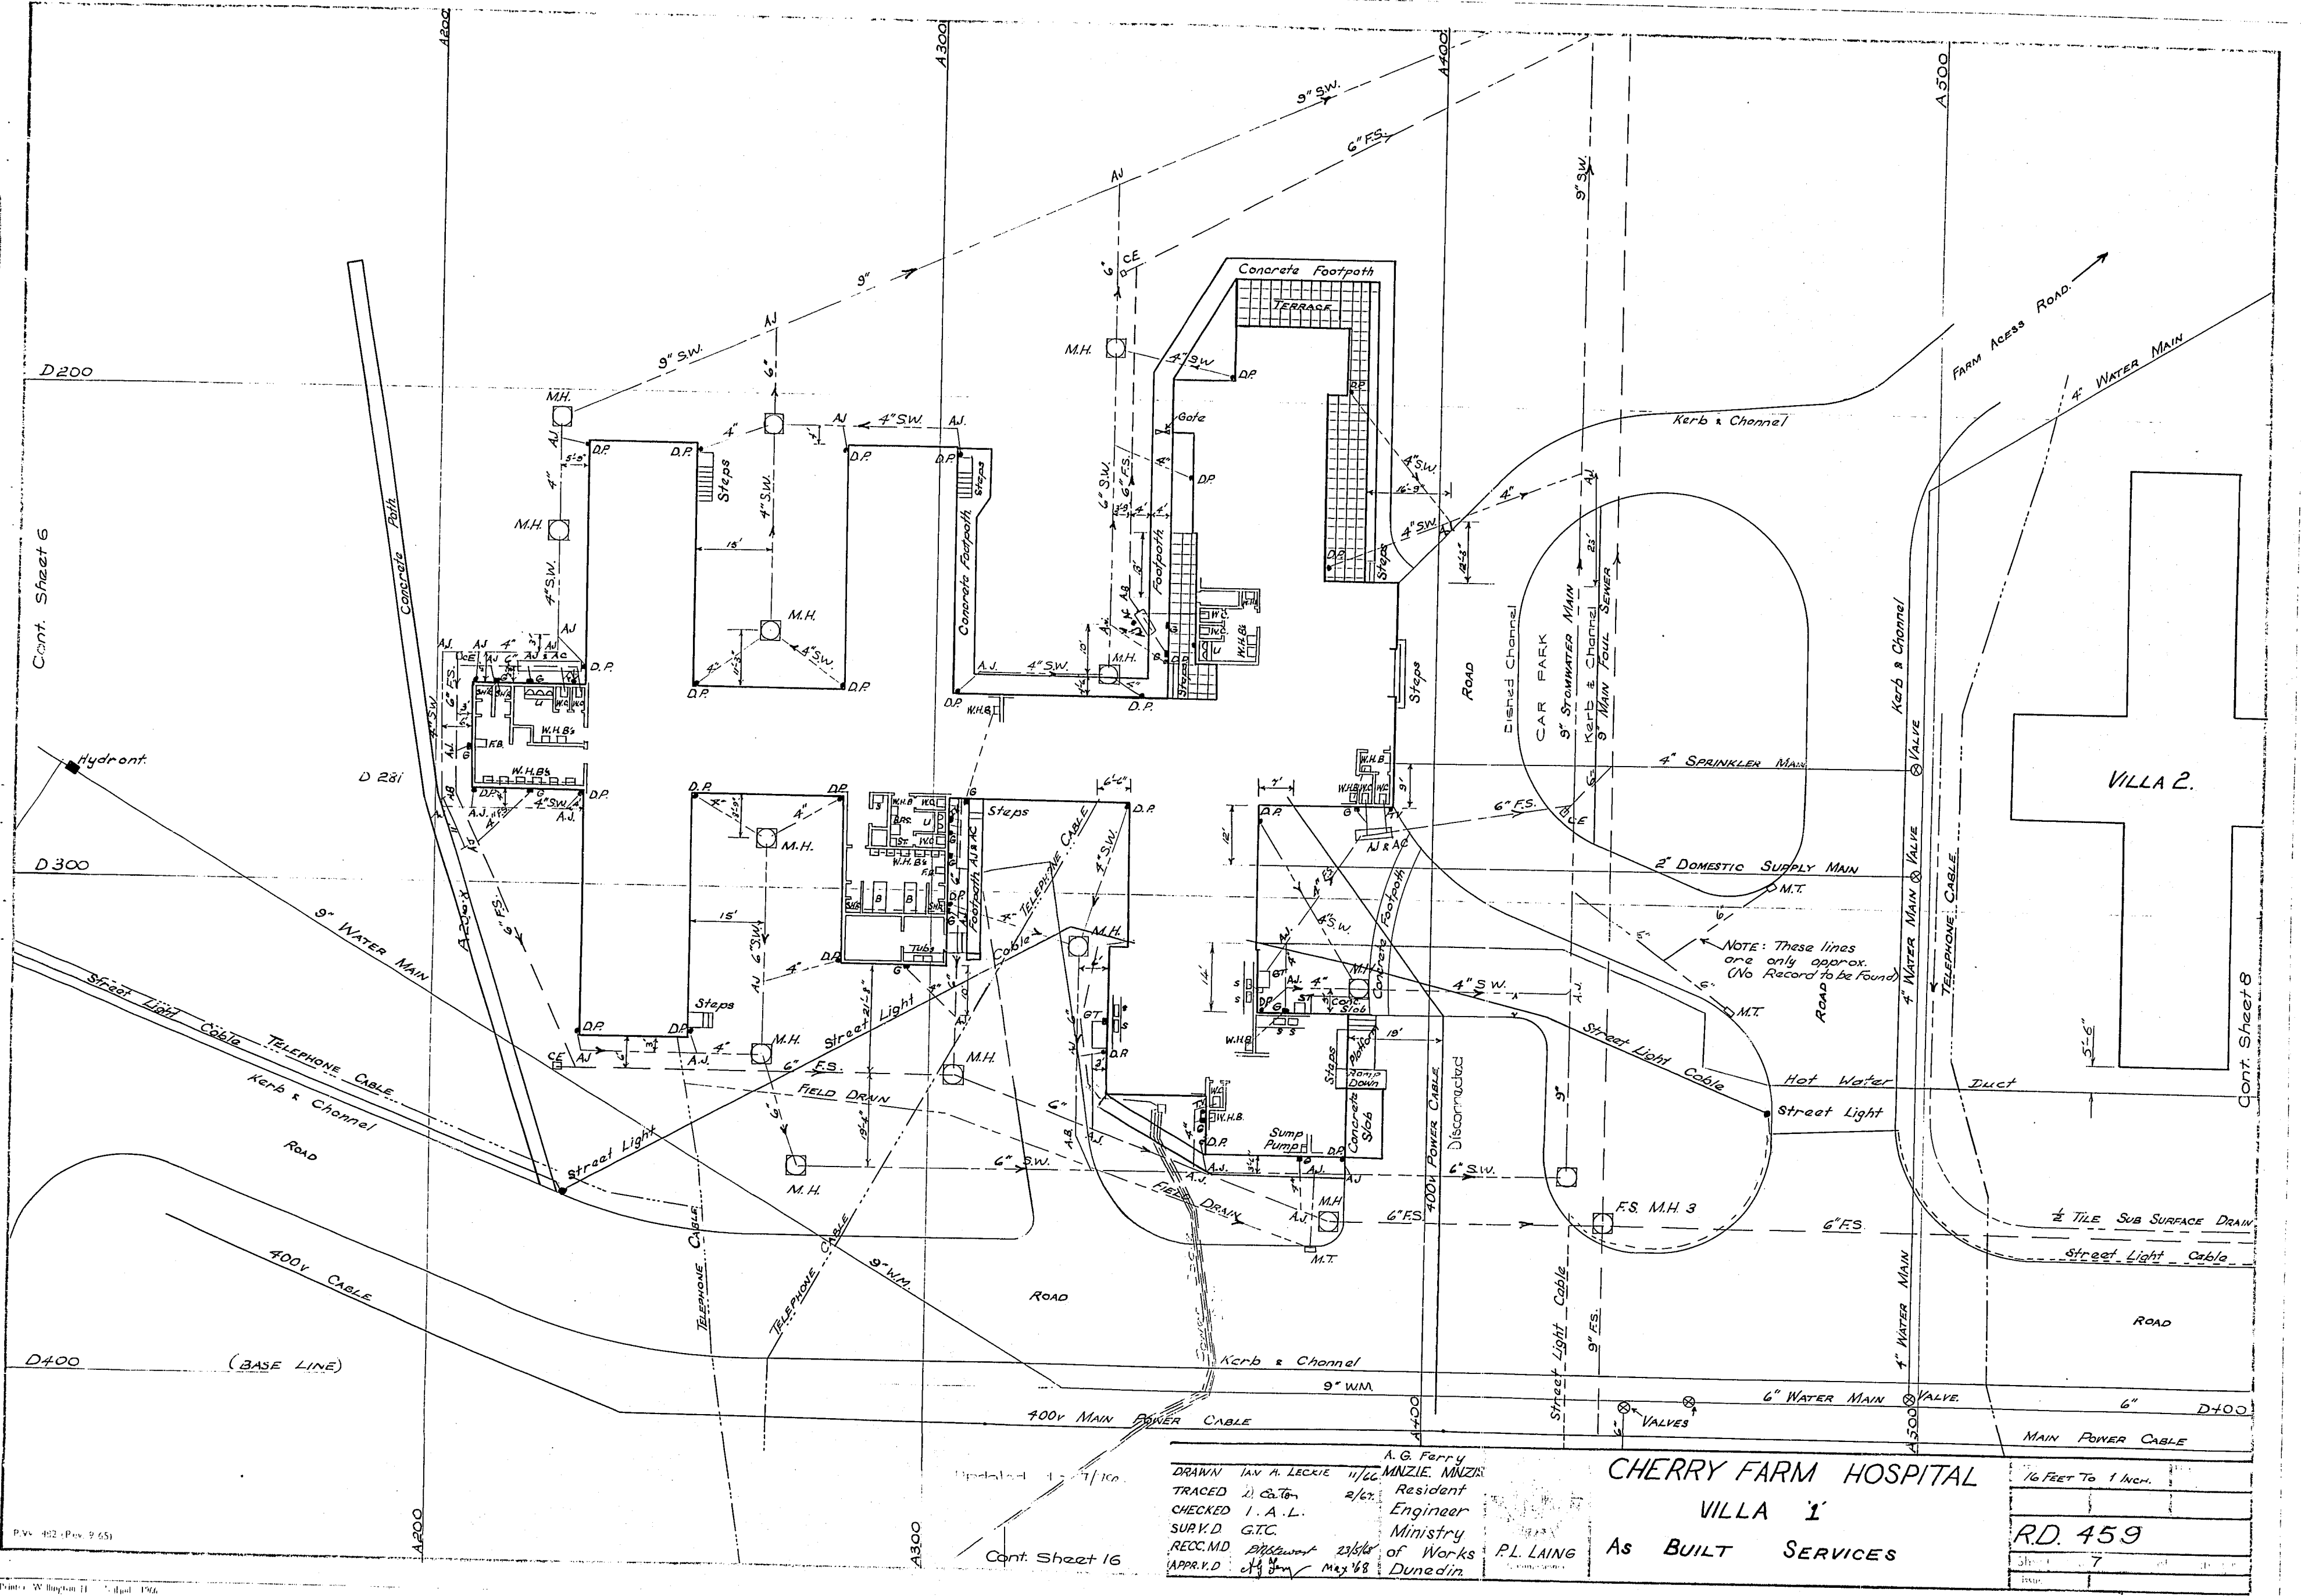

DRAWN IAN A. LECKIE TRACED 2/10/68 CHECKED I. A. L. SURV. D. G.T.C. RECC. MD. P. LAING APPR. V. D. 23/6/68		A. G. FERRY 11/6/68 Resident Engineer Ministry of Works Dunedin		CHERRY FARM HOSPITAL VILLA 1 As BUILT SERVICES		1/4" = 1' 0" RD. 459 7
---	--	---	--	---	--	-------------------------------------

MADE IN NEW ZEALAND
 1 2 3 4 5 6 7 8 9 10 11 12 13 14 15 16 17 18 19 20 21 22 23 24 25 26 27 28 29 30 31 32 33 34 35 36 37 38 39 40

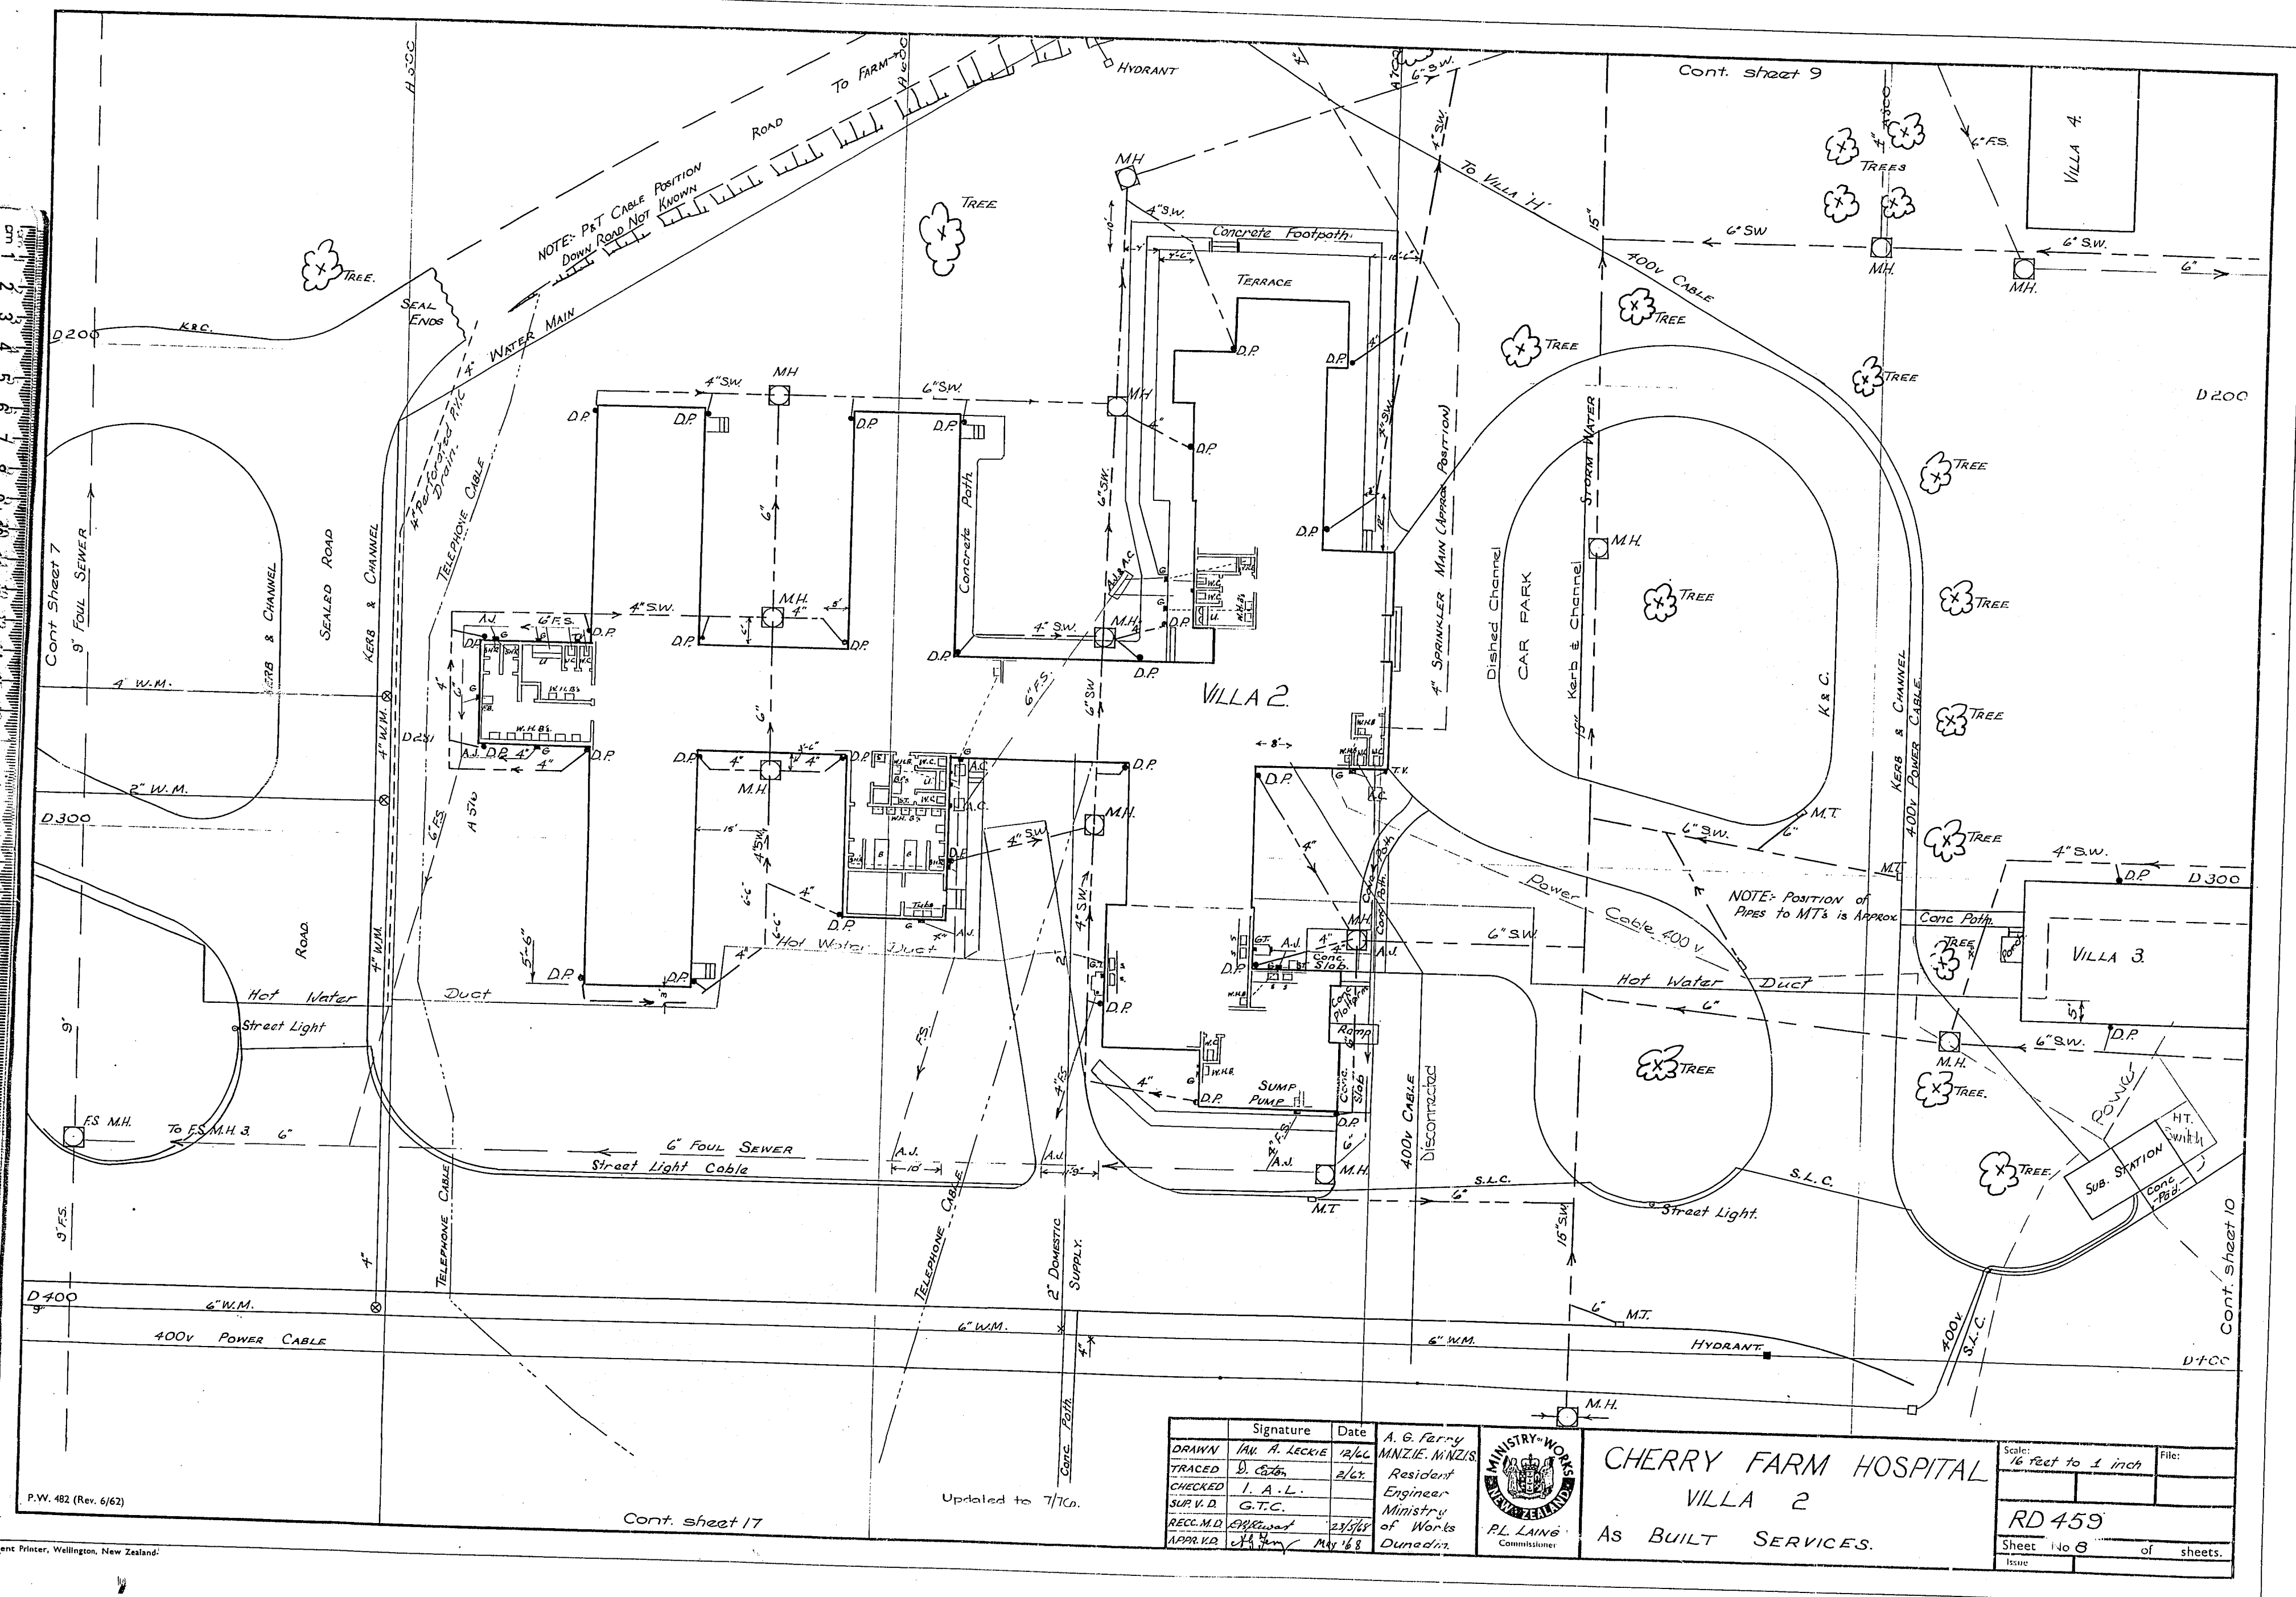

	Signature	Date
DRAWN	M. A. Leckie	2/6/68
TRACED	B. G. G. G.	2/6/68
CHECKED	I. A. L.	
SUP. V.D.	G.T.C.	
RECC. M.D.	G.T.C.	24/1/68
APPR. V.D.	A. G. Farry	24/1/68




CHERRY FARM HOSPITAL
VILLA 2
 As BUILT SERVICES.

Scale: 1/4 inch = 1 foot
 File: _____
 RD 459
 Sheet No 8 of 8 sheets

10 20 30 40 50 60 70 80 90 100 110 120 130 140 150 160 170 180 190 200 210 220 230 240 250 260 270 280 290 300 310 320 330 340 350 360 370 380 390 400

MADE IN NEW ZEALAND

1 2 3 4 5 6 7 8 9 10 11 12 13 14 15 16 17 18 19 20 21 22 23 24 25 26 27 28 29 30 31 32 33 34 35 36 37 38 39 40

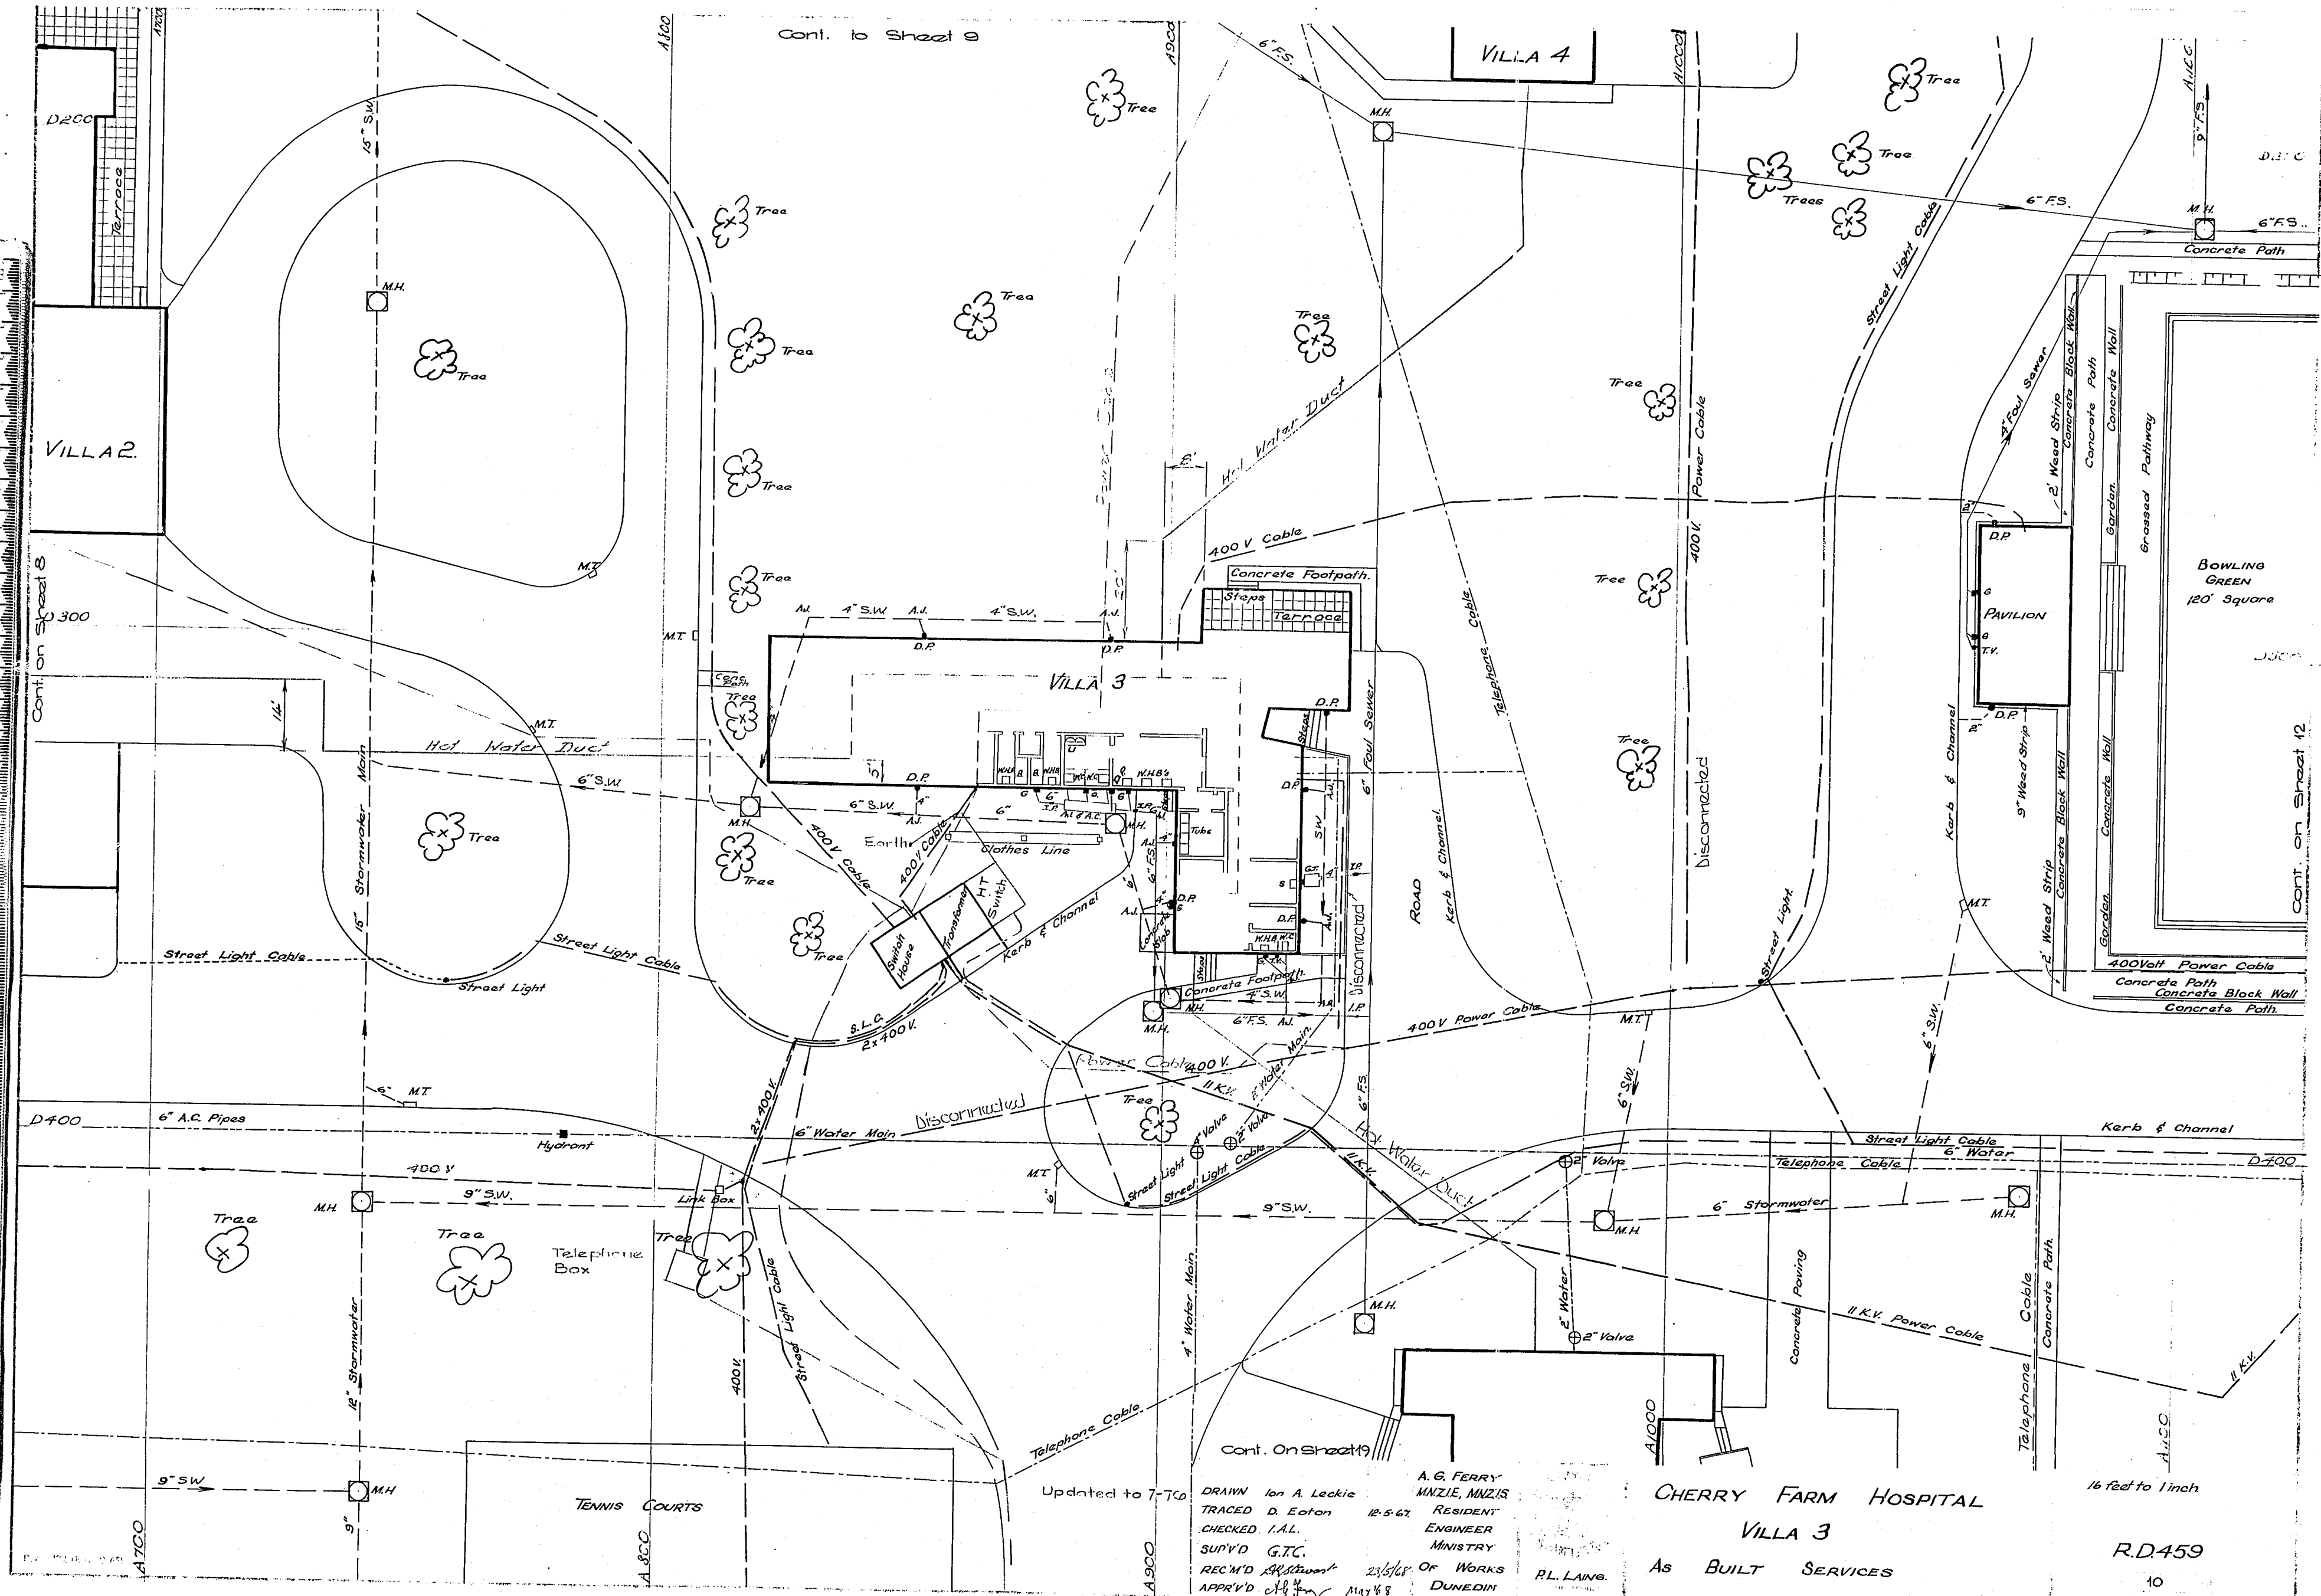

Updated to 7-70

DRAWN Ian A. Leckie
TRACED D. Eaton 12.5.67
CHECKED I.A.L.
SURV'D G.T.C.
REC'D R. Lang 23/6/67
APPR'D [Signature] May 68

A.G. FERRY
MINZIE, MINZIS
RESIDENT
ENGINEER
MINISTRY
OF WORKS
DUNEDIN

R.L. LANG


CHERRY FARM HOSPITAL
VILLA 3
AS BUILT SERVICES

R.D.459
10

10 20 30 40 50 60 70 80 90 100 110 120 130 140 150 160 170 180 190 200 210 220 230 240 250 260 270 280 290 300 310 320 330 340 350 360 370 380 390 400

MADE IN NEW ZEALAND

1 2 3 4 5 6 7 8 9 10 11 12 13 14 15 16 17 18 19 20 21 22 23 24 25 26 27 28 29 30 31 32 33 34 35 36 37 38 39 40

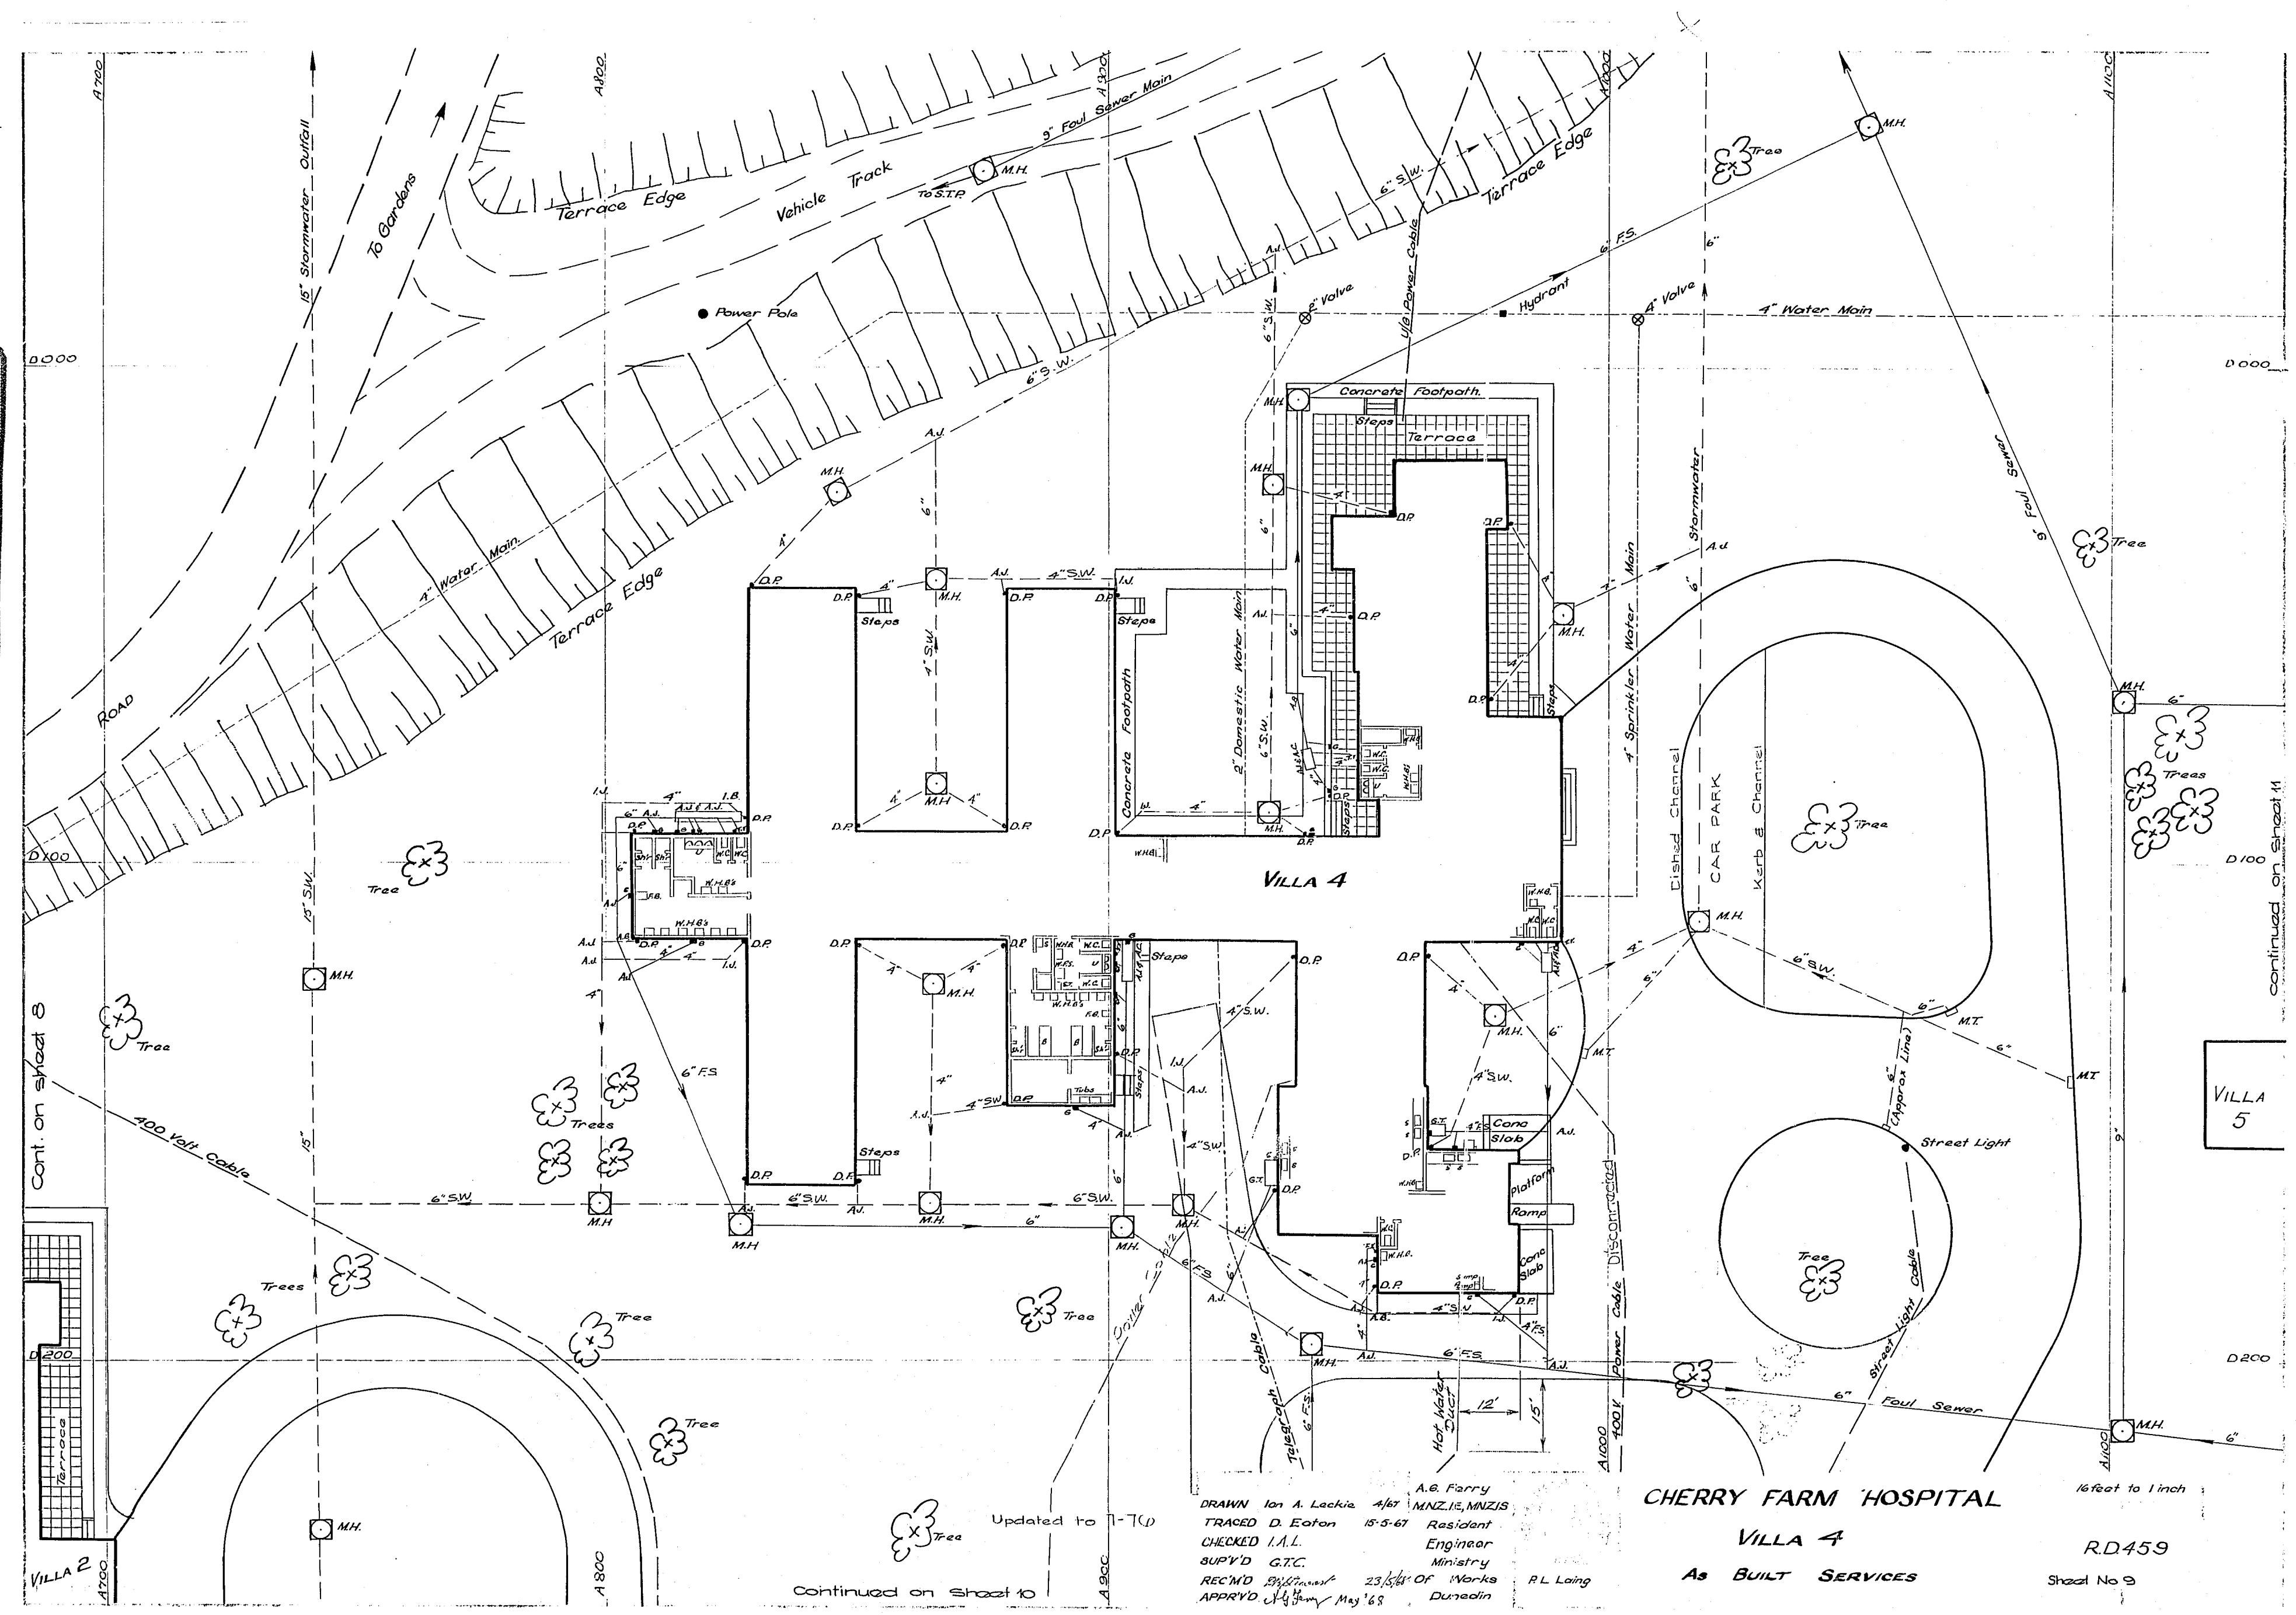

Updated to T-7(1)



Continued on Sheet to

DRAWN Ian A. Lackie A/Et
CHECKED D. Eaton 15-5-67
SUPV'D G.T.C.
REC'D 23/5/67 OF Works
APPROV'D 24/5/67 May '68

A.E. Farry
MINZIE, MINZIE
Resident
Engineer
Ministry
Dunedin

R.L. Laing

CHERRY FARM HOSPITAL
VILLA 4
As BUILT SERVICES
RD459
Sheet No 9

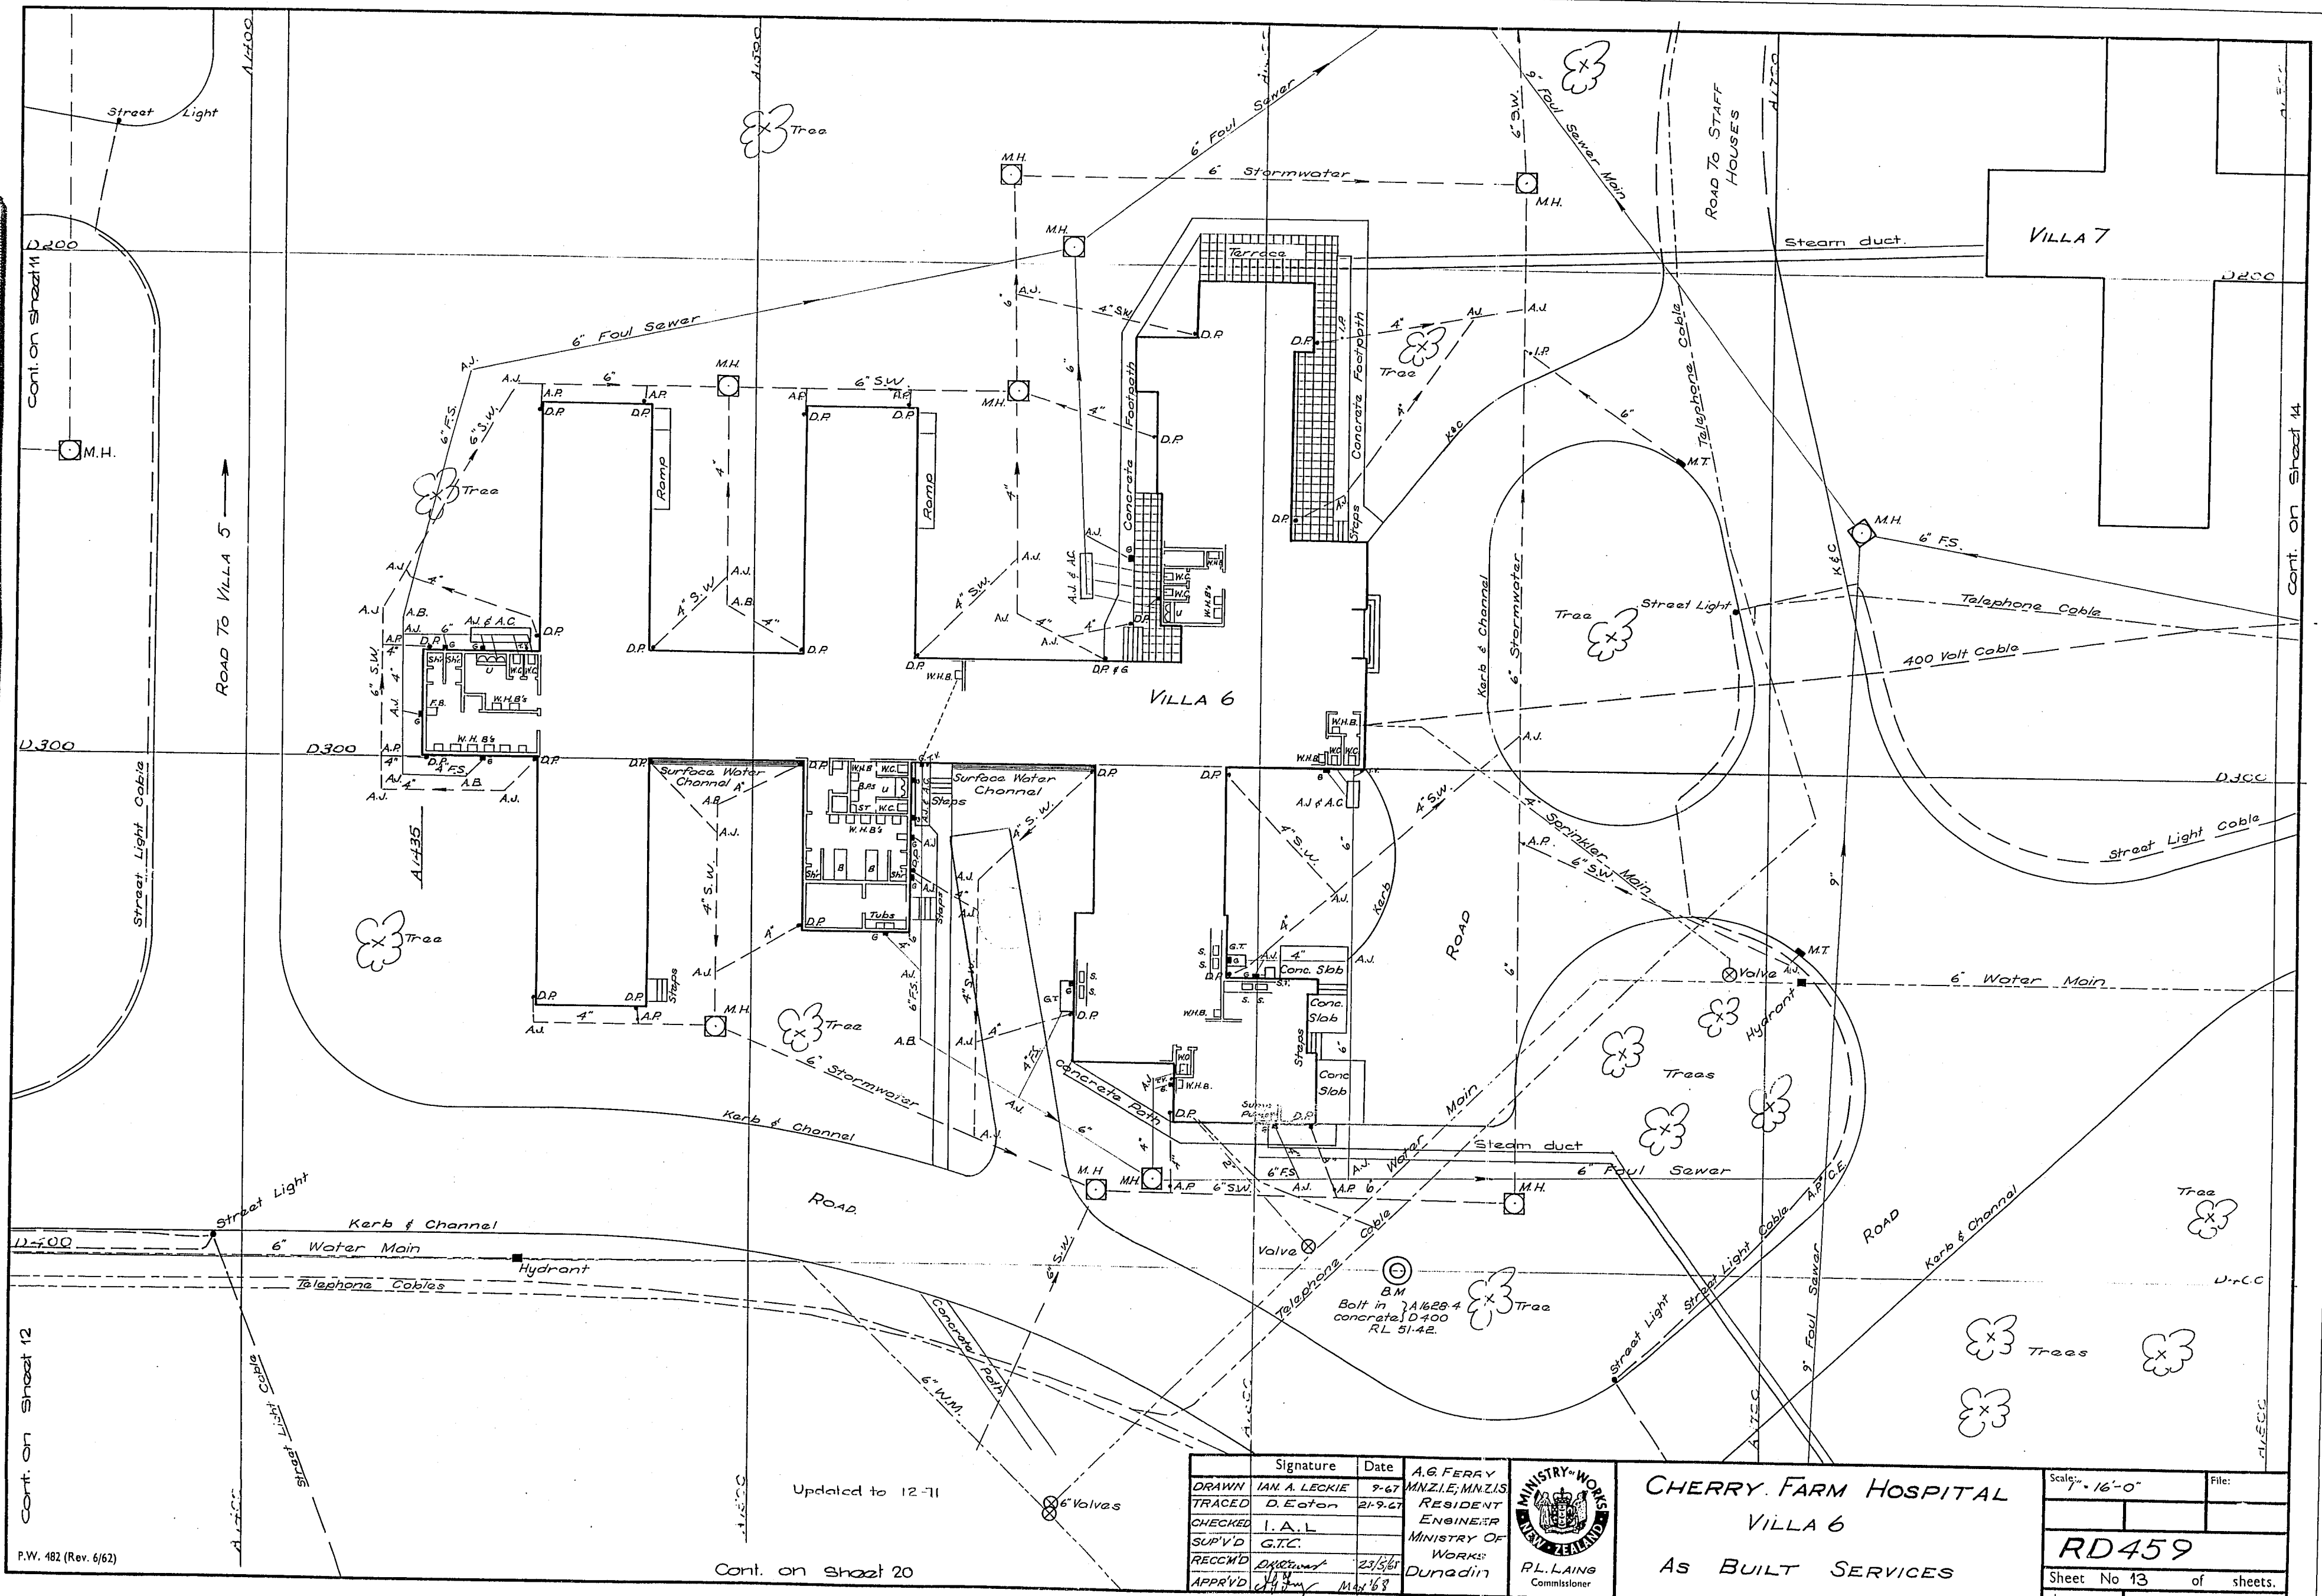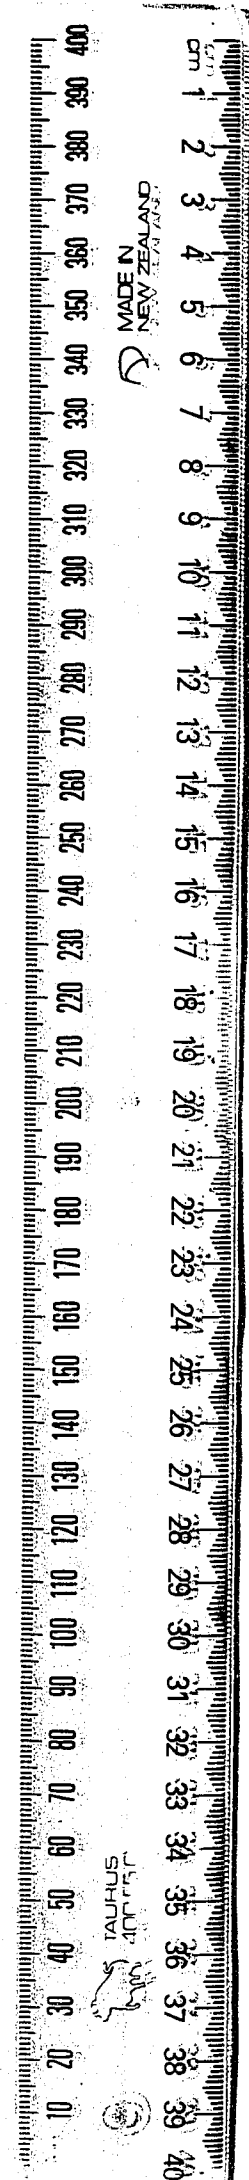


Signature	Date	A.G. FERRY
DRAWN IAN A. LECKIE	7-67	MNZIE, MNZIS
TRACED D. Eaton	21-9-27	RESIDENT
CHECKED I.A.L.		ENGINEER
SUP'VD G.T.C.		MINISTRY OF
RECCMD G.T.C.	23/5/67	WORKS
APPRVD J.H. M	16/6/68	Dunedin



CHERRY FARM HOSPITAL
VILLA 6
As BUILT SERVICES


Scale: 1" = 16'-0"	File:
RD459	
Sheet No 13 of sheets.	
Issue	

NEW ZEALAND
 1 2 3 4 5 6 7 8 9 10 11 12 13 14 15 16 17 18 19 20 21 22 23 24 25 26 27 28 29 30 31 32 33 34 35 36 37 38 39 40
 10 20 30 40 50 60 70 80 90 100 110 120 130 140 150 160 170 180 190 200 210 220 230 240 250 260 270 280 290 300 310 320 330 340 350 360 370 380 390 400

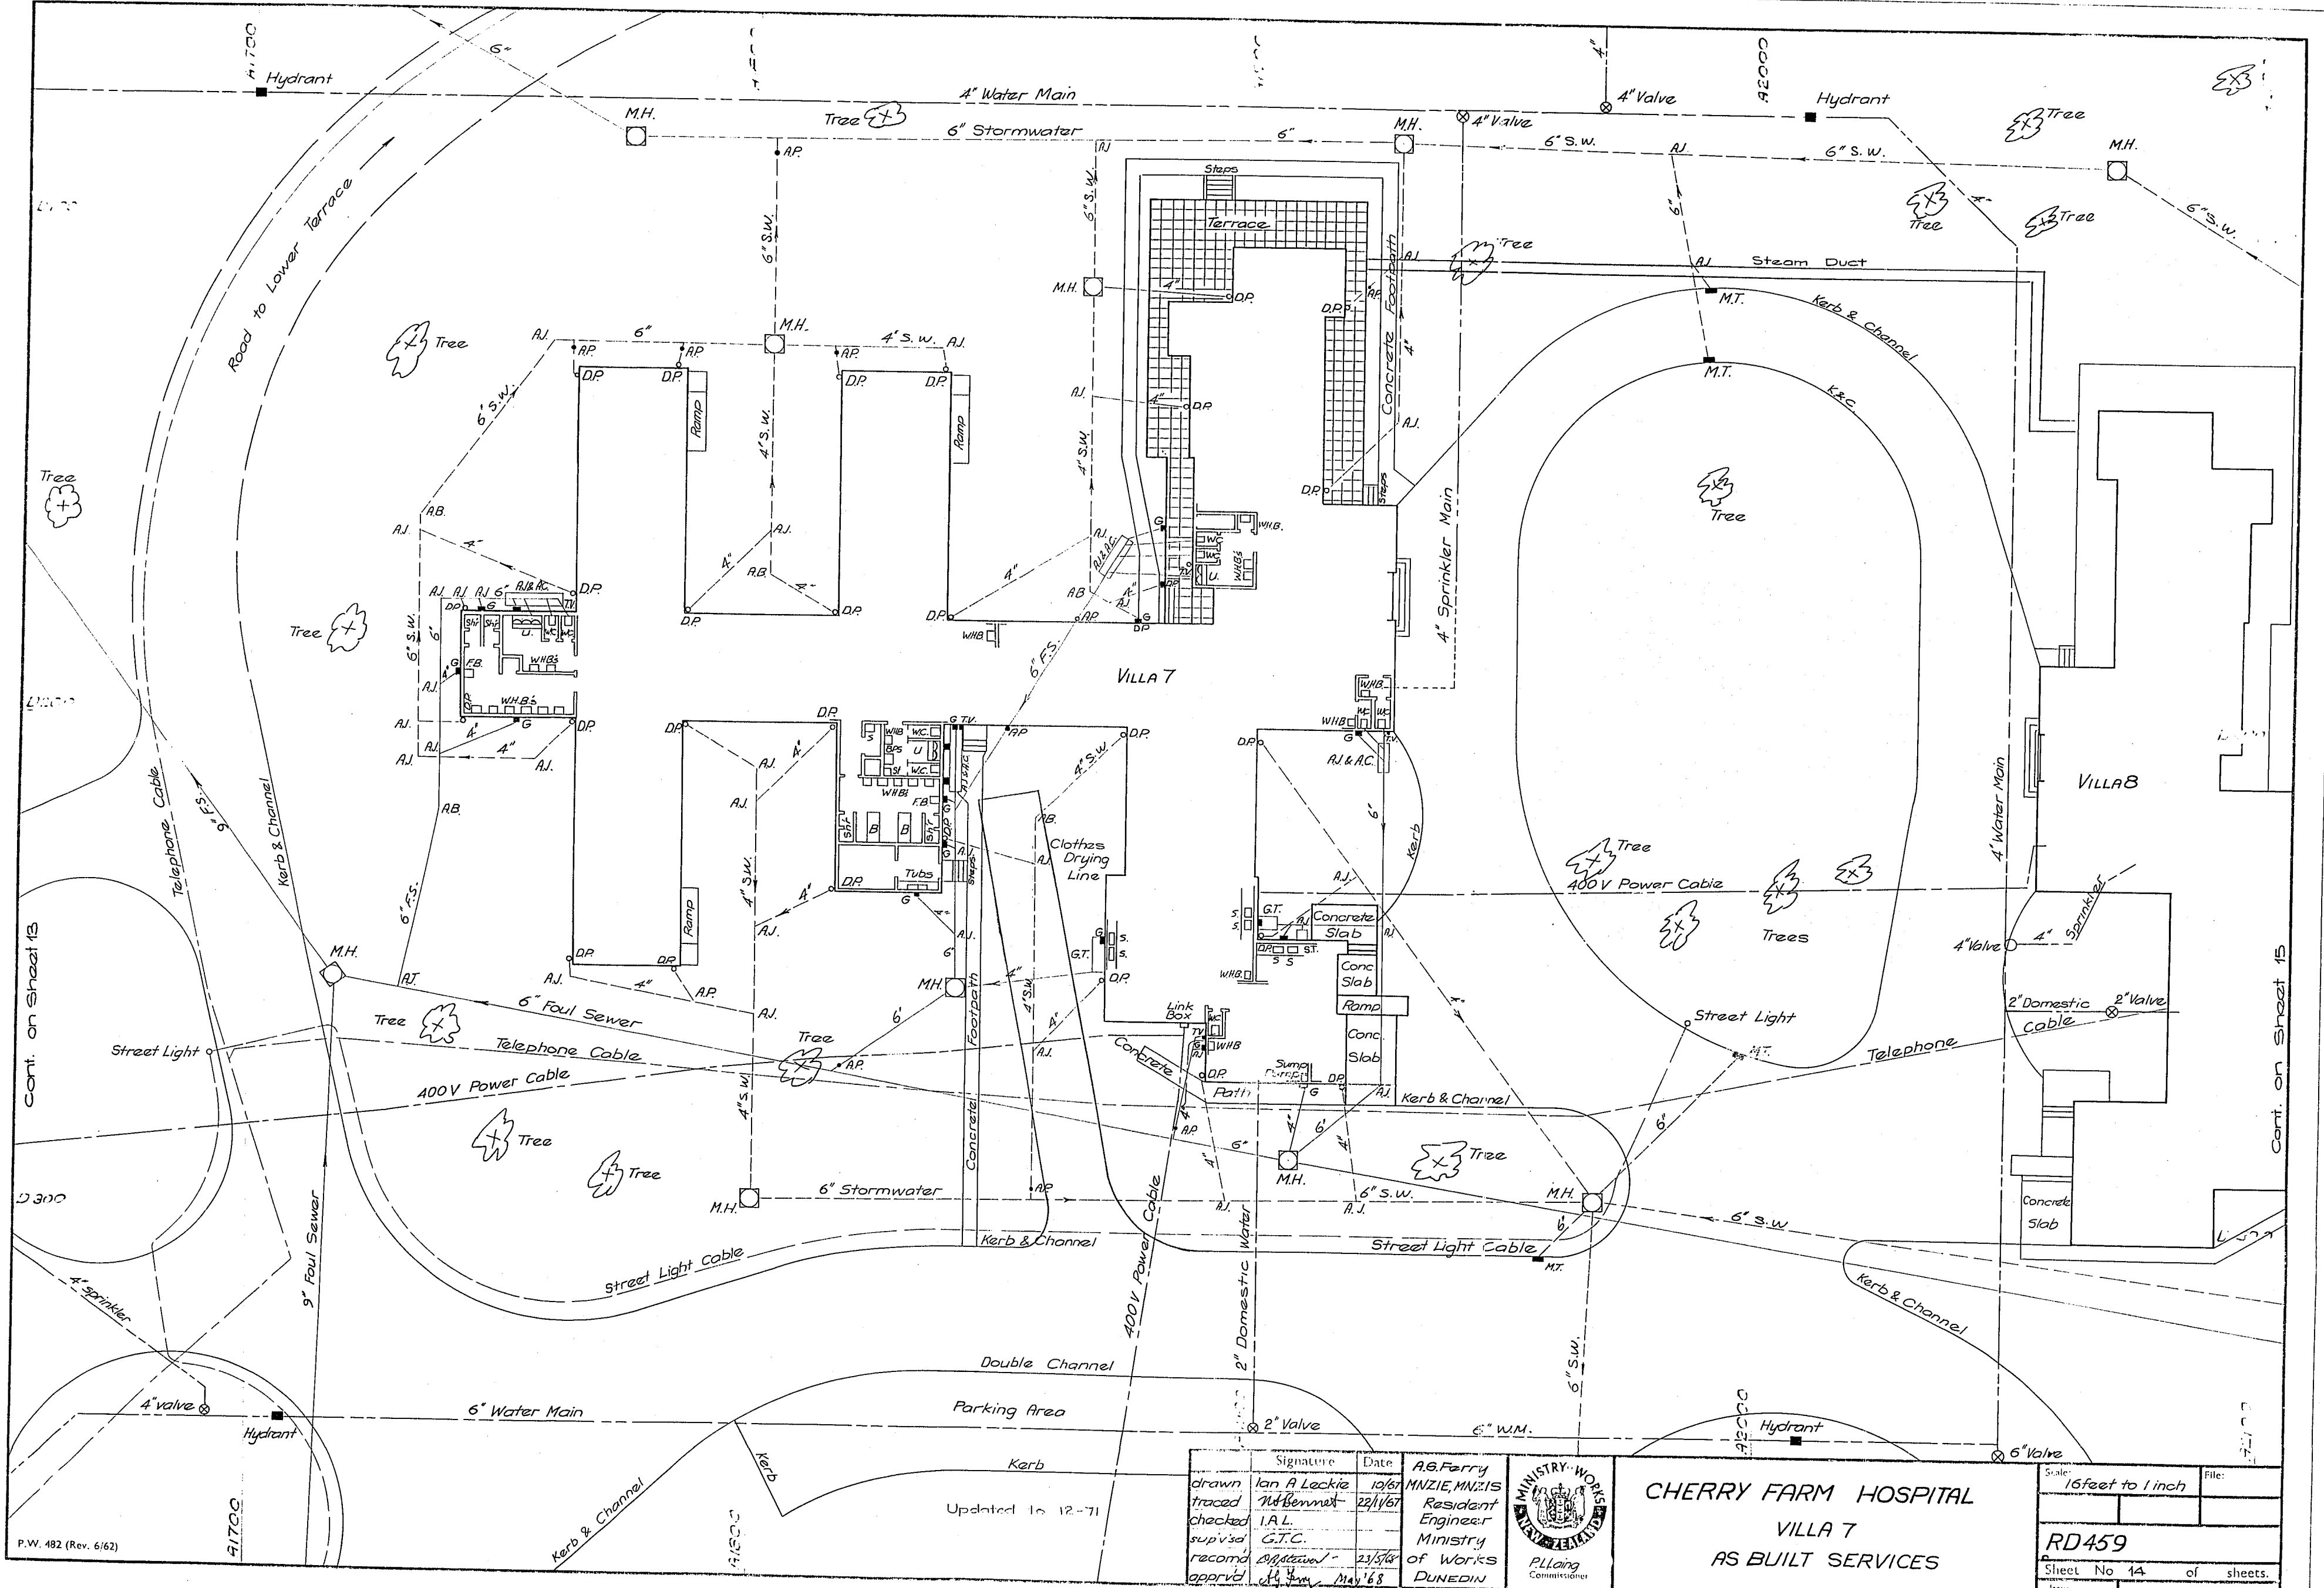

drawn checked sup'd recom'd approved	van A Leacke Nuffenham I.A.L. G.T.C. M.H. M.H.	1967 22/1/67 22/5/68 22/5/68 May '68	As. Ferry M.N.Z.I.E. Resident Engineer Ministry of Works DUNEDIN	 P.O. Box 100 Wellington	CHERRY FARM HOSPITAL VILLA 7 AS BUILT SERVICES	Scale: 16 feet to 1 inch	File:
						RD459	
						Sheet No 14 of sheets.	Issue

MADE IN NEW ZEALAND
1 2 3 4 5 6 7 8 9 10 11 12 13 14 15 16 17 18 19 20 21 22 23 24 25 26 27 28 29 30 31 32 33 34 35 36 37 38 39 40
10 20 30 40 50 60 70 80 90 100 110 120 130 140 150 160 170 180 190 200 210 220 230 240 250 260 270 280 290 300 310 320 330 340 350 360 370 380 390 400
Cont on Sheet 14

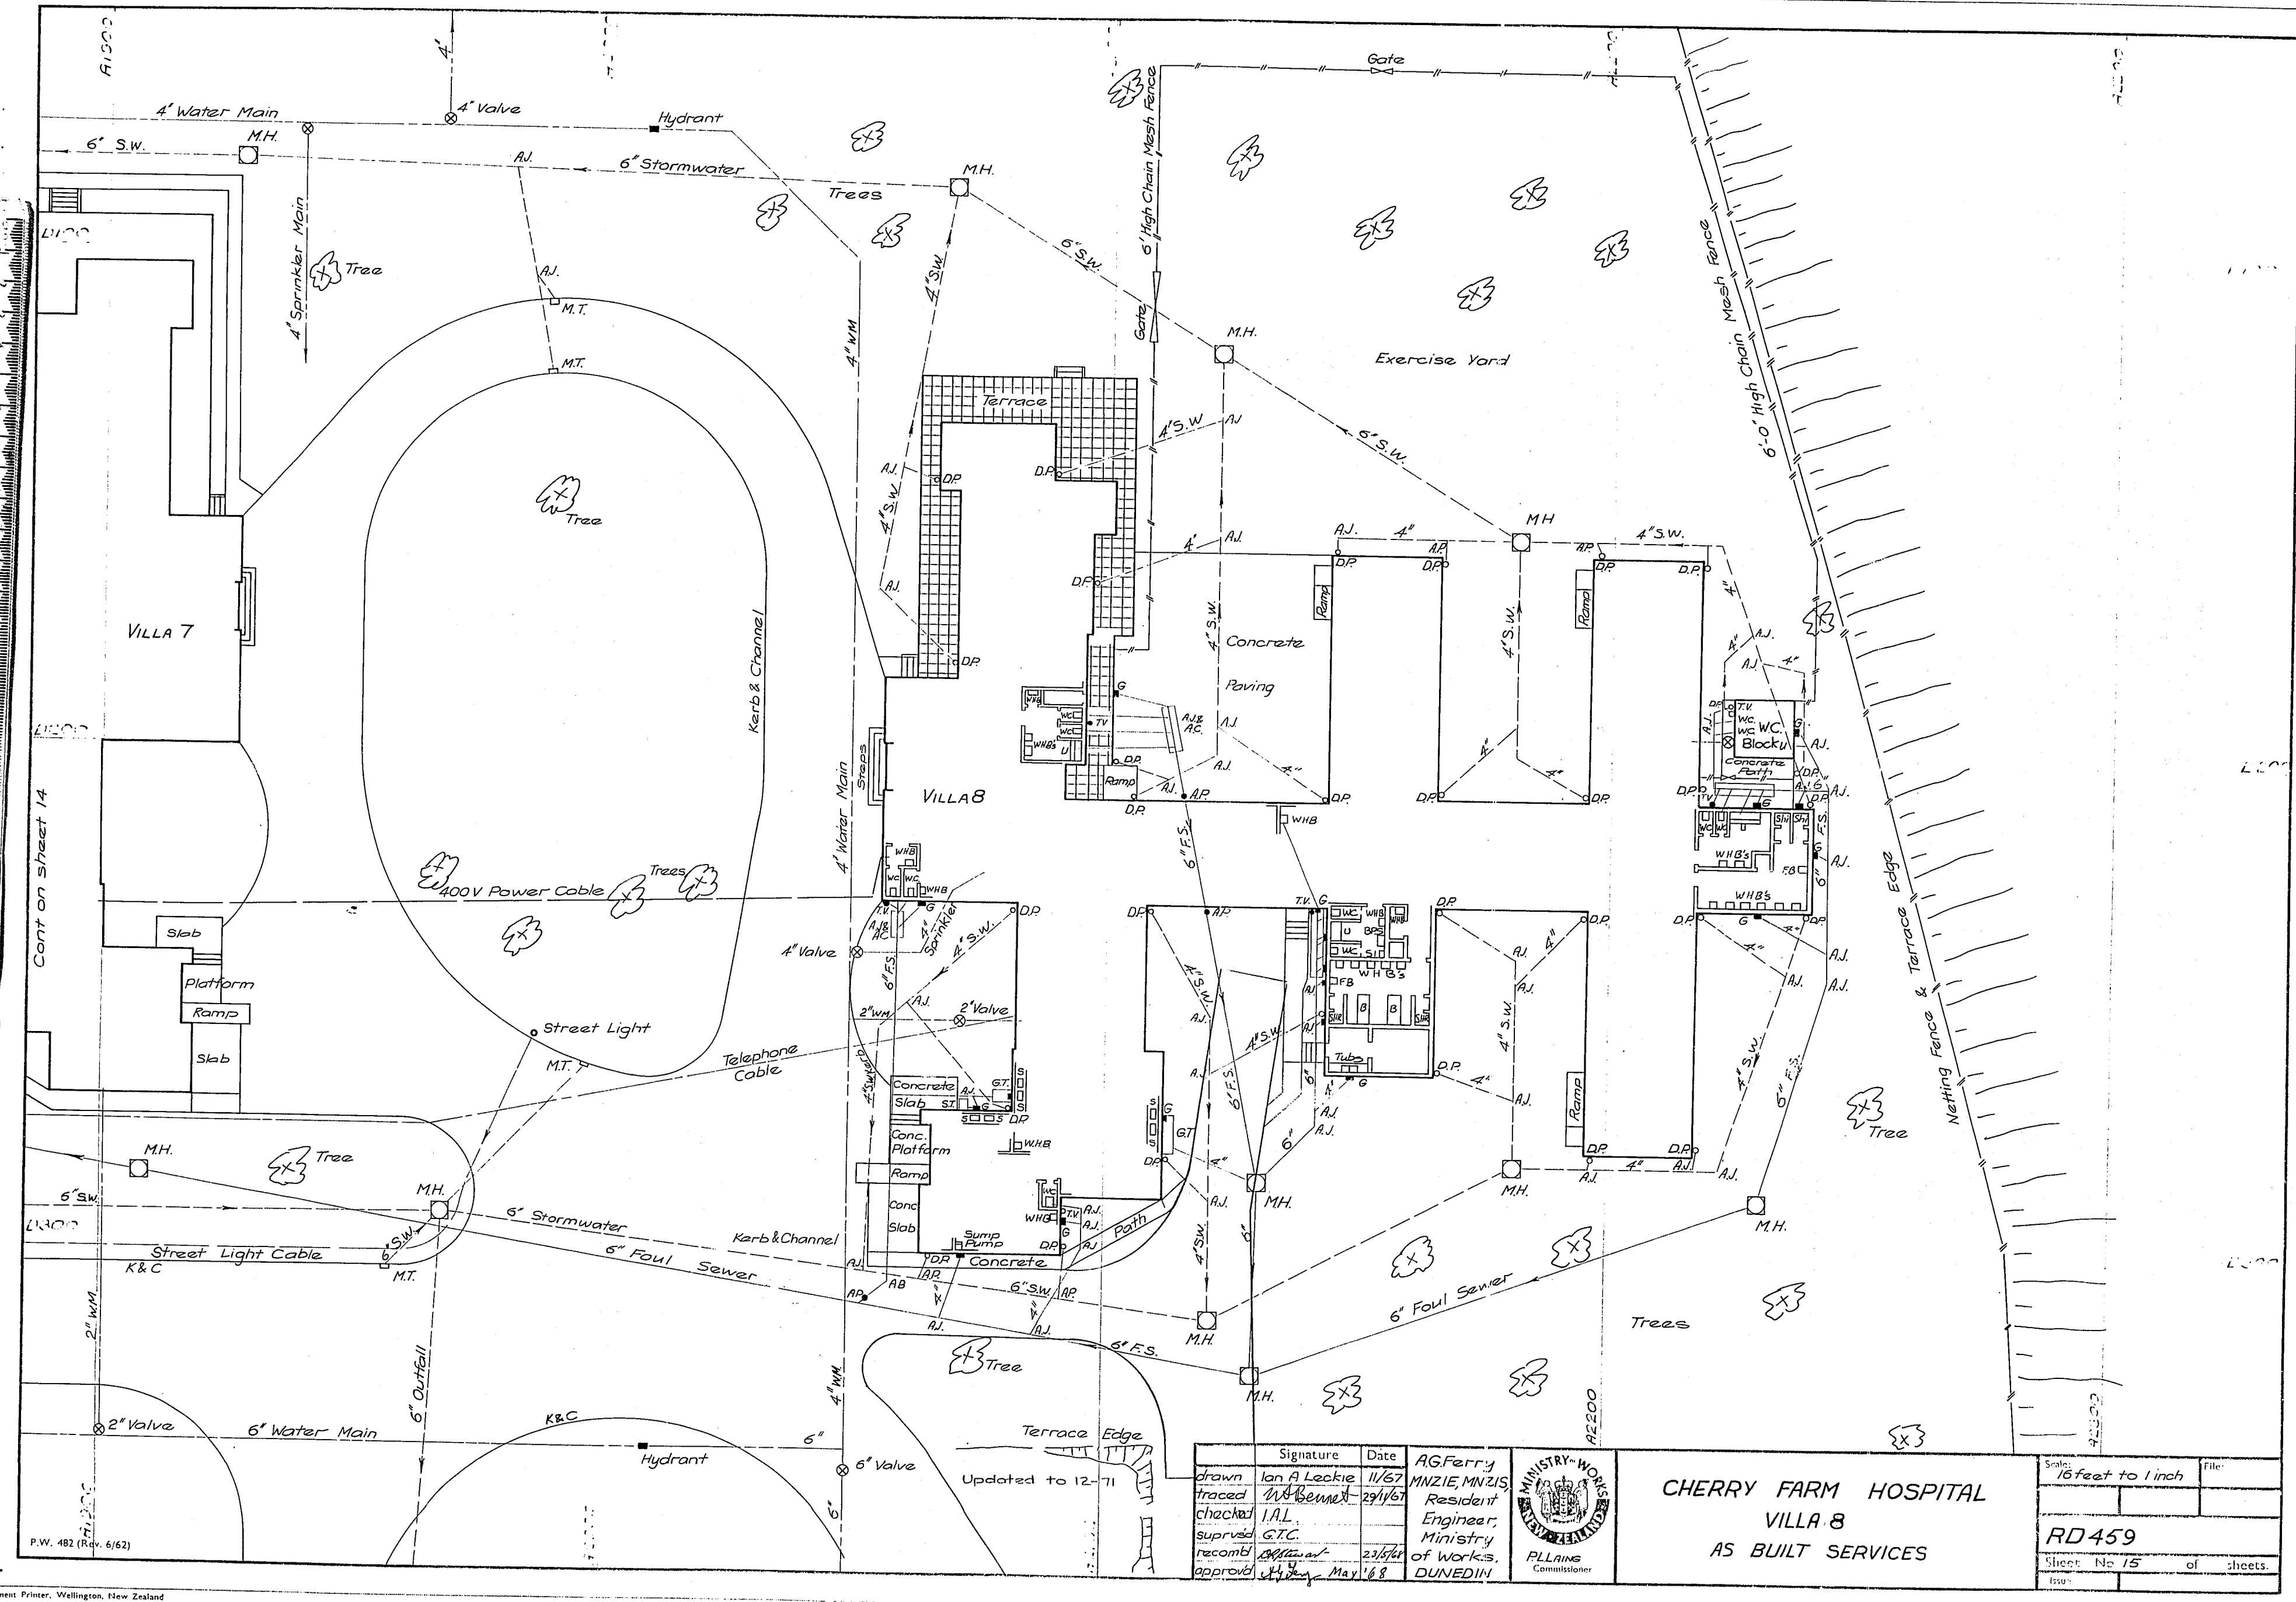


Signature	Date
drawn Ian A Leckie	11/67
traced W.A. Bennett	29/1/67
checked I.A.L.	
supervised G.T.C.	
rechecked G.T.C.	23/6/67
approved H. May	1/68



CHERRY FARM HOSPITAL
VILLA 8
AS BUILT SERVICES

Scale	16 feet to 1 inch	File
RD 459		
Sheet No 15	of sheets	

1 2 3 4 5 6 7 8 9 10 11 12 13 14 15 16 17 18 19 20 21 22 23 24 25 26 27 28 29 30 31 32 33 34 35 36 37 38 39 40
 10 20 30 40 50 60 70 80 90 100 110 120 130 140 150 160 170 180 190 200 210 220 230 240 250 260 270 280 290 300 310 320 330 340 350 360 370 380 390 400
 NEW ZEALAND
 P.W. 482 (Rev. 6/62)

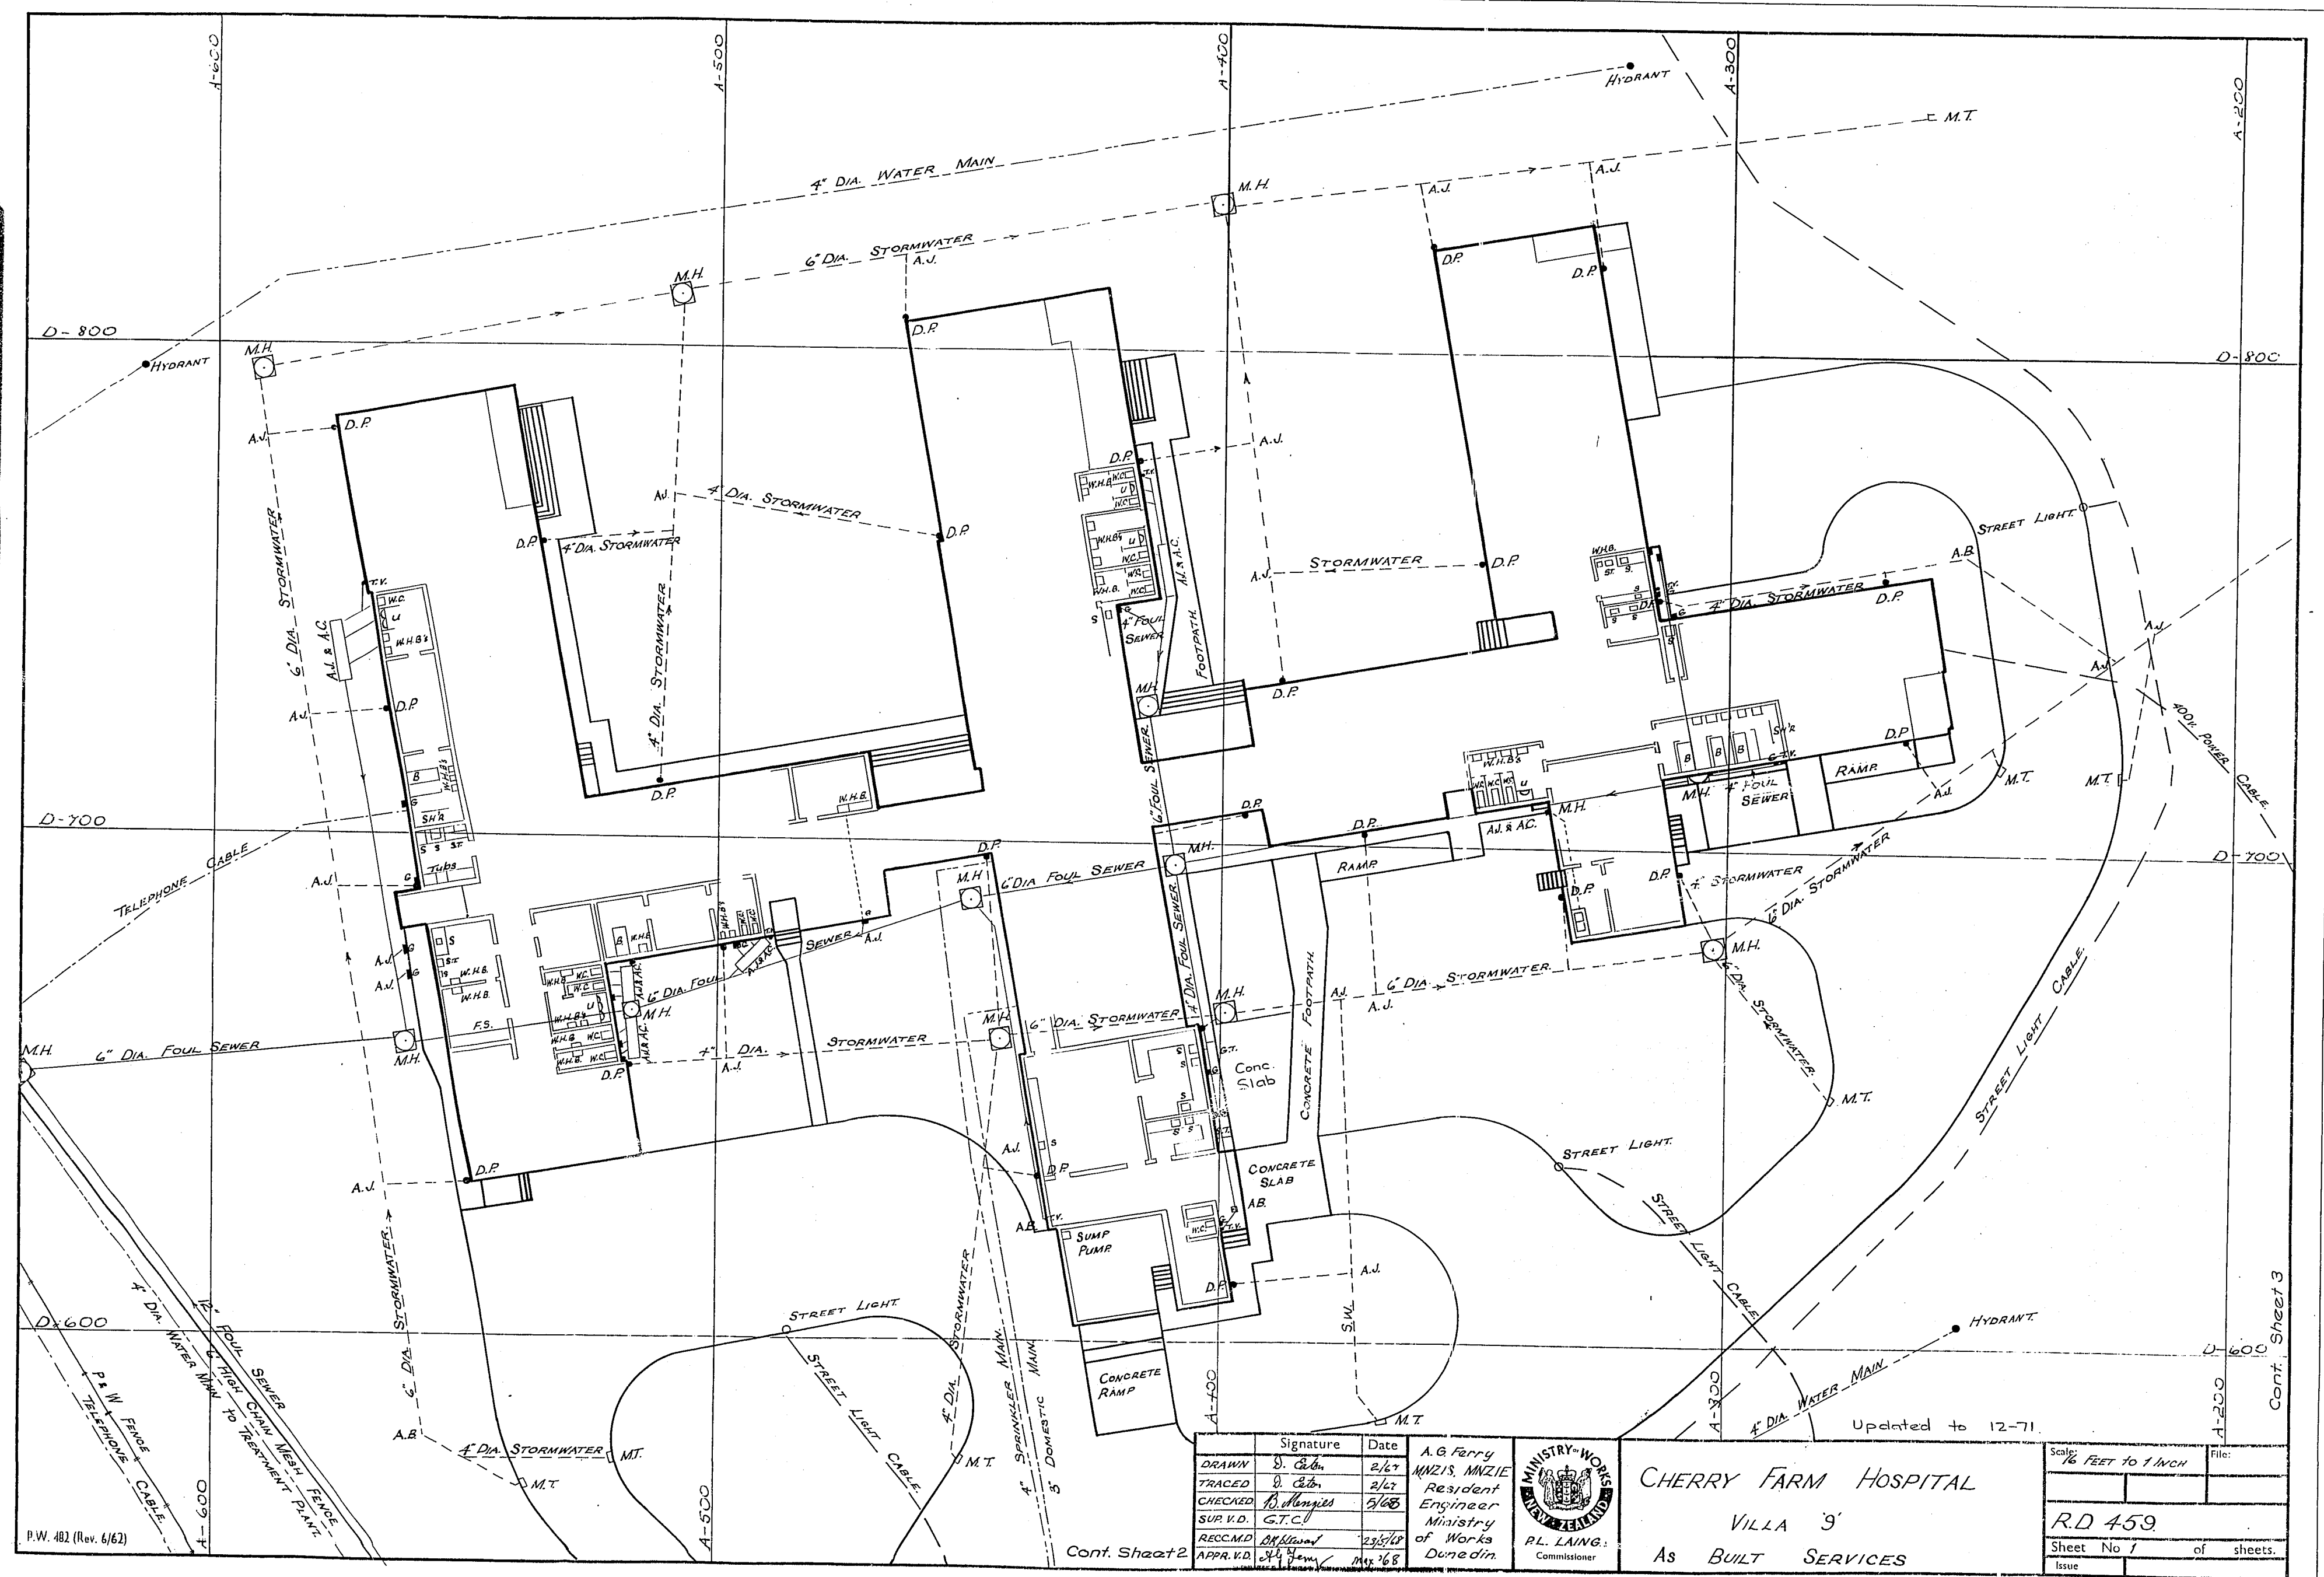

Signature	Date
Drawn S. C. G.	2/67
Traced S. C. G.	2/67
Checked R. H. G.	5/68
Sup. V.D. G.T.C.	
Recomm. R. H. G.	23/5/67
Appr. V.D. R. H. G.	May 1968


A. G. Ferry
 M.N.Z.I.S. M.N.Z.I.E.
 Resident Engineer
 Ministry of Works
 of Works
 Dunedin



CHERRY FARM HOSPITAL
 VILLA 9
 As BUILT SERVICES

Scale: 1/8" = 1' 0"	File:
R.D. 459	
Sheet No 1 of 1	
Issue	

MADE IN NEW ZEALAND
1 2 3 4 5 6 7 8 9 10 11 12 13 14 15 16 17 18 19 20 21 22 23 24 25 26 27 28 29 30 31 32 33 34 35 36 37 38 39 40
10 20 30 40 50 60 70 80 90 100 110 120 130 140 150 160 170 180 190 200 210 220 230 240 250 260 270 280 290 300 310 320 330 340 350 360 370 380 390 400

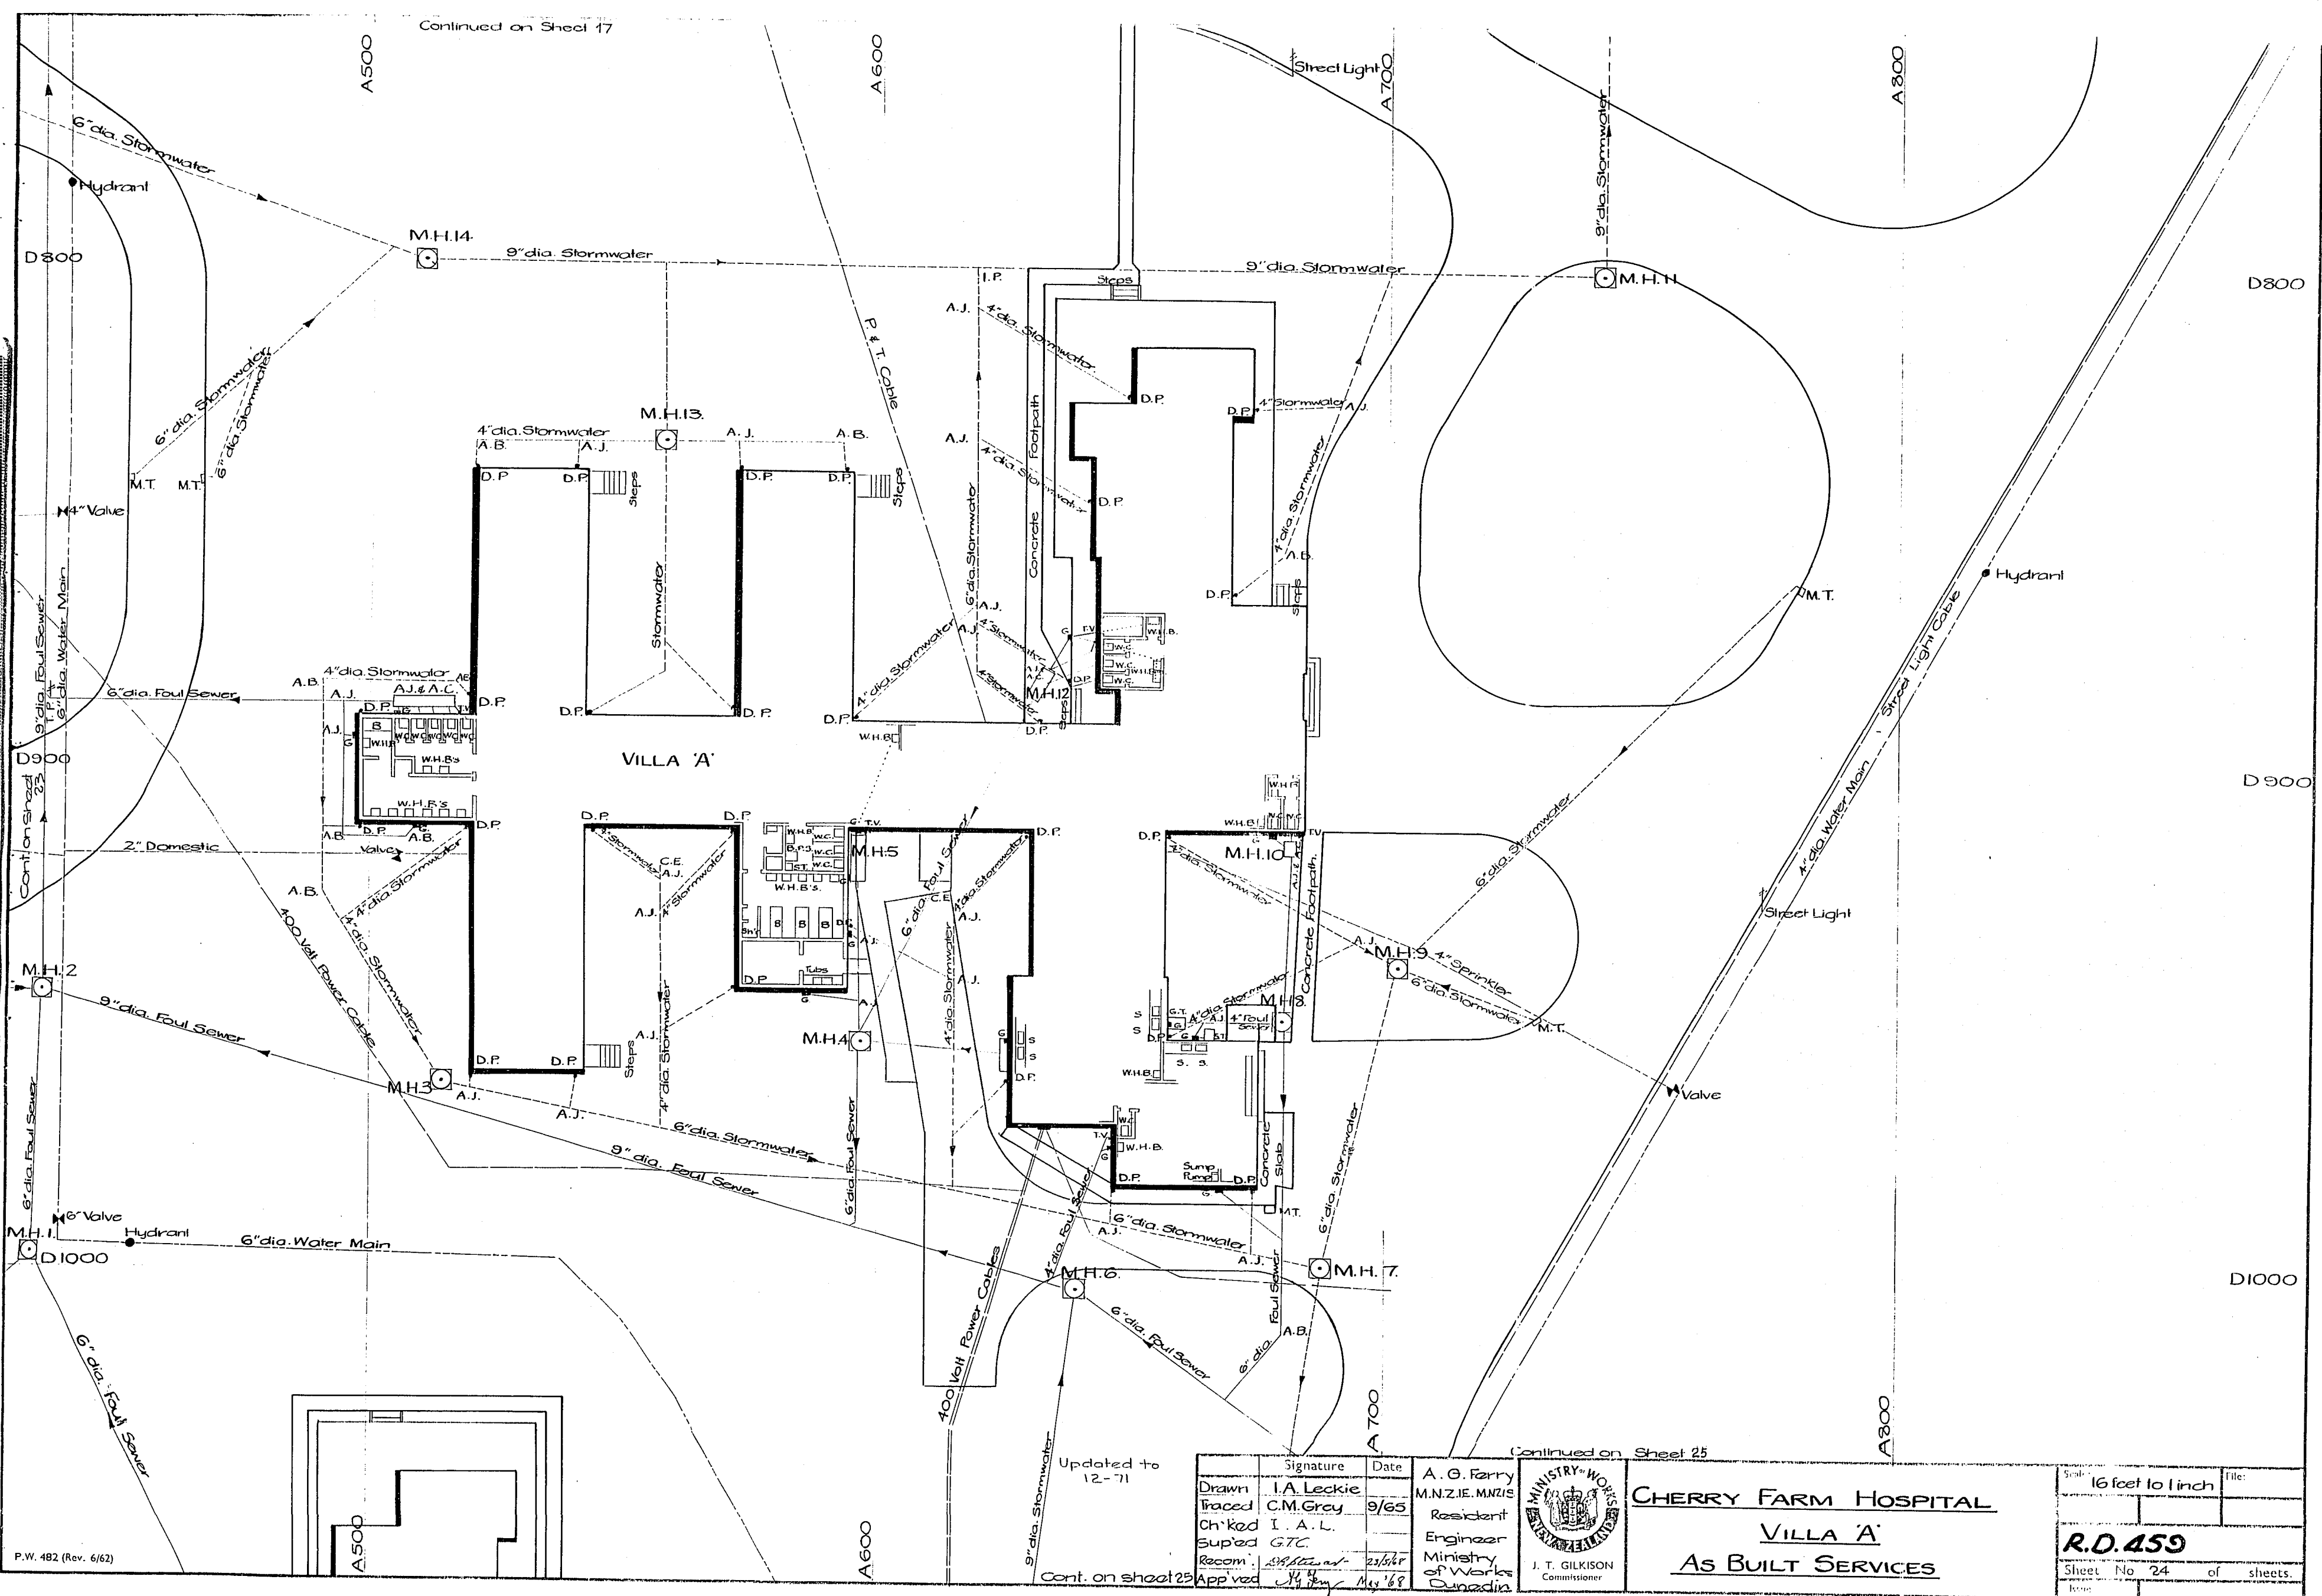

Updated to 12-71
Cont. on sheet 25

Signature	Date	A. G. Barry
Drawn	I. A. Leckie	M.N.Z.I.E. M.M.16
Traced	C. M. Gray	Resident
Ch'kd	I. A. L.	Engineer
Sup'd	G.T.C.	Ministry of Works
Rec'd	23/6/67	Canada
App'vd	14/7/67	




MINISTRY OF WORKS
J. T. GILKISON
Commissioner

CHERRY FARM HOSPITAL
VILLA 'A'
AS BUILT SERVICES

Scale: 16 feet to 1 inch
R.D. 459
Sheet No 24 of sheets

1 2 3 4 5 6 7 8 9 10 11 12 13 14 15 16 17 18 19 20 21 22 23 24 25 26 27 28 29 30 31 32 33 34 35 36 37 38 39 40

MADE IN NEW ZEALAND

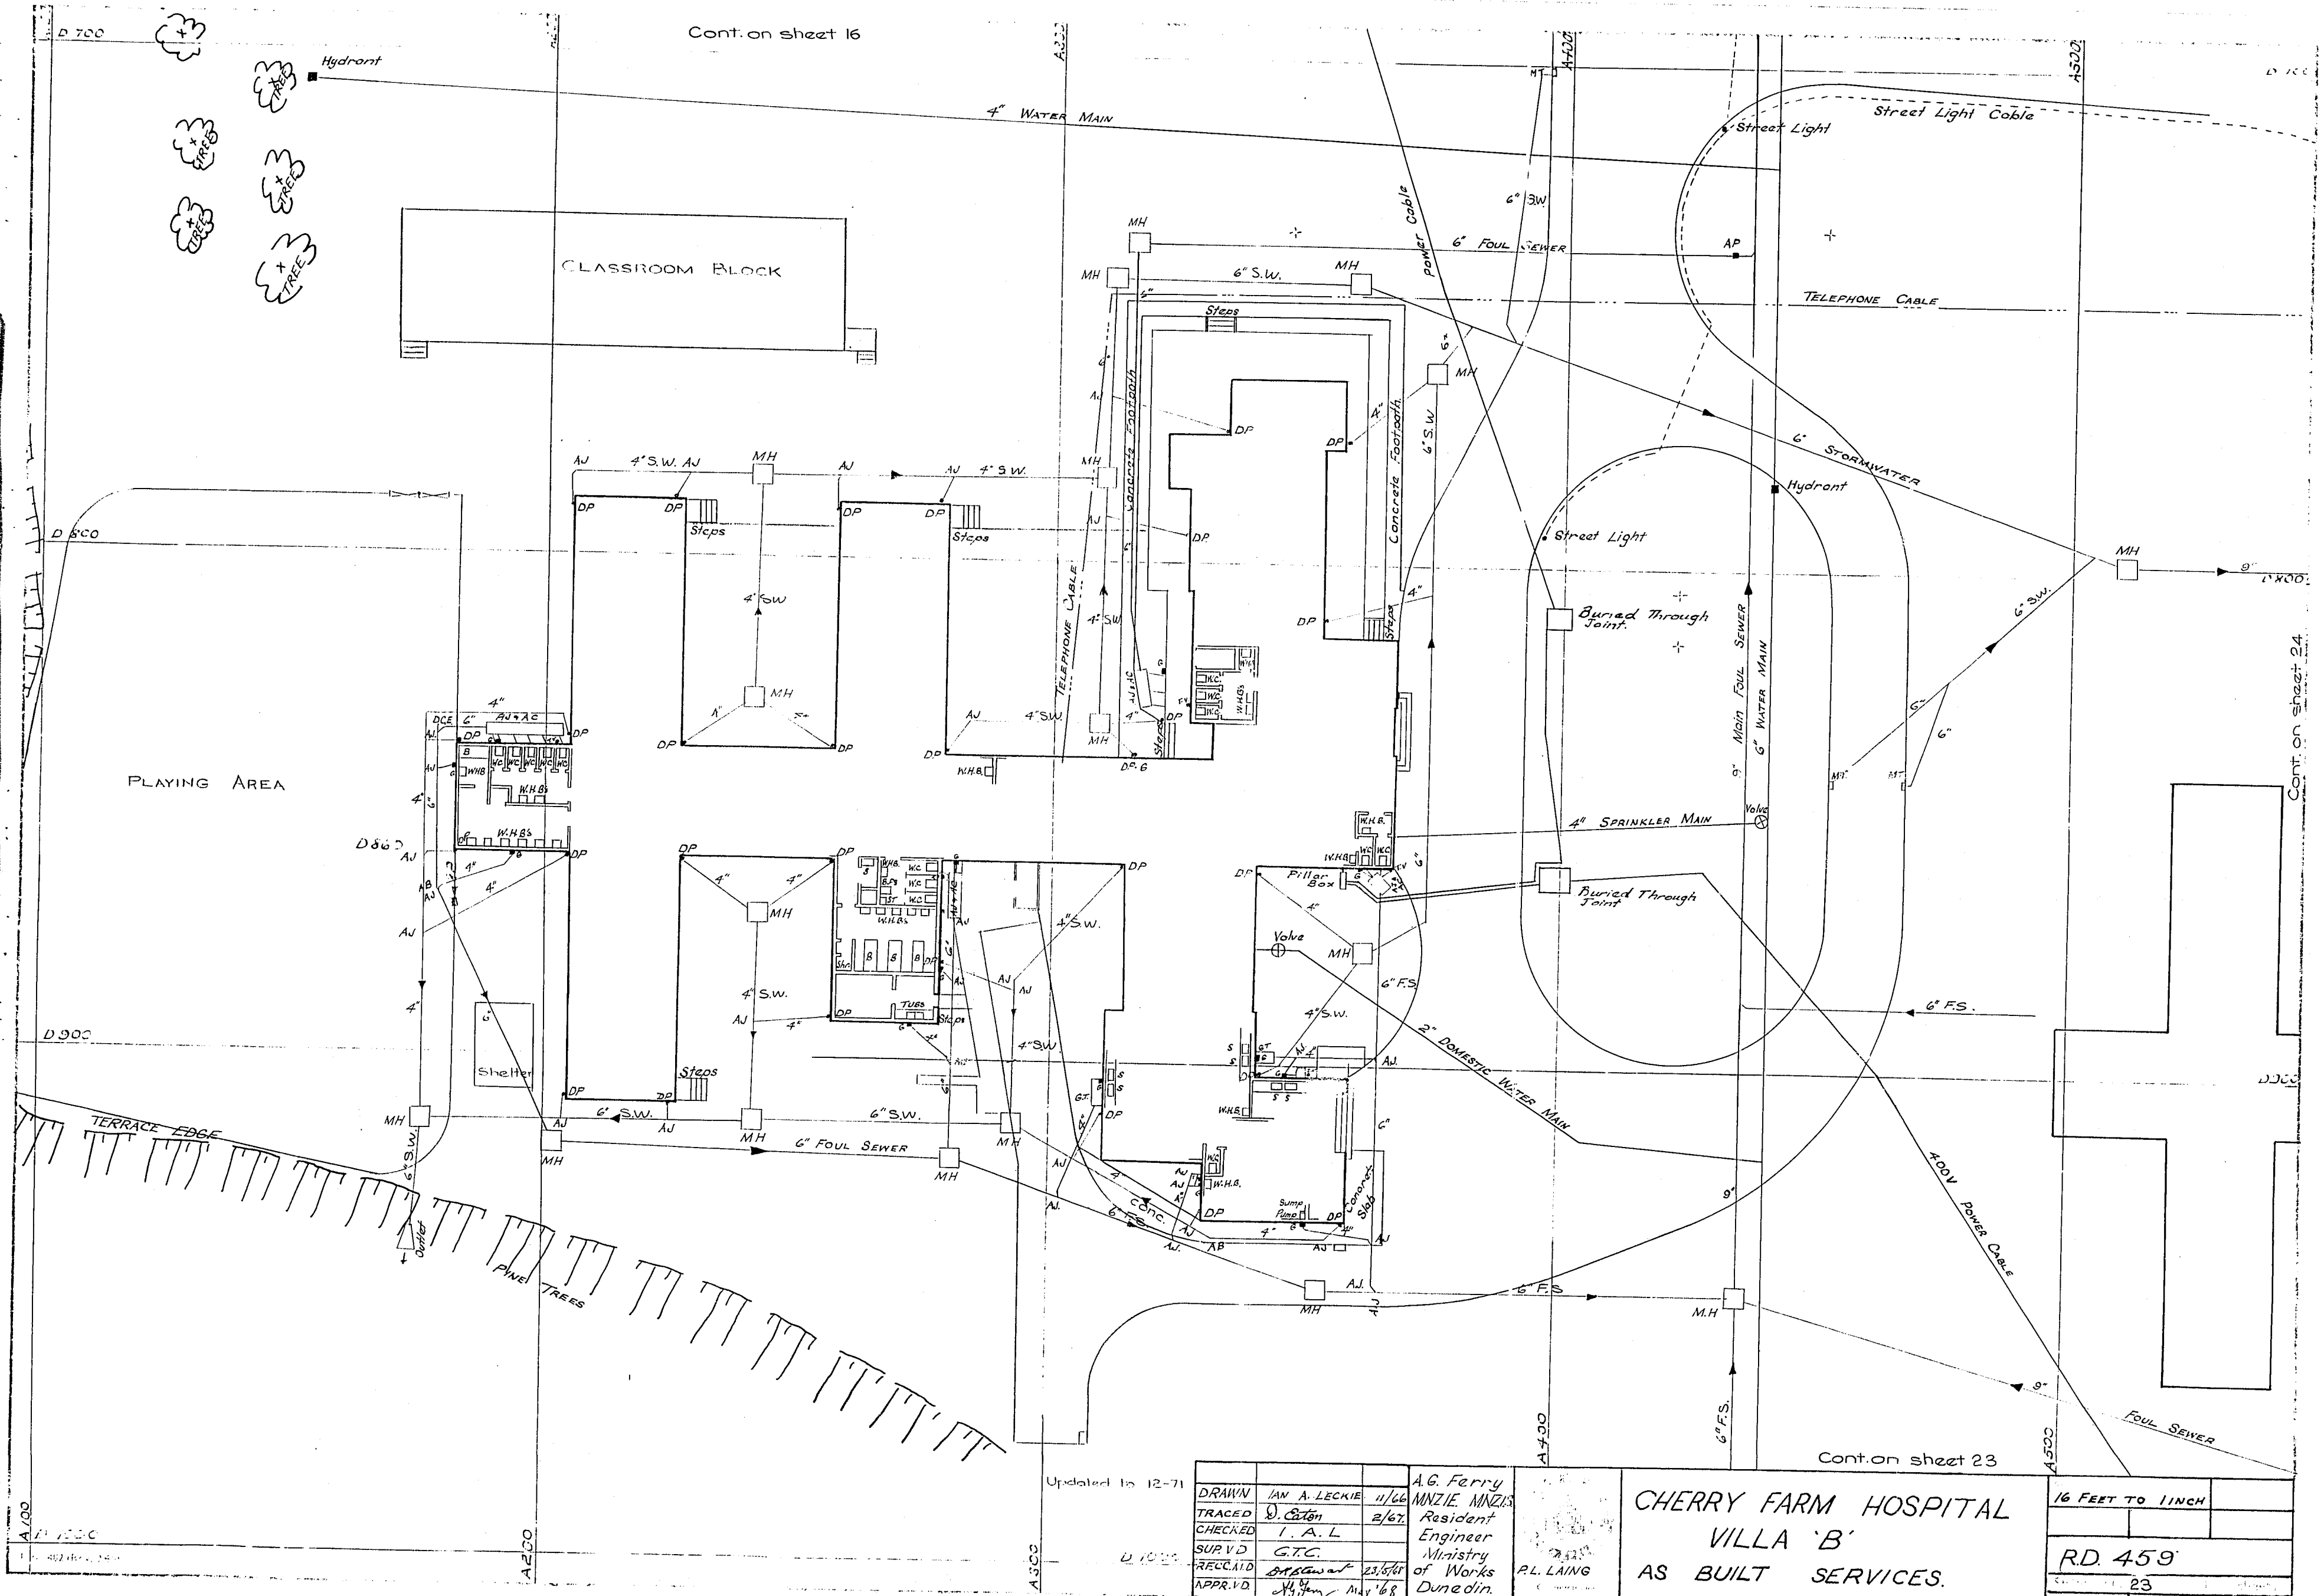


Updated to 12-71


DRAWN	IAN A. LECKIE	11/66	A.G. FERRY
TRACED	D. COTTON	2/67	MINZIE, MINZIE
CHECKED	I. A. L.		Resident
SUPV'D	G.T.C.		Engineer
RECEIVED	23/5/61		Ministry of Works
APPROVED	24/5/61		Dunedin.

CHERRY FARM HOSPITAL
VILLA 'B'
AS BUILT SERVICES.

16 FEET TO 1 INCH
RD. 459
Sheet 23

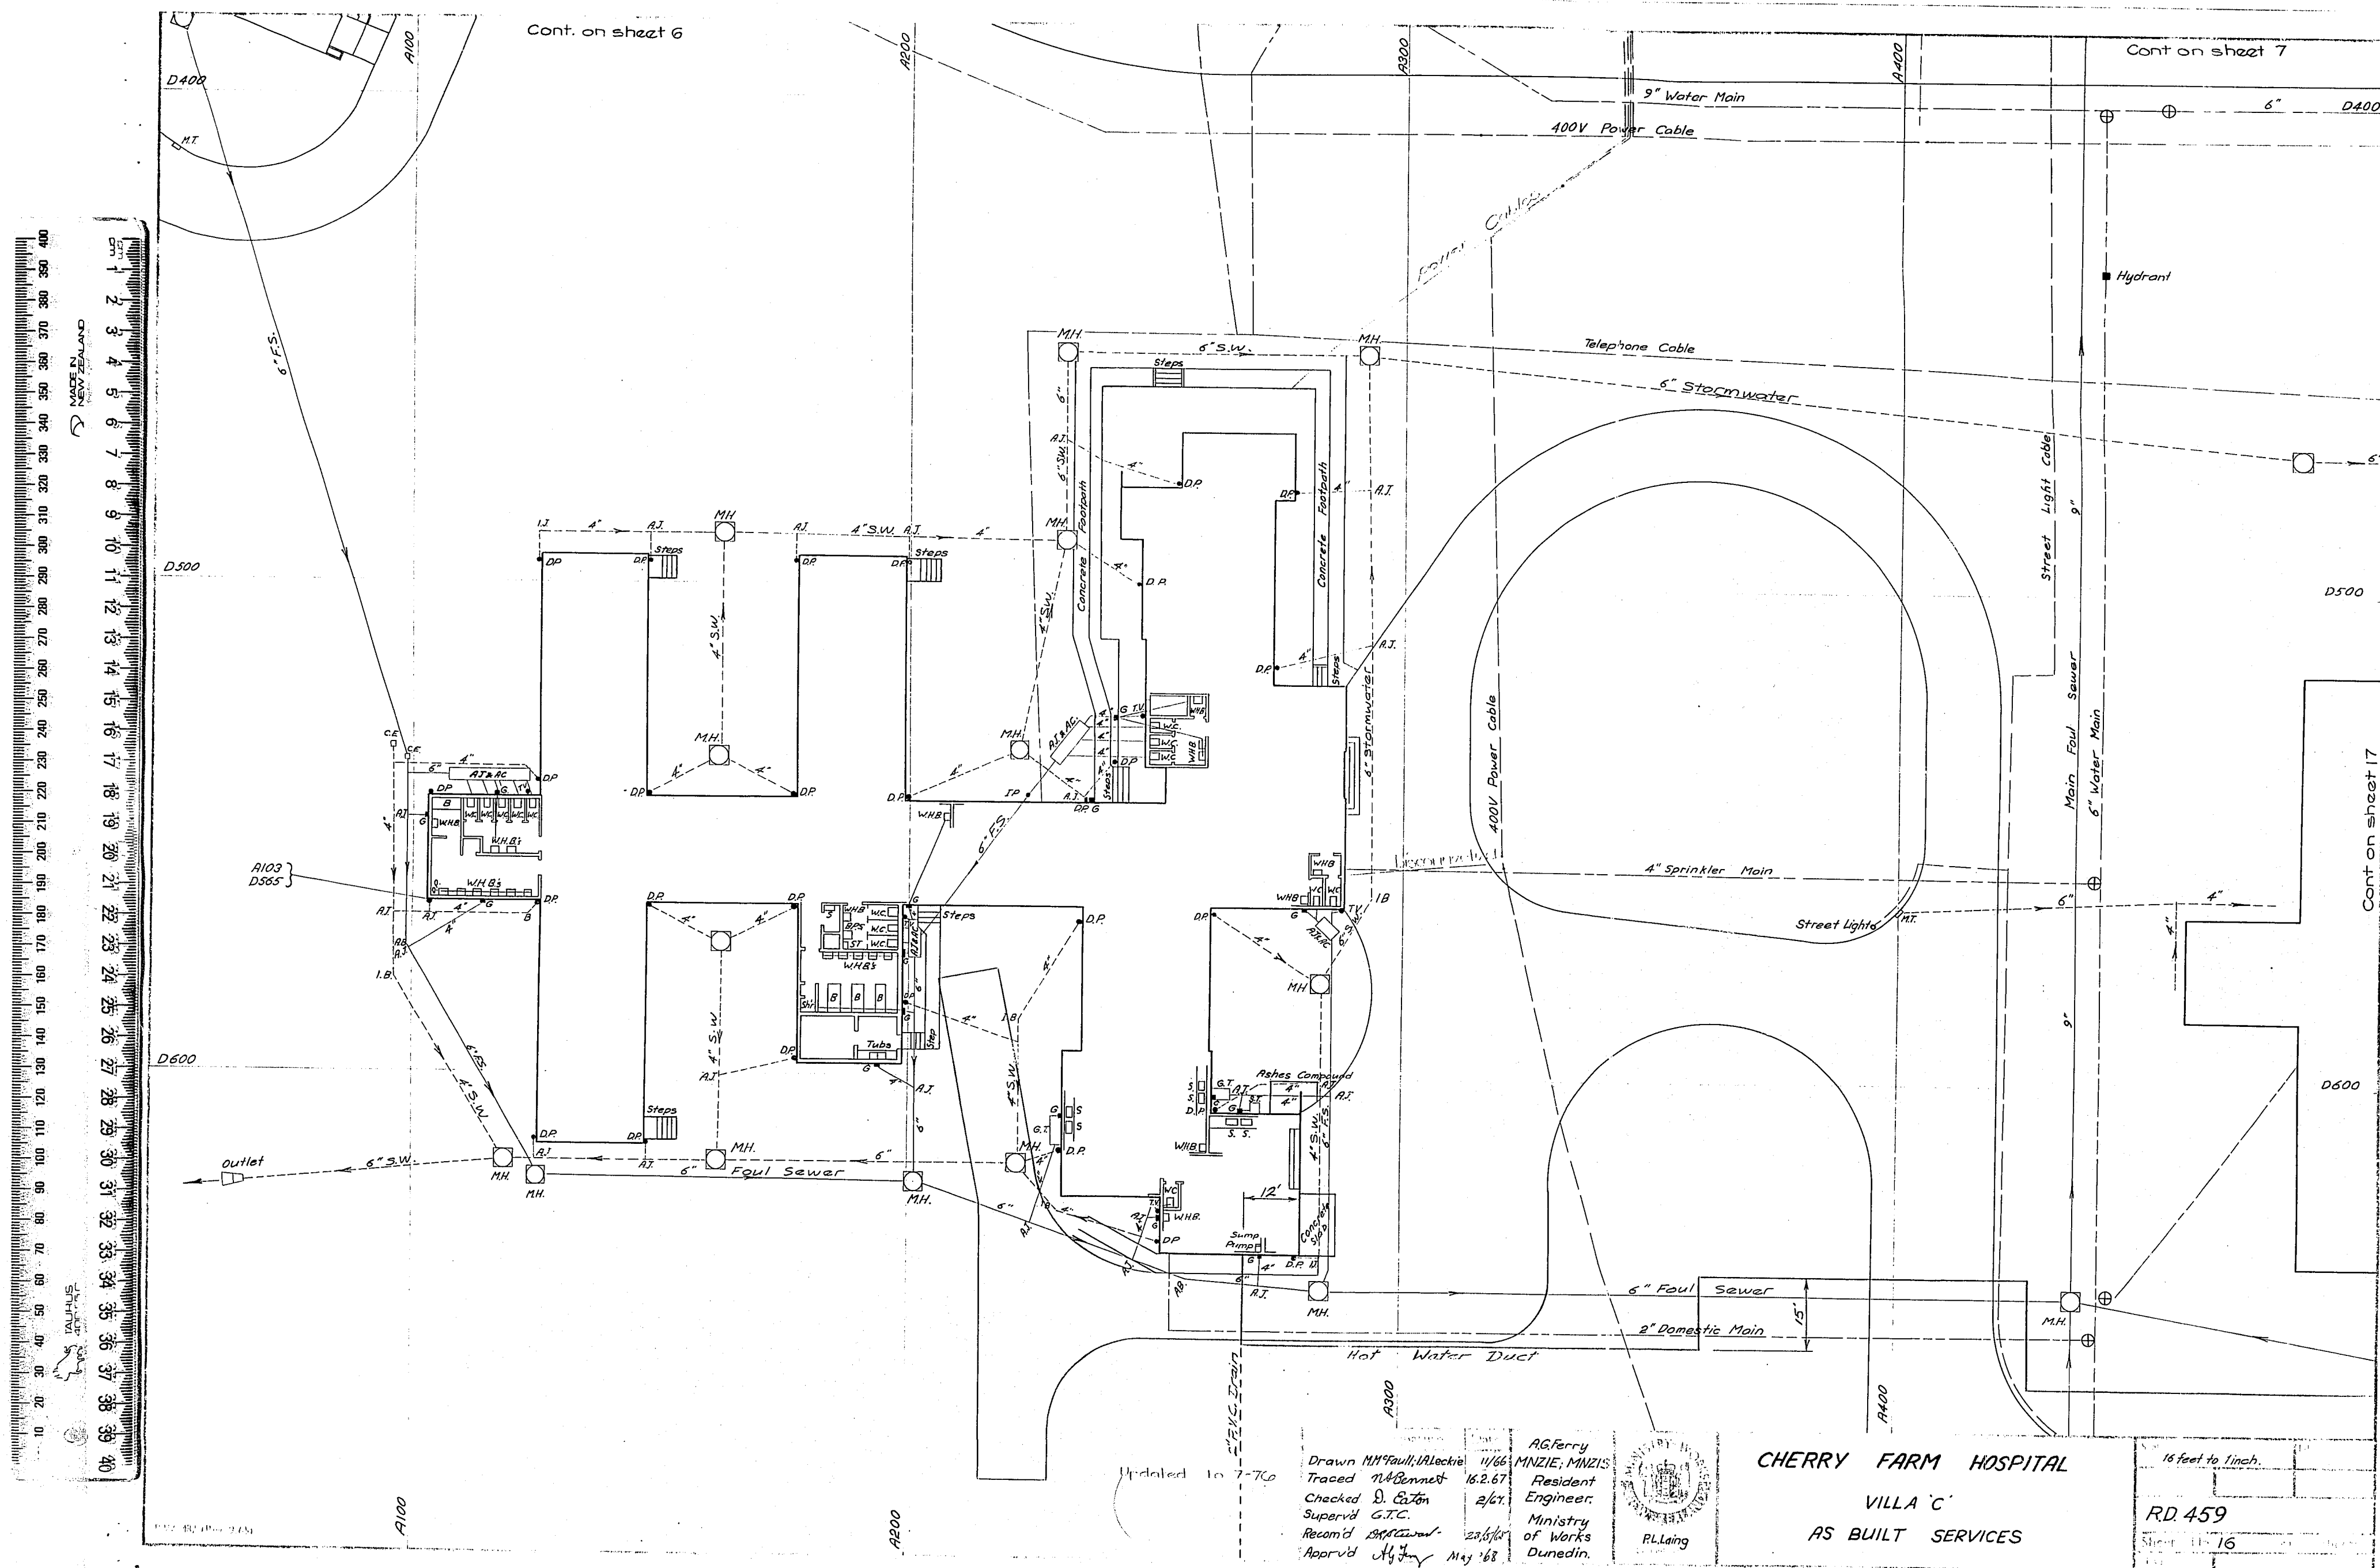

1 2 3 4 5 6 7 8 9 10 11 12 13 14 15 16 17 18 19 20 21 22 23 24 25 26 27 28 29 30 31 32 33 34 35 36 37 38 39 40

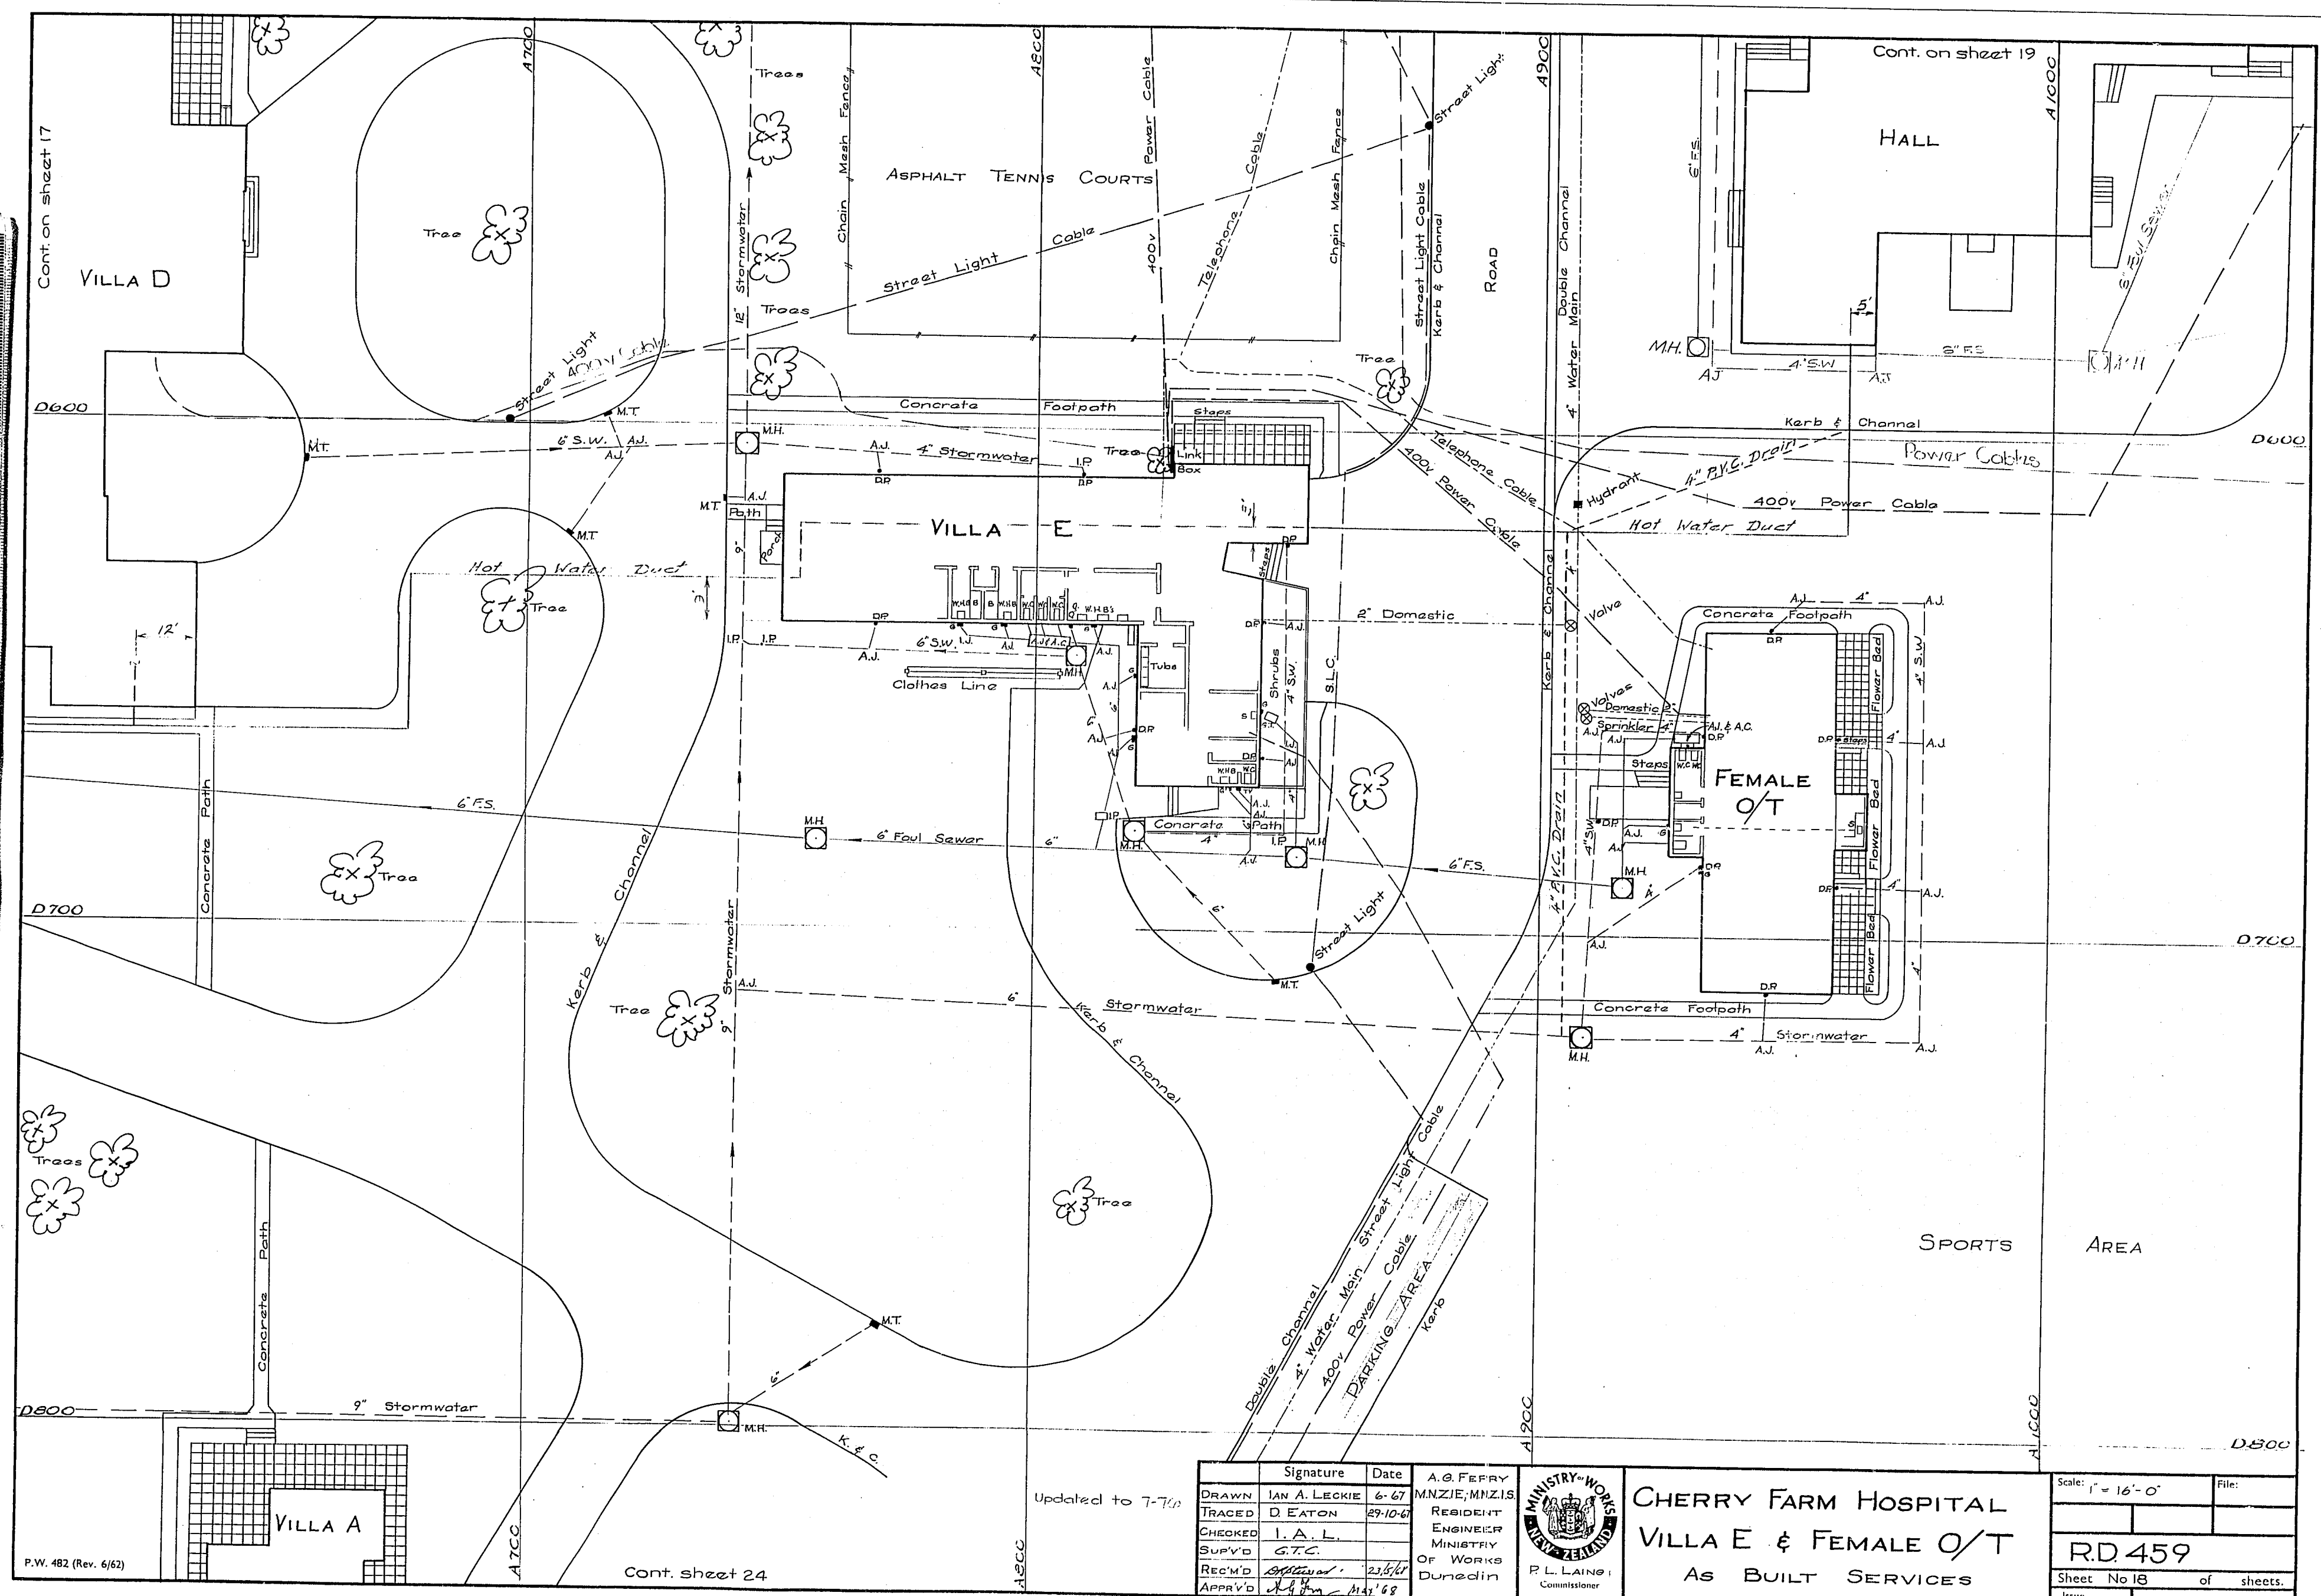



Signature	Date	A.G. FERRY
DRAWN IAN A. LECKIE	6-67	MNZIE/MNZIS
TRACED D. EATON	29-10-67	RESIDENT
CHECKED I. A. L.		ENGINEER
SUP'D G.T.C.		MINISTRY
REC'D	23/5/67	OF WORKS
APPR'D	14/1/68	Dunedin



CHERRY FARM HOSPITAL
VILLA E & FEMALE O/T
AS BUILT SERVICES


Scale: 1" = 16'-0"	File:
RD 459	
Sheet No 18	of sheets.
Issue	

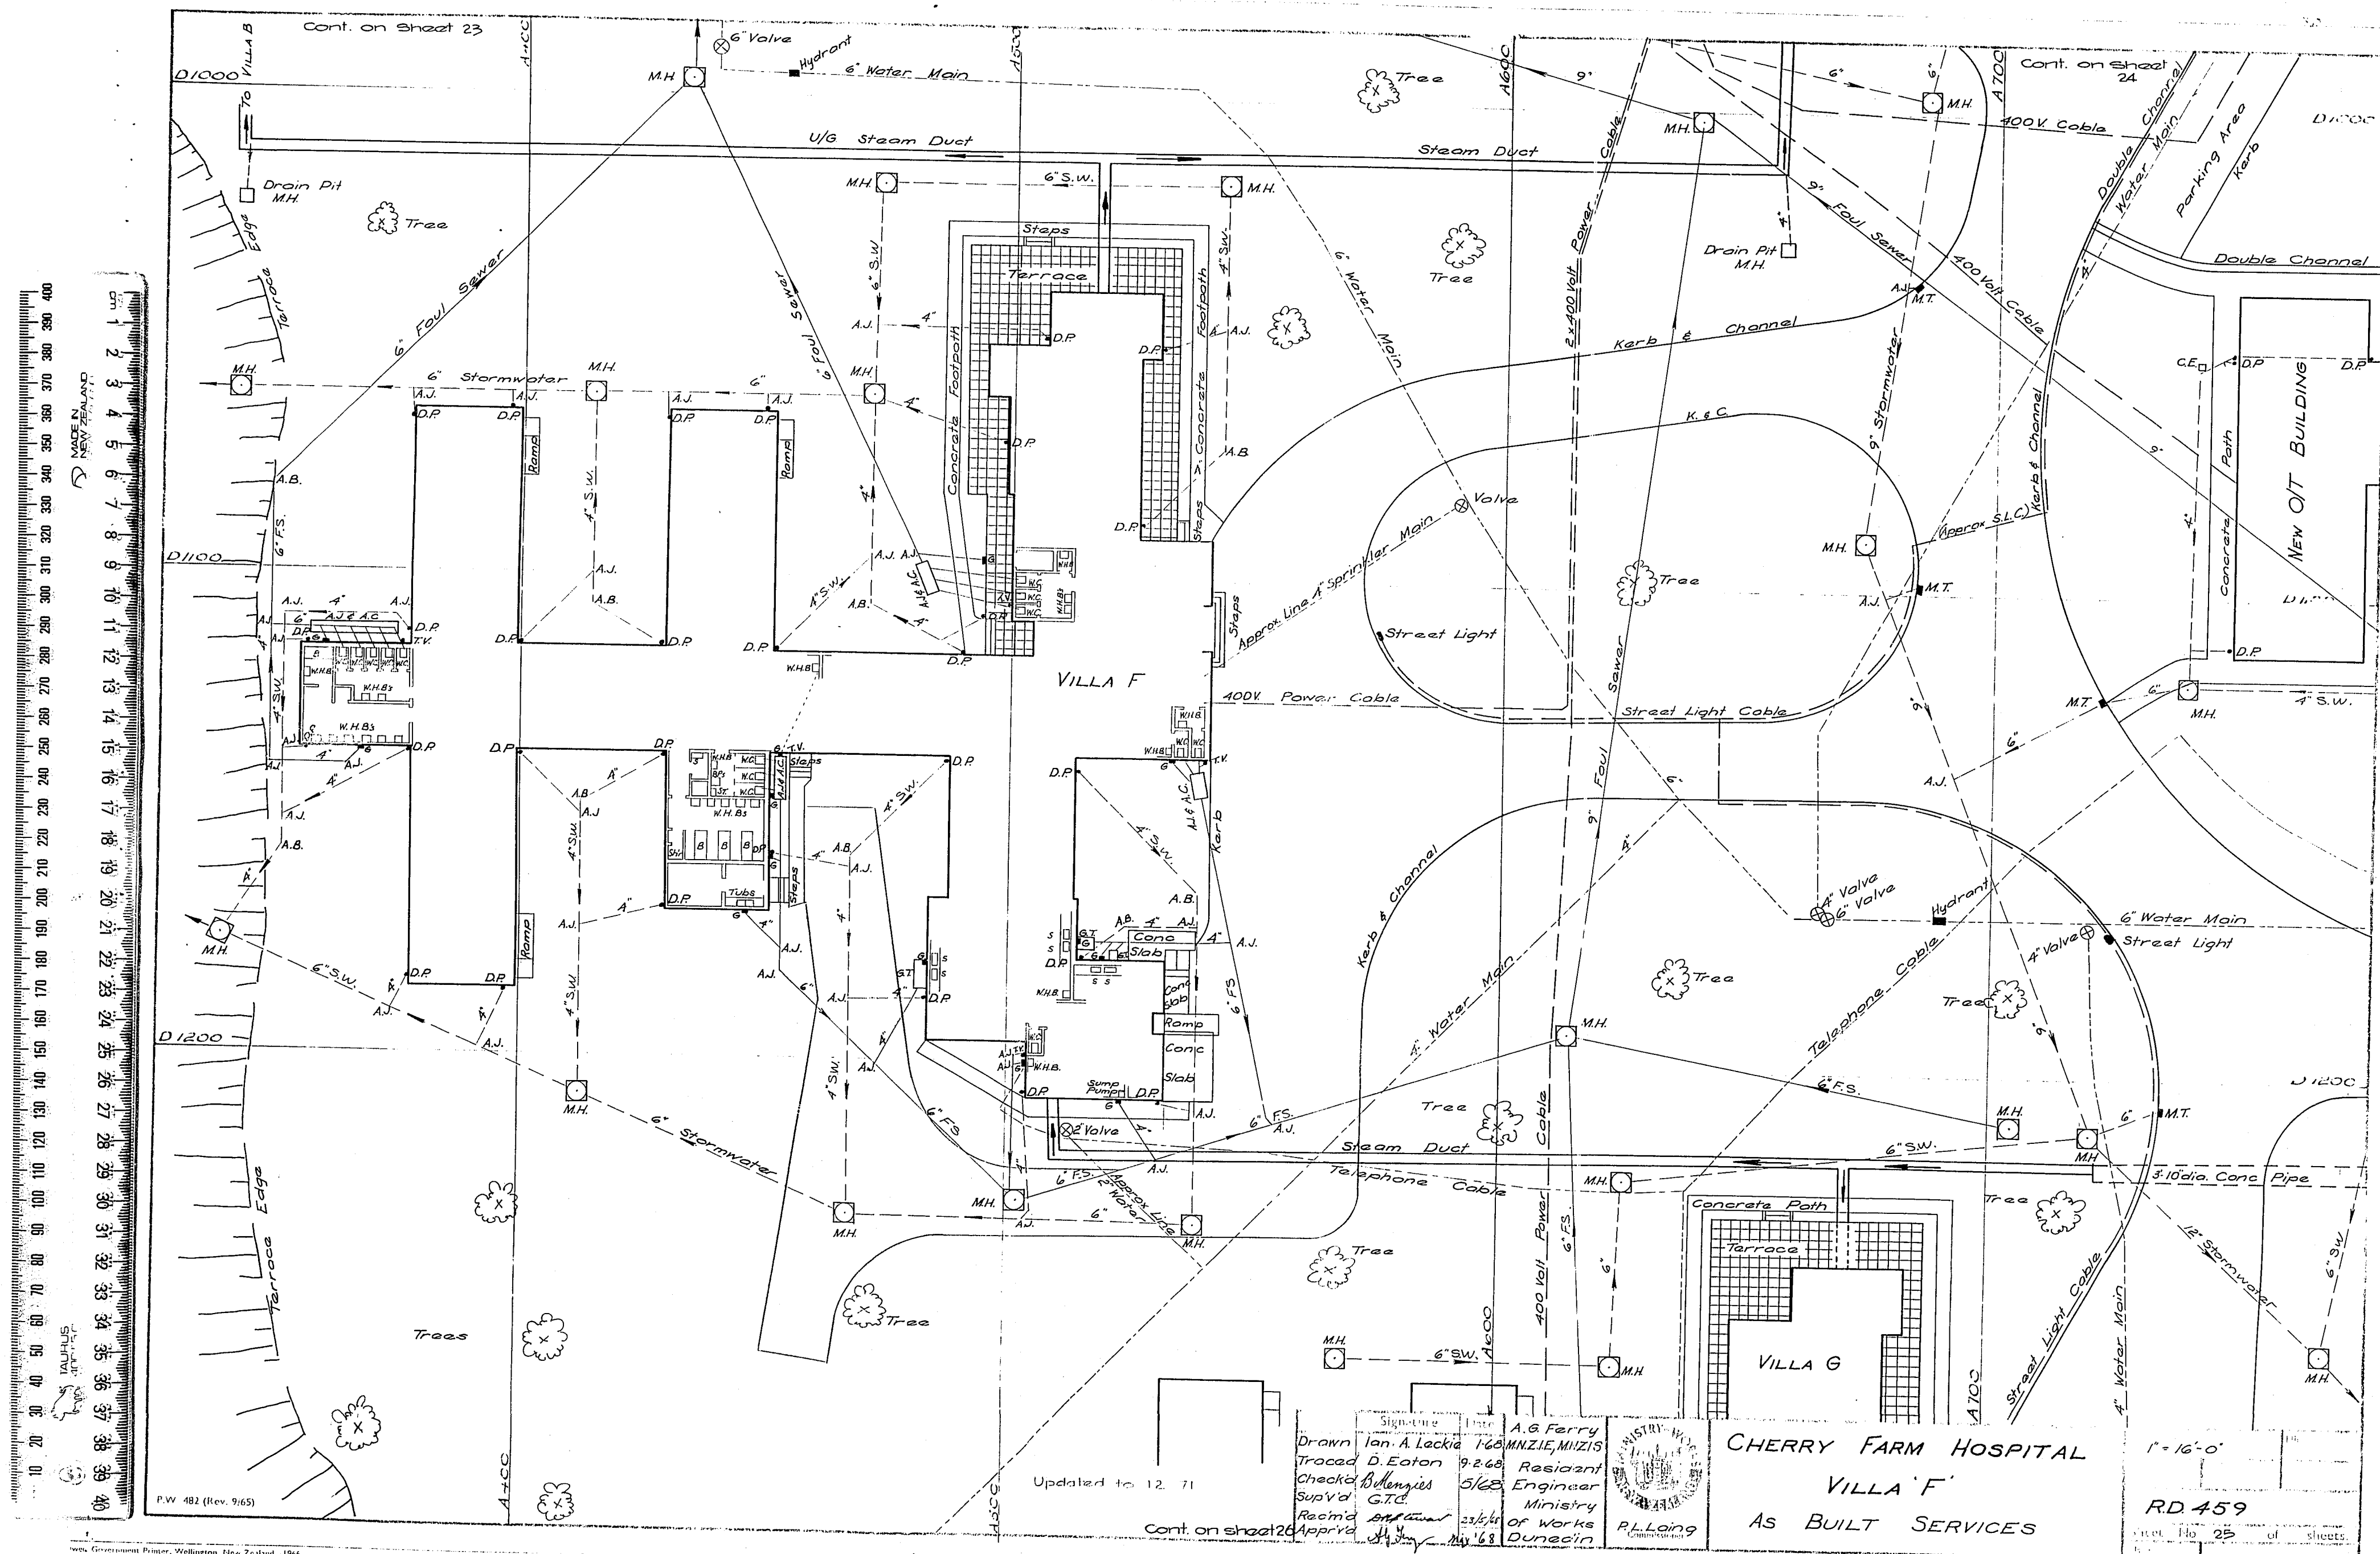

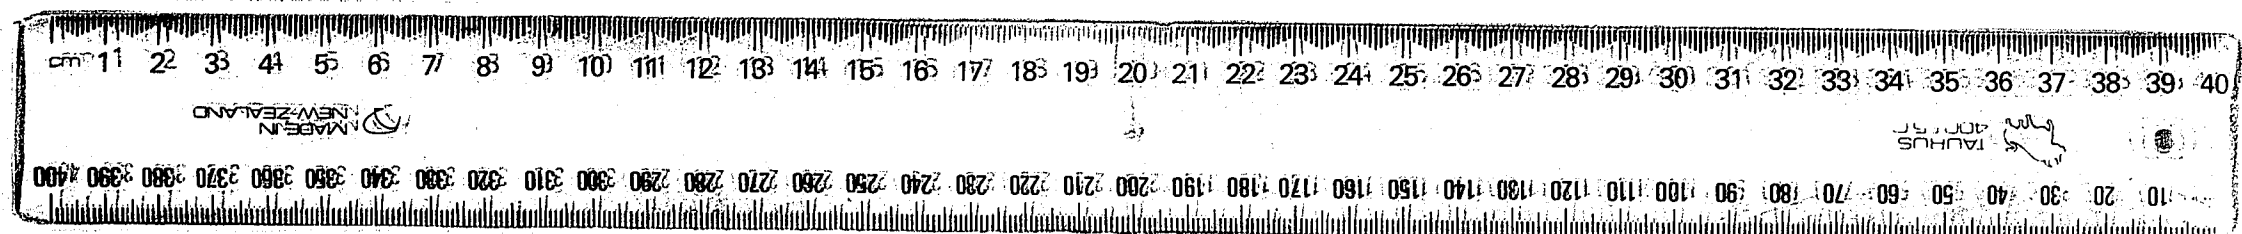

MADE IN NEW ZEALAND



1 2 3 4 5 6 7 8 9 10 11 12 13 14 15 16 17 18 19 20 21 22 23 24 25 26 27 28 29 30 31 32 33 34 35 36 37 38 39 40

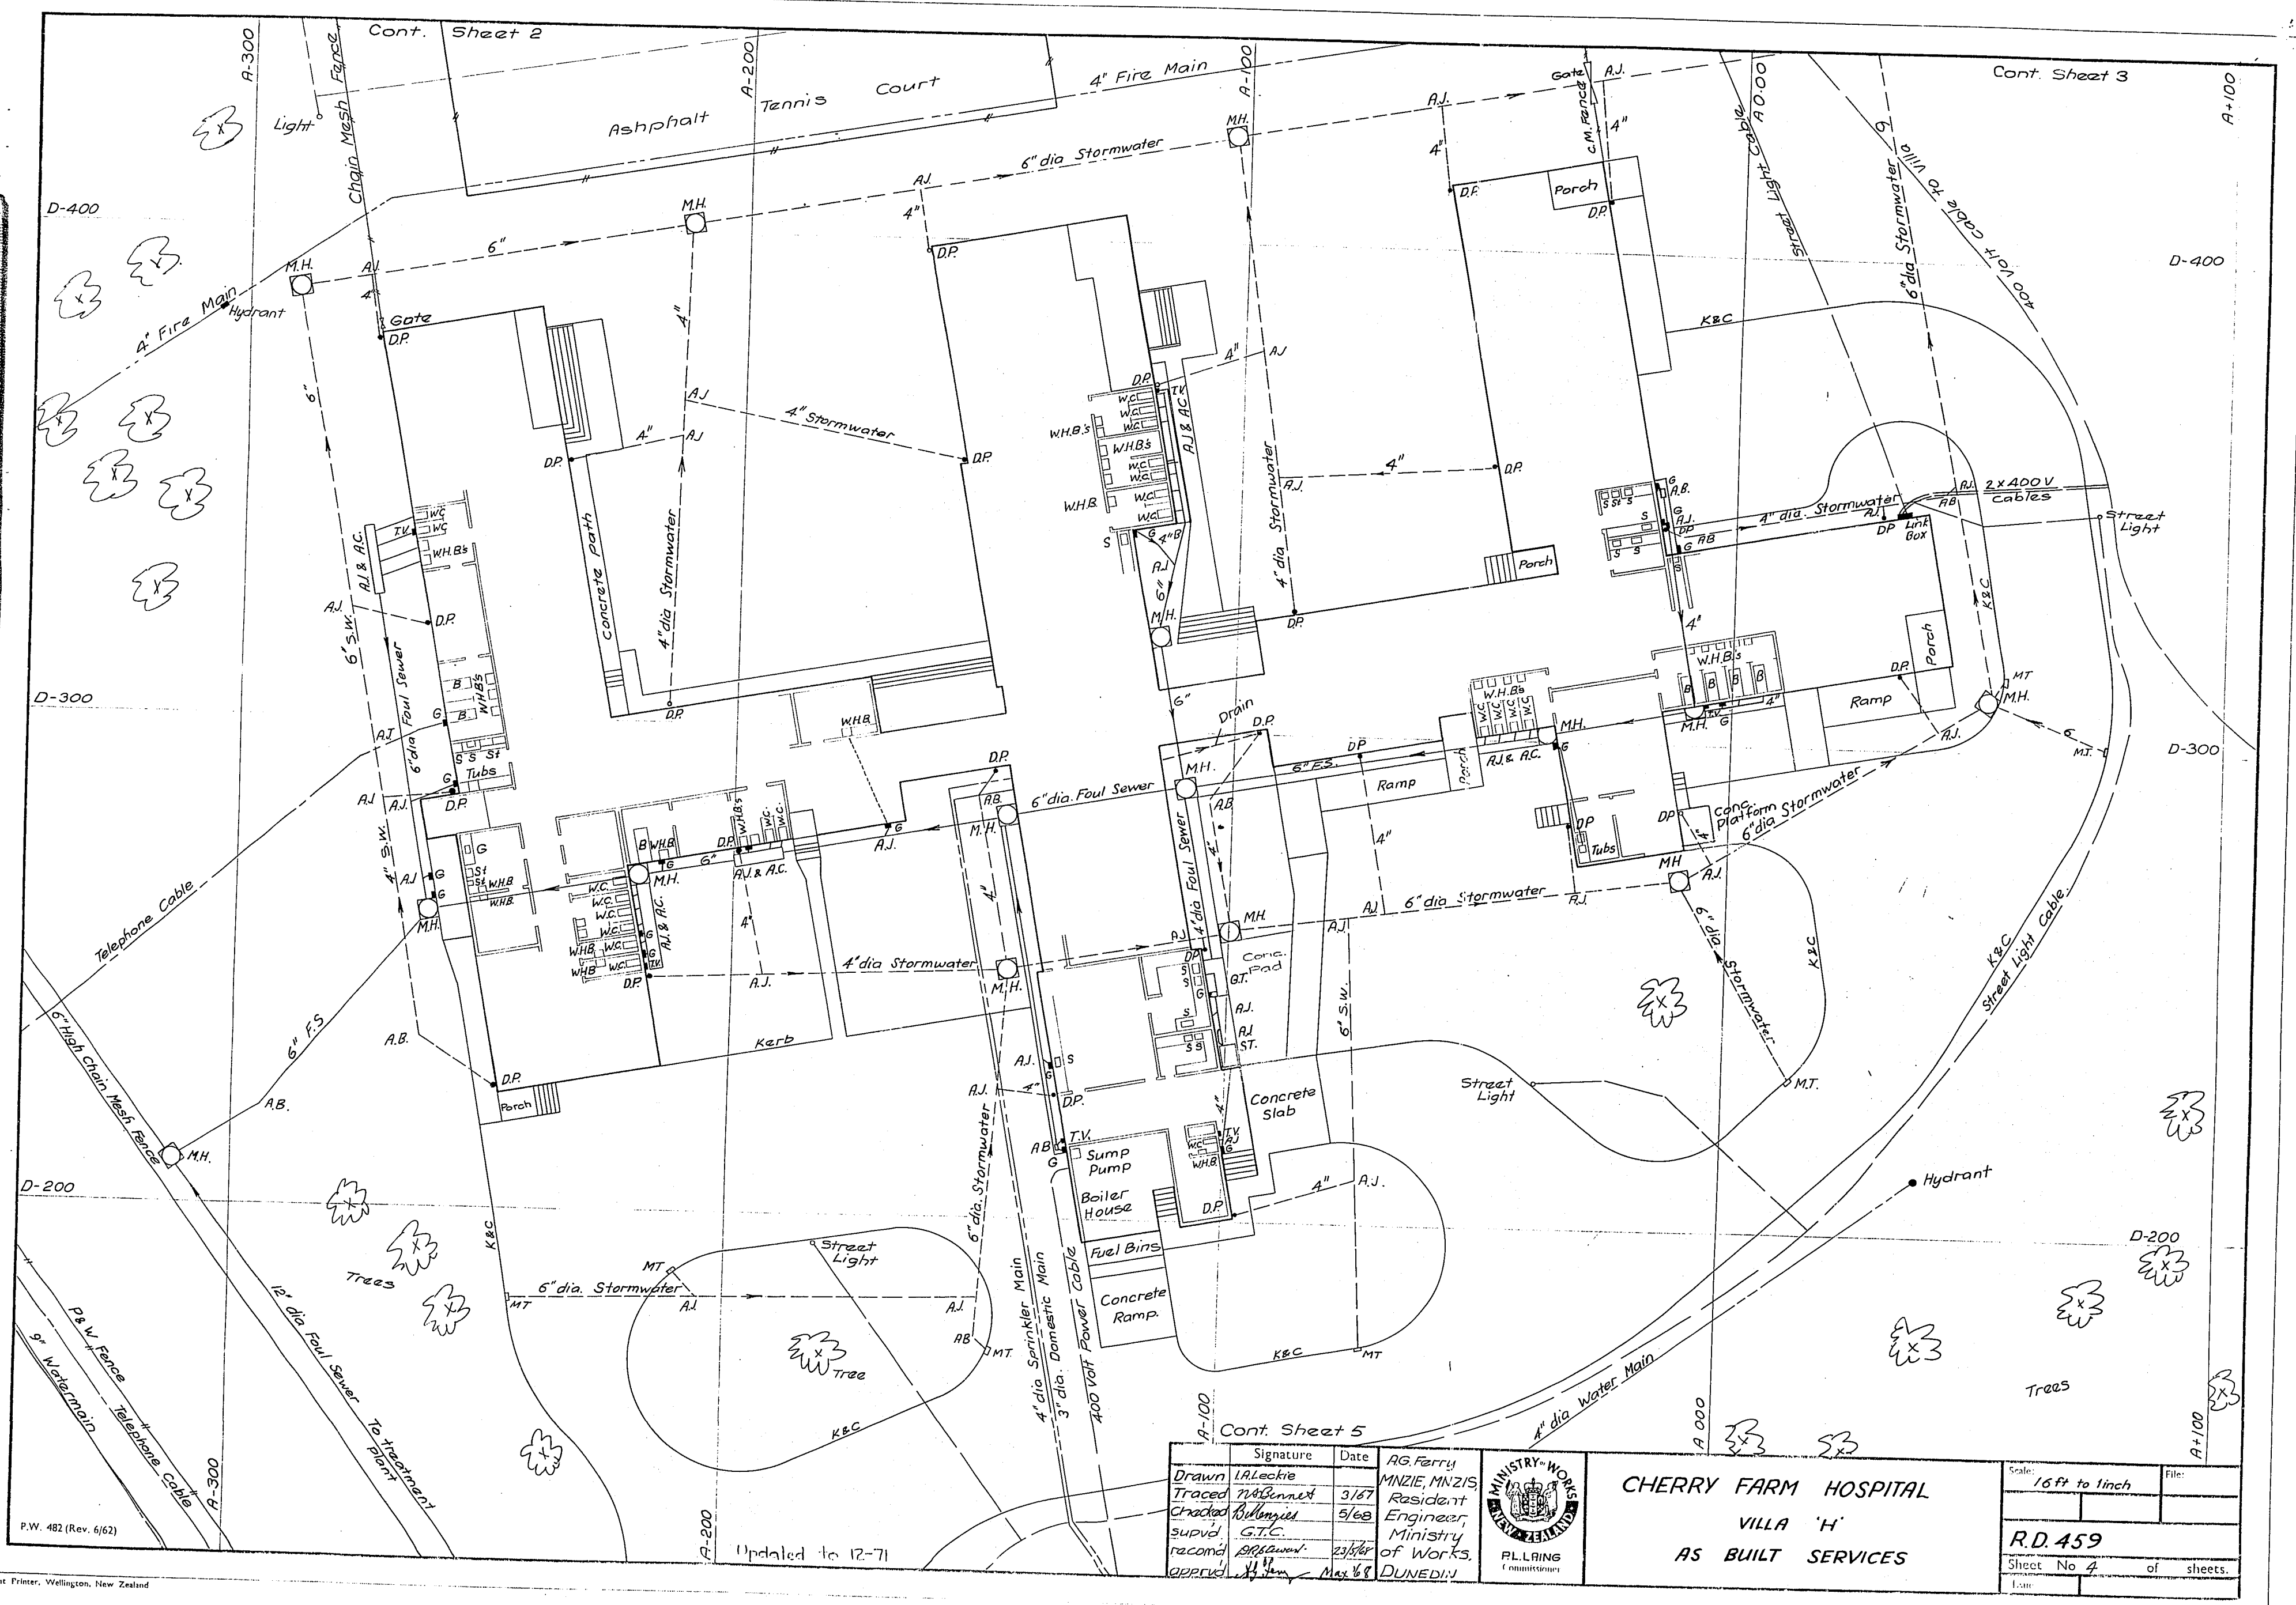

MADE IN NEW ZEALAND

ORIGINAL SIZE mm

0 10 20 1000

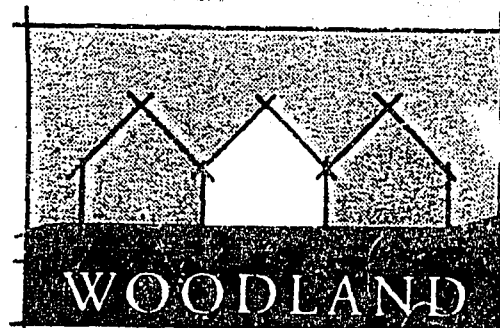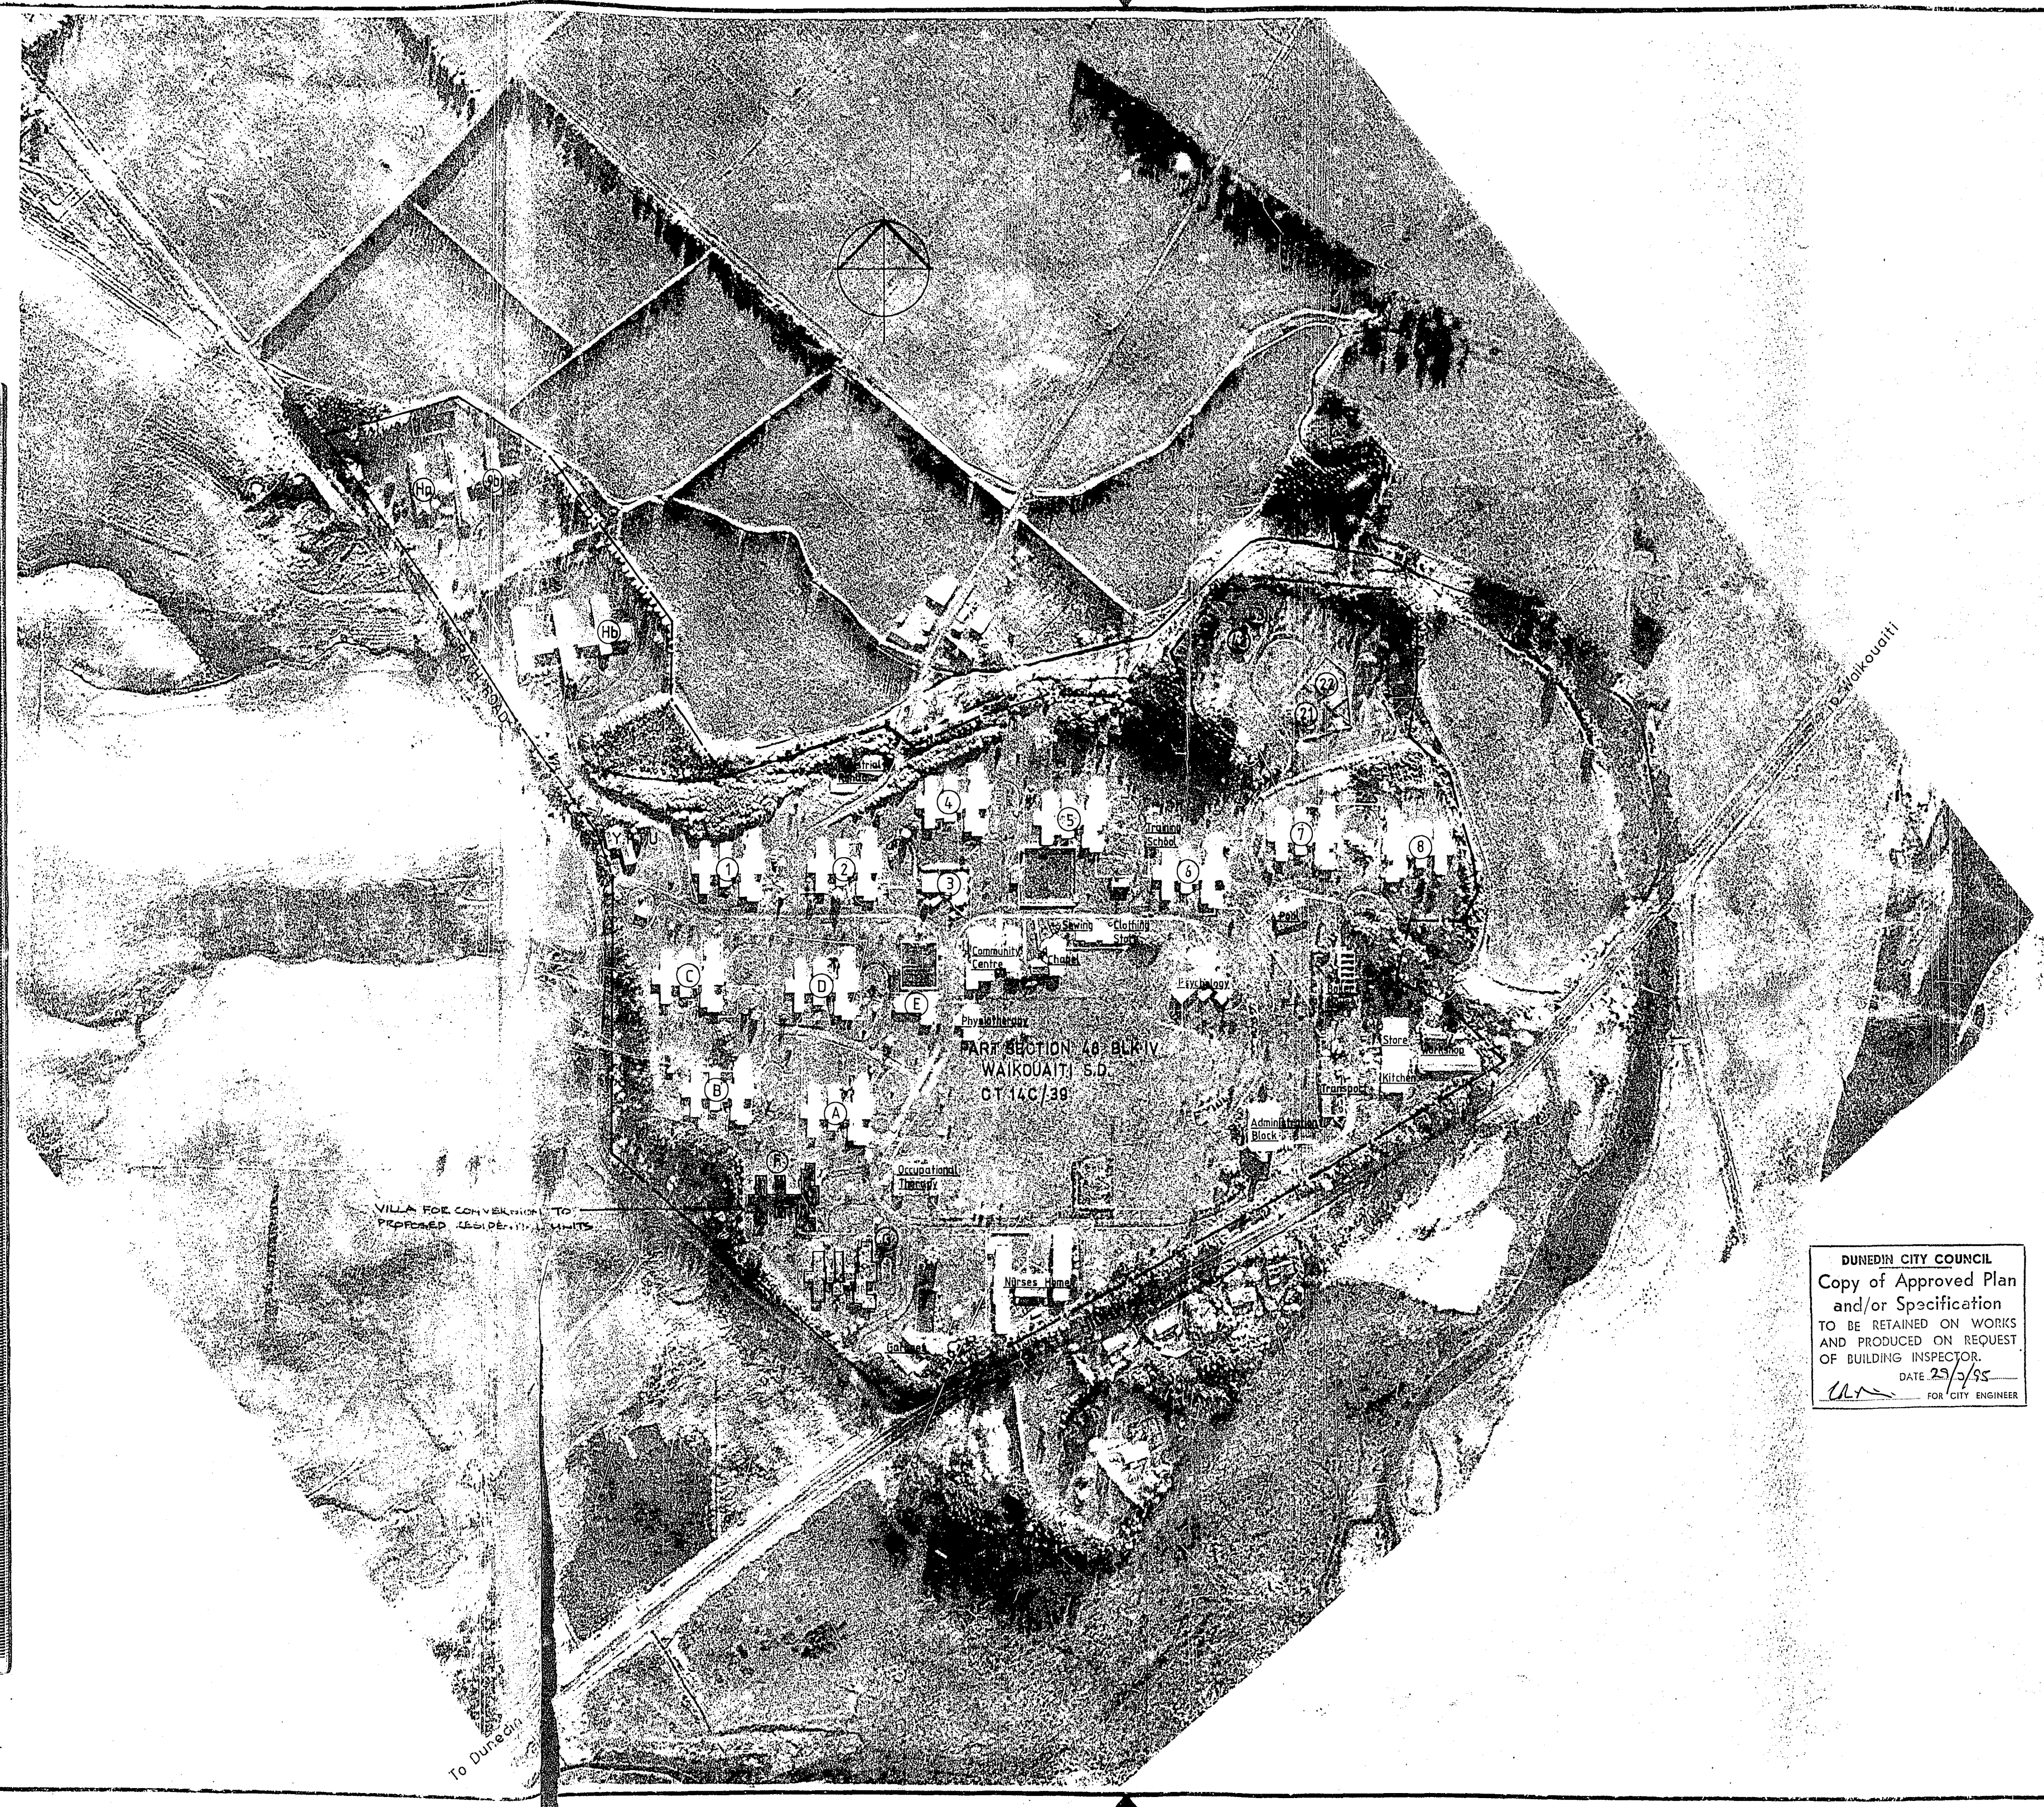

DUNEDIN CITY COUNCIL
 Copy of Approved Plan
 and/or Specification
 TO BE RETAINED ON WORKS
 AND PRODUCED ON REQUEST
 OF BUILDING INSPECTOR.
 DATE 29/3/95
 [Signature] FOR CITY ENGINEER

F.B.	Initials	Date	TR.	Initials	Date
SURV.			CH.		
DGN.			APP.		
DR.					


CLIENT KARITANE ESTATES LTD

JOB NAME HAWKSURY VILLAGE

TITLE SITE PLAN



SCALE 1:2500

95/0091

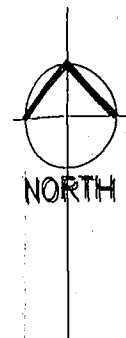

NOTES

1. ALL AREAS INDICATED TO BE DEMOLISHED ARE TO INCLUDE ALL ROOF, WALLS, FLOORS & FOUNDATIONS.
2. ALL SERVICES ARE TO BE BLOCKED OFF BELOW GROUND.

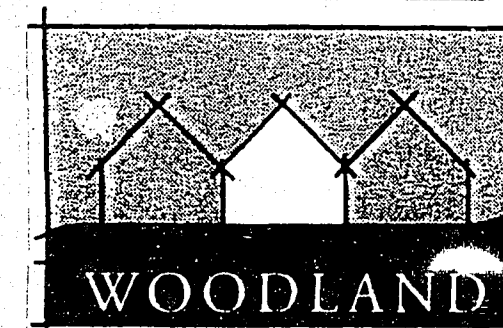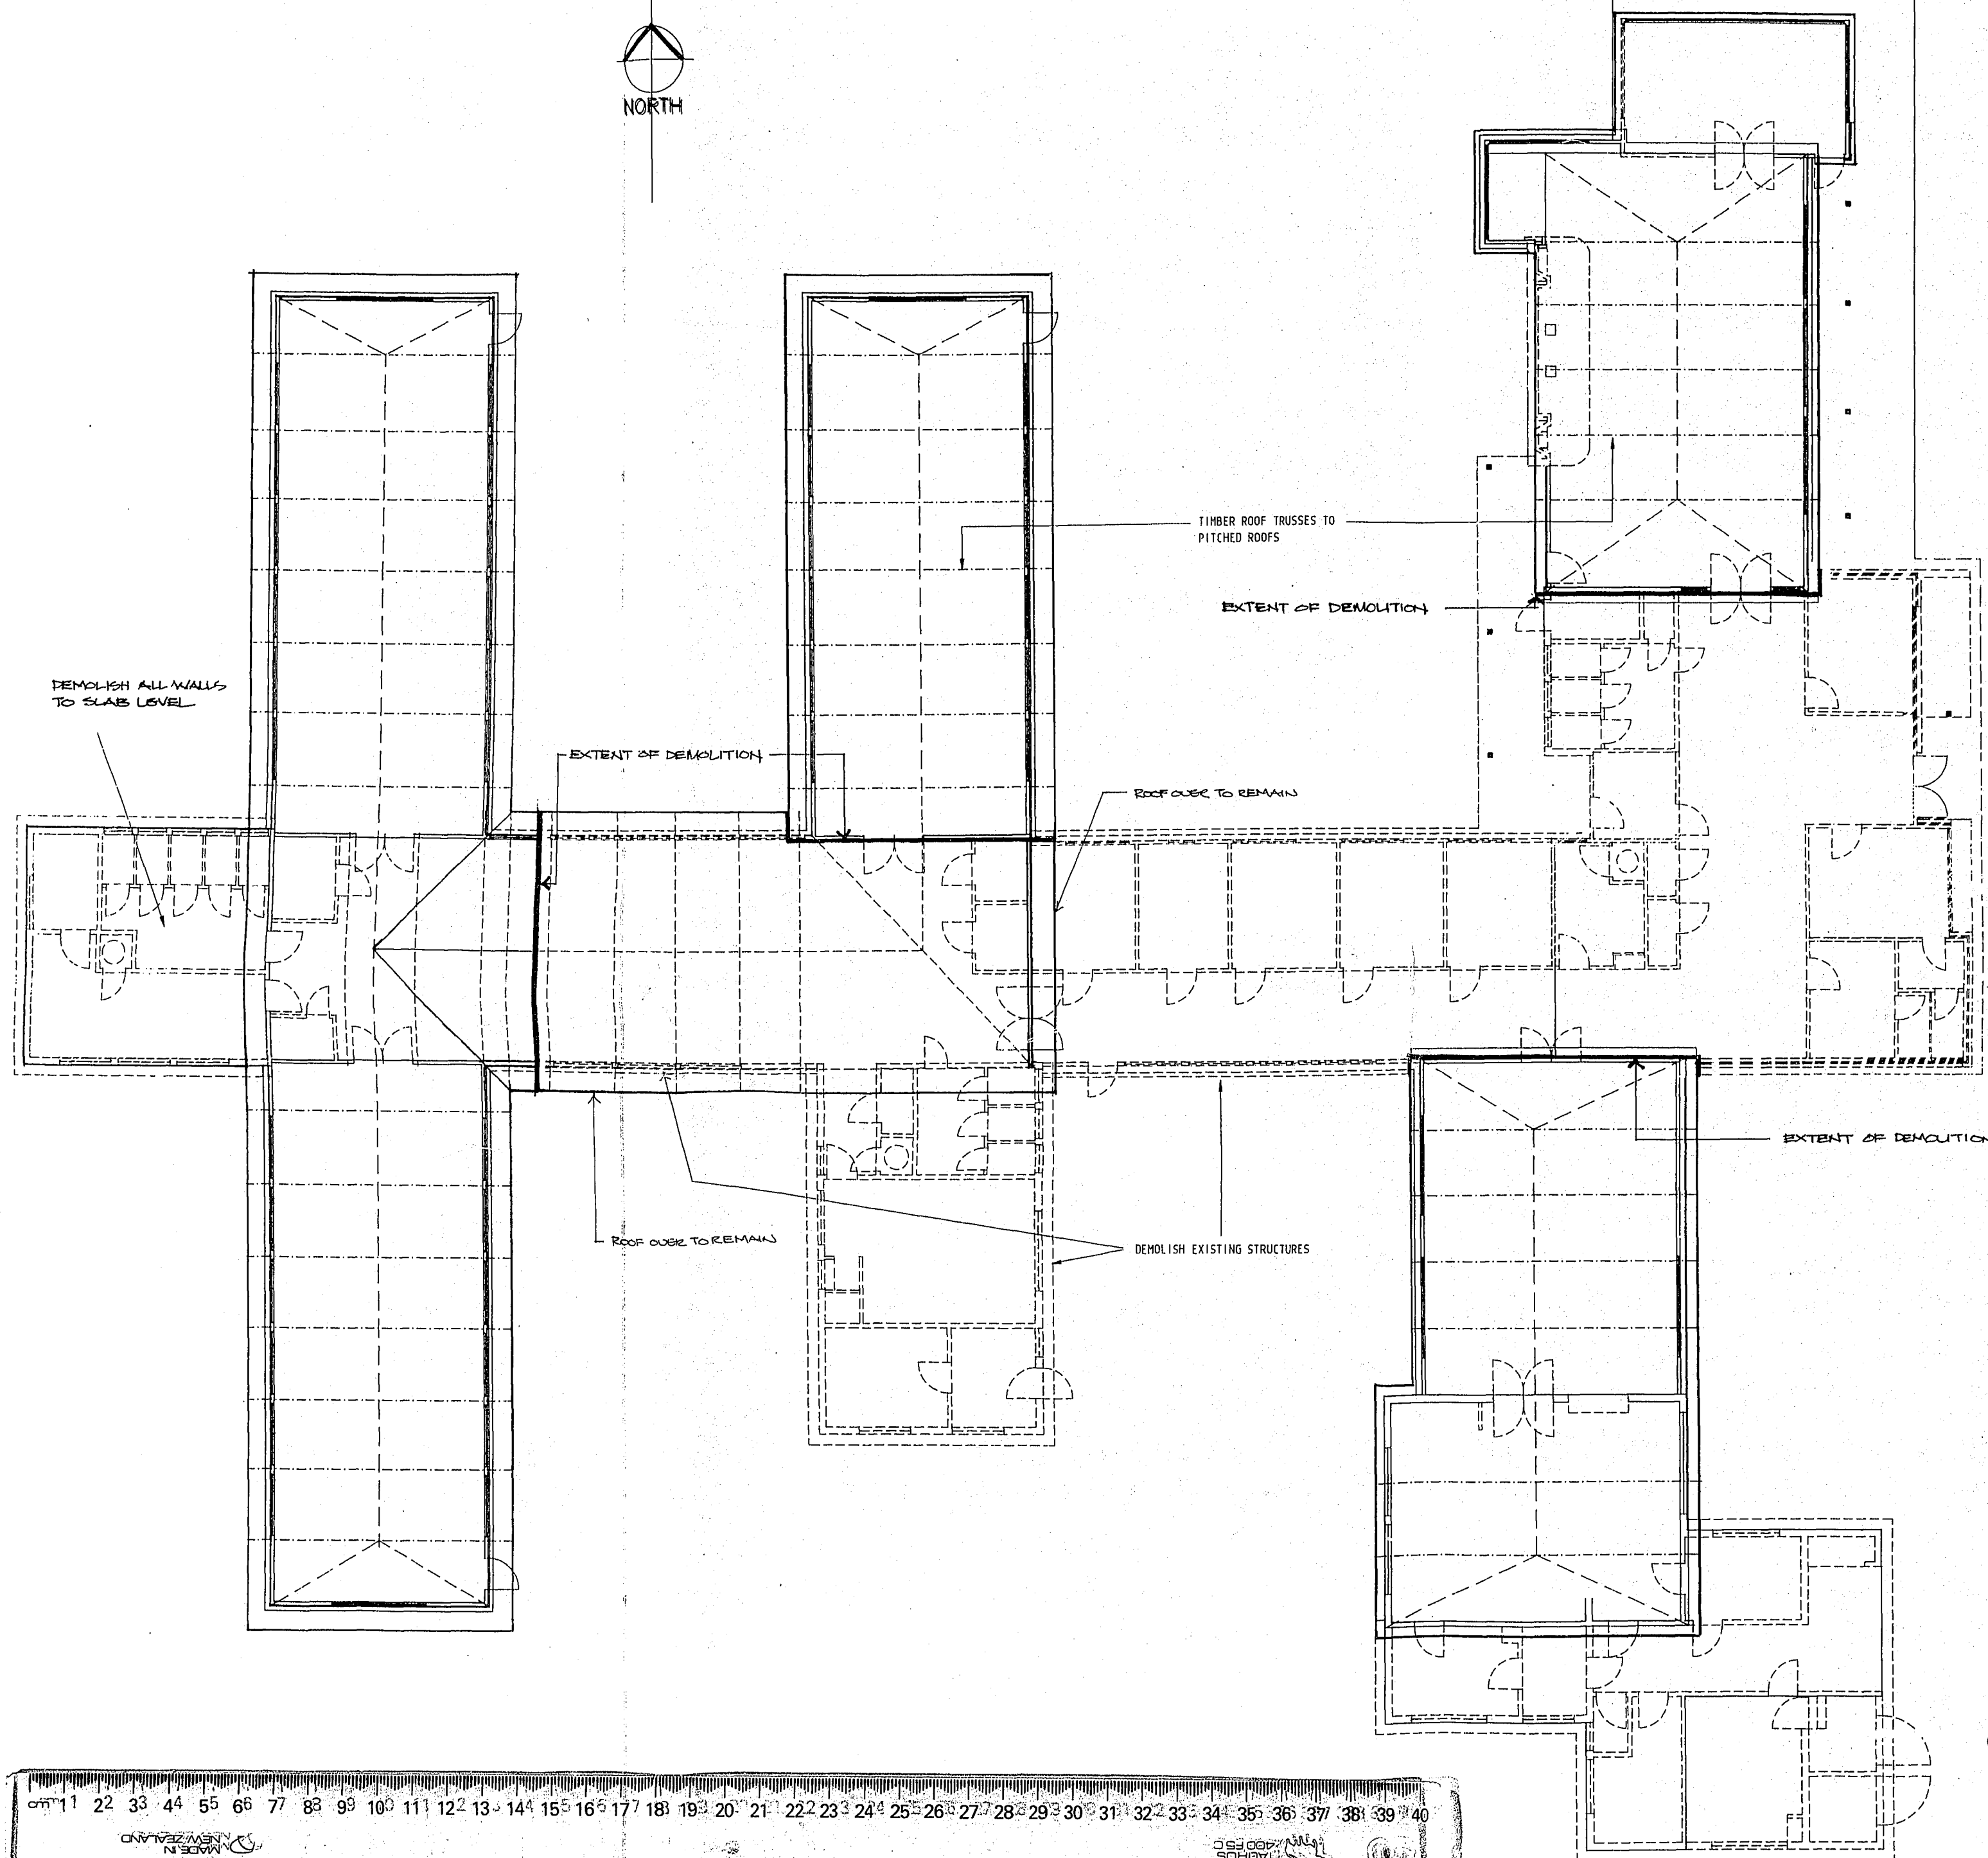

F.B.	Initials	Date	Initials	Date
SURV.			TR.	
DES.			CH.	
DR.	JBH	12/94	APP.	

KARITANE ESTATES LTD

HAWKSURRY VILLAGE

DEMOLITION PLAN
VILLA F

SCALE: 1 : 100


9401 / 2

95/91


0 1 2 3 4 5 6 7 8 9 10 11 12 13 14 15 16 17 18 19 20 21 22 23 24 25 26 27 28 29 30 31 32 33 34 35 36 37 38 39 40

MADE IN NEW ZEALAND

TAHARA 400 FSC

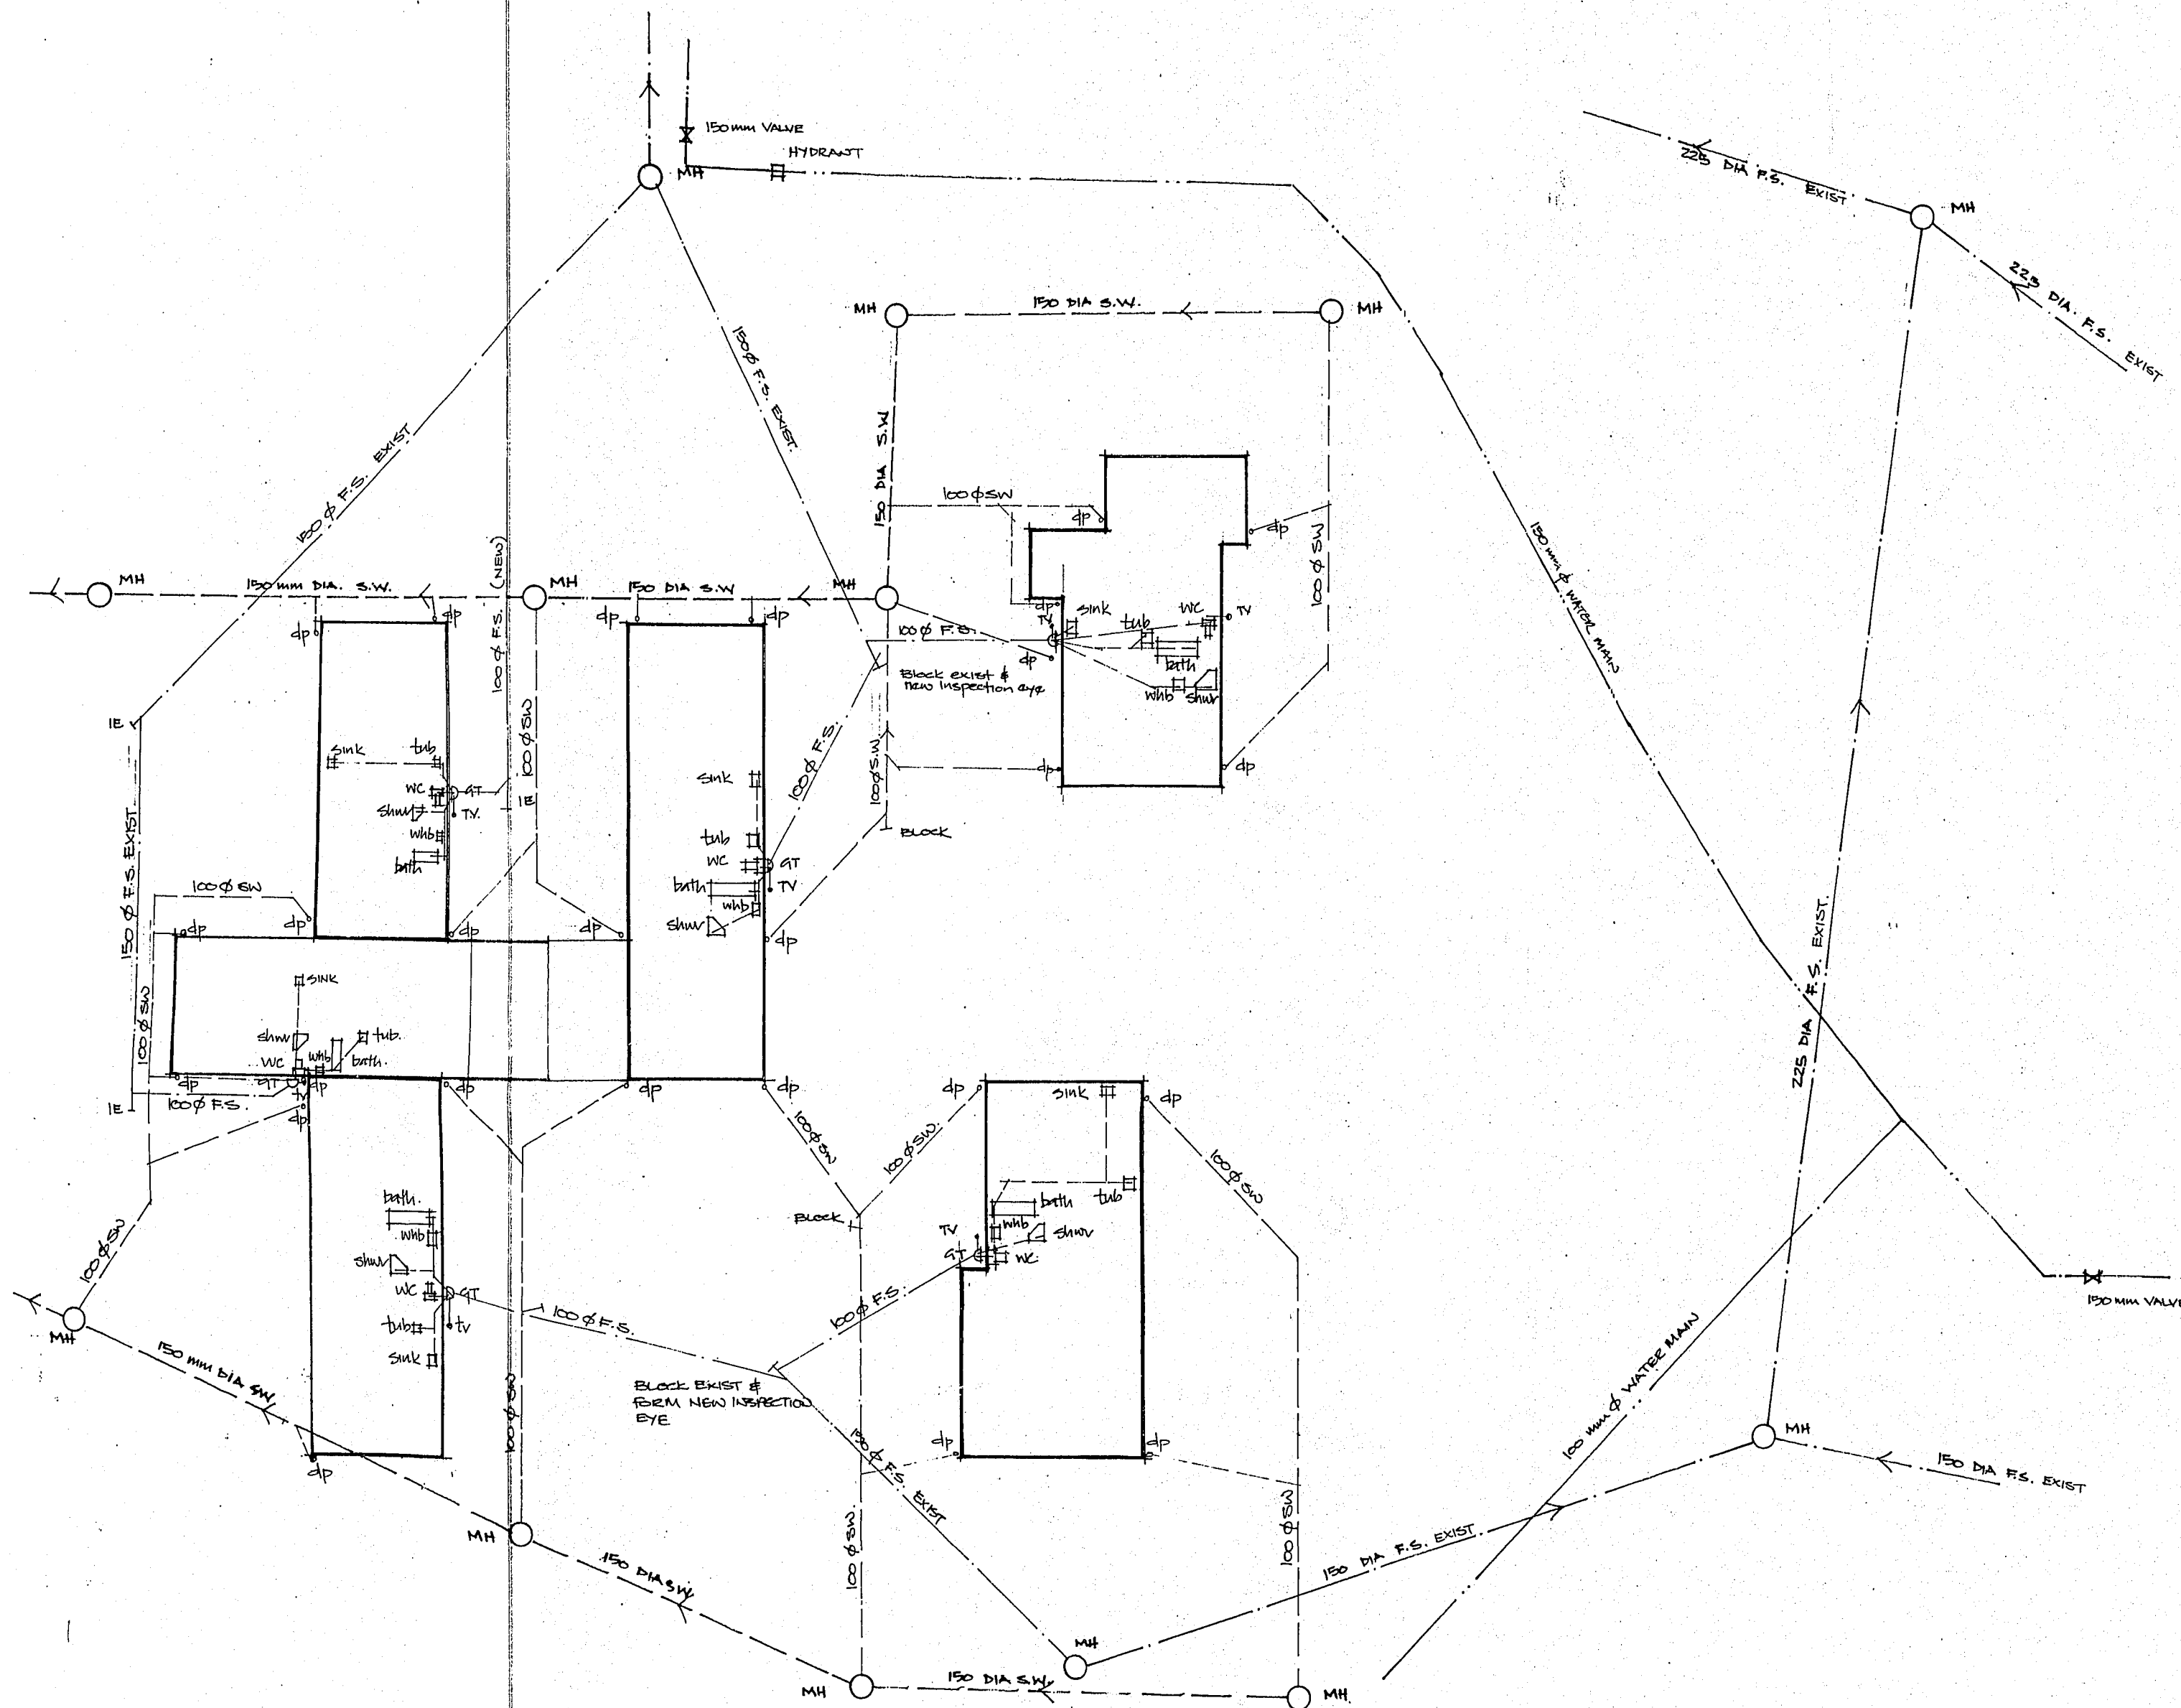

- NOTES
1. ALL NEW DRAINAGE PIPE TO BE UPVC IN SIZES INDICATED
 2. ALL PLUMBING & DRAINAGE SHALL COMPLY WITH THE RELEVANT SECTIONS OF THE NEW ZEALAND BUILDING CODE
 3. ALL DISUSED FOUL SEWER AND STORMWATER CONNECTIONS, SHALL BE BLOCKED OFF
 4. DOWNPIPE CONNECTIONS SHALL BE REUSED WHERE POSSIBLE
 5. EXIST FOUL SEWER AND STORMWATER PIPE SHALL BE REUSED WHERE POSSIBLE

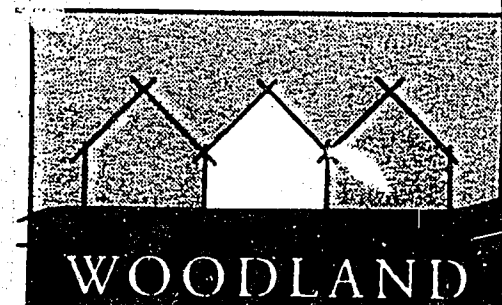

Initials	Date	Initials	Date
SRV		FR	
DSN		CH	
DR	12/94	APP	

CLIENT KARITANE ESTATES LTD

JOB NAME HAWKSURRY VILLAGE



TITLE VILLA F DRAINAGE PLAN

SCALE: NTS.




9401 / 10

95/91

300
200
100
50
20
10
0
ORIGINAL SIZE mm

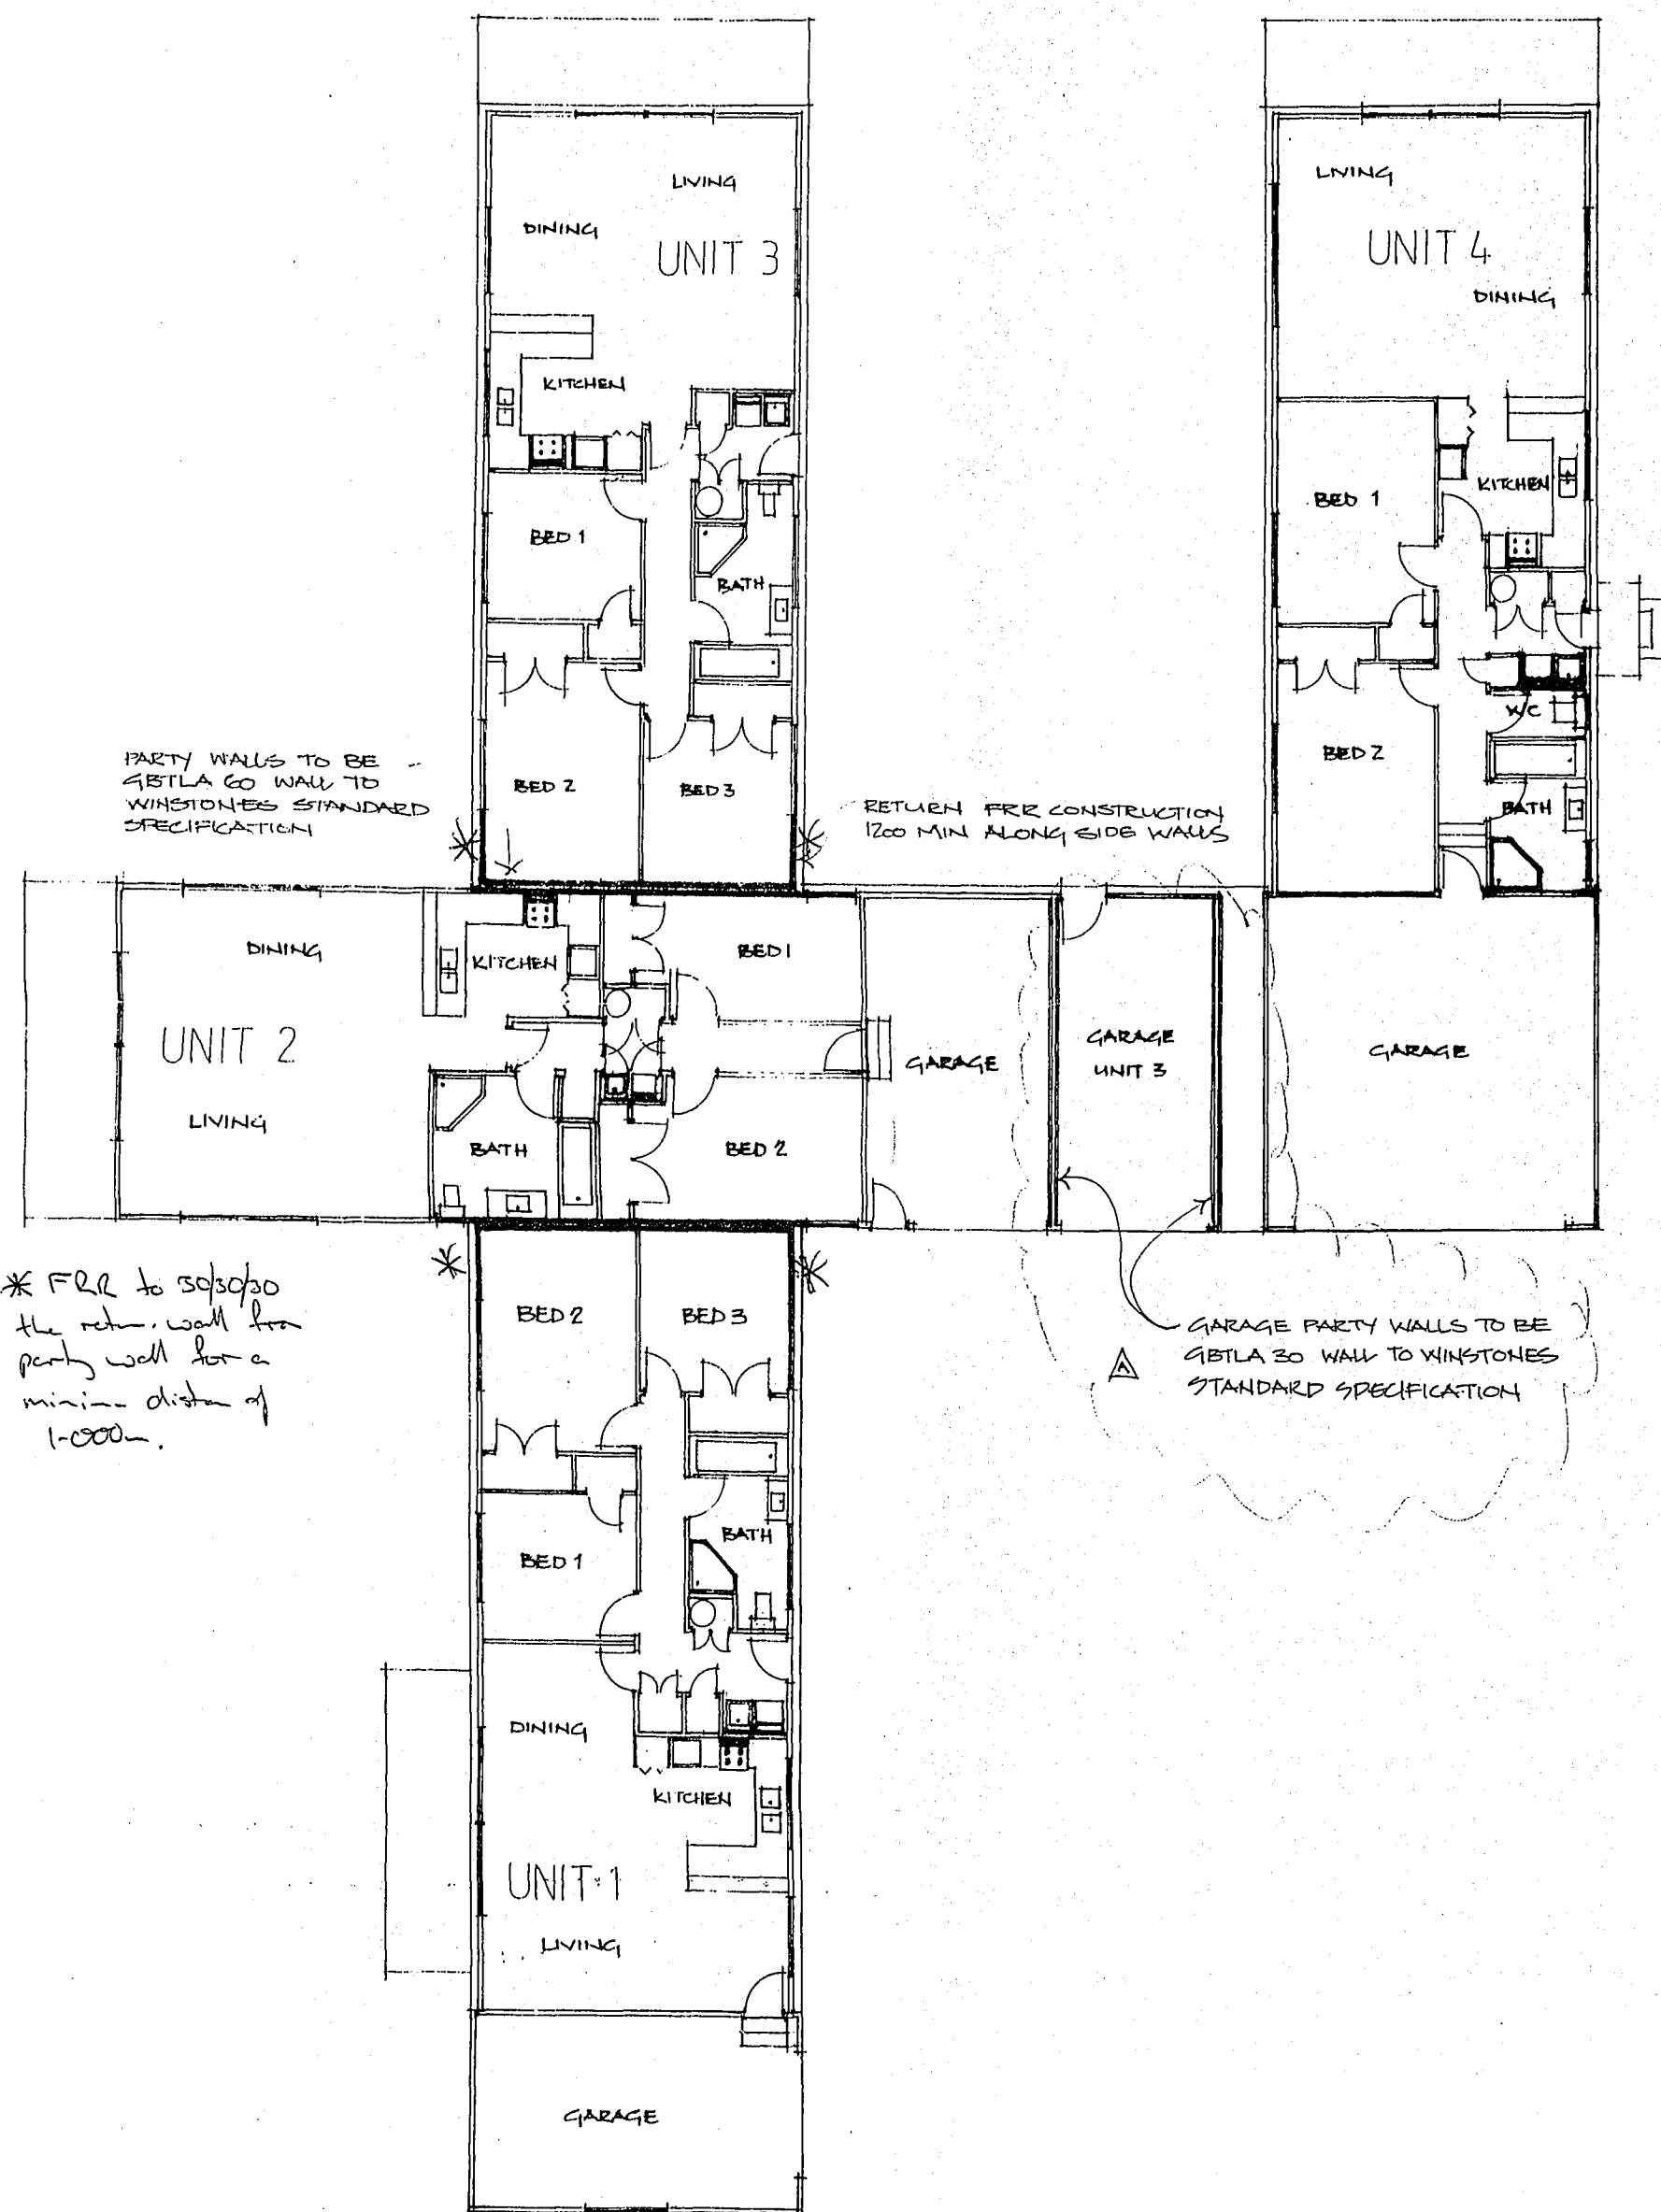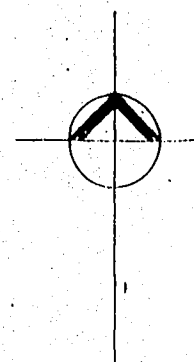

* FR to sqsqso
the reh. wall from
party wall for a
minim distn of
1-000m.

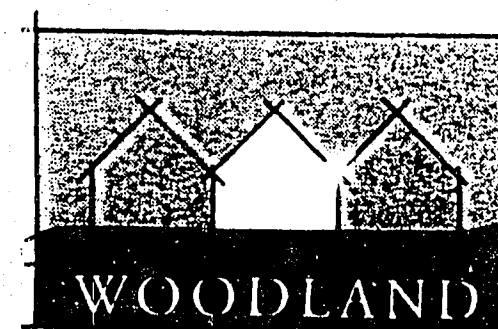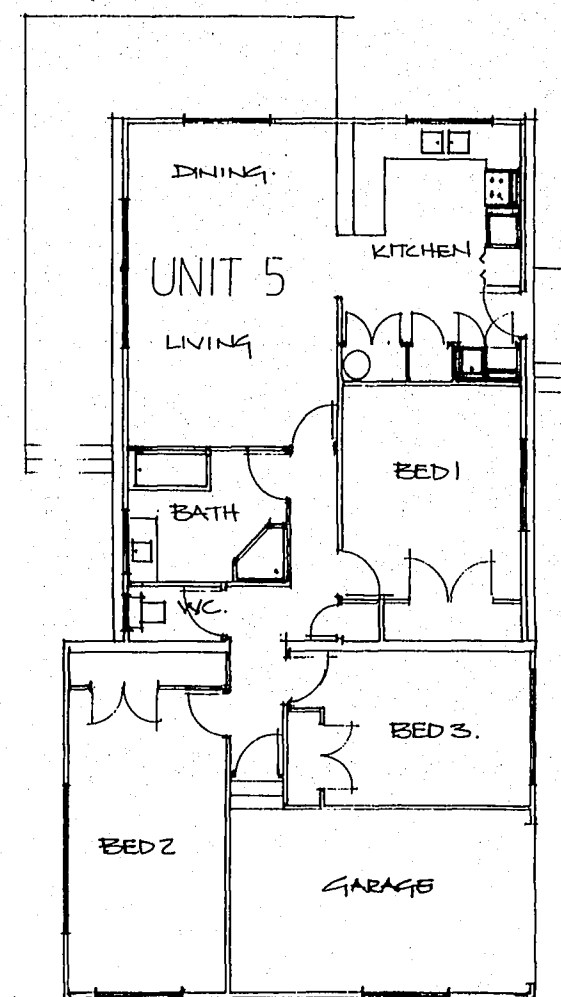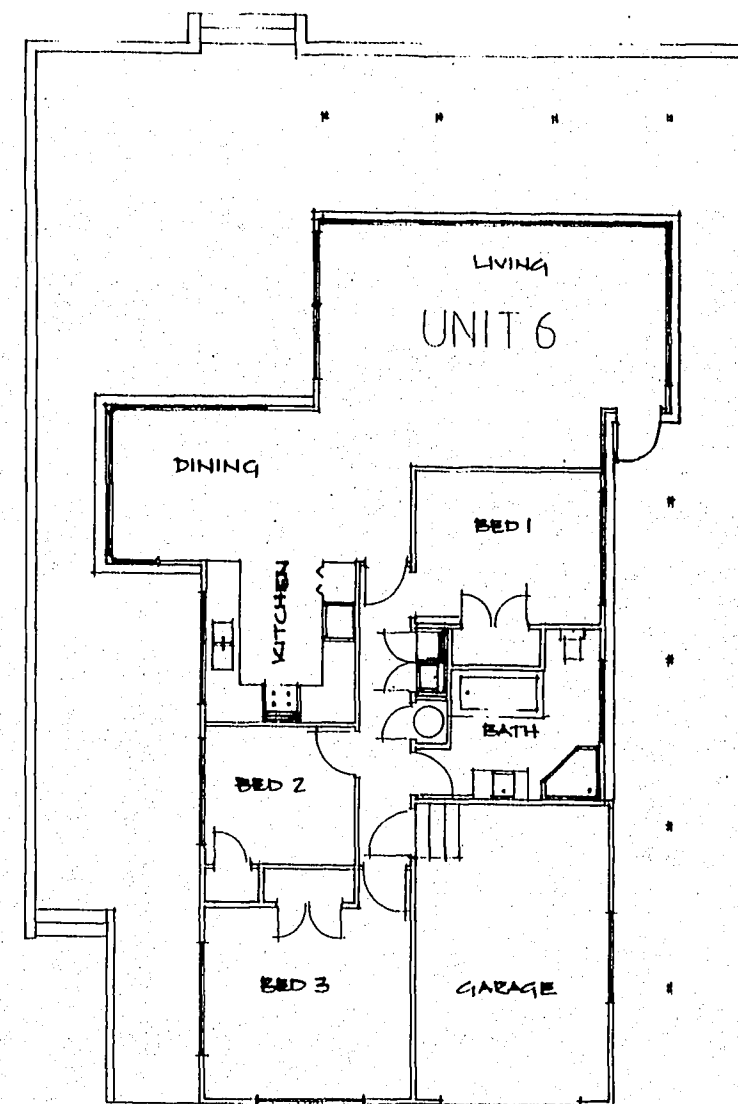

REV. A FIRE WALLS TO UNIT 3 GARAGE

FD	12/94
OGN	12/94
DR	12/94

KARITANE ESTATES LTD

HAWKS BURY VILLAGE


FLOOR PLANS






SCALE 1:100

9401 / 4 A

95/91

Amended Plan and/or
Specification Received
By 24/5/05
Date 24/5/05

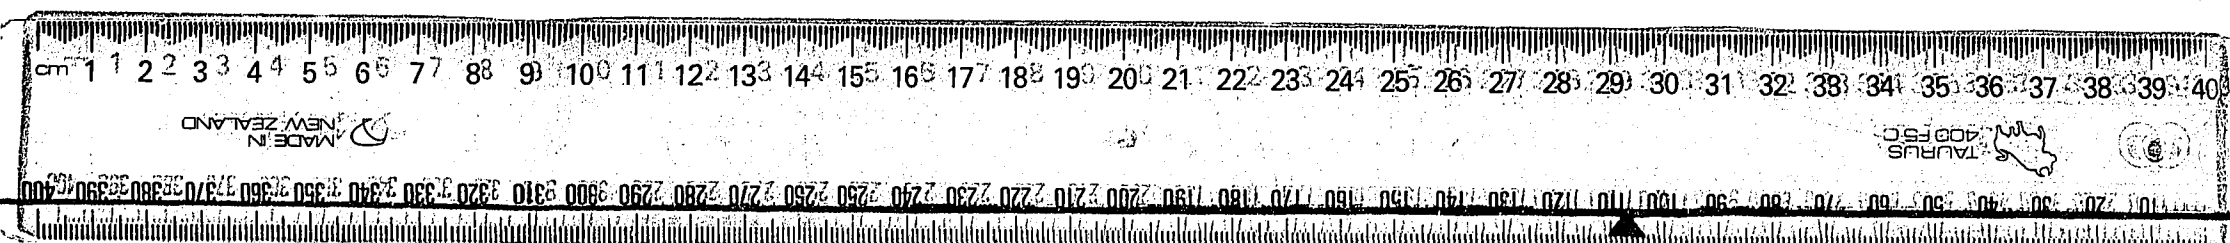

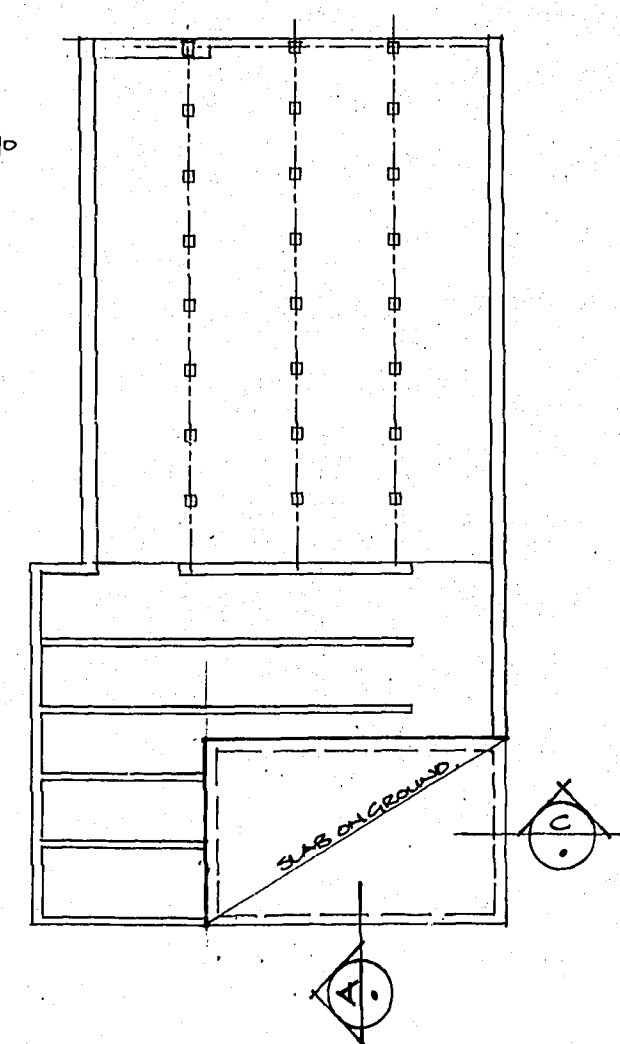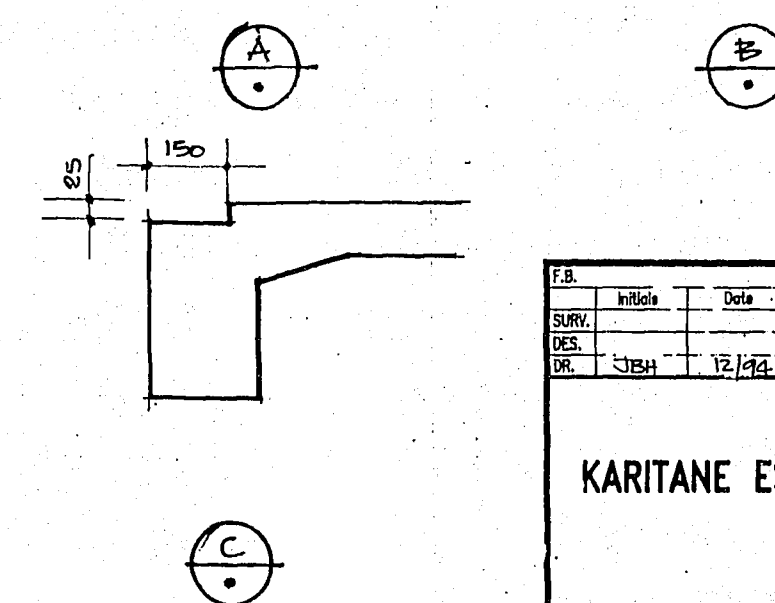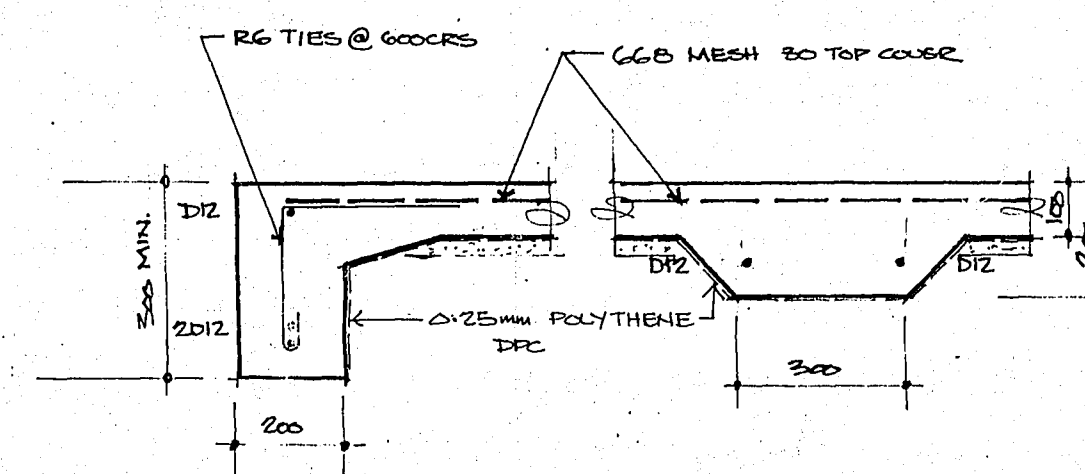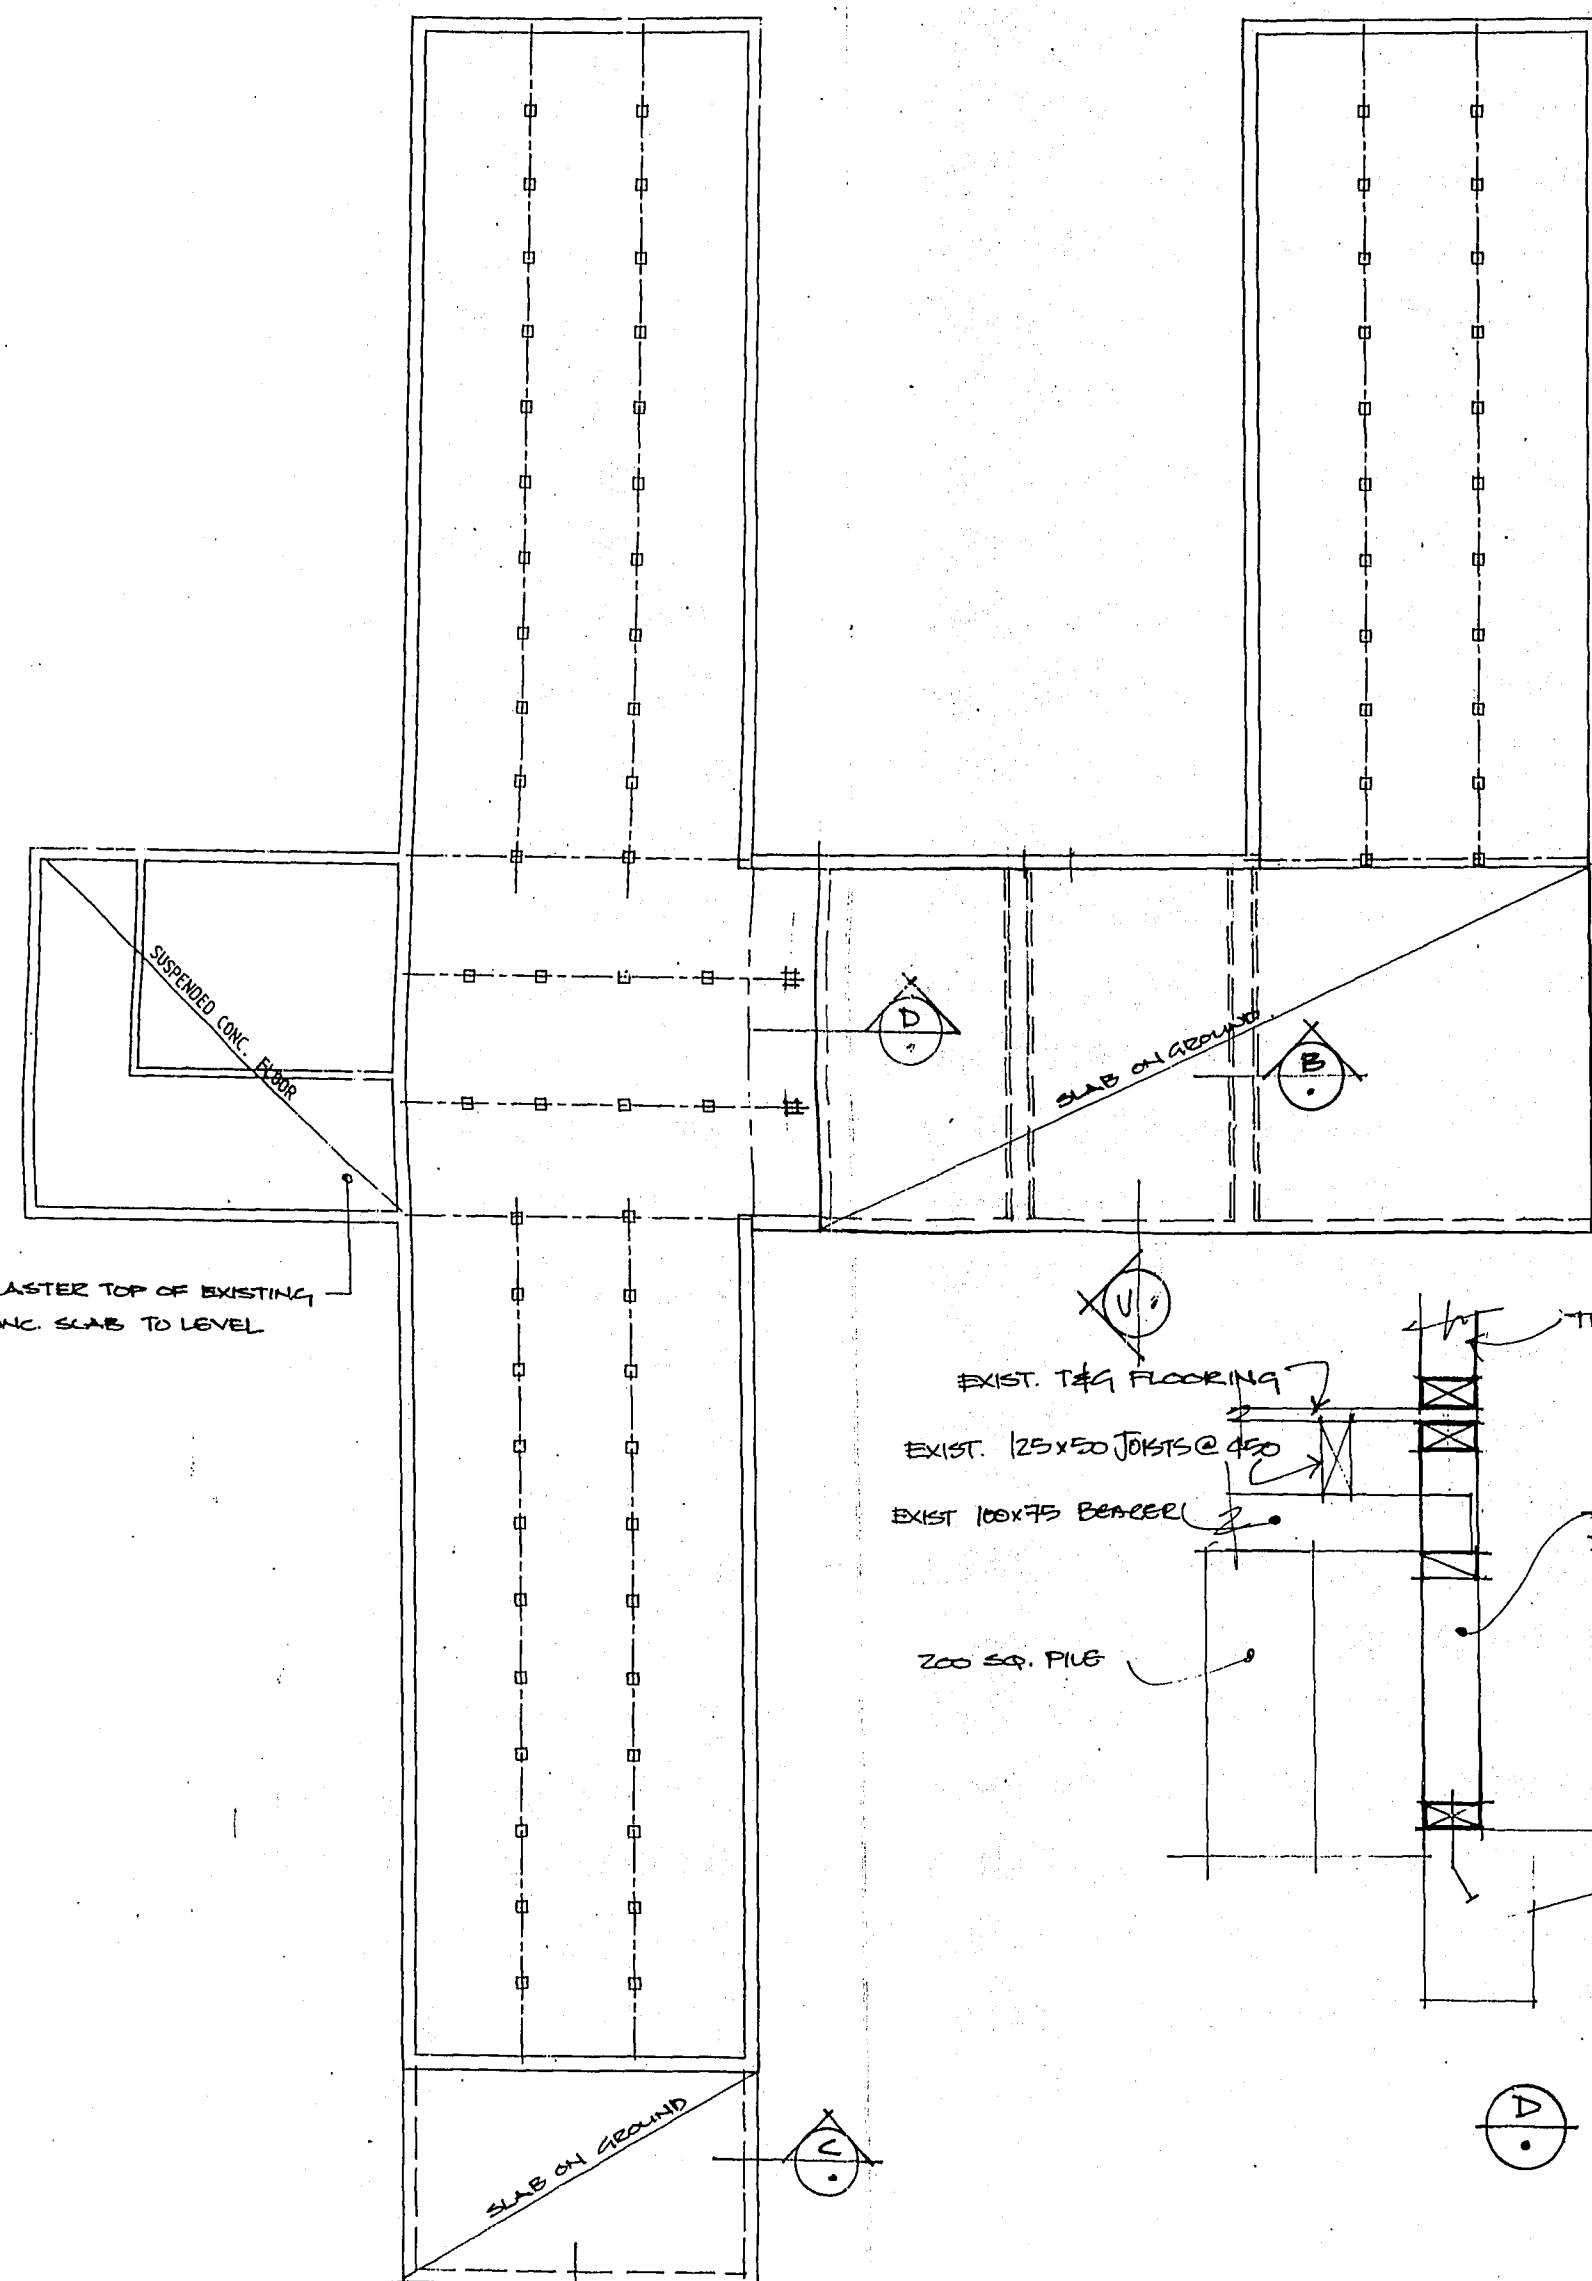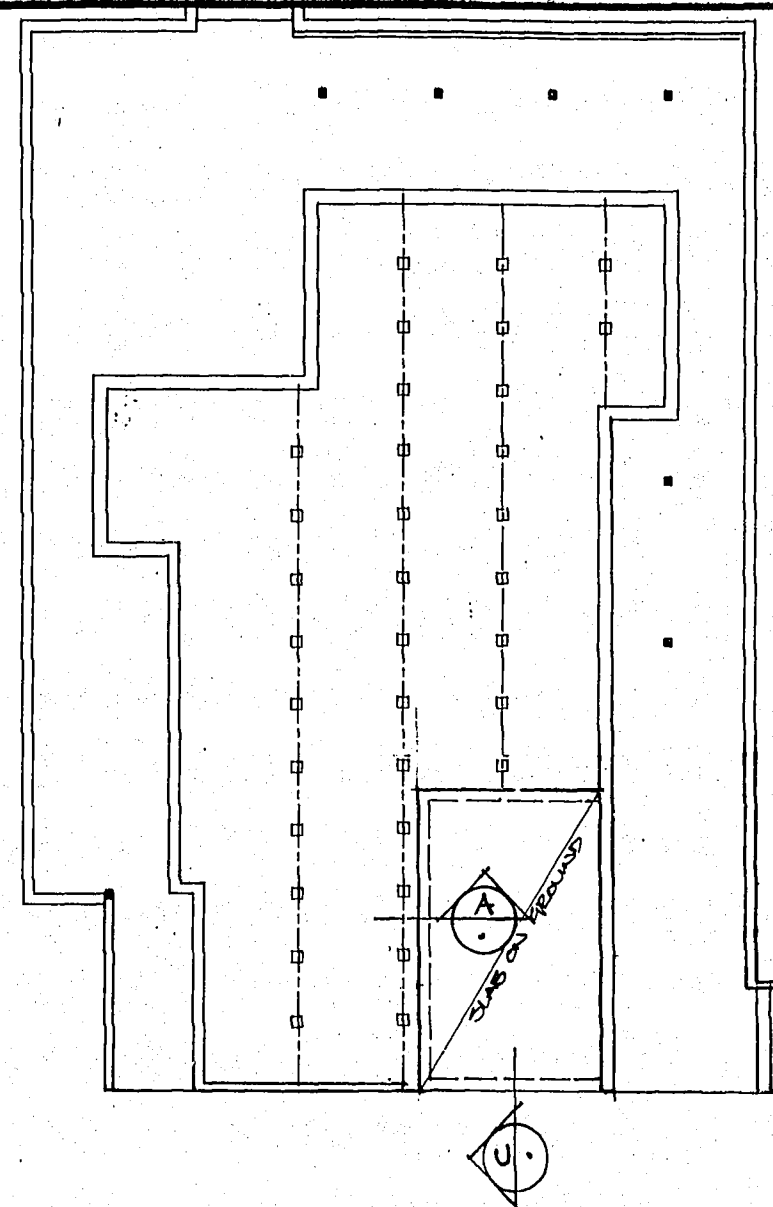


95/91


F.B.					
	Initials	Date		Initials	Date
SURY.			TR.	AutoCAD 11	10/93
DES.			CH.		
DR.	JBH	12/94	APF.		

FOUNDATION
PLAN

9401 / 3


FOUNDATION PLAN
1:100

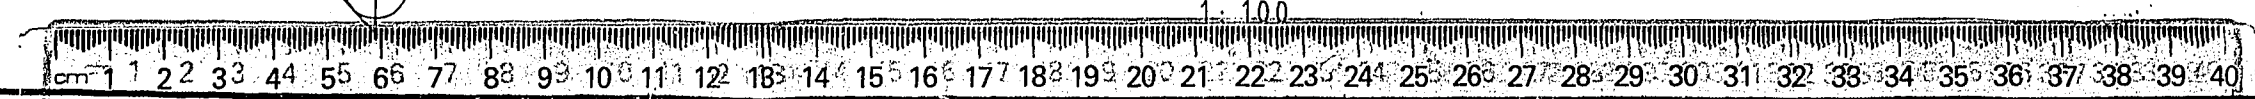

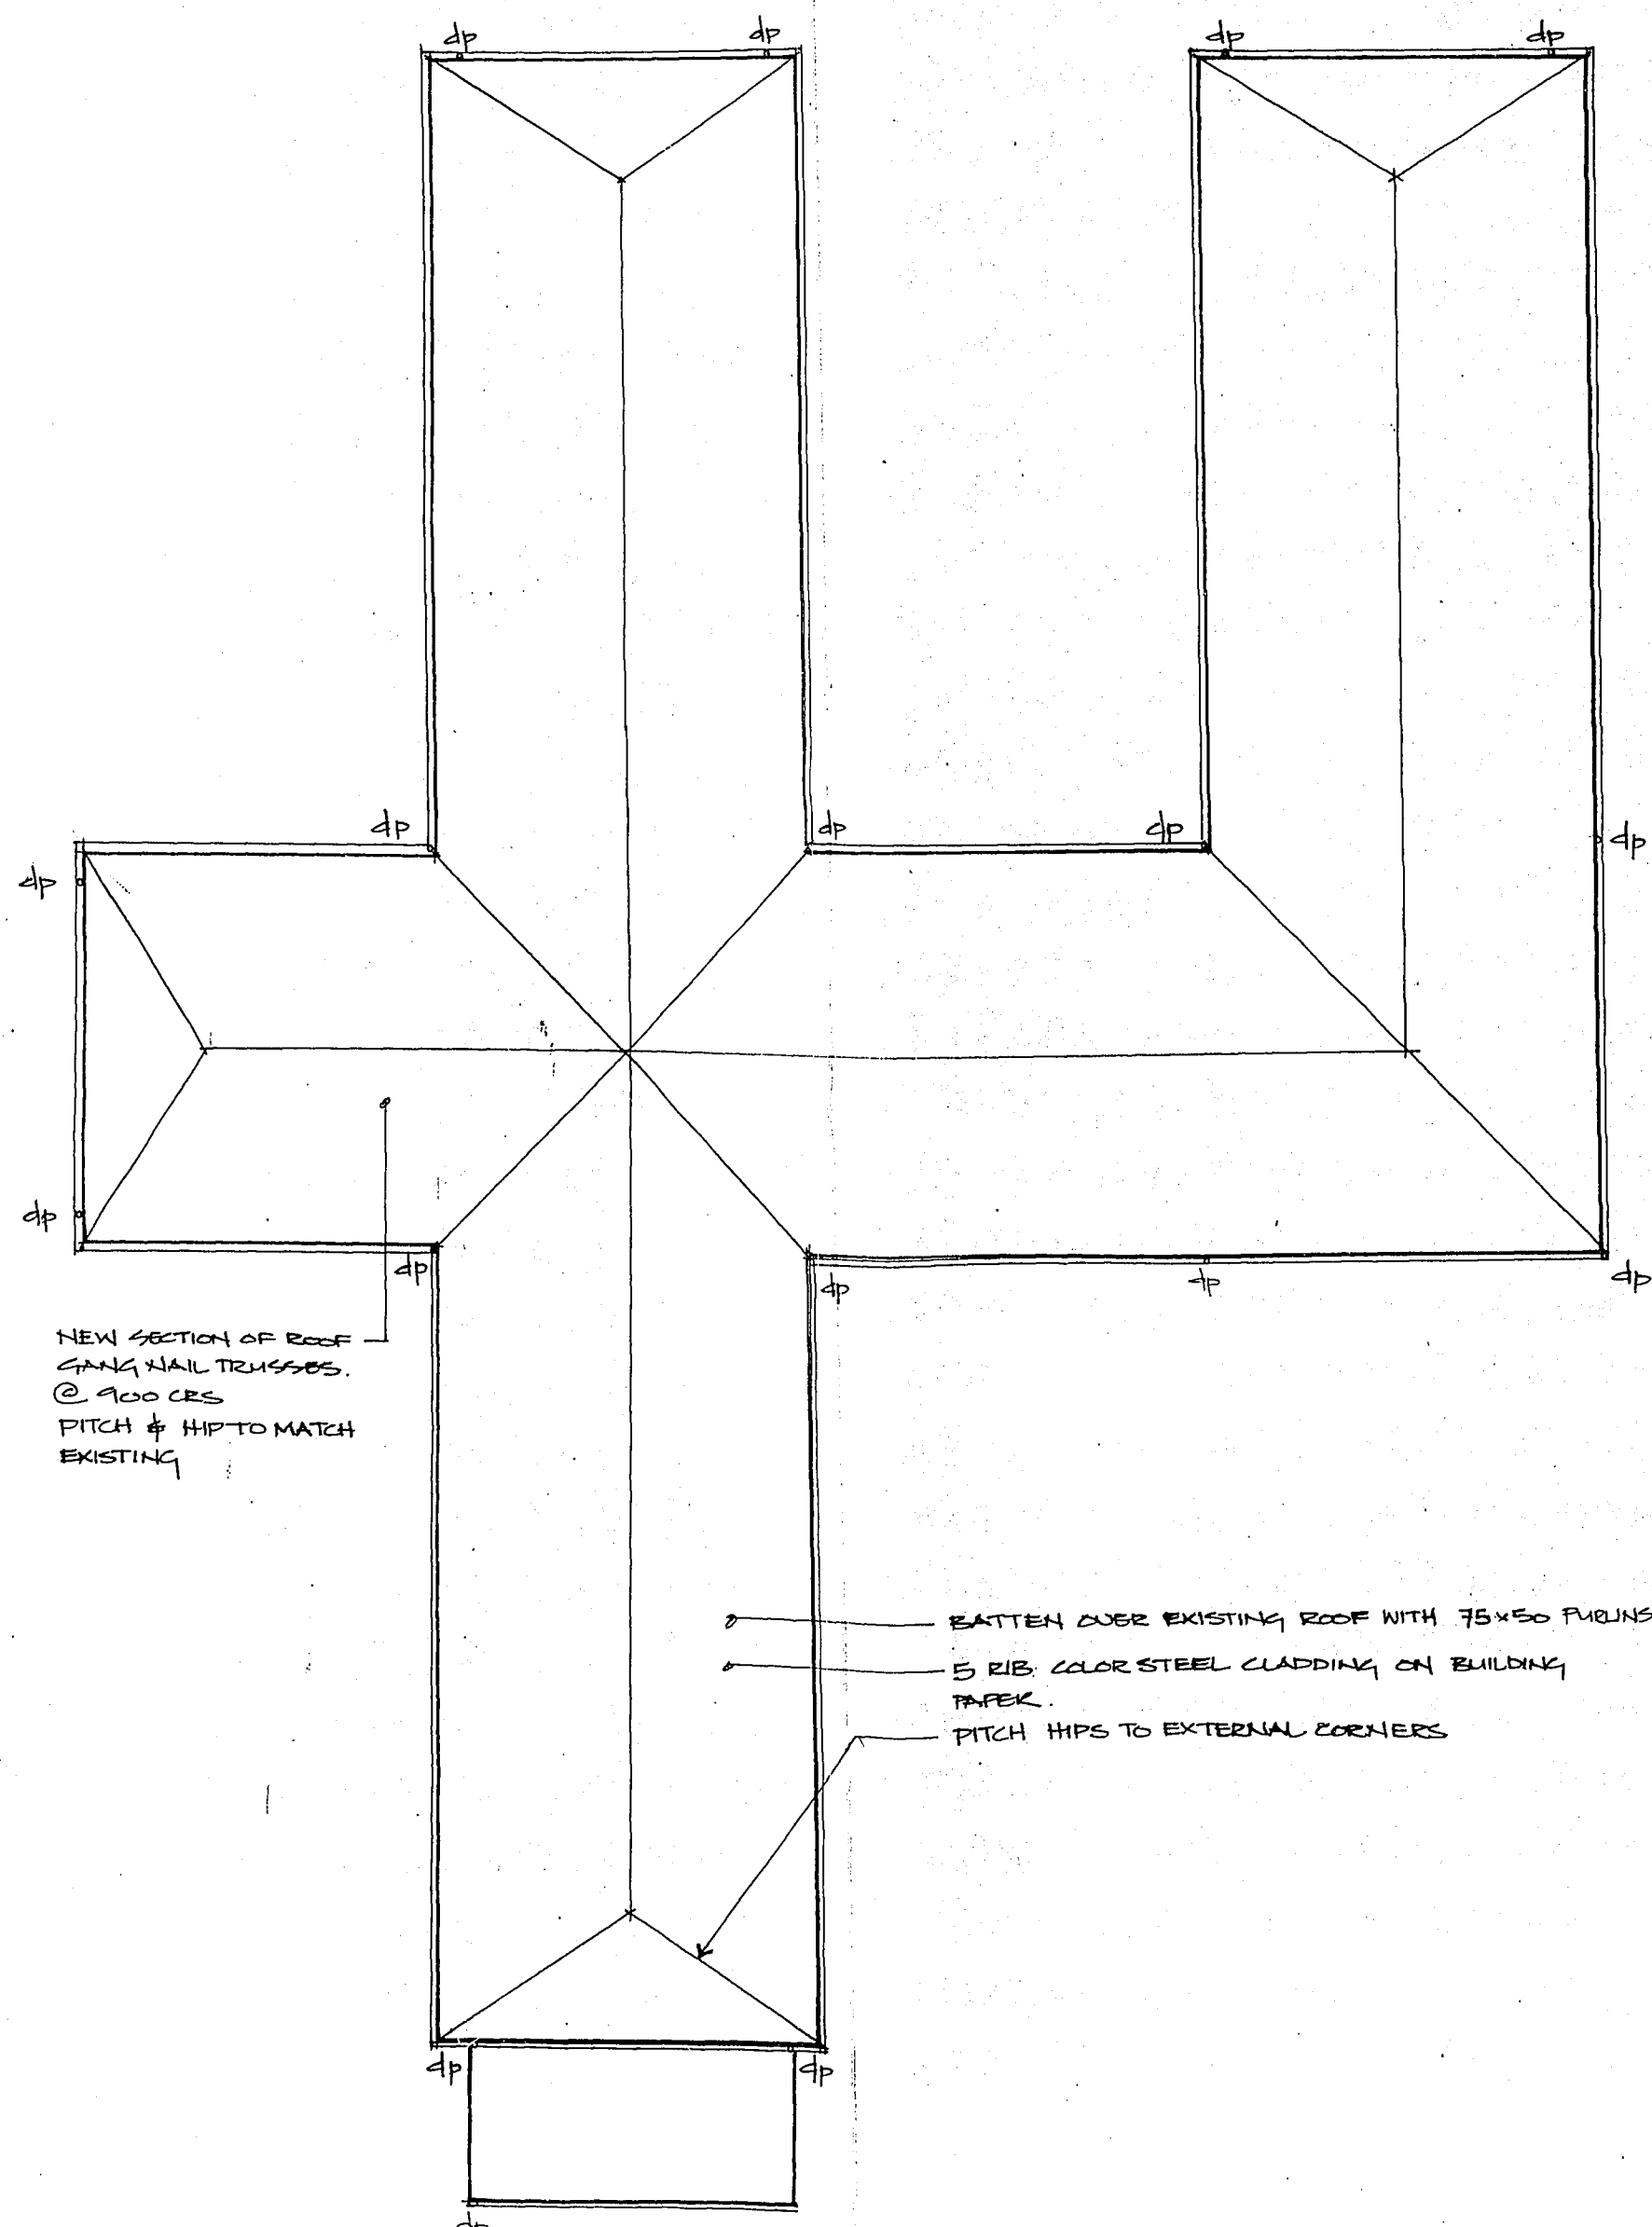


NEW SECTION OF ROOF -
GANG NAIL TRUSSES.
@ 900 CRS
PITCH & HIPS TO MATCH
EXISTING

BATTEN OVER EXISTING ROOF WITH 75x50 FURLINS @ 900 CRS.
5 RIB COLOR STEEL CLADDING ON BUILDING
PAPER.
PITCH HIPS TO EXTERNAL CORNERS

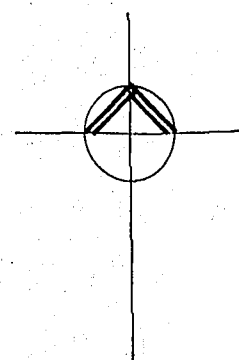


FRAME NEW SECTION OF ROOF
OVER EXISTING FLAT ROOF

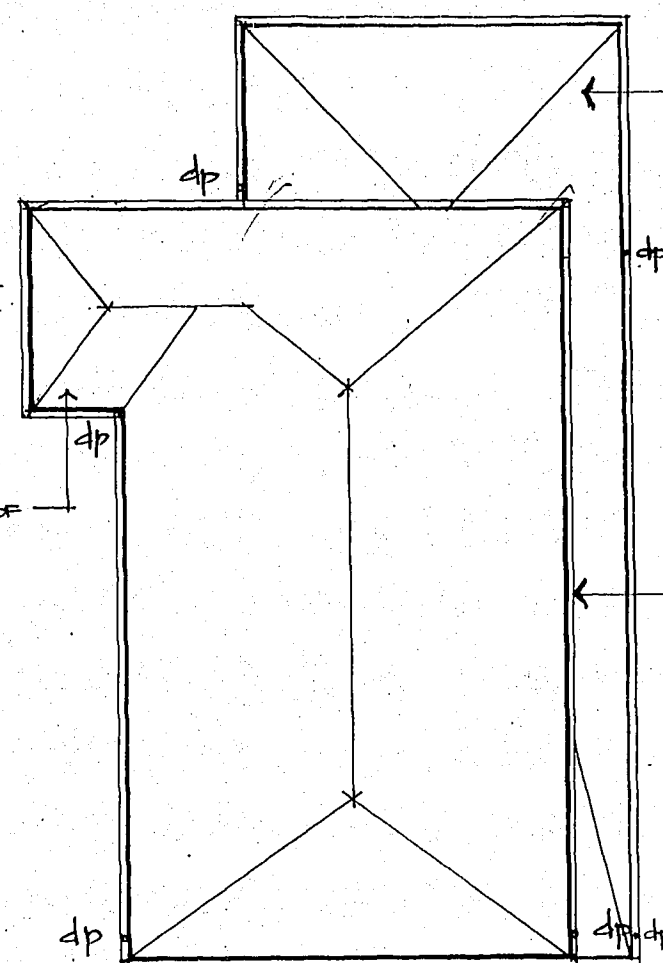


FRAME NEW SECTION OF ROOF OVER EXISTING
FLAT ROOF & VERANDA

NEW MARLEY PVC GUTTERS & DOWN PIPES
ALL ROUND - TYPICAL ALL ROOFS.

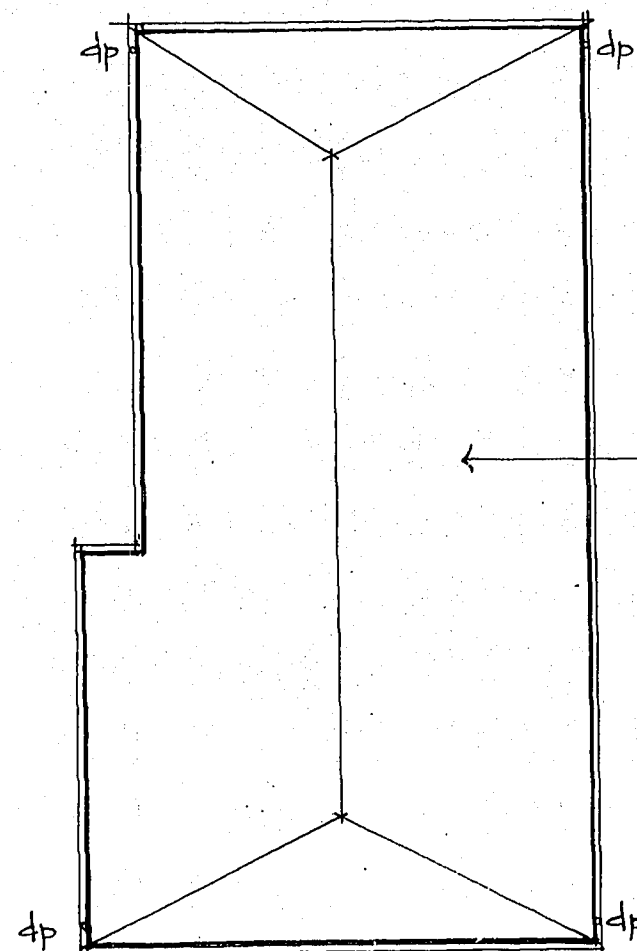

NEW 5 RIB COLOR STEEL CLADDING
ON BUILDING PAPER ON 75x50 FURLINS @ 900 CRS
FIXED TO EXISTING SARKING

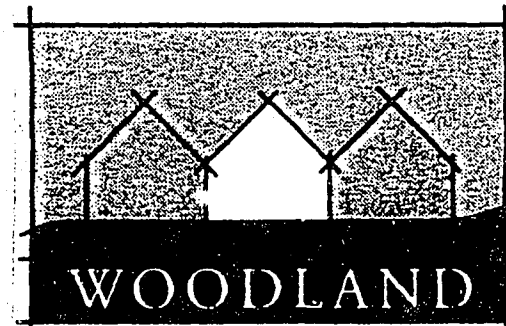

F.B.		Initials	Date	TR	Initials	Date
SURV.	DGN.			CH		
DR.	JEB		12/94	APP.		

KARITANE ESTATES
LTD


HAWKS BURY
VILLAGE

ROOF PLAN



SCALE: 1:100

9401 / 5

95/91

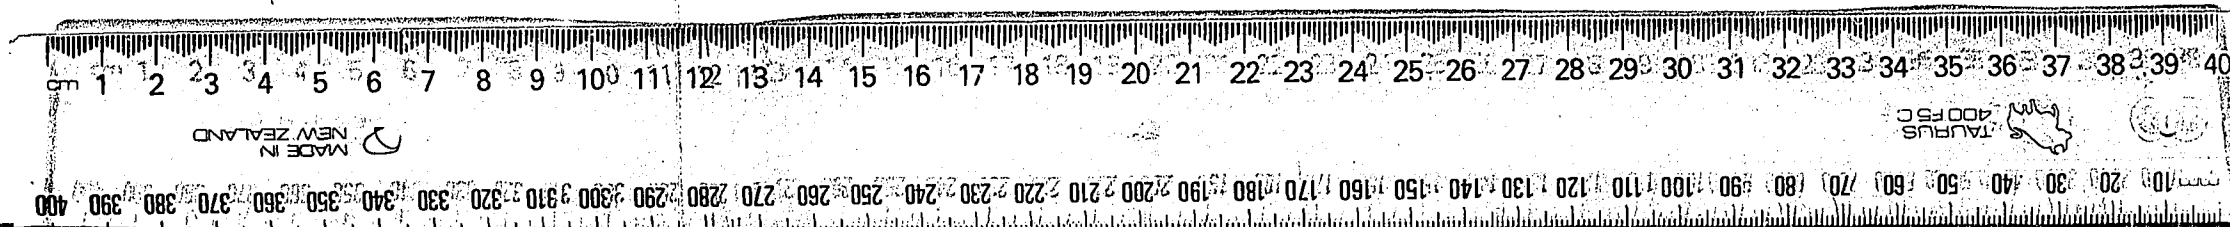

ORIGINAL SIZE mm 0 10 20 30 40 50 60 70 80 90 100 110 120 130 140 150 160 170 180 190 200 210 220 230 240 250 260 270 280 290 300

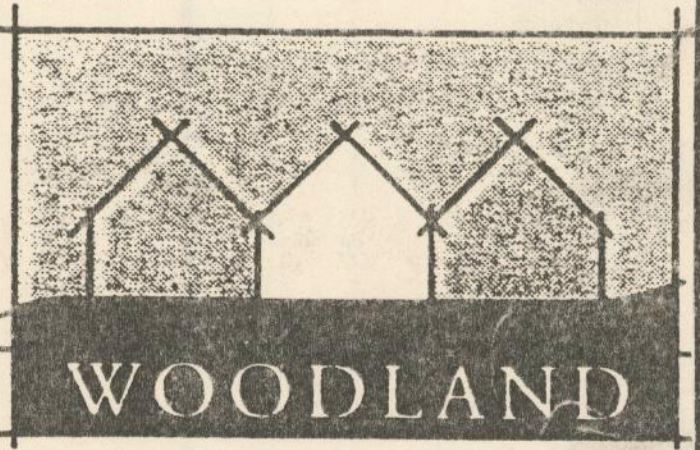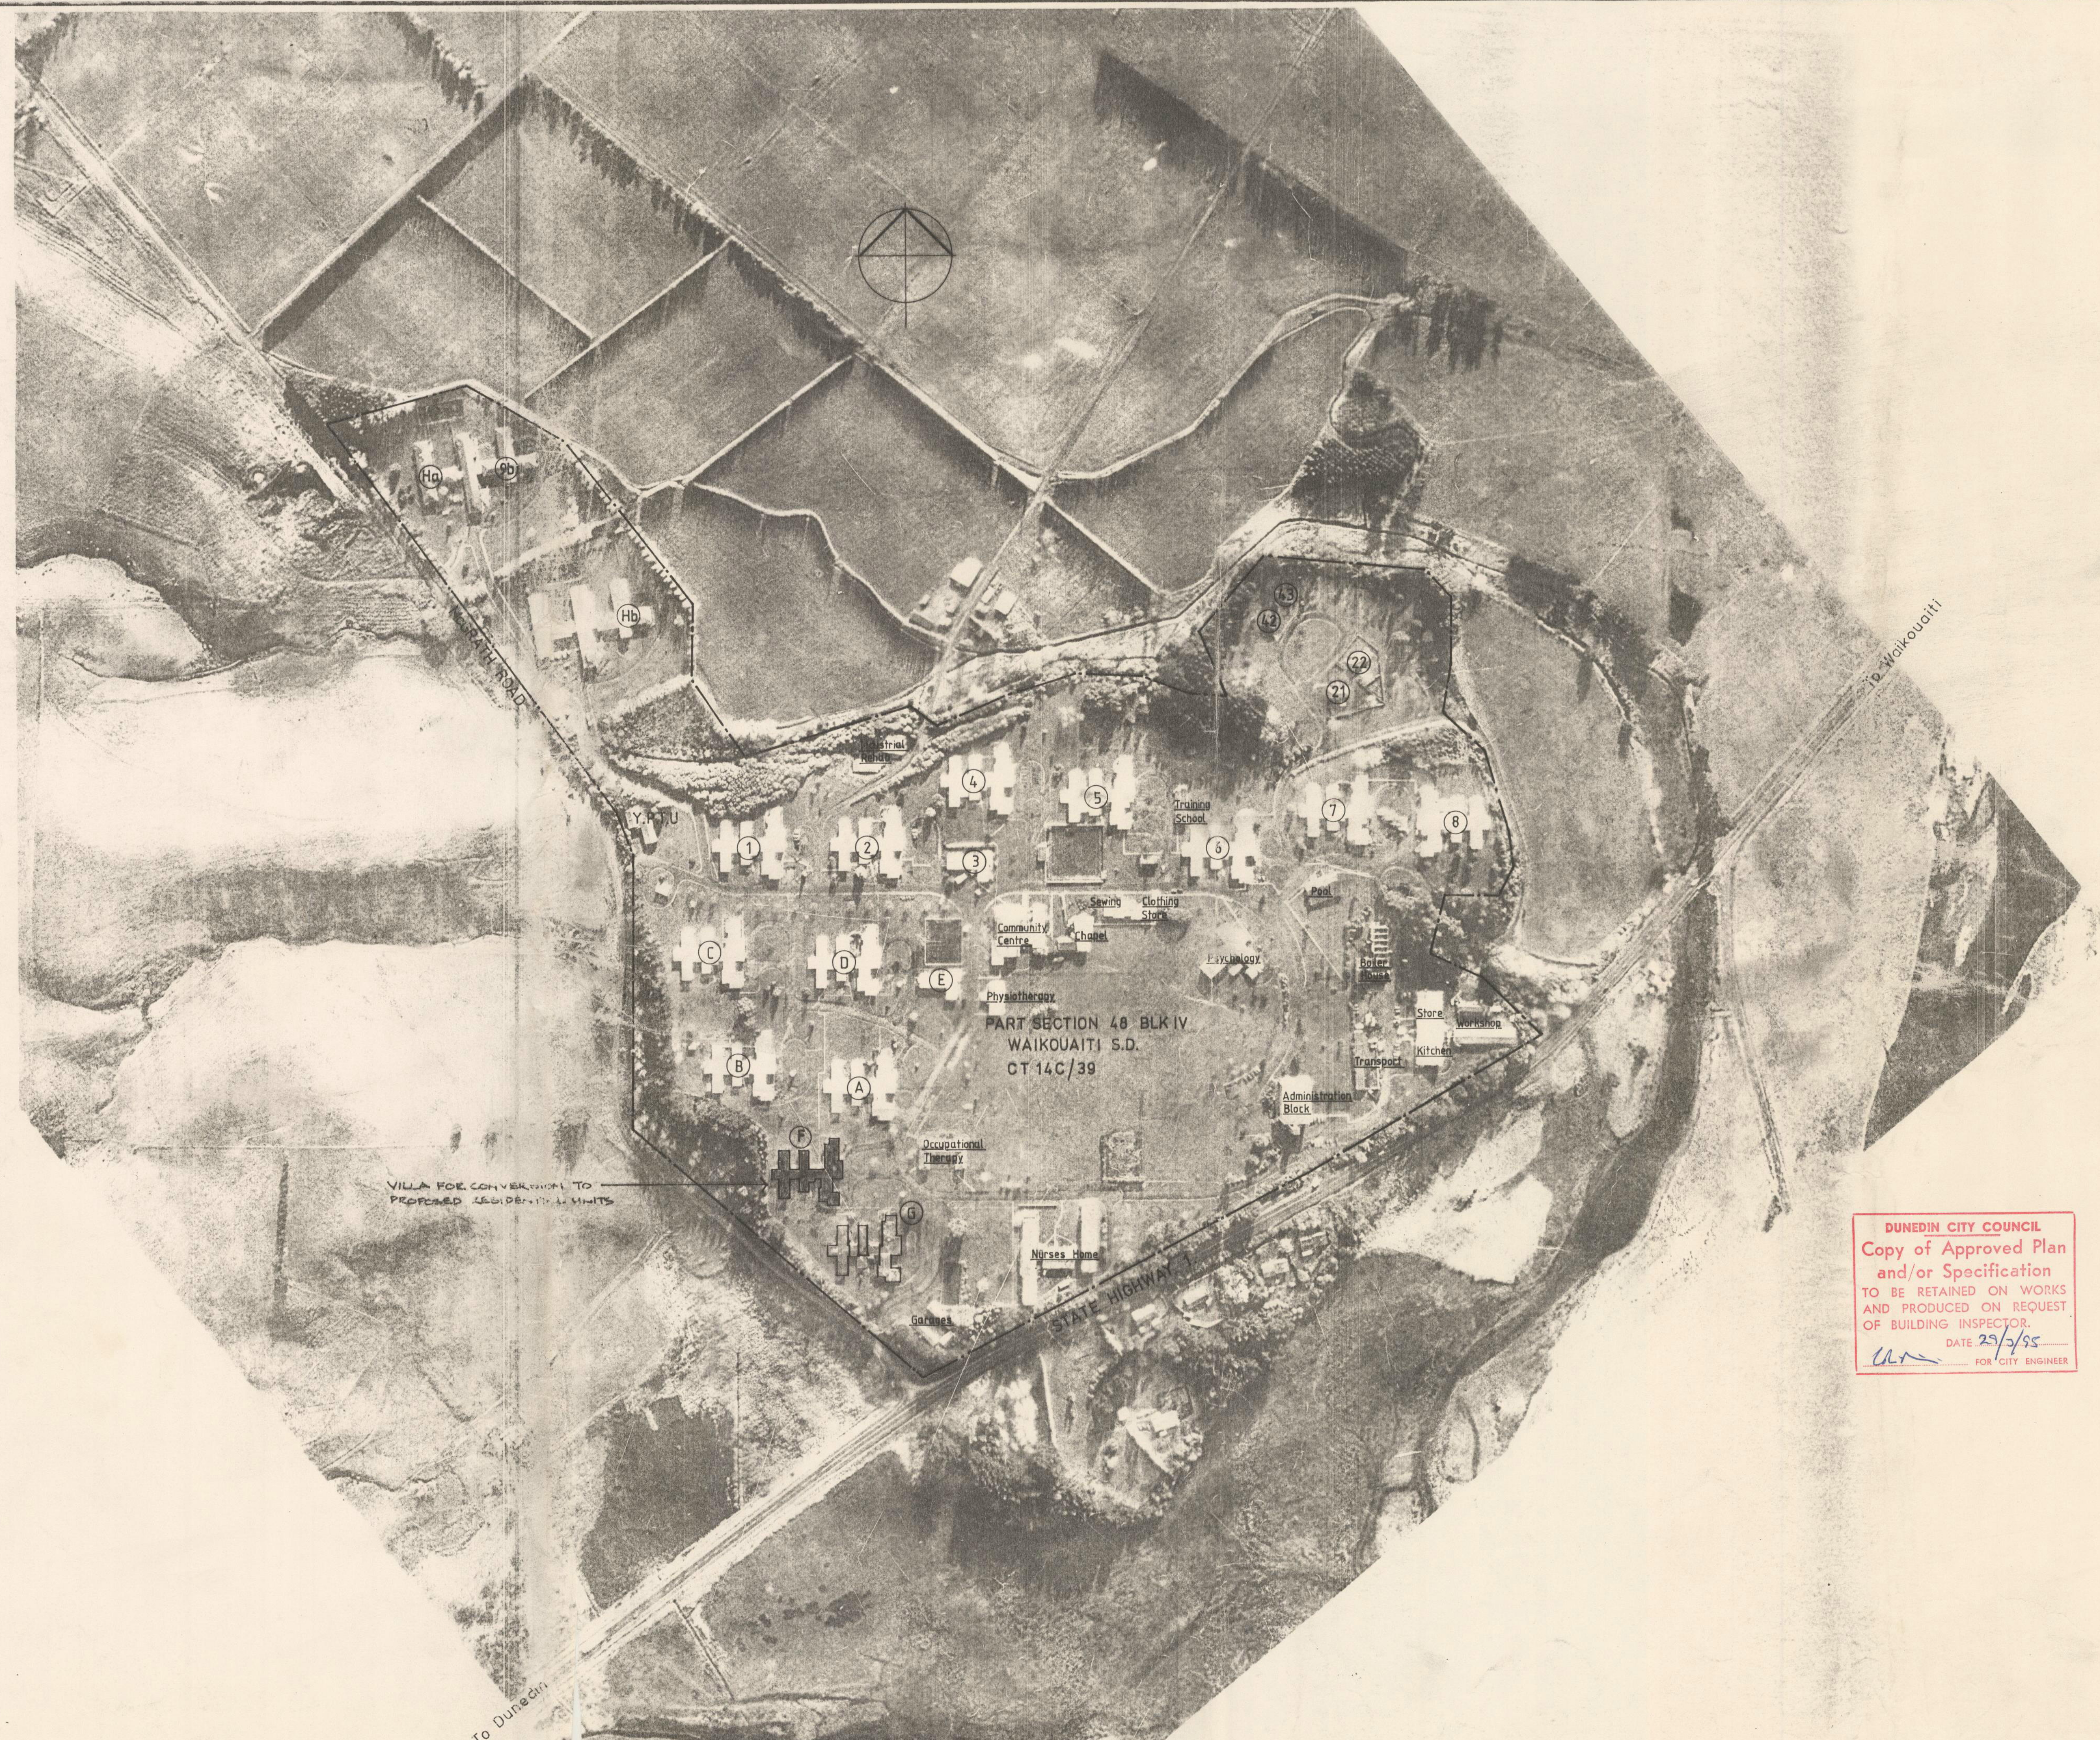

DUNEDIN CITY COUNCIL
Copy of Approved Plan
and/or Specification
TO BE RETAINED ON WORKS
AND PRODUCED ON REQUEST
OF BUILDING INSPECTOR.
DATE 23/3/95
FOR CITY ENGINEER

F.B.	Initials	Date	Initials	Date
SURV			TR	
DGN	CH	12/94	CH	
DR			APP	


CLIENT KARITANE ESTATES LTD

JOB NAME HAWKSBUARY VILLAGE







TITLE SITE PLAN

SCALE 1 : 2500

95/0091

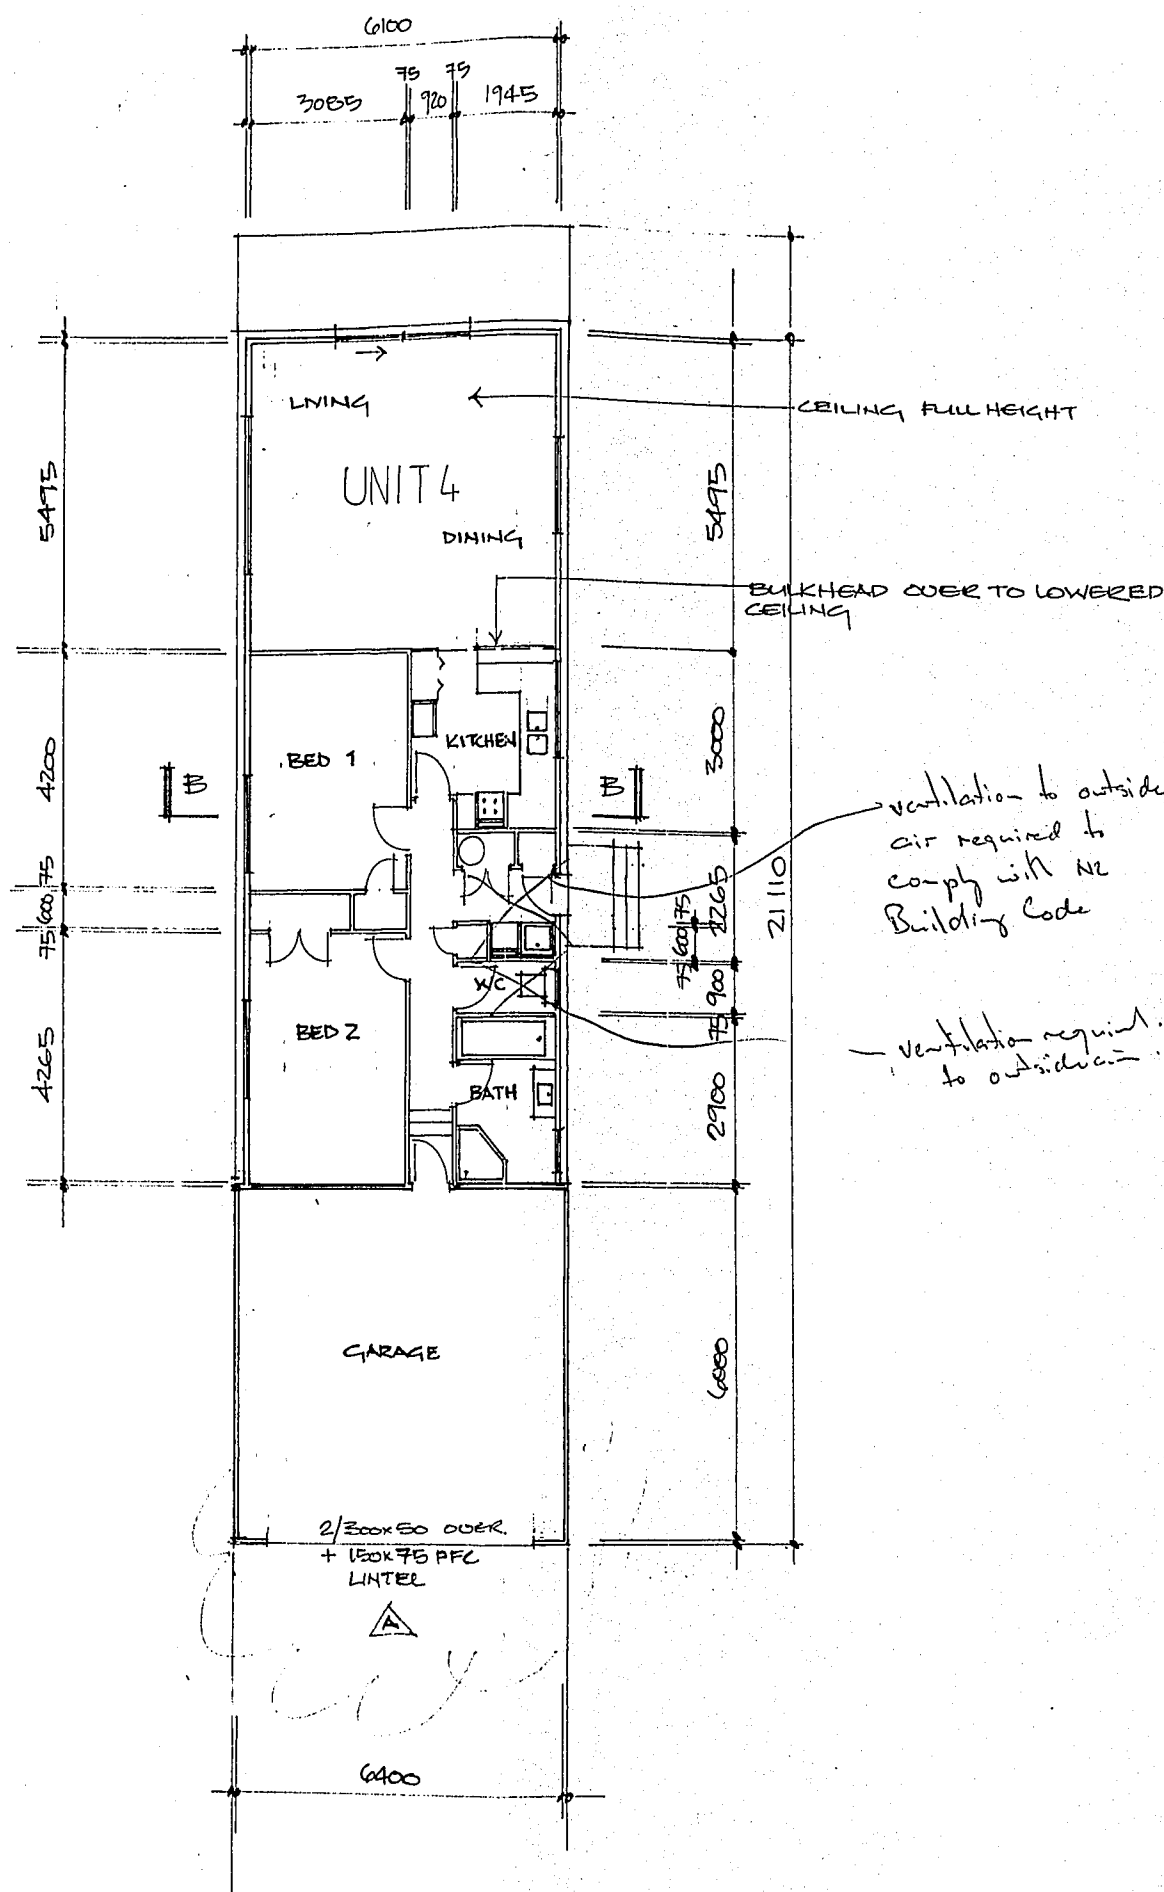

PLAN

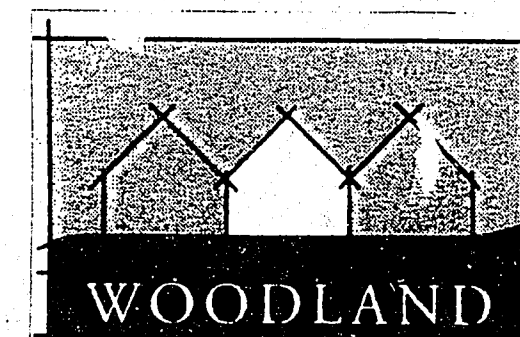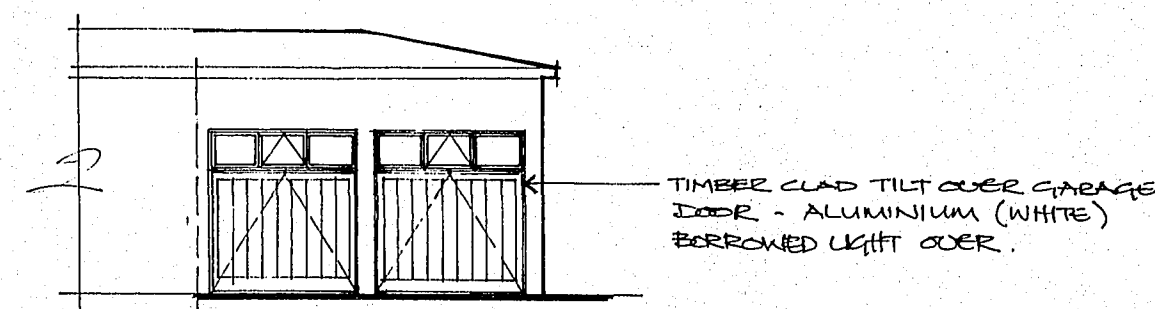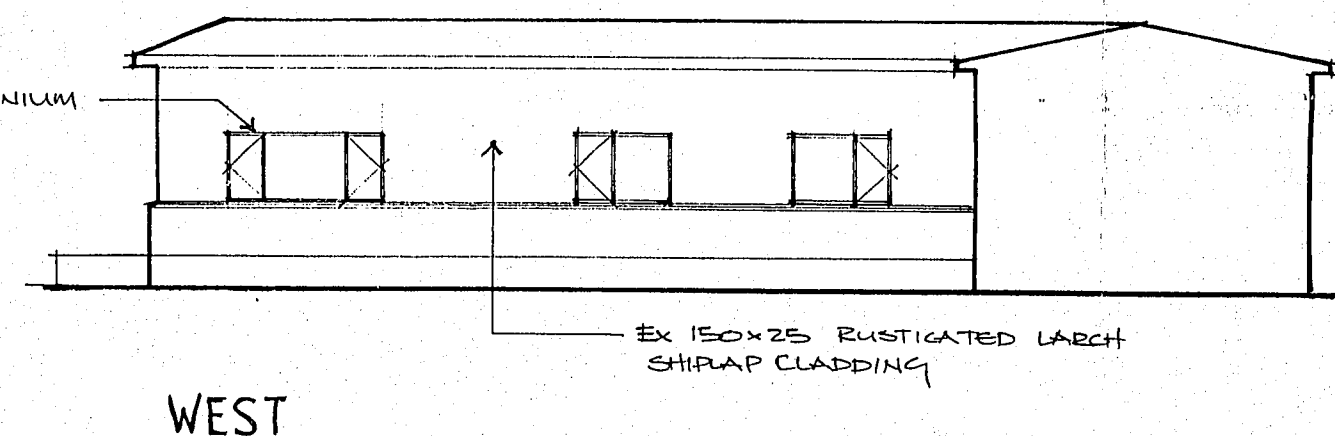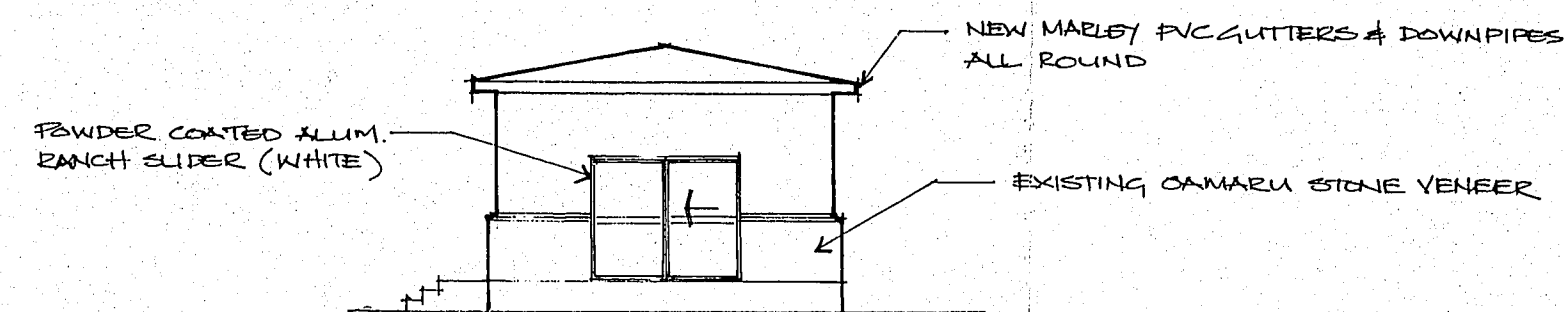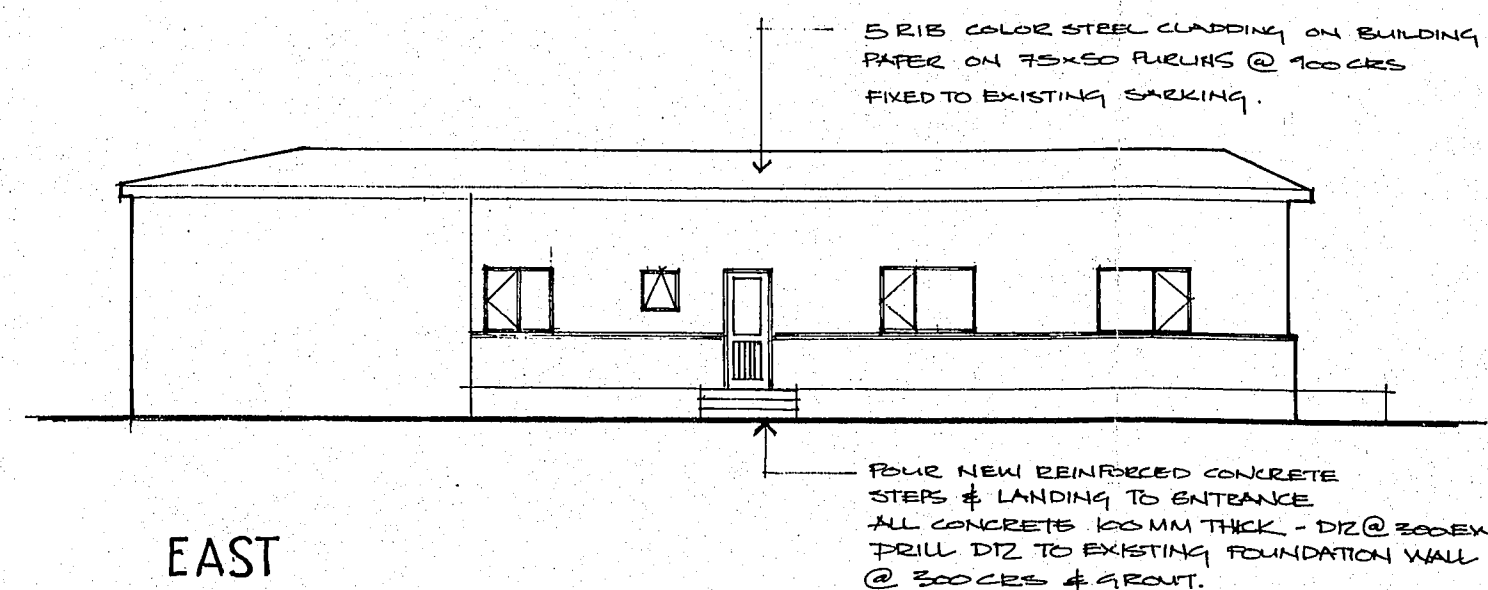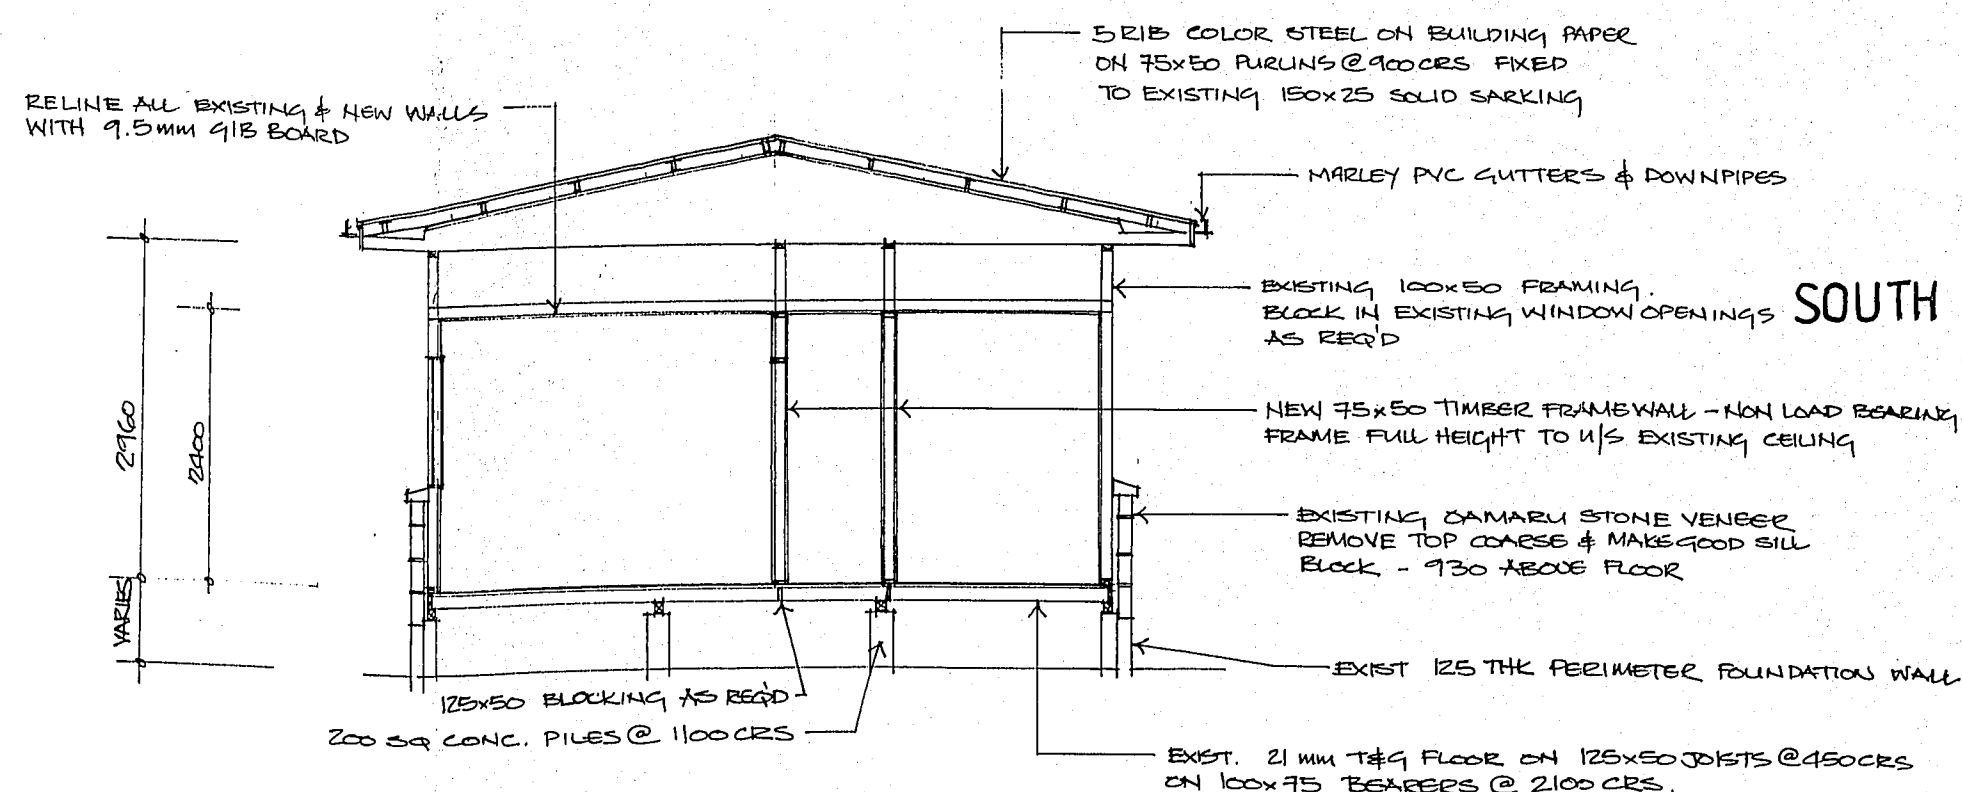

REV A 150x75 PFC GARAGE LINTEL					
F.B	Initials	Date	TR	Initials	Date
SURV			TR		
DES			CH		
DR	TEH	12/12	APP		

CLIENT KARITANE ESTATES LTD

JOB NAME HAWKS BURY VILLAGE


TITLE VILLA F UNIT 4 PLAN & ELEVATIONS






SCALE 1:100 1:50

9401 / 7 A

95/91

Amended Plan and/or Specification Received
By: *[Signature]*
Date: 25/2/95

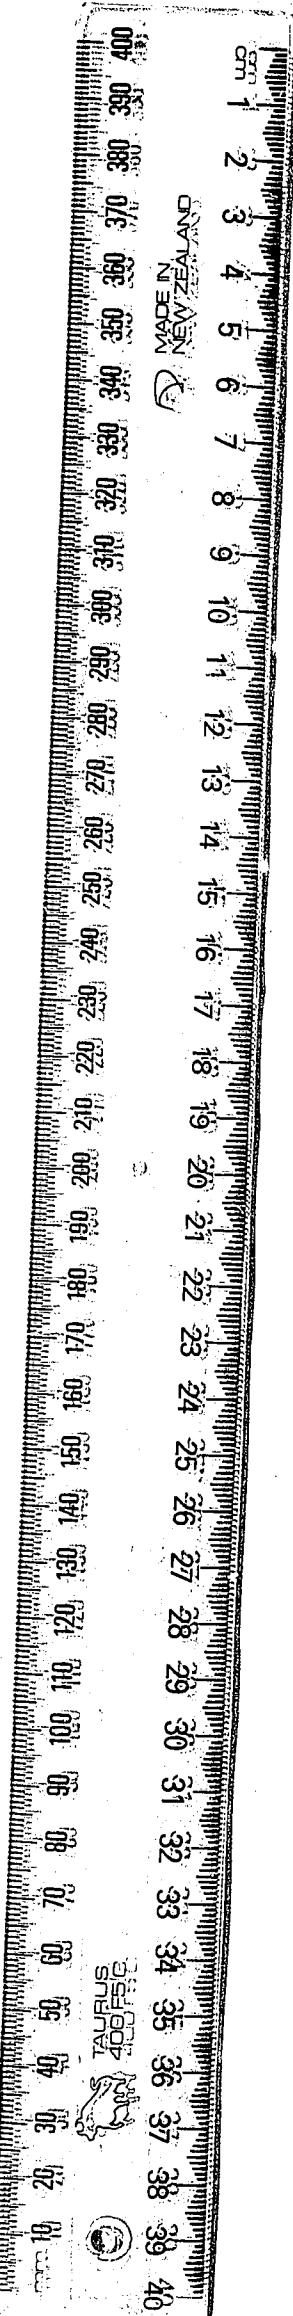

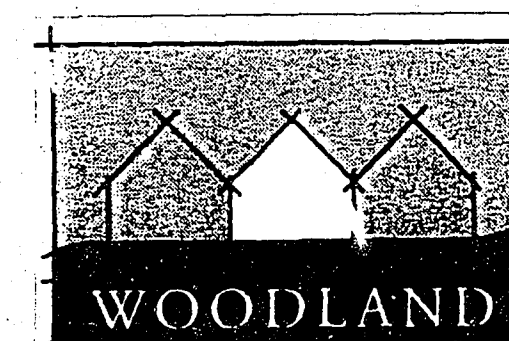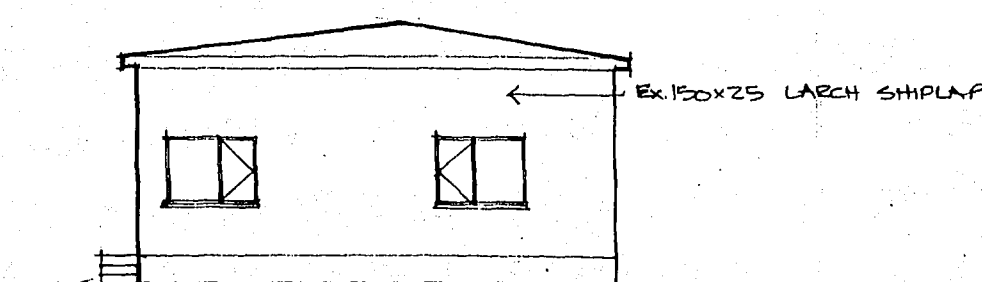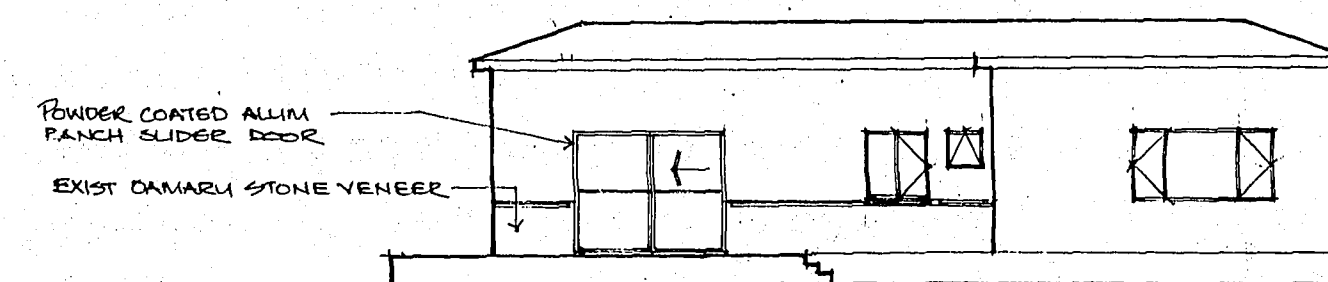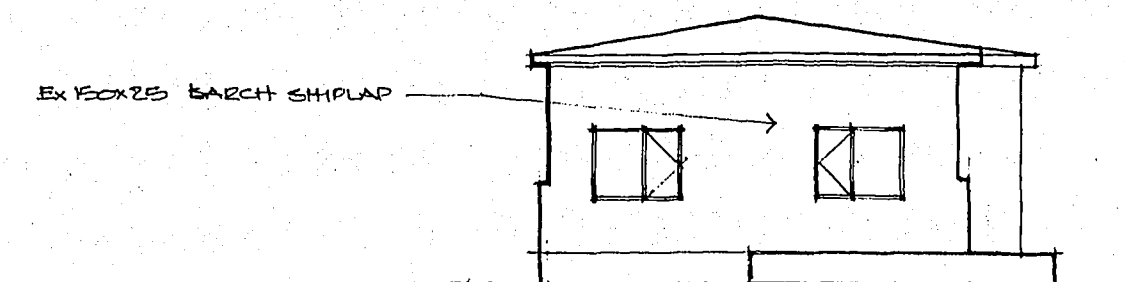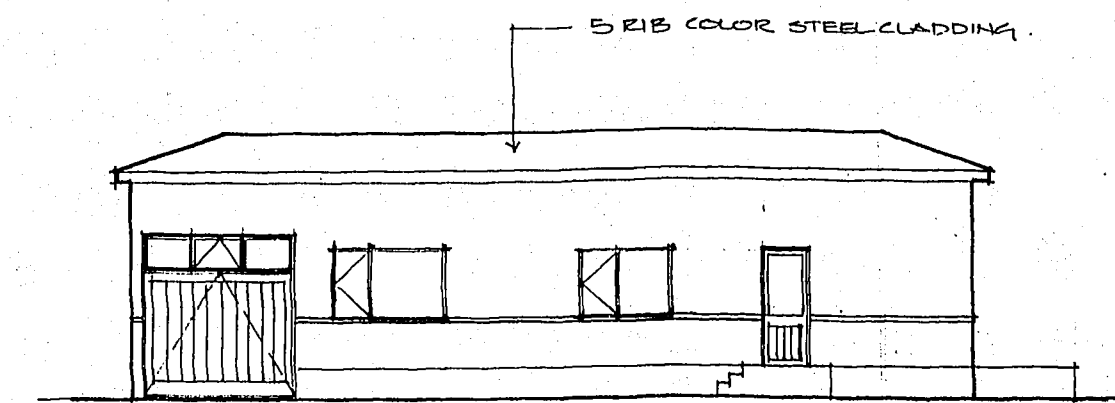

F.B.					
	Initials	Date		Initials	Date
SURV.			TR		
DGN.			CH		
DR	TBL	12/11	APP		

CLIENT KARITANE ESTATES LTD

JOB NAME HAWKS BURY
VILLAGE

TITLE UNIT 5
PLAN & ELEVATION

SCALES: 1:100 1:50

9401 / 8

Hand-drawn architectural sketches of a building from four perspectives: West, East, North, and South. The sketches include various annotations:

- West Elevation:**
 - EXISTING CONCRETE DECKS.
 - POWDER COATED ALUM GLAZING - WHITE
- East Elevation:**
 - REPICTH NEW ROOF OVER LIVING & VERANDA
 - EXISTING TIMBER GLAZING
 - EXISTING VERANDA. RELINE SOFFIT WITH 60 MM HARDISHEET
- North Elevation:**
 - EXISTING TIMBER GLAZING
- South Elevation:**
 - Ex 150x25 LARCH SHIPLAP TO ALL EXTERNAL WALLS

Additional notes at the bottom right of the page:

glazing to comply with
N2S 4213 pts 1, 2, & 3


WEST

EAST



NORTH

SOUTH

glazing to comply with
423 4223 pts 1, 2, & 3.

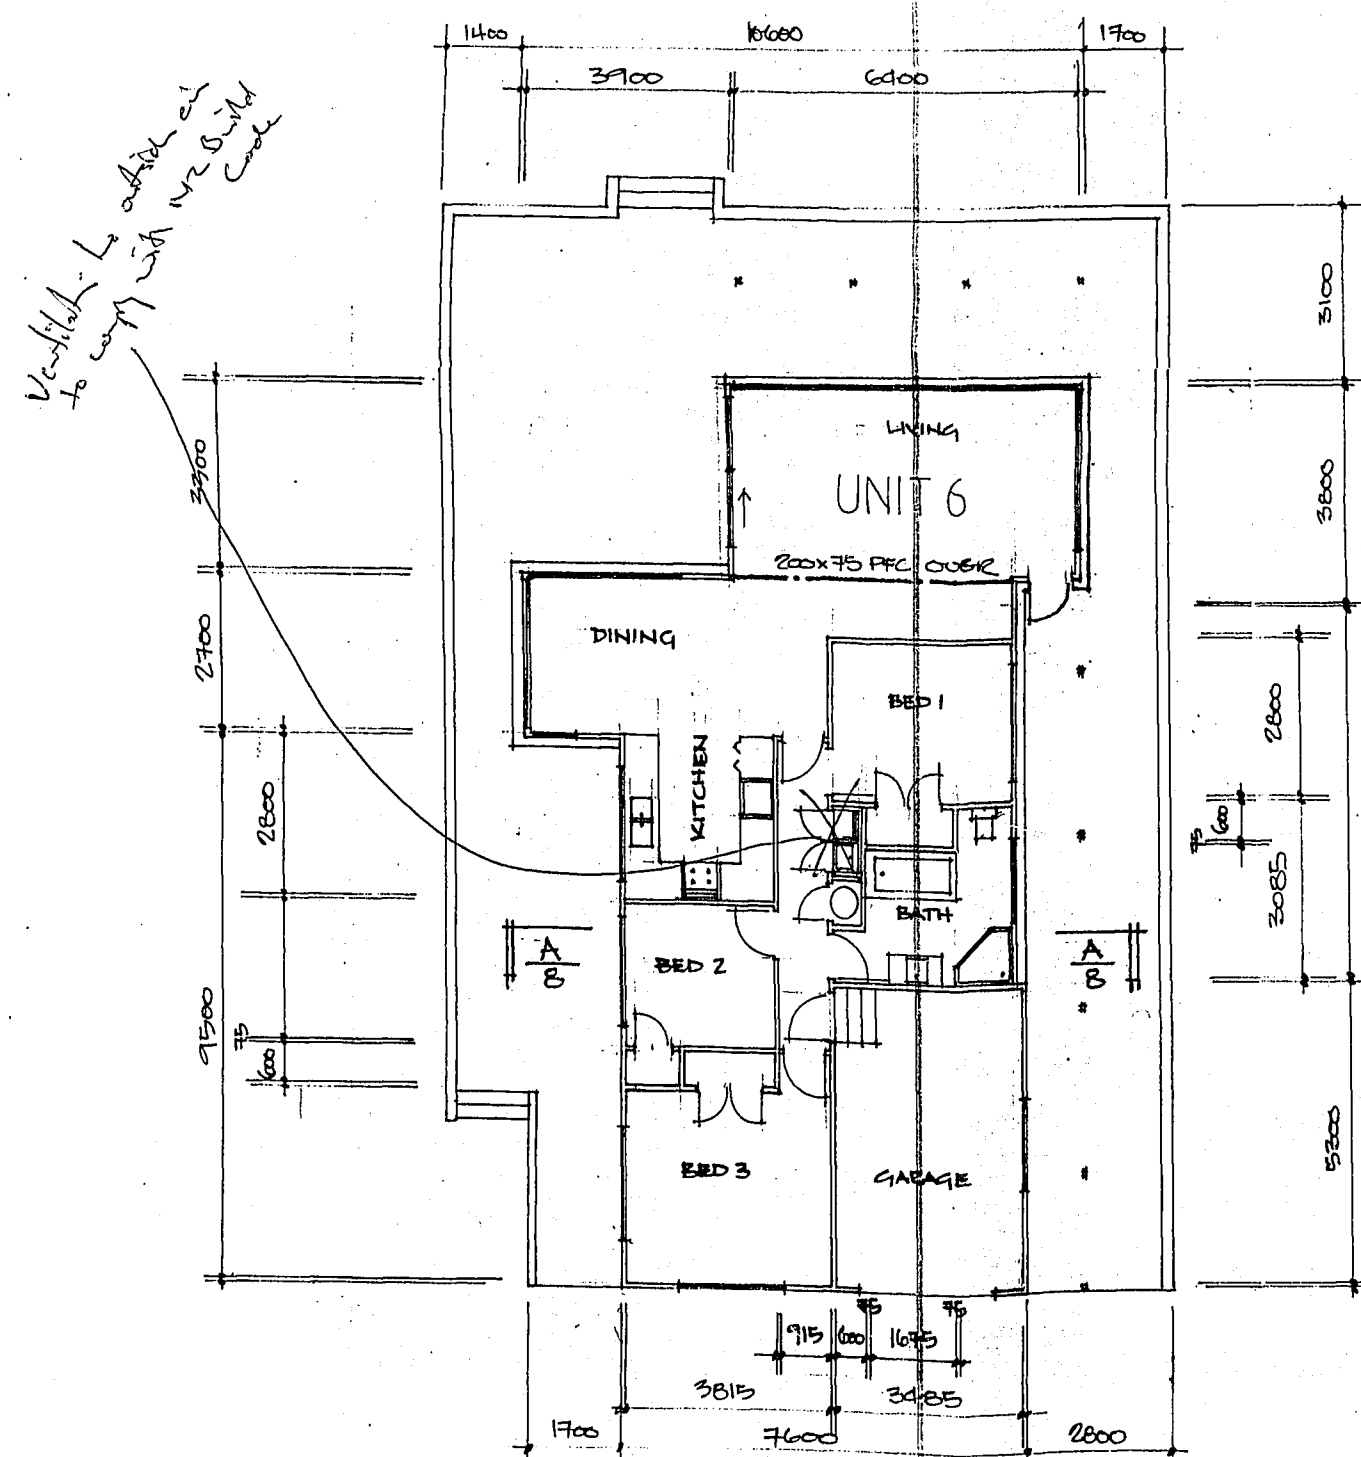

PLAN

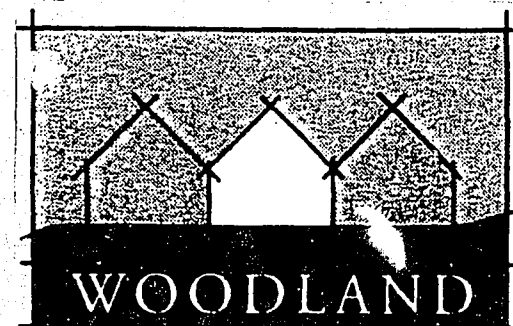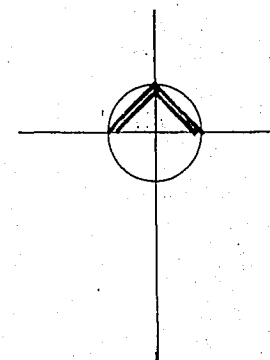

F.B.					
	Initials	Date		Initials	Date
SURV.			TR.		
DGN			CH		
DR.	JBH	12/74	APP		


CLIENT KARITANE ESTATES LTD.

JOB NAME HAWKS BURY
VILLAGE

UNIT 6
PLAN & ELEVATIONS

SCALES 1:100

9401 / 9

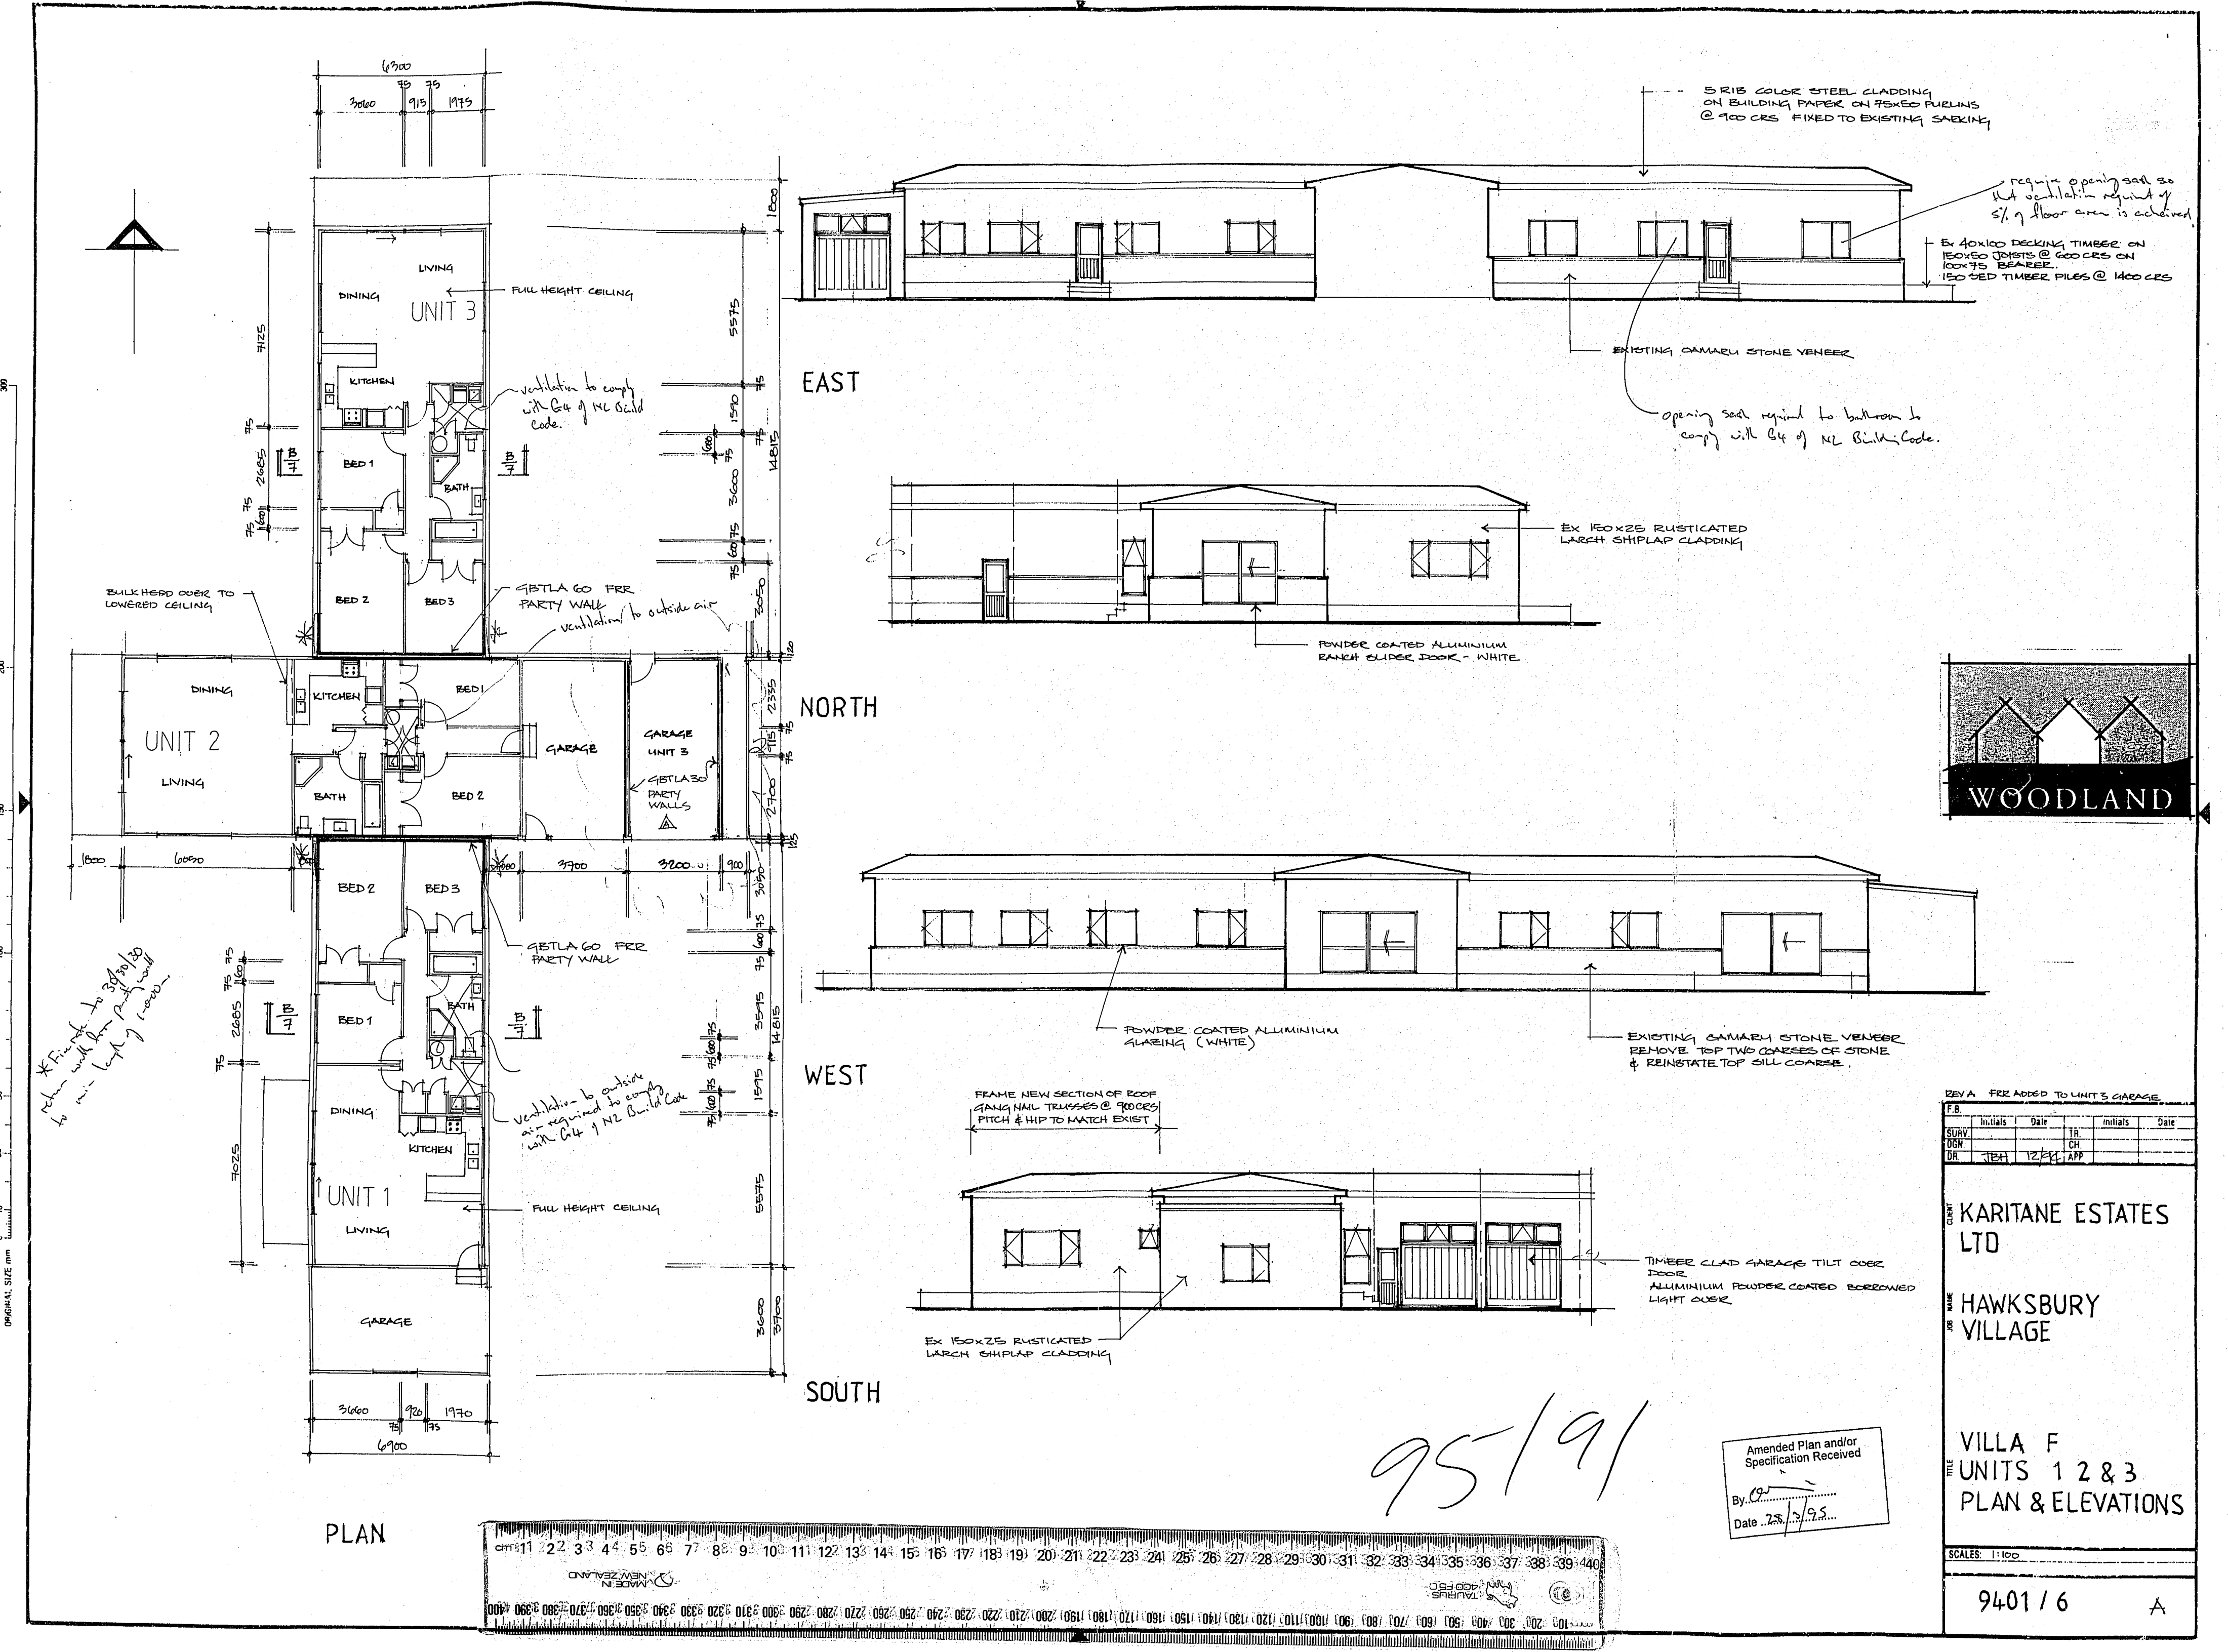

ORIGINAL SIZE mm
0 10 20 30 40 50 60 70 80 90 100 110 120 130 140 150 160 170 180 190 200 210 220 230 240 250 260 270 280 290 300 310 320 330 340 350 360 370 380 390 400

* Finish to 300/30
to min. depth of 1000


PLAN

EAST

NORTH

WEST

SOUTH

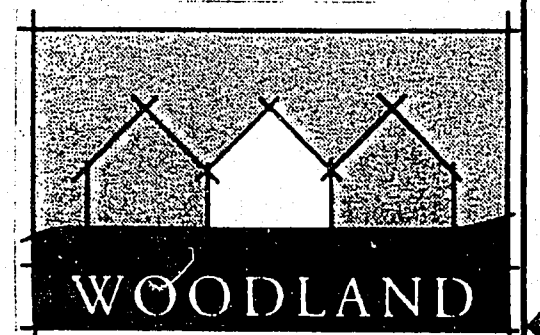

REV A FRZ ADDED TO UNIT 3 GARAGE

SURV	Initials	Date	TR	Initials	Date
DGN			CH		
DR	JEB	12/28	APP		

KARITANE ESTATES LTD
HAWKS BURY VILLAGE

VILLA F
UNITS 1 2 & 3
PLAN & ELEVATIONS

SCALE: 1:100

9401 / 6 A

Amended Plan and/or Specification Received
By: *[Signature]*
Date: 28/3/95

95/91

BUILDING CONSENT

Section 35, Building Act 1991

ISSUED BY:



DUNEDIN CITY COUNCIL

50 THE OCTAGON, BOX 5045, DUNEDIN, NEW ZEALAND. TELEPHONE (03) 477-4000. FACSIMILE (03) 474-3594



Telephone No:	474-3525	Consent No:	ABA 954644	Reference No:	5102233
---------------	----------	-------------	------------	---------------	---------

(Insert a cross in each applicable box. Attach relevant documents).


APPLICANT	PROJECT
Name: MACDONNELL, EILEEN Mailing Address: R D 1, WAIKOUAITI	All ☒ Stage No of an intendedstages New Building ☐ Alteration ☒ Intended Use(s) in detail: ADD TO GARAGE Intended Life: Indefinite, not less than 50 years ☒ Specified as 0 years Demolition ☐ Estimated Value: \$4950
PROJECT LOCATION	
Street Address: 1861/6 WAIKOUAITI-WAITATI ROAD, MERTON, WAIKO	
LEGAL DESCRIPTION	
Property Number: 5102233 Valuation Roll No: 26520 02400 Legal Description: PT SECS 19 48 PT DP 5596 & PT DP 5778 BL	
COUNCIL CHARGES	Signed for and on behalf of the Council: Name: Position: AUTHORISED OFFICER Date: 14/11/1995
The balance of Council's charges payable on uplifting of this building consent, in accordance with the tax invoice are: Total: \$ ALL FEES ARE GST INCLUSIVE	

This building consent is a consent under the Building Act 1991 to undertake building work in accordance with the attached plans and specifications so as to comply with the provisions of the building code. It does not affect any duty or responsibility under any other Act nor permit any breach of any other Act.


This building consent is issued subject to the conditions specified in the attached pages headed "Conditions of Building Consent No....."

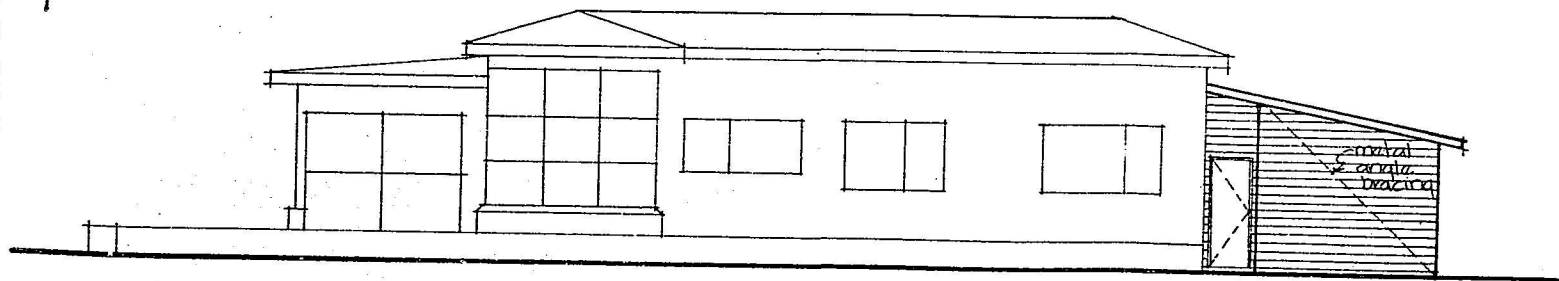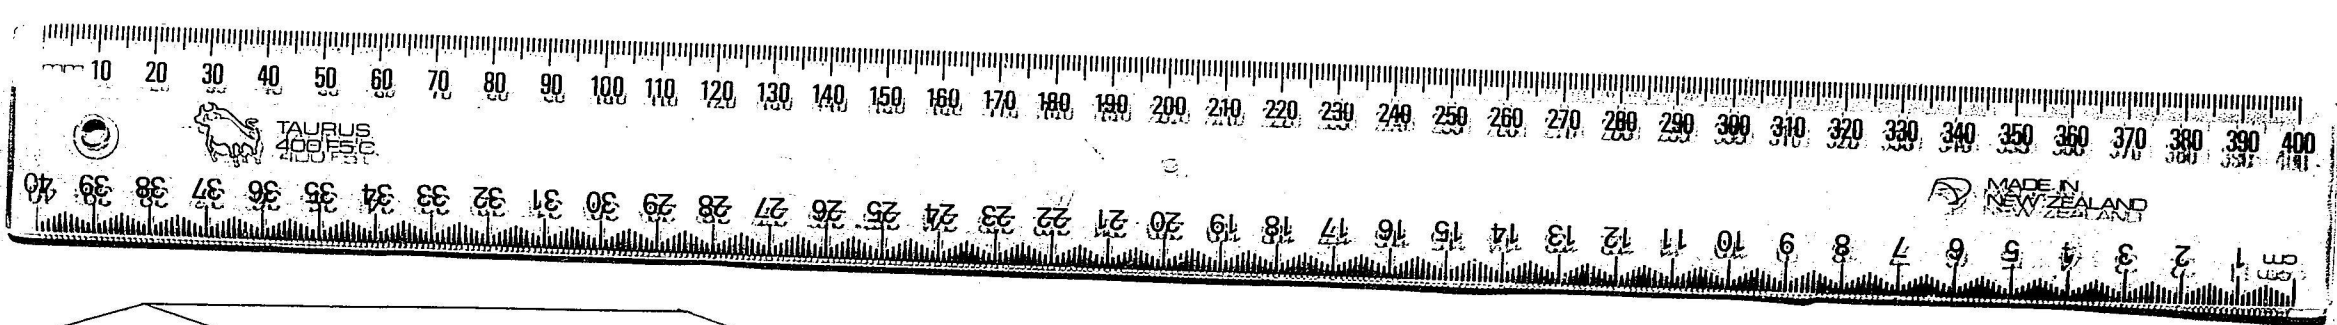


WEST ELEVATION 1:100

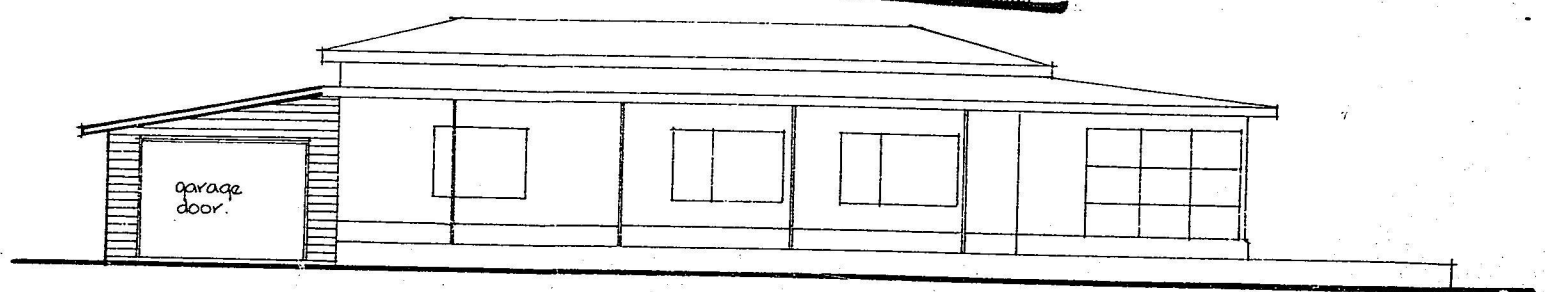

EAST ELEVATION 1:100

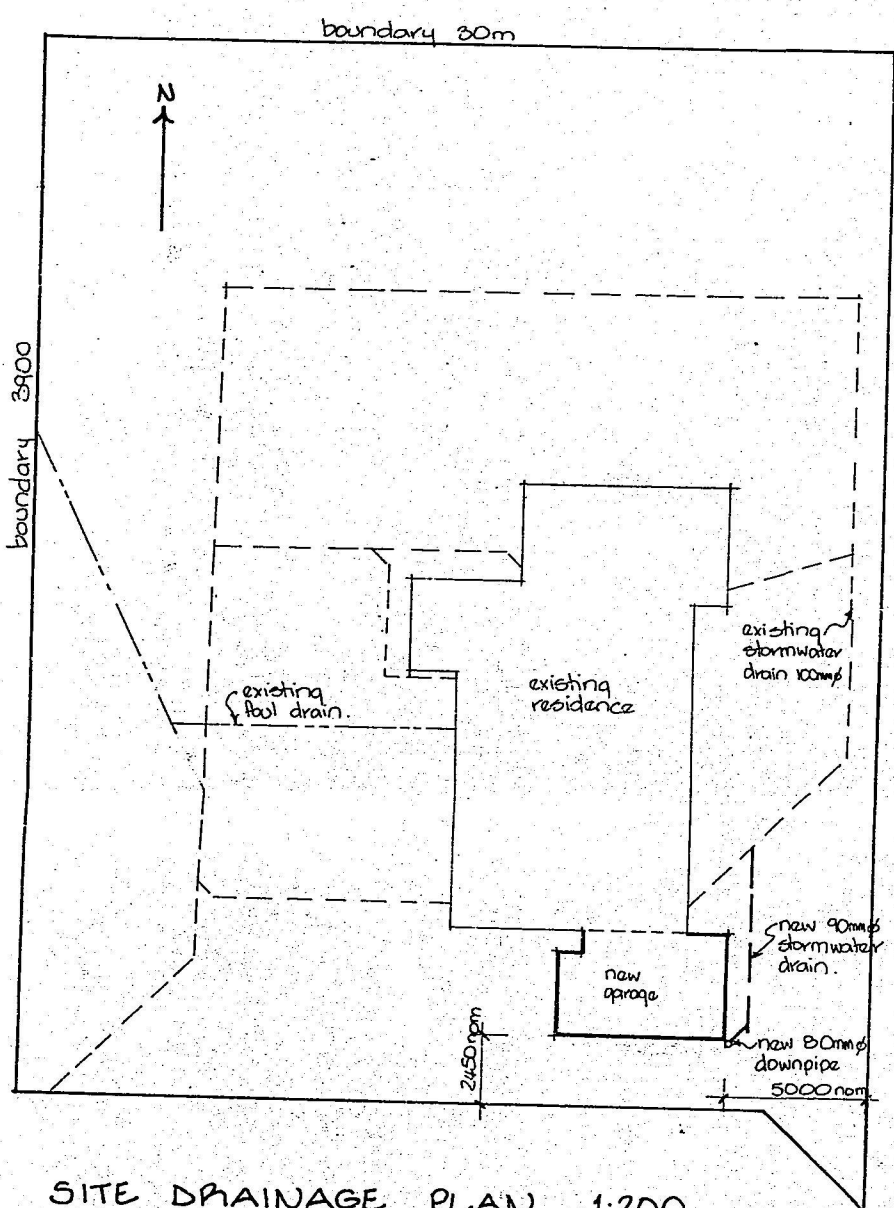


SITE DRAINAGE PLAN 1:200

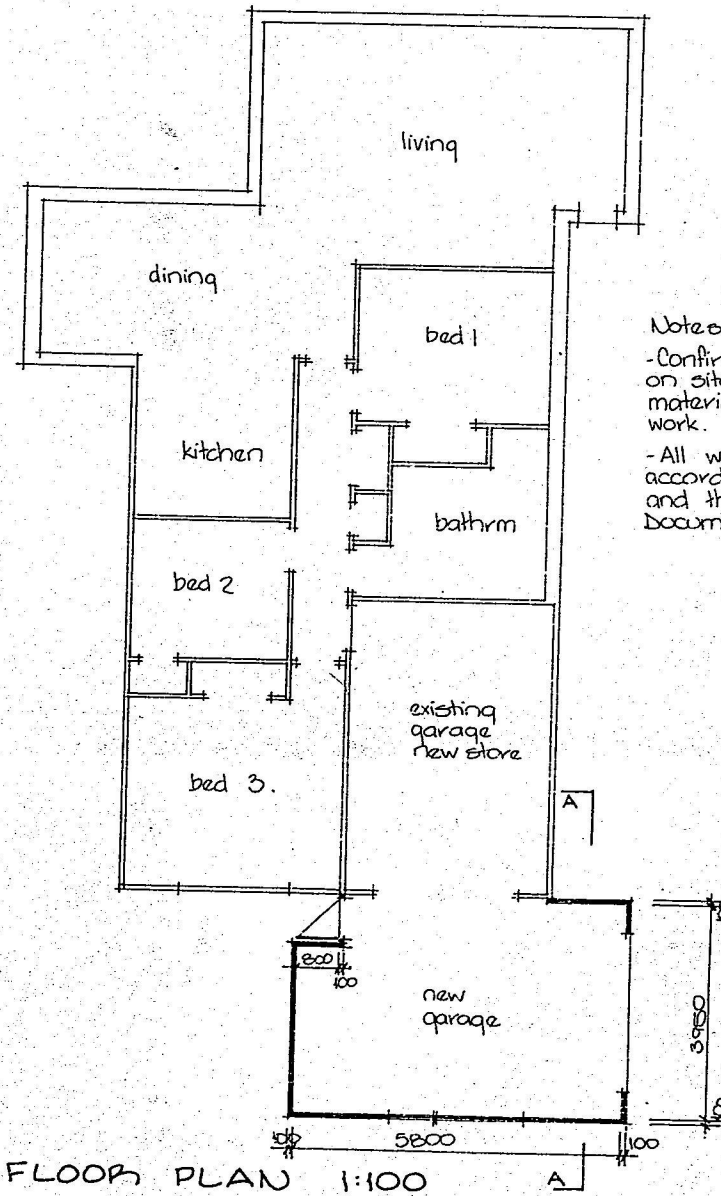


FLOOR PLAN 1:100

Notes:
- Confirm all dimensions on site before ordering materials or commencing work.
- All work to be in accordance with NZS3604 and the NZBIA Approved documents.

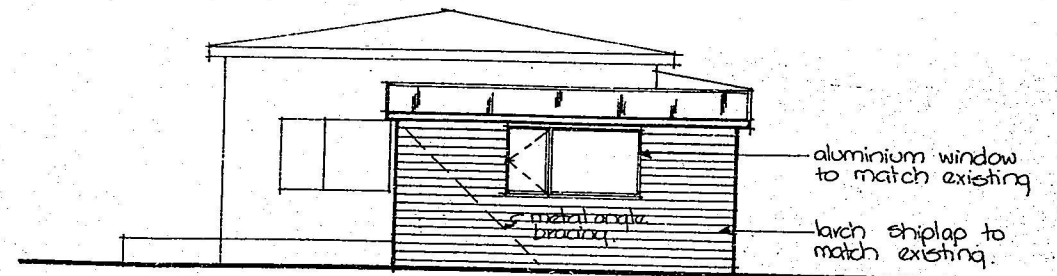

SOUTH ELEVATION 1:100

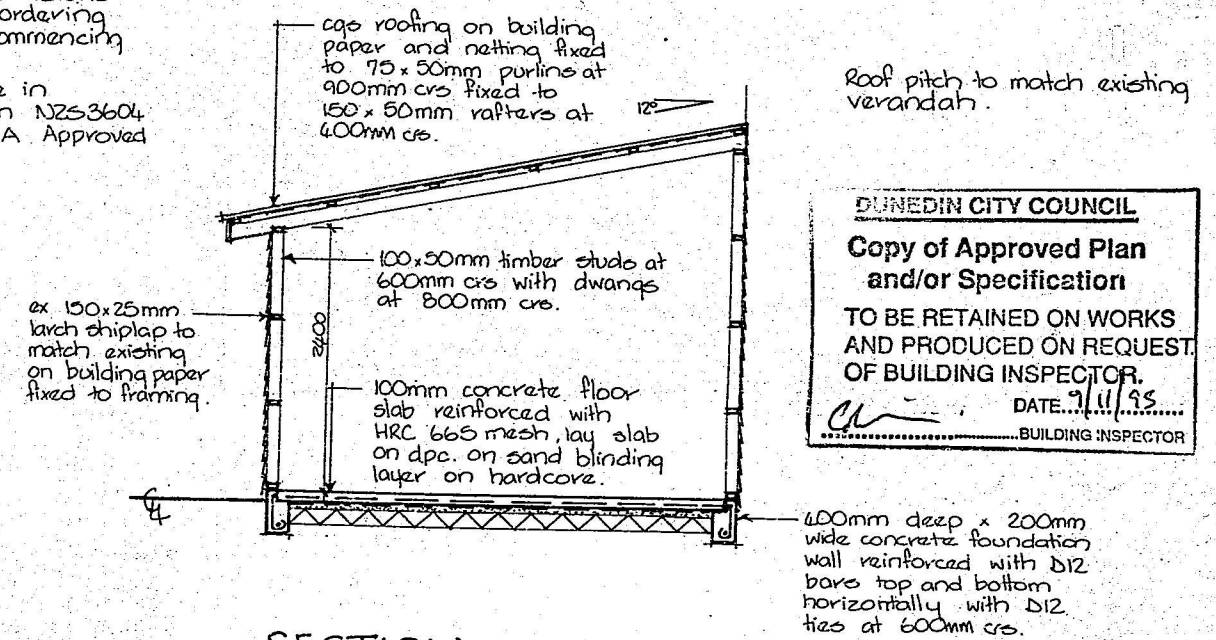


SECTION A-A 1:50

DUNEDIN CITY COUNCIL
Pursuant to the provisions of the District Scheme, these plans and specifications are approved, provided that no change shall be made to the details shown hereon, and contained in the specification attached hereto, and subject to the following conditions:
1. The work shall be completed within the time specified.
2. The work shall be completed in accordance with the specification attached hereto.
3. The work shall be completed in accordance with the District Scheme.
4. The work shall be completed in accordance with the District Scheme.
5. The work shall be completed in accordance with the District Scheme.
6. The work shall be completed in accordance with the District Scheme.
7. The work shall be completed in accordance with the District Scheme.
8. The work shall be completed in accordance with the District Scheme.
9. The work shall be completed in accordance with the District Scheme.
10. The work shall be completed in accordance with the District Scheme.

Drawn: S. Thomson
Job No: 9541
September 1995

95/4644


1861/6 Waikouaiti-Waitati Road, Merton. Property I.D. 5102233
NEW GARAGE FOR THE EXISTING RESIDENCE AT
6 ELMTREE PLACE, HAWKS BURY VILLAGE.

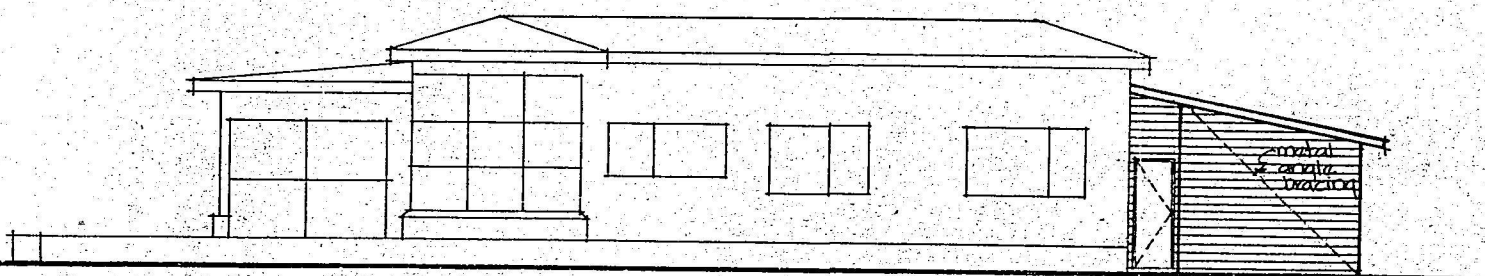


WEST ELEVATION 1:100



EAST ELEVATION 1:100

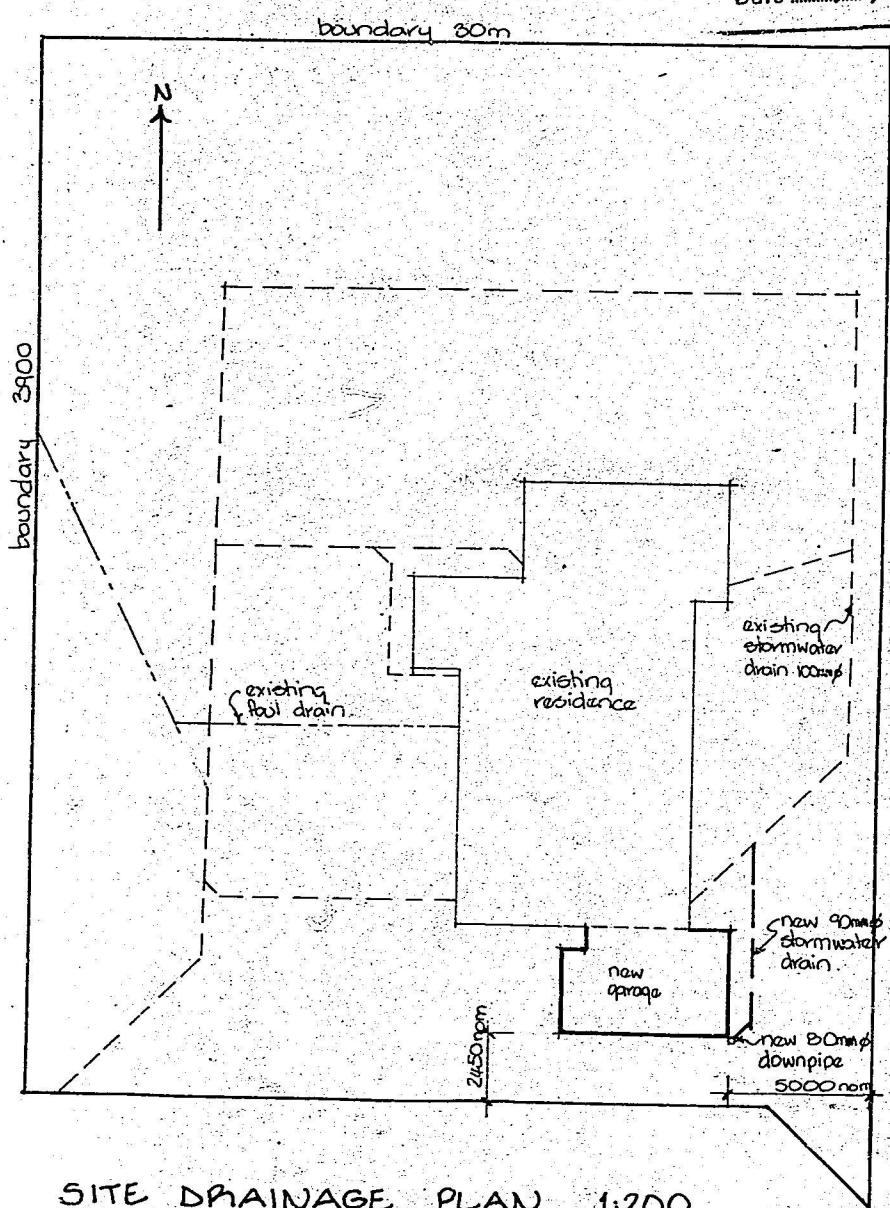


SITE DRAINAGE PLAN 1:200

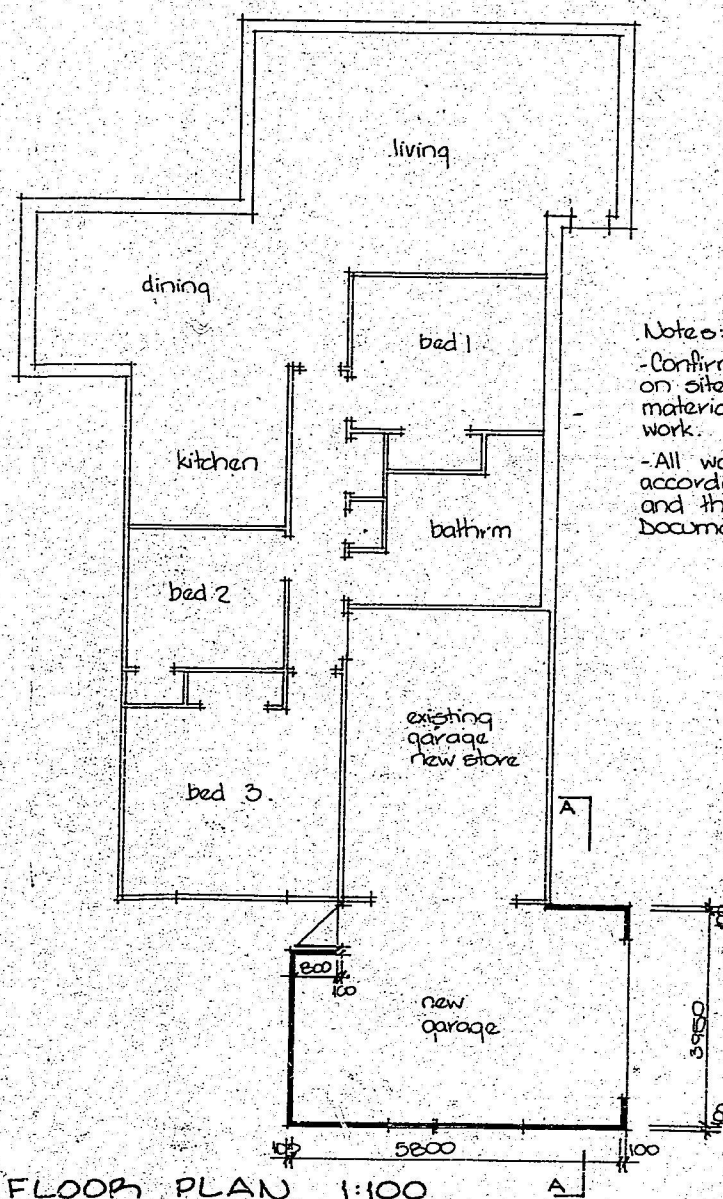


FLOOR PLAN 1:100

Notes:
- Confirm all dimensions on site before ordering materials or commencing work.
- All work to be in accordance with NZS3604 and the NZBIA Approved documents.

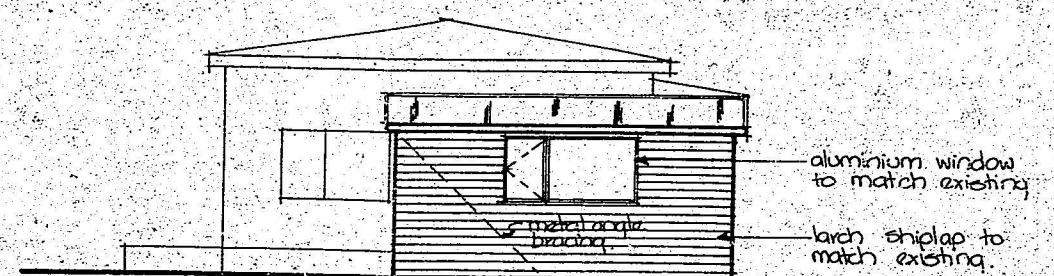

SOUTH ELEVATION 1:100

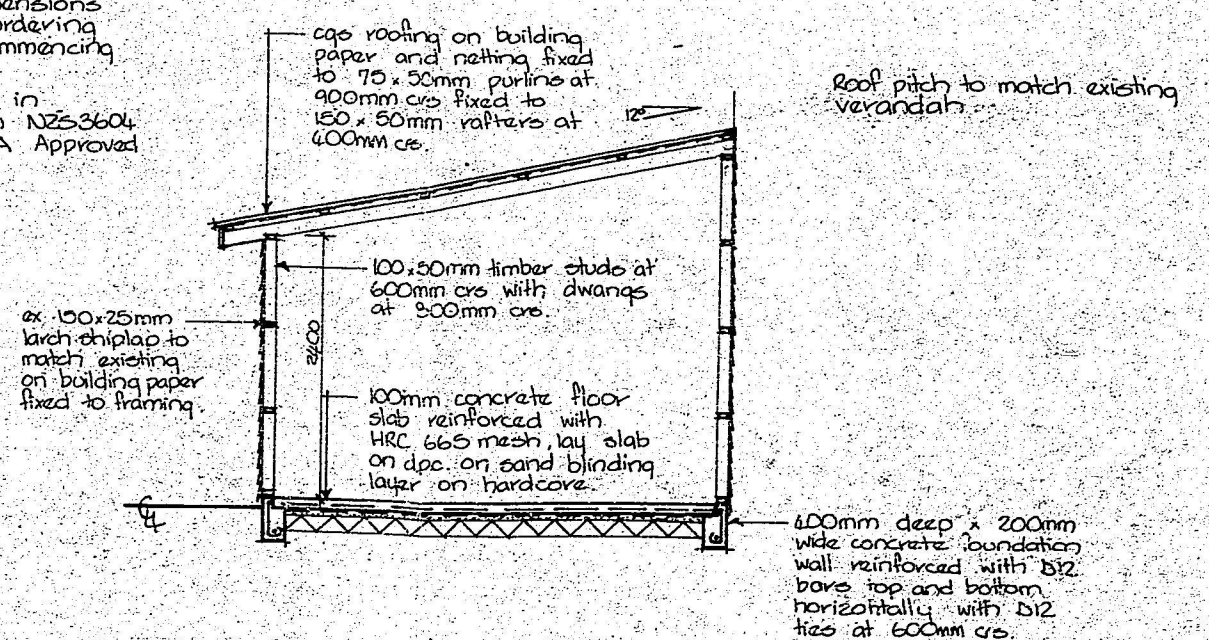

SECTION A-A 1:50

Richardson Unit 5
Open for Kaitang Estate

Drawn: S. Thomson
Job No: 9541
September 1995

NEW GARAGE FOR THE EXISTING RESIDENCE AT
6 ELMTREE PLACE, HAWKS BURY VILLAGE.

Code Compliance Certificate Form 7

Section 95, Building Act 2004

S J Adams
6 Martin Close
RD 1
Waikouaiti 9471

The building

Street address of building: 6 Martin Close Waikouaiti

Legal description of land where building is located: UNIT 6 DP 24746 on LOT 52 DP 24597

Building Name: n/a

Location of building within site/block number: n/a

Level/unit Number: n/a

Current, lawfully established, use: Housing

Number of occupants: 2

Year first constructed: 1995

The owner

Name of owner: S J Adams

Contact person: S J Adams

Mailing address: 6 Martin Close, RD 1, Waikouaiti 9471

Street address/registered office:

Mobile: 021 203 9850

Landline:

Email address:

First point of contact for communications with the building consent authority: As above

Building work

Building Consent Number:

ABA-2015-591 - Install Woodsman ECR Novo Freestanding Heater and Flue in Dwelling

This CCC also applies to the following amended consents: n/a

Issued by: Dunedin City Council

Code Compliance

The building consent authority named below is satisfied, on reasonable grounds, that-

- (a) The building work complies with the building consent

This Certificate is issued subject to the conditions specified:

The Building Consent is subject to a modification to the Building Code to the effect that, Clause B2.3.1 applies from 14 May 2015 instead of from time of issue of the Code Compliance Certificate.



Team Leader Inspections
On behalf of Dunedin City Council

Date: 10 December 2021

50 The Octagon | PO Box 5045 | Dunedin 9054, New Zealand | T 03 477 4000 | E dcc@dcc.govt.nz | www.dunedin.govt.nz

 [DunedinCityCouncil](https://www.facebook.com/DunedinCityCouncil)  [@DnCityCouncil](https://twitter.com/DnCityCouncil)

DUNEDIN CITY COUNCIL

Plans and Specifications Approved in accordance with The New Zealand Building Code and Approved Documents. To be retained on works and produced on request.

IMPORTANT INFORMATION

For freestanding heating appliance inspections, the ceiling plate shall be detached and safe access provided to the ceiling space.


If a wetback system is installed, safe access must be provided to the hot water cylinder and tempering device.

Building
Drainage *RACC*
Health

Date
Date *20-01-15*
Date

NOTE

6 Martine Close
Hawkesbury Village
Kaitiaki
Waikouaiti 9471
⊗ Smoke Alarms
as per NZBC F7

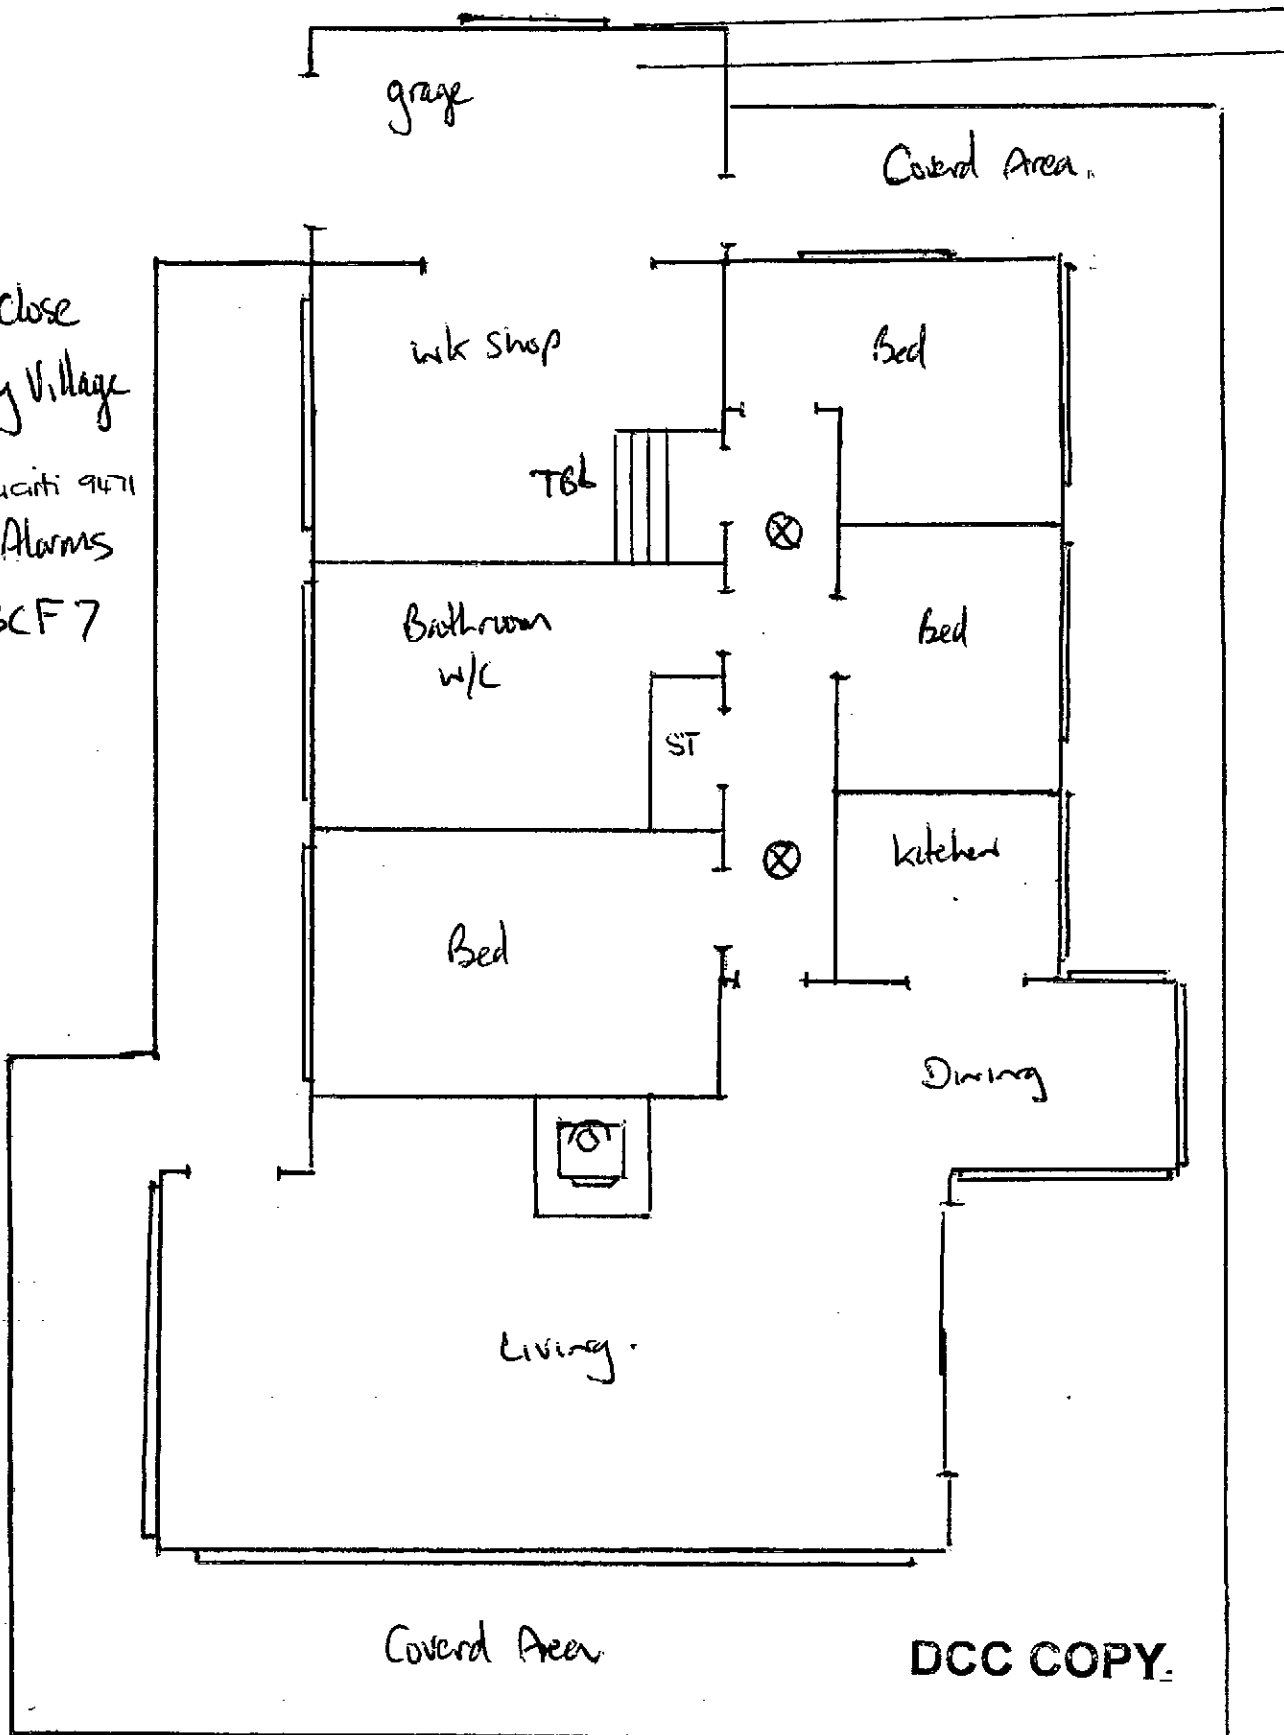

DUNEDIN CITY COUNCIL
APPROVED BUILDING CONSENT DOCUMENTS

2015-591

DCC COPY

25/26/2



50 THE OCTAGON. BOX 5045. DUNEDIN. NEW ZEALAND TELEPHONE (03) 477-4000 FACSIMILE (03) 474-3594

10 October 1994

Paterson Pitts Partners Ltd
Box 1083
DUNEDIN

Dear Sir/Madam

RESOURCE CONSENT A94237

Thank you for your letter dated 18 July 1994 submitting a Resource Consent Application for subdivision at Hawksbury Estate.

This has now been considered and approved subject to the conditions contained in the attached schedule.

A copy of the approved plan is enclosed.

Yours faithfully

A handwritten signature in cursive script, appearing to read 'Doug Jackson', is written over a horizontal line.

Doug Jackson
COMMITTEE SECRETARY

Encl

SCHEDULE FOR REPORT A94237

Resource Consent (Land Use Consent and Subdivision Consent) is granted in respect to the part Sections 21 and 48 Block IV Waikouaiti District, being the land held in CT 14C/39 as follows:

- i) Land Use consent in respect to a discretionary activity involving a reduction in the required yards to Lots 9, 14, 17, 18, 19, 20, 22, 23, 37, 38 and 55 on the scheme plan of subdivision, to the extent that the buildings existing as at 29 September 1994 do not have the required yard to existing or new boundaries. This consent is given without conditions.

The reason for the consent is that it is not practical to require compliance in respect to the existing buildings on the above lots.

and

- ii) That in terms of Section 321(2)(c) of the Local Government Act 1974, the Committee is satisfied that the proposed private roads and rights of ways will provide adequate access, and accordingly Section 321(1) of the Local Government Act 1974 shall not apply.

and

- iii) Subdivision consent in respect to a controlled activity involving private rather than public roads for the reason that the proposal meets the District Plan provisions and suitable conditions of consent can be imposed to mitigate any adverse effects on the environment.

Pursuant to Sections 108 and 220 of the Resource Management Act 1991, the subdivision consent is subject to the following conditions:

1. The consent holder may in accordance with Section 127 (1) of the Resource Management Act 1991, apply to the Dunedin City Council for the change or cancellation of any conditions of this consent;
 - a) with a period of three months from the date of this consent;
 - or
 - b) at anytime on the grounds that a change of circumstances has caused the condition or conditions to become inappropriate or unnecessary.
2. Lot 63 shall vest as a legal road.

3. The easements noted on pages 14 and 15 of the application are approved and shall be duly granted or reserved.
4. An easement in gross shall be granted or reserved in favour of the Dunedin City Council over Lots 64, 65, 66 and all the rights of ways noted on the plan of subdivision.
5. Works at the entrance from State Highway 1 shall be in accord with the agreement reached with Transit NZ.
6. The plan of subdivision shall be amended to increase the entrance strips to Lot 59 to the satisfaction of Council in respect to visual and physical access.
7. The registration of a consent notice on the titles of Lots 34 and 59 indicating that they are to be transferred to and held by Karitane Management Limited for the use and enjoyment of all lots in the subdivision.
8. The registration of a consent notice on all titles in the subdivision indicating that all owners are to comply with the requirements of the Deed of Covenant required by Condition 10.
9. In terms of Section 348 of the Local Government Act 1974, Lot 64, Lot 65 and Lot 66 are approved as private roads subject to compliance with the minimum road reserve of 16 metres. No additional formation is required but the subdivider shall maintain the private road in good repair and free of defects. The pavement repairs/resurfacing required on Lots 64, 65 and 66, as detailed in DWK's report dated 18 April 1994, (included in submission), shall be undertaken within a two year period from the date of consent being given. These works shall also include any necessary repair works which have resulted from on site construction activities or pavement failures which have occurred since April 1994.
10. That Karitane Estates or its successor take over full responsibility for all services associated with this subdivision via a Deed of Covenant formulated to the satisfaction of Council's Group Manager of Planning and Development. (See Appendix 1 for the suggested format.)
11. Prior to Council providing certification under Section 224 of the Resource Management Act 1991, the Subdivider shall have formed the rights of ways to the standard detailed in the District Plan. All construction works shall be in accordance with plans approved by the Council's Roading Manager and shall be certified by a suitably qualified and experience person.
12. Prior to Council providing certification under Section 224 of the Resource Management Act 1991, the Subdivider shall have paid Council \$5,000 plus

GST, being half of the estimated cost of sealing McGrath Road from State Highway 1 to private road No 6.

13. Prior to Council providing certification under Section 224 of the Resource Management Act 1991, the Subdivider shall
 1. Provide a foul lateral to each residential lot.
 2. Provide a stormwater connection to an approved out fall to each residential lot.
 3. Provide a reticulation plan showing all main drains and laterals.
 4. Carry out absorption tests on the proposed on site land disposal area to confirm the required disposal area.
 5. Forward a copy of the proposed drainage right for the land disposal area to the Reticulation Engineer for approval.
 6. The approved effluent disposal easement be duly granted or reserved.
14. Prior to Council providing certification under Section 224 of the Resource Management Act 1991, the Subdivider shall provide 'As built' plans of the water reticulation showing hydrants, valves, pipe sizes and property connections to the satisfaction of the Water Manager.
15. Prior to Council providing certification under Section 224 of the Resource Management Act 1991, the Subdivider shall provide additional information on the following:
 - the structural form of the intended landscaping
 - the tree/shrub/plant varieties to be used
 - existing trees that shall be retained on the siteall to the satisfaction of Council in respect to an integrated landscape treatment.
16. That this consent shall not expire until December 2001 and it may be given effect to in stages during that period.

APPENDIX 1

Water Department and Drainage Department requirements in relation to the Deed of Covenant.

(As provided for in respect to subdivision to the east of State Highway 1. Roothing requirements need to be added.)

- a) That Karitane Estates Limited establish a management company to supply water and sewerage reticulation services to all residents and occupants of the Hawksbury Estate. This management company shall enter into a binding transferable agreement with the Dunedin City Council to provide a water service and a sewerage service to all residents and occupants of the Hawksbury Estate.

The conditions of supply of water and sewerage services form the management company to consumers of the estate shall be in compliance with the relevant sections of the Dunedin City Council Water Department terms and conditions of supply and any conditions imposed by the Drainage Department.

- b) That the Dunedin City Council Water Department supply bulk water to the Hawksbury Estate through a single metered point of supply in McGrath Road (this shall be the existing point of supply).
- c) That the water be charged at the rate per cubic metre applying for water supply to the Karitane Merton water scheme or such other rate as may be negotiated between the management company and the Water Department or as approved or otherwise set by the Dunedin City Council from time to time.
- d) That the management company enter into a Deed of Covenant with the owners of each subdivided section and each unit title controlling company set up within any future subdivision undertaking to provide a water service and a sewerage service to each independent dwelling unit generally in compliance with the Dunedin City Council Water Department terms and conditions of supply and the Drainage Department conditions of supply of service.

That a consent notice in accordance with Section 221 of the Resource Management Act 1991 be registered on all subdivided sections and unit titles within the subdivision requiring the owners to comply with the conditions of the Deed of Covenant with the management company relating to the provision of water and sewerage services to all independent dwelling units and commercial, industrial, recreational, or other buildings with the Hawksbury Estate.

- f) That the binding transferable agreement between the management company and the Dunedin City Council specifically require the company to maintain water and sewerage services to all independent dwelling units and commercial, industrial, recreational, or other buildings within the Hawksbury Estate in perpetuity. However renegotiation of the agreement could be undertaken with the consent of both parties provided all properties within the estate were included within any new arrangement.
- g) That the Deed of Covenant between the management company and the owners of the subdivided allotments within the subdivision require that each independent dwelling unit or other building remain connected to the water and sewerage sources in perpetuity.
- h) That the bindings transferable agreement between the management company and the Dunedin City Council and the Deed of Covenant between the management company and the owner of each independent subdivided section and unit titles and any other documentation required to set up a clear and workable means of administering the provision of first class water and sewerage reticulation service to the Hawksbury Estate be subject to checking by the Councils solicitors and that all costs be borne by the developer.
- i) That that management company undertake to provide a water service to the property boundary of each consumer within the estate and to maintain fire fighting service within the estate generally complying with the New Zealand Fire Service Code of Practice 1992.



APA/SEP

Capitol Building, 67 Princes Street
P.O. Box 292, Dunedin, New Zealand
Telephone (03) 477-3940
Facsimile (03) 474-1249
A.N.Z. Bank No. 01 0907 0044423-12

9 August 1995

District Land Registrar
John Wickcliffe House
Private Bag
DUNEDIN

CONO 889162 Consent unc

Cpy - 01/01.Pgs - 004, 19/12/02, 10:54



DncID 110410561

Dear Sir

Re: Karitane Estate Limited

Certificates of Title Registers 16C/344 and 16C/345 are to be included for registration and we have amended the Consent Notice.

Yours faithfully
Albert Alloo & Sons

Per: 
(letters2\Karitane.E)

Partners: Peter B. Alloo MA LL.M.
Albert P. Alloo LL.B.

Consultant: A. Lawrence Alloo
Associate: Howard T. Alloo LL.B.

Accountant: Ivan D. Roxburgh B.Com. A.C.A.



APA/SEP

31 July 1995


The Registrar
Land Registry Office
DUNEDIN

Dear Sir

Re: Karitane Estate Limited to Brocket

Please note that Messrs Aspinall Joel Radford & Bowler will be effecting joint registration and the Consent Notice that will also be registered against their Certificate of Title Register 16C/352.

Yours faithfully
Albert Alloo & Sons

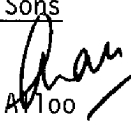Per: Albert P. Alloo 
Partner

Capitol Building, 67 Princes Street
P.O. Box 292, Dunedin, New Zealand
Telephone (03) 477-3940
Facsimile (03) 474-1249
A.N.Z. Bank No. 01 0907 0044423-12

IN THE MATTER of Lots 8, 24 - 34 inclusive
52, 53 and 64 being subdivision of
Part Section 48 Block IV
Waikouaiti Survey District
containing 8.1481 hectares (All
Certificate of Title 14C/39)

AND

IN THE MATTER of Subdivision Consent
pursuant to Sections 105, 220 and
221 of the Resource Management
Act 1991

Pursuant to Section 221 of the Resource Management Act 1991 the Dunedin City Council
by resolution passed under Delegated Authority on the 7th day of October 1994 imposed
the following condition on the Subdivision Consent for Lots 8, 24 - 34 inclusive 52, 53 and
64 being subdivision of Part Section 48 Block IV Waikouaiti Survey District containing
8.1481 hectares (All Certificate of Title 14C/39)

Lot 34 only

Lot 34 is to be transferred to and held by Karitane Management Limited for the use and
enjoyment of all lots in the subdivision of CT 14C/39.

All Lots

All owners are to comply with the requirements of the Deed of Covenant agreed to
between the Dunedin City Council and Karitane Estate Limited.

DATED at Dunedin this 13th day of July

1995

M. Haing
ADMINISTRATION MANAGER
DUNEDIN CITY COUNCIL
(PRINCIPAL ADMINISTRATION OFFICER
FOR THE DUNEDIN CITY COUNCIL)


IN THE MATTER of Lots 8, 24 - 34 inclusive 52, 53
and 64 being subdivision of Part
Section 48 Block IV Waikouaiti
Survey District containing 8.1481
hectares (All Certificate of Title
14C/39)

AND

IN THE MATTER of Subdivision Consent pursuant
to Sections 105, 220 and 221 of the
Resource Management Act 1991

CONSENT NOTICE PURSUANT
TO RESOURCE MANAGEMENT ACT 1991

PATERSON PITTS PARTNERS LTD
REGISTERED SURVEYORS
DUNEDIN

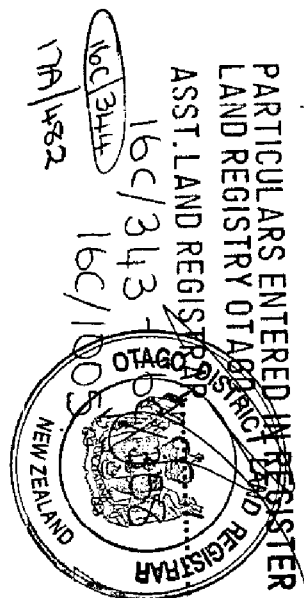

11.22 16.AUG95 889162

F5000001456219
MWP_0011244