



As Laid Drainage

Working Together

Building Consent Number: 2021/42222 Date: 23 / 02 / 2022 No. of pages: 1


Building Address: Units 1 & 2, 32 Glenview Terrace, Hamilton

Drain Layer Name: Matthew Noah [Please print clearly] Signature: *Matthew Noah*

Registration Number: 09771 Business Name: Jamark Plumbing Limited

To Council: [Tick]

☒ Hamilton ☐ Hauraki ☐ Matamata-Piako ☐ Otorohanga ☐ Thames-Coromandel ☐ Waipa ☐ Waikato ☐ Waitomo

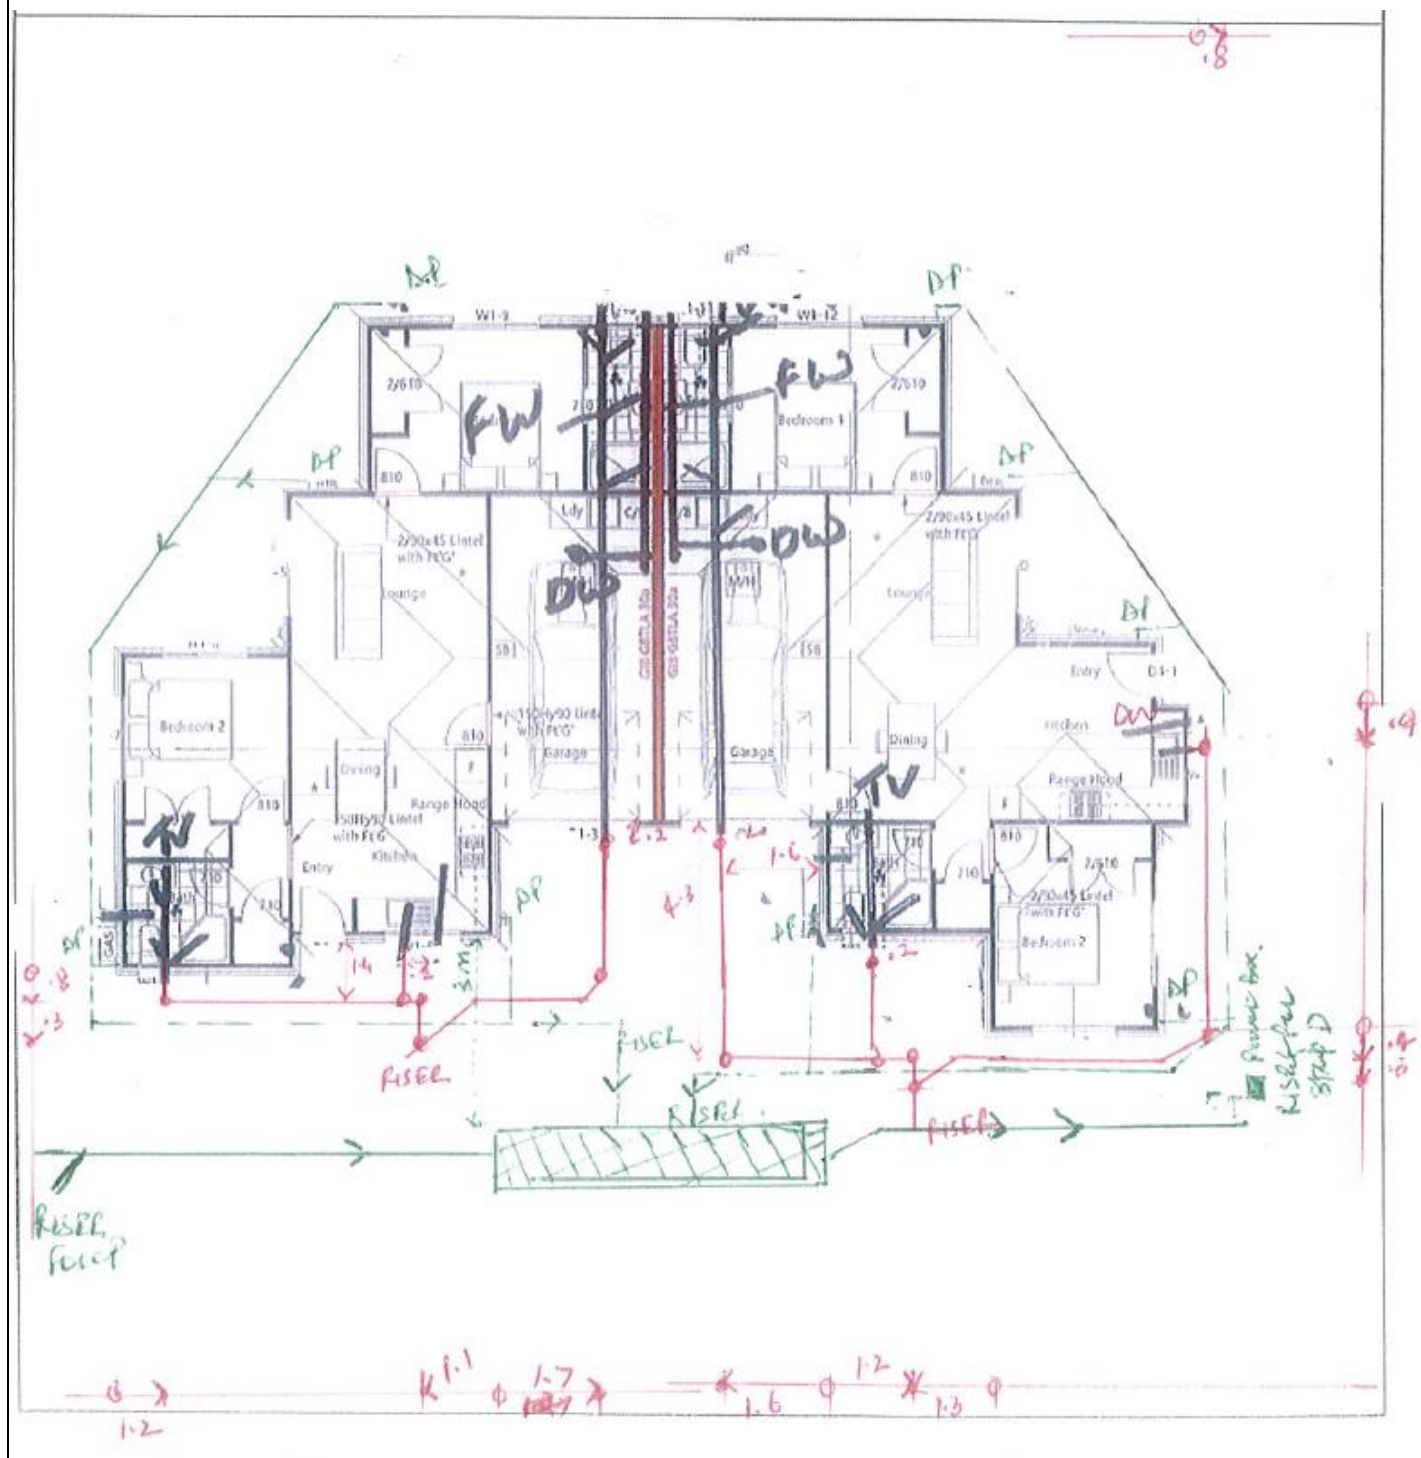



As Laid Drainage

Working Together

Building Consent Number: 2021/42222 Date: 23/02/2022 No. of pages: 1


Building Address: Units 3 & 4, 32 Glenview Terrace, Hamilton

Drain Layer Name: Matthew Noah [Please print clearly] Signature: *Matthew Noah*

Registration Number: 09771 Business Name: Jamark Plumbing Limited

To Council: [Tick]

☒ Hamilton ☐ Hauraki ☐ Matamata-Piako ☐ Otorohanga ☐ Thames-Coromandel ☐ Waipa ☐ Waikato ☐ Waitomo

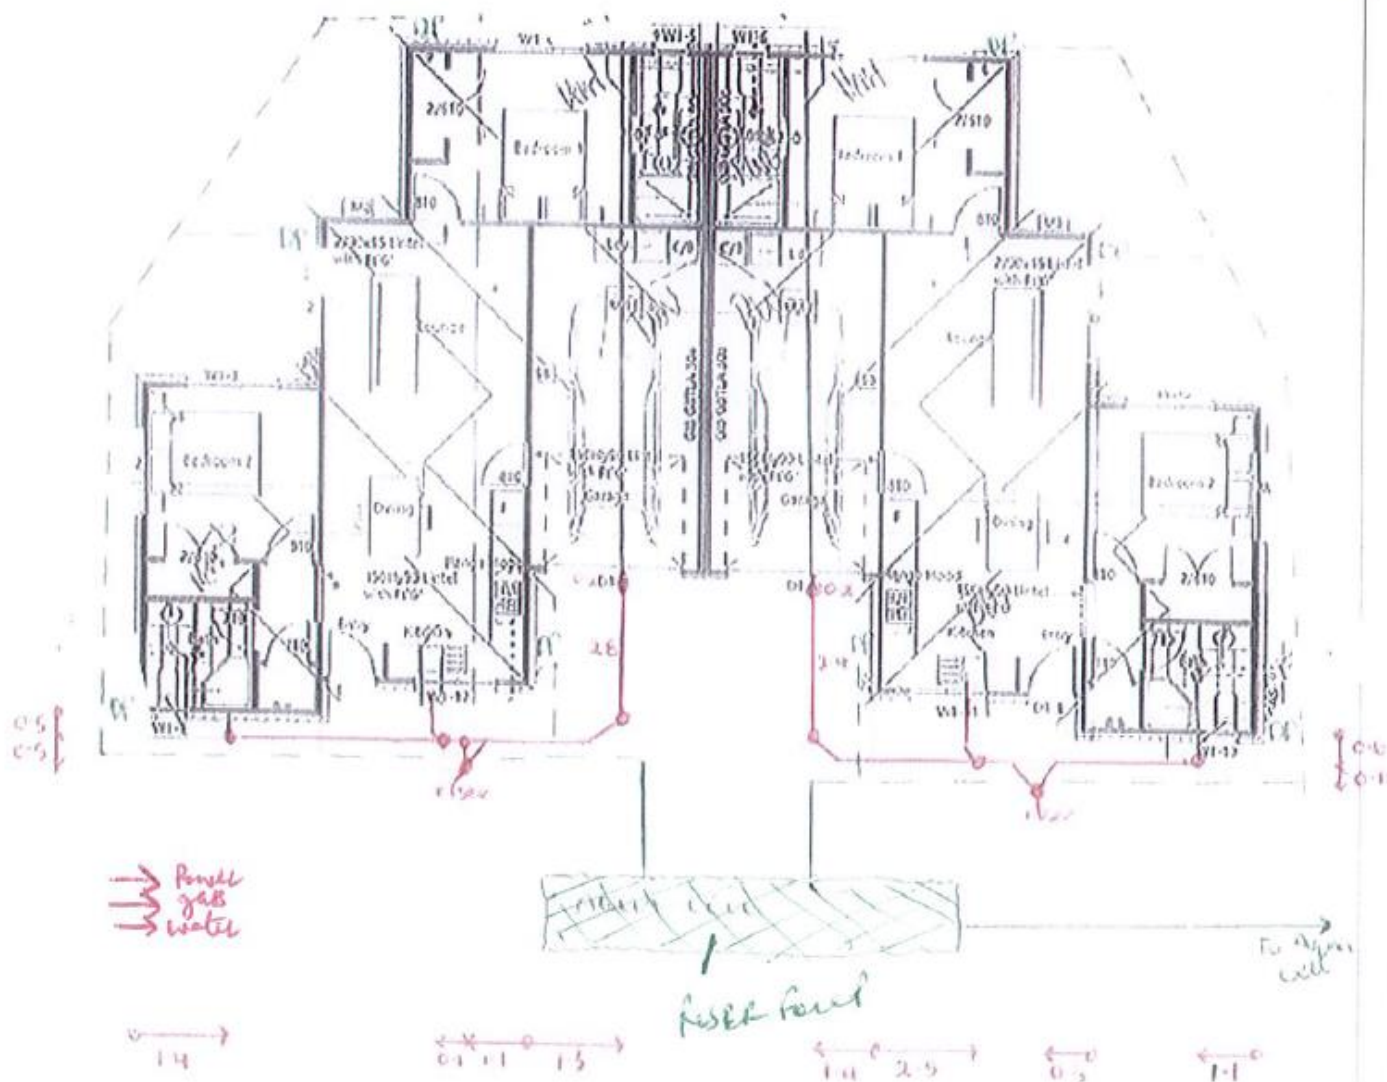



As Laid Drainage

Working Together

Building Consent Number: 2021/42222 Date: 23 / 02 / 2022 No. of pages: 1


Building Address: Units 1 & 2, 32 Glenview Terrace, Hamilton

Drain Layer Name: Matthew Noah [Please print clearly] Signature: *Matthew Noah*

Registration Number: 09771 Business Name: Jamark Plumbing Limited

To Council: [Tick]

☒ Hamilton ☐ Hauraki ☐ Matamata-Piako ☐ Otorohanga ☐ Thames-Coromandel ☐ Waipa ☐ Waikato ☐ Waitomo

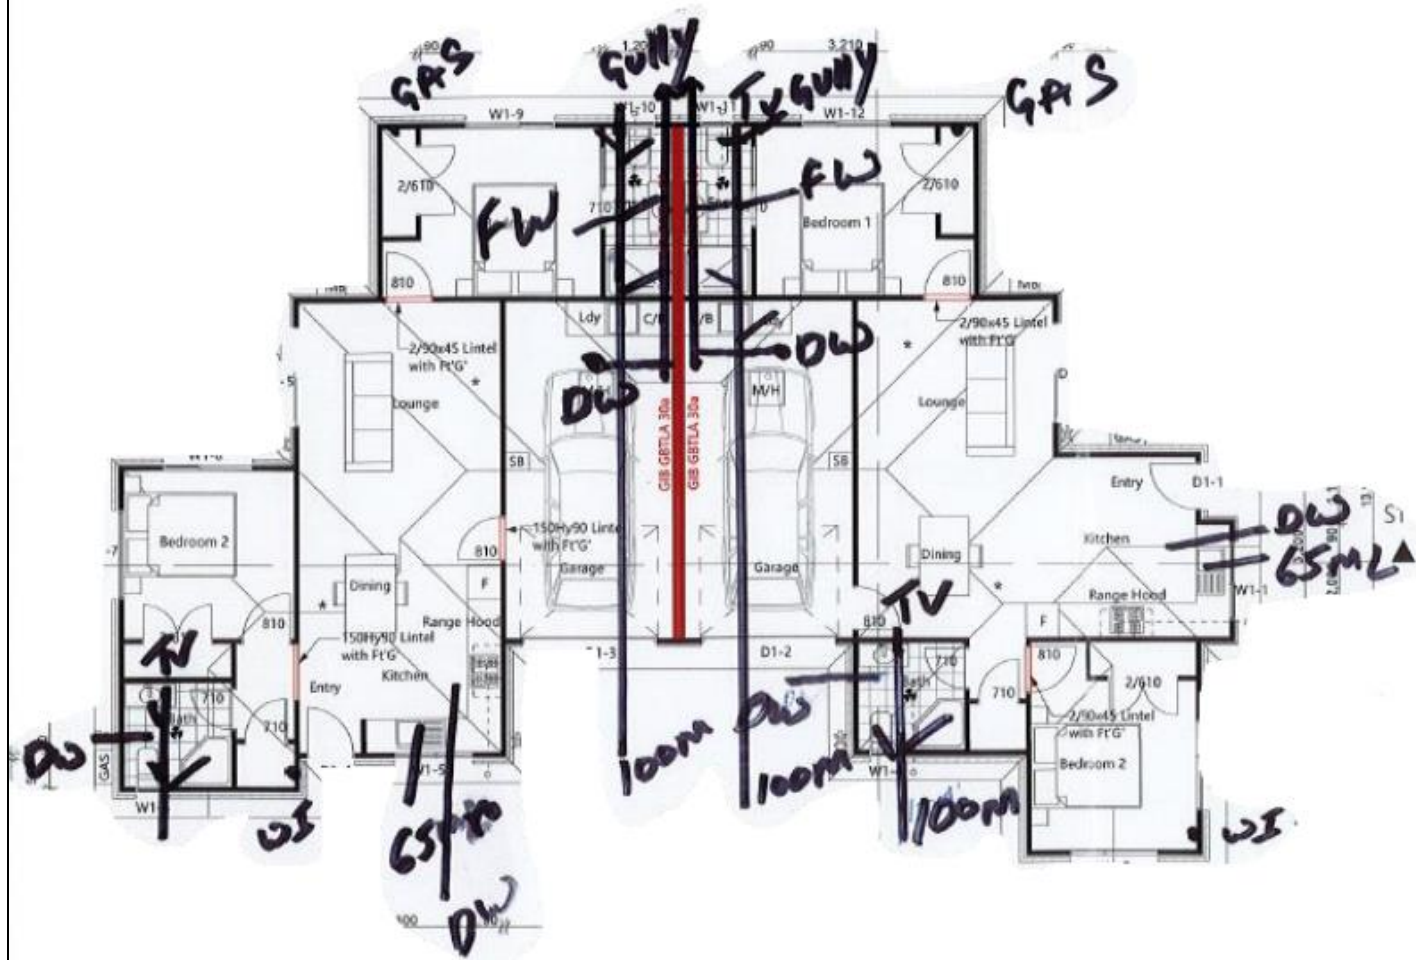

As Laid Drainage

Working Together

Building Consent Number: 2021/42222 Date: 23/ 02 / 2022 No. of pages: 1

Building Address: Units 3 & 4, 32 Glenview Terrace, Hamilton

Drain Layer Name: Matthew Noah [Please print clearly] Signature: 

Registration Number: 09771 Business Name: Jamark Plumbing Limited

To Council: *[Tick]*

☒ Hamilton ☐ Hauraki ☐ Matamata-Piako ☐ Otorohanga ☐ Thames-Coromandel ☐ Waipa ☐ Waikato ☐ Waitomo

