


Lot 8. D.P. MT Vernon Place Street No. 15
Flat 1

STILES-

Owner	Insp. Date	Description of Work	Inspector
Mr. R. Kesslence	29.1.86	Flat 1. Completed	WB

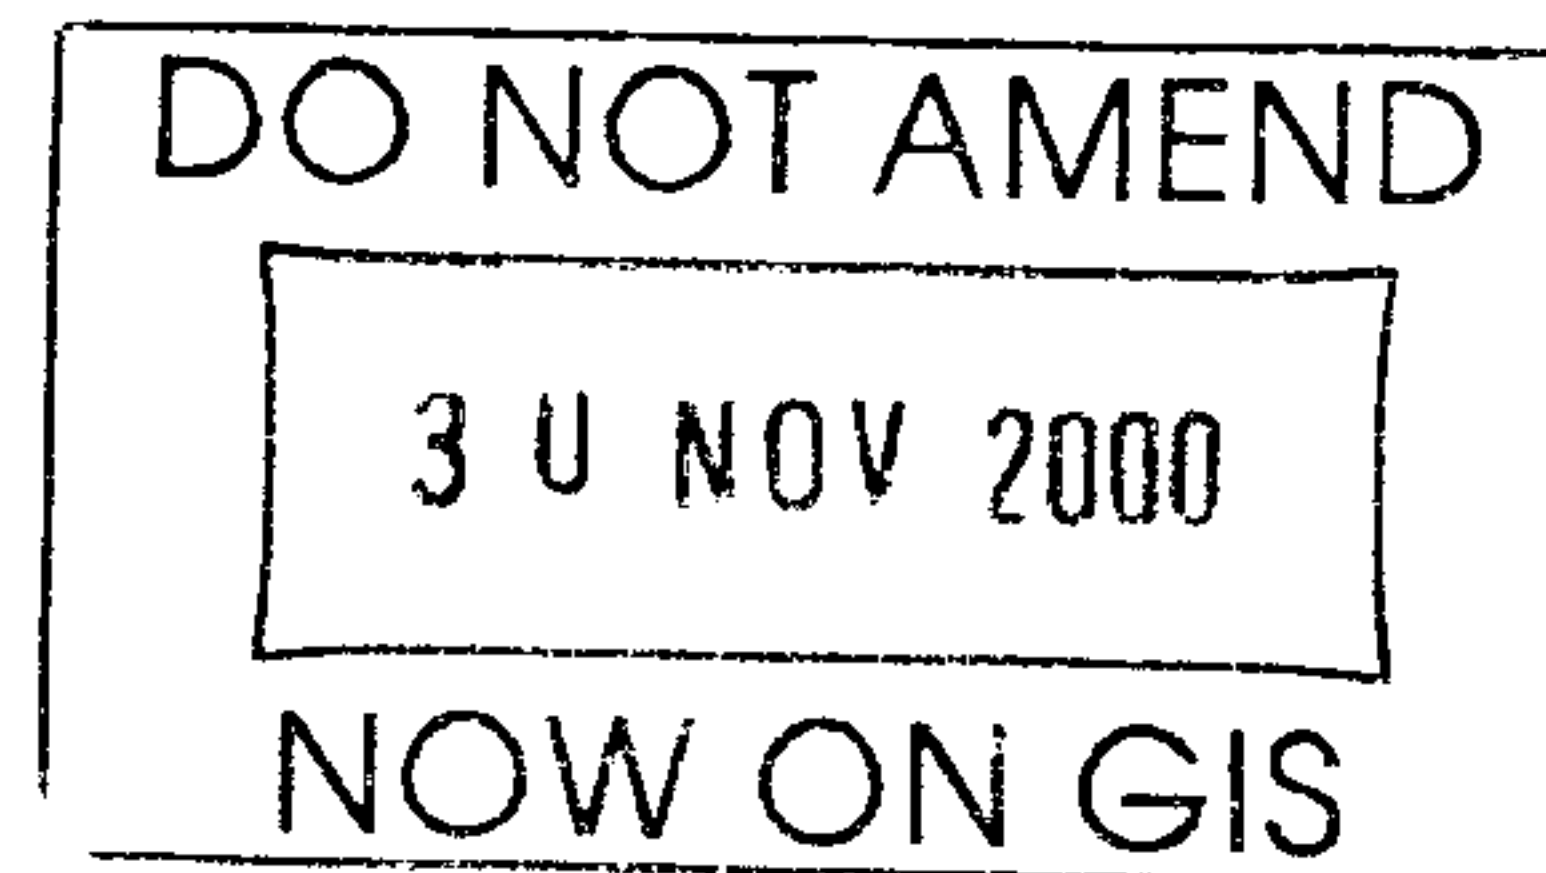

Drainlayer M. Ching

Drainage Card, City Engineers Department, Nelson

