


Lot 8 D.P. ....

Mt. Vernon Place Street No. 15  
Flat 2

STILES-

| Owner                    | Insp. Date     | Description of Work     | Inspector |
|--------------------------|----------------|-------------------------|-----------|
| <i>Fairline Builders</i> | <i>28.1.86</i> | <i>flat 2 completed</i> | <i>WB</i> |
|                          |                |                         |           |
|                          |                |                         |           |
|                          |                |                         |           |
|                          |                |                         |           |

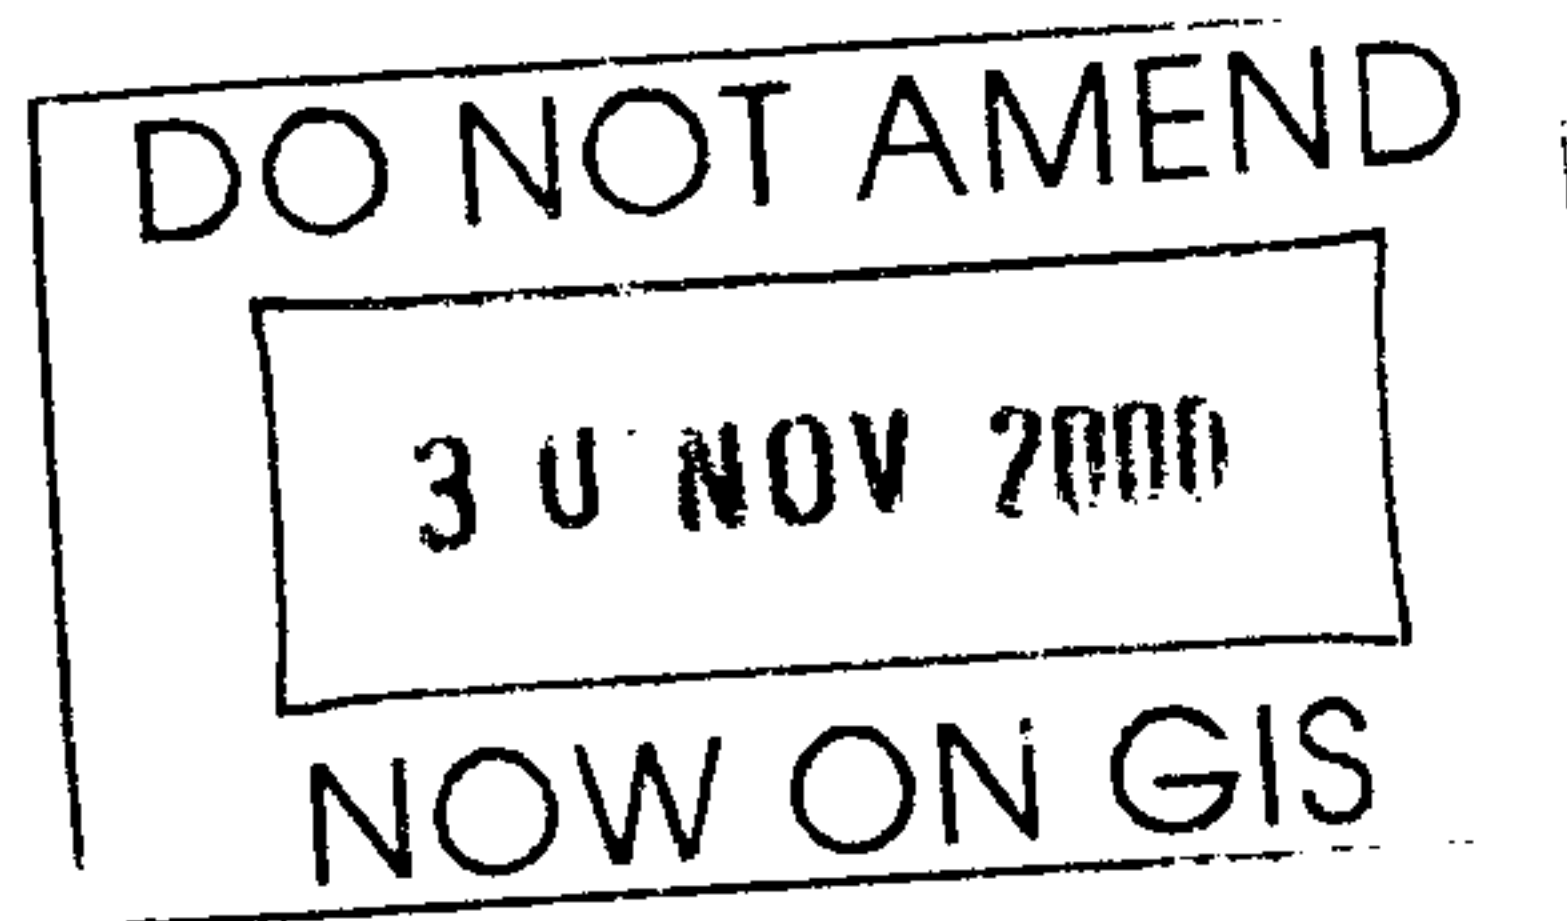

Drainlayer N. Ching

Drainage Card, City Engineers Department, Nelson

