

PROPERTY DETAILS

Name/Initials AF & JJ Surname STEWART

Company _____

Address 13-15 MOREY ST

SERVICE CONNECTION DETAILS

Approval Date 01-Nov-99
(application valid for 90 days from approval date)

Installation Date 26.11.99

WaterMain/Rider Size 500.0 Type MDPE Depth 0.6m Dist. to bdy 1.4m

Service Line Size 200 Type MDPE Length 1.2m

Connection Size 20 Type/brand _____

Meter Size 0 Type/brand _____

Number _____

Reading _____

Backflow Size 0 Type/brand _____


Flow Restrictor Size 0 L/min Type/brand _____

Pressure 750 KPA Flow (l/min) 89 l/m.

(Pressure and Flow must be recorded prior to the installation of any flow restrictor)

Comments: LOTS OF TREE ROOTS.

Site Plan

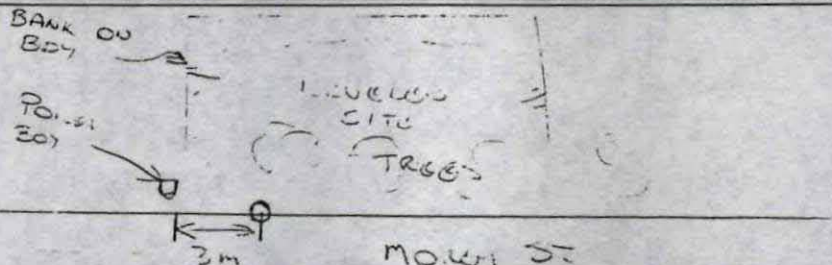

*brief site plan of the connections location - note driveway, boundary, pegs etc

LOCATION OF CONNECTION

Preferred Location 3.0M/LHB

Actual Location Dimensions 3.0 m LHB / RHB .5 m Inside / Outside

*note: All measurements must be taken from a legal boundary peg.

CERTIFICATION

I certify all the Information on this form as being complete and correct, and that all materials and works are in accordance with the specifications for connections and all relevant documents.

Name CC Campbell Signed Chris Campbell Date 26.11.99

Authorised Contractor Number N00 ISSUED

Total Value of Work \$ _____ (GST Exclusive)

This information is required under local Authority and will not be made available for public use.

PF 21984

