

PROPOSED DRAINAGE PLAN FOR


S & J. CANTWELL

LOT 19 GOVAN DRIVE EXTENSION

05-02


1. INJECTION TO GROUND LEVEL.
2. W.C. & TERMINAL VENT.
3. INSPECTION
4. INSPECTION
5. INSPECTION
6. COUNCIL CONNECTION WITH INSPEC TO GL.

----- STORM WATER

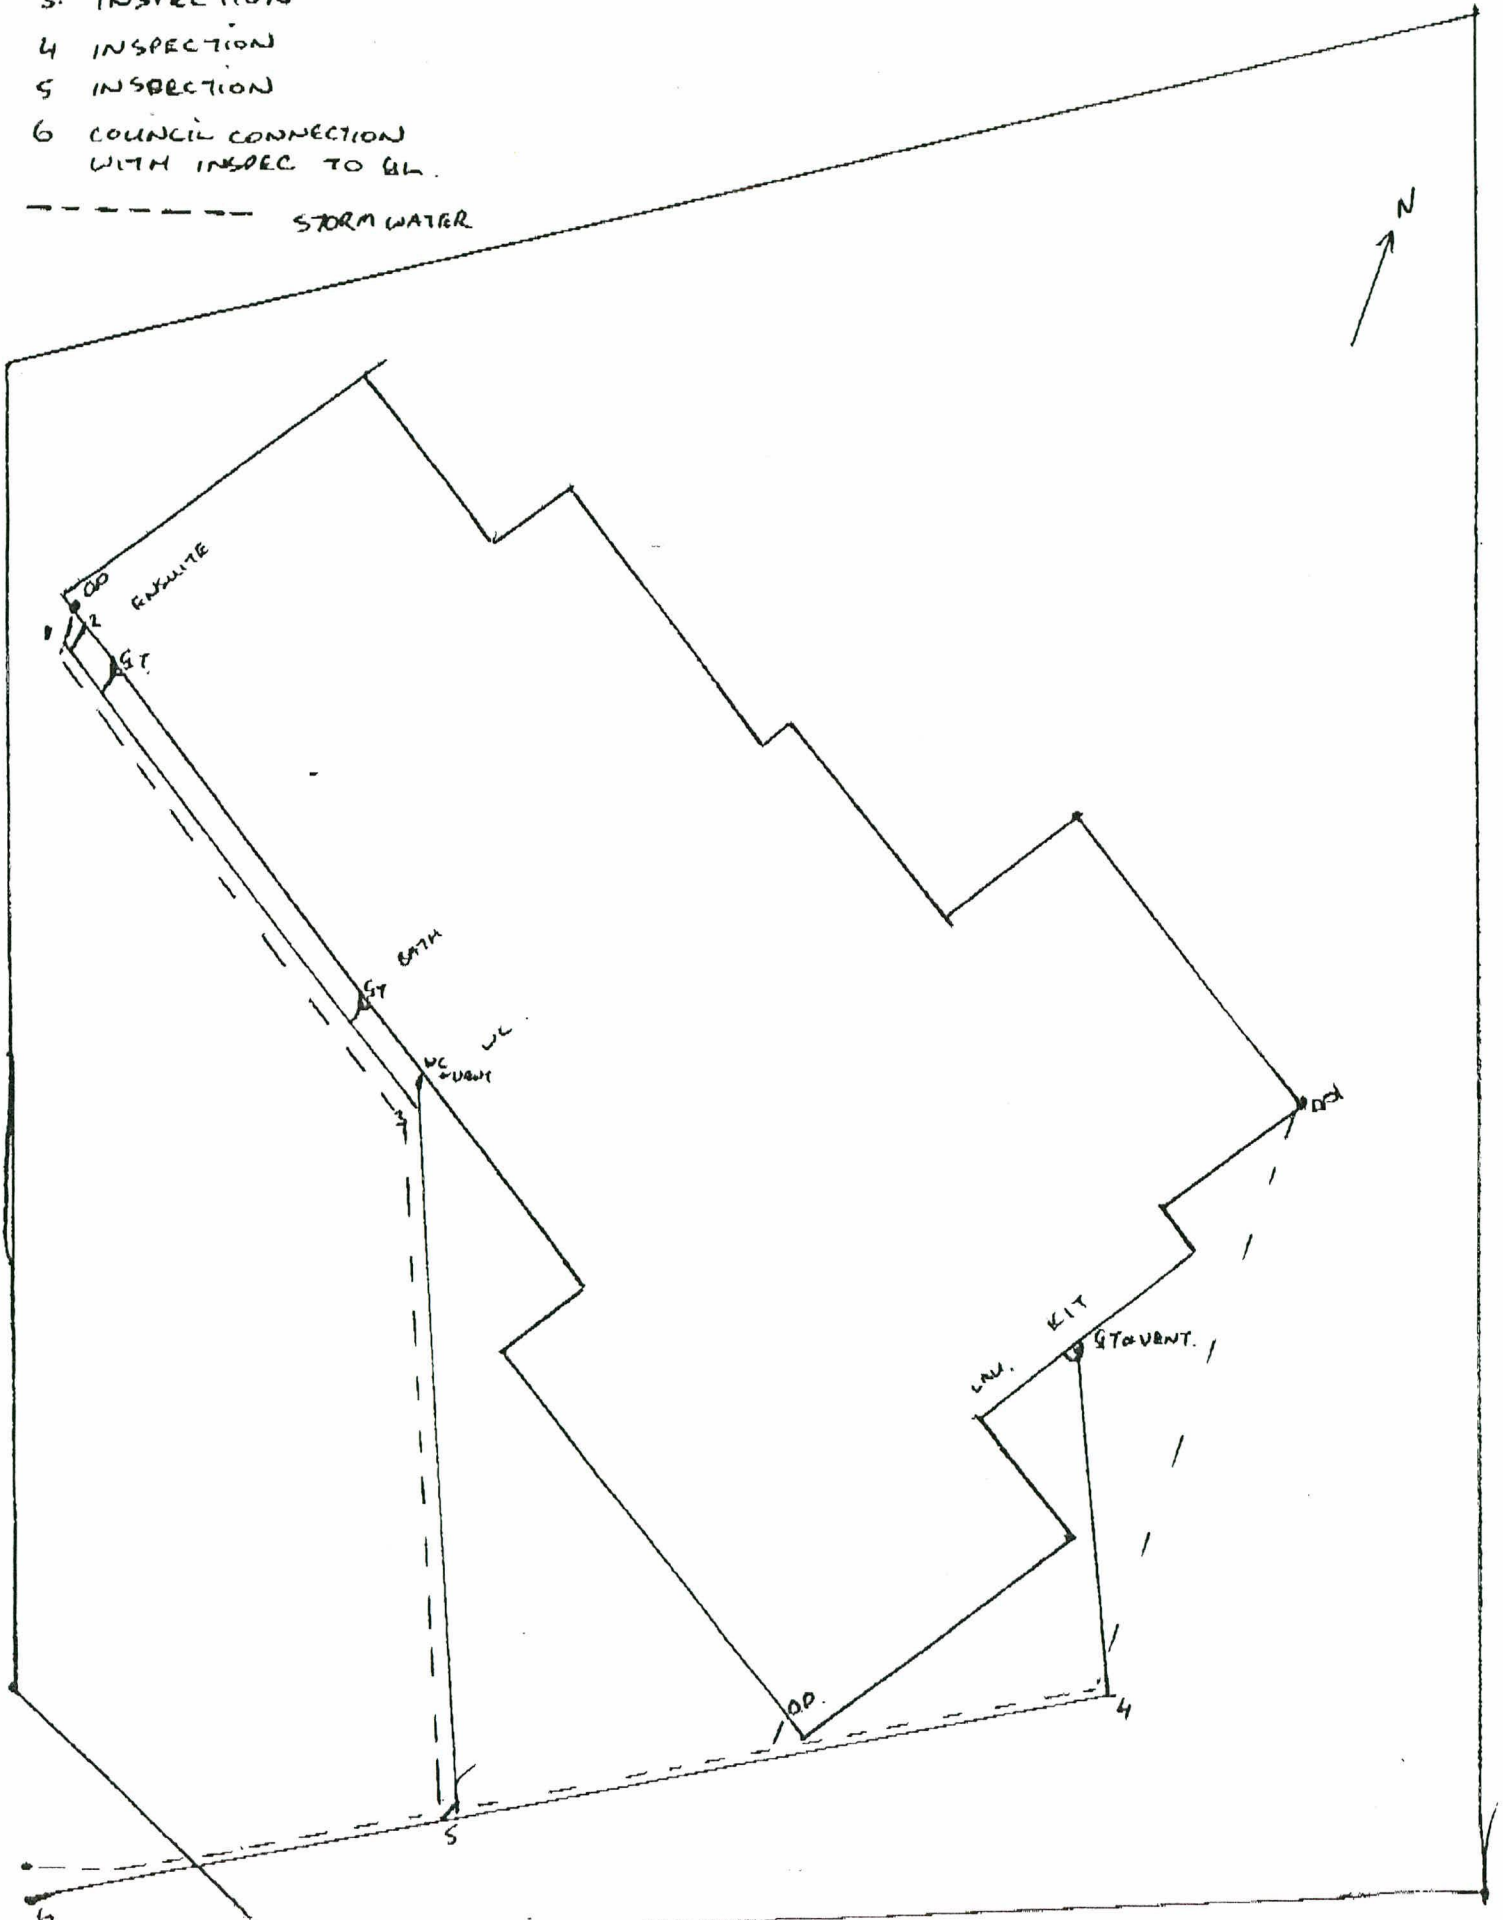

New Home for Sean + Judith Cantwell
Govan Drive Te Anau
Lot 19.

Scale 1:100

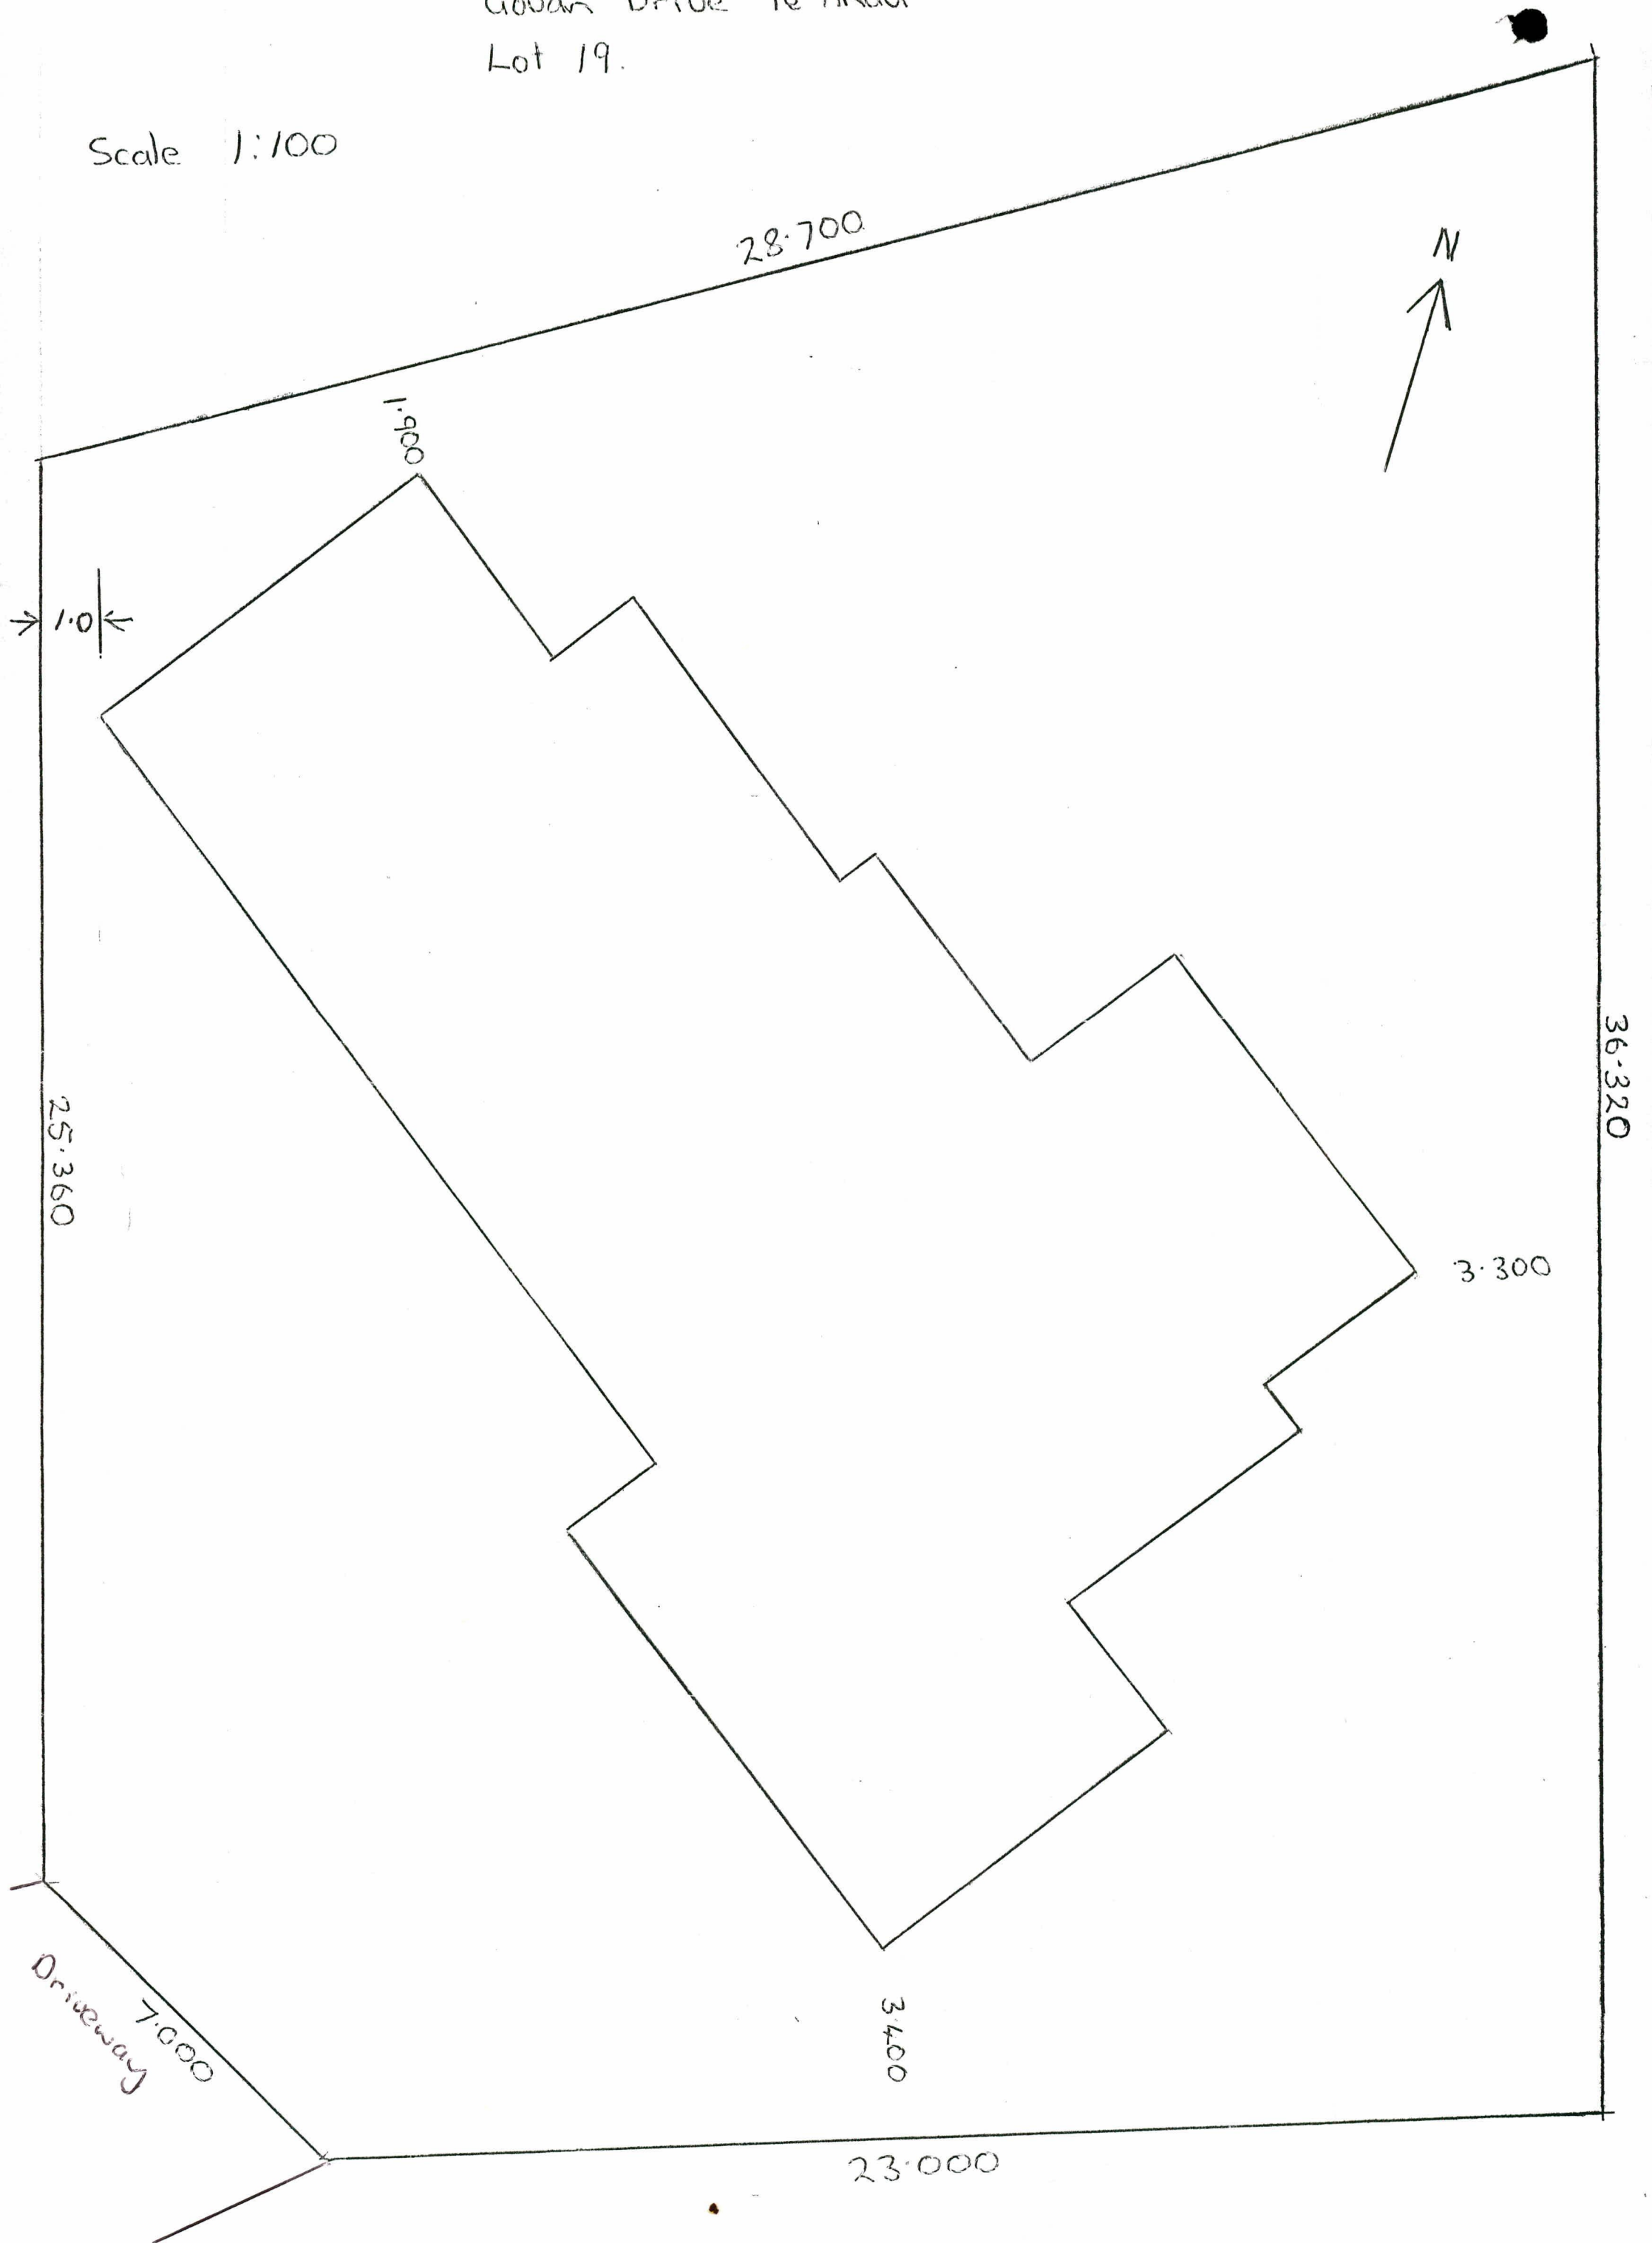

New Home for Sean + Judith Cantwell
Govan Drive Te Anau
Lot 19.

CONSTANT 23529
3535/114

FILE COPY

Scale 1:100

28.700

AS Laid DRAINAGE PLAN

— Foul Sewer.
- - - Storm Water.

1. W.C. TO. & INSPECTION ON RISER.
2. INSPECTION TO G.H. 1350 OUT FROM GULLY DISH.
3. INSPECTION G.H. 650 OUT FROM FOUNDATION.
4. INSPECTION 1800 OUT FROM FOUNDATION 2100 FROM POLE APPROX 1000 DEEP.
5. INSPECTION 550 OUT FROM GULLY DISH.
6. INSPECTIONS F.S. & S.W. TO G.H. IN STEEL BOX IN DRIVE.

N

1.0

ENRUTE

25.360

1.900

BATH

W.C.

3.300

KITCHEN

LAUNDRY

3.400

23.000

36.320