
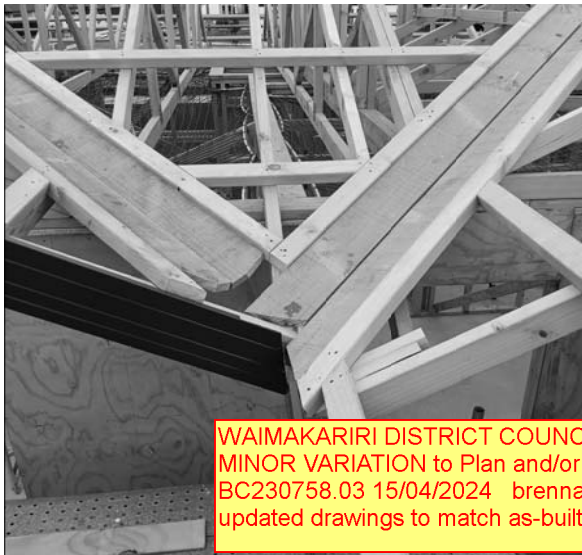
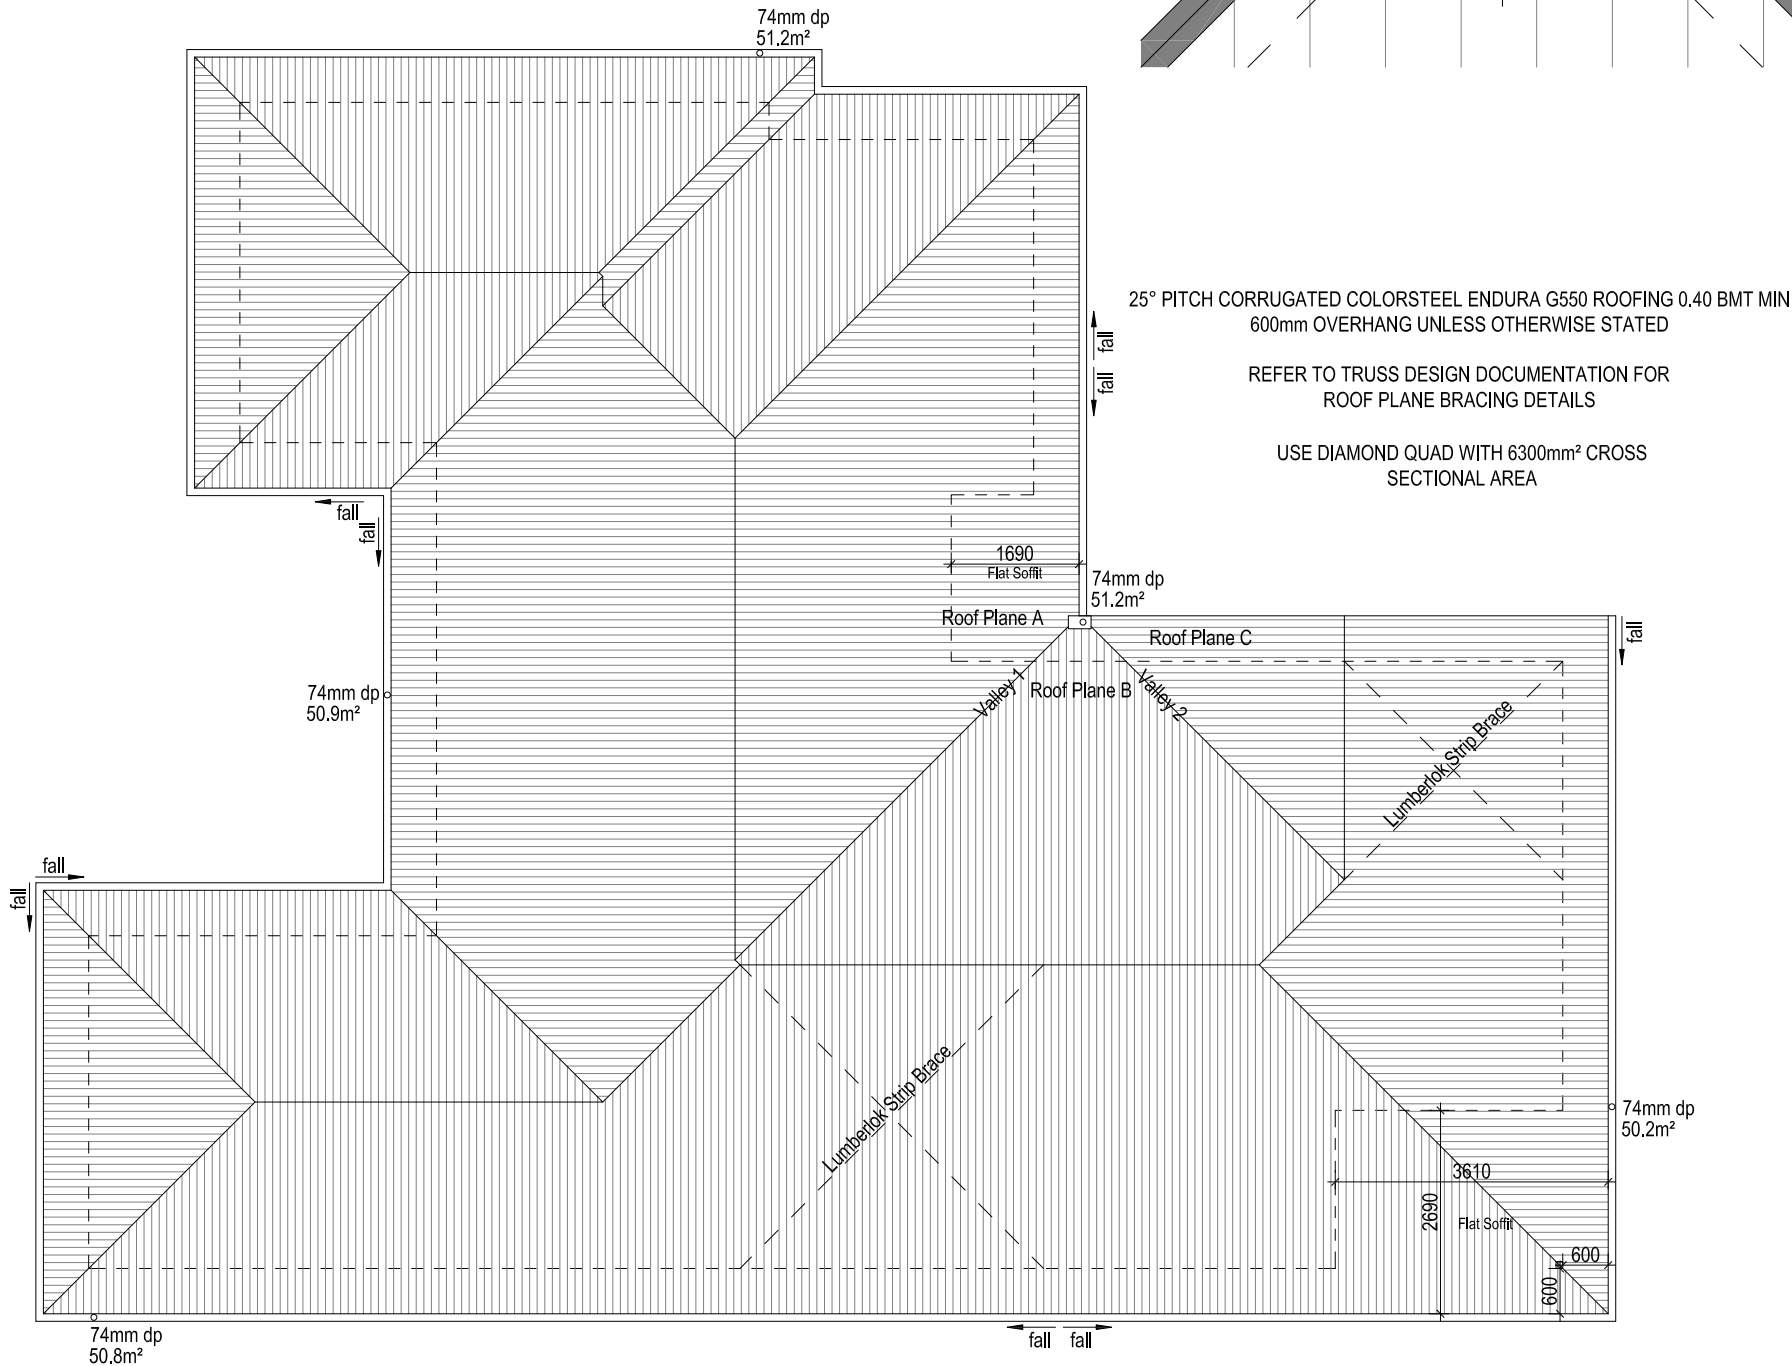
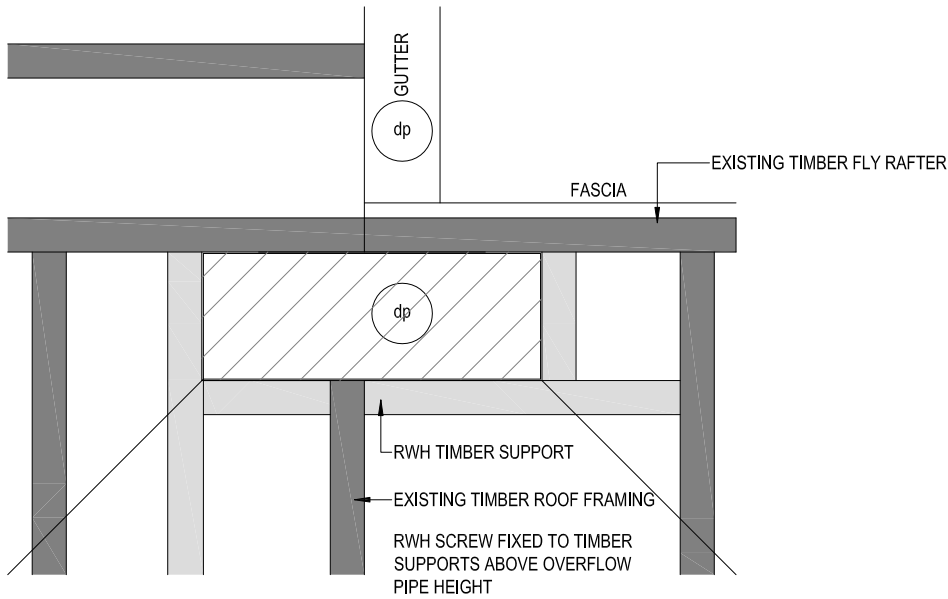
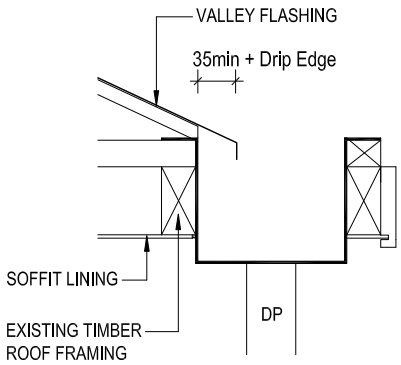


ALLOW FOR EXPANSION JOINTS
TO GUTTERS - DARK COLOURS = 9.0m
LIGHT COLOURS = 12.0m

USE 90 x 45 @ 900crs ON EDGE
HORIZONTALLY SUPPORTING SOFFIT
LININGS TO SOFFITS OVER 750mm WIDE

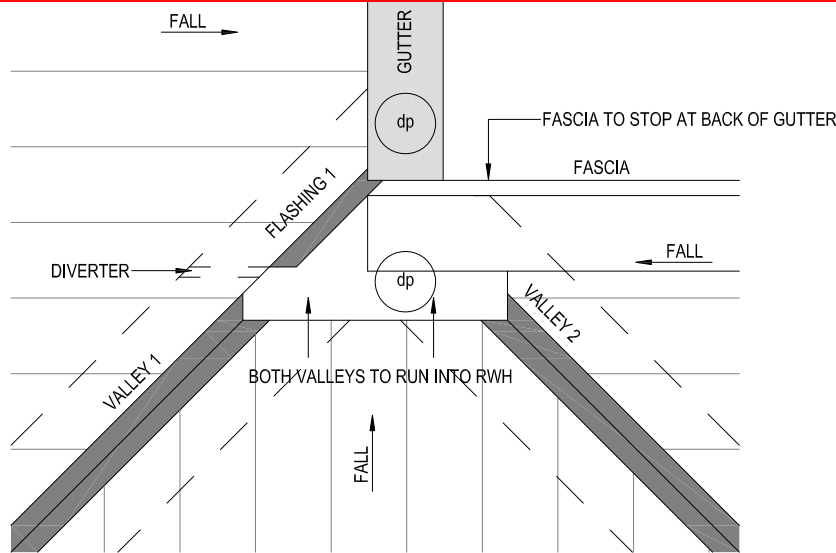

WAIMAKARIRI DISTRICT COUNCIL
MINOR VARIATION to Plan and/or Specifications APPROVED
BC230758.03 15/04/2024 brennao
updated drawings to match as-built RWH

a.s.c.a.d.
limited
ascadltd@snap.net.nz
0272 838 775

job title:
BADDOCK - LOT 115

drawing title:
ROOF PLAN
11/09/23 REV B - Notes updated
09/02/24 REV E - RWH added
21/02/24 REV F - Details added
25/03/24 REV G - Details updated

legal description:
Lot 115
Townsend
RANGIORA

WORKING DRAWINGS
SUBJECT TO COUNCIL APPROVAL
ALL MEASUREMENTS TO BE CONFIRMED
ON SITE BY CONTRACTOR PRIOR TO
THE COMMENCEMENT OF WORK
DO NOT SCALE FROM DRAWINGS UNDER ANY
CIRCUMSTANCES

scale:
1:100
Job No.:
-

page:
10g
of: 25
DATE: 18/07/23



WAIMAKARIRI DISTRICT COUNCIL
MINOR VARIATION to Plan and/or Specifications APPROVED
BC230758.03 15/04/2024 brennao
updated drawings to match as-built RWH

a.s.c.a.d. limited ascadltd@snap.net.nz 0272 838 775	job title: BADDOCK - LOT 115	drawing title: DETAILS 25/03/24 REV G - New sheet	legal description: Lot 115 Townsend RANGIORA	WORKING DRAWINGS SUBJECT TO COUNCIL APPROVAL ALL MEASUREMENTS TO BE CONFIRMED ON SITE BY CONTRACTOR PRIOR TO THE COMMENCEMENT OF WORK DO NOT SCALE FROM DRAWINGS UNDER ANY CIRCUMSTANCES	scale: 1:10 Job No.: -	page: 26g of: 25 DATE: 18/07/23
---	--	---	--	---	---	---



WAIMAKARIRI DISTRICT COUNCIL
MINOR VARIATION to Plan and/or Specifications APPROVED
BC230758.03 15/04/2024 brennao
updated drawings to match as-built RWH

a.s.c.a.d. limited ascadltd@snap.net.nz 0272 838 775	job title: BADDOCK - LOT 115	drawing title: DETAILS 25/03/24 REV G - New sheet	legal description: Lot 115 Townsend RANGIORA	WORKING DRAWINGS SUBJECT TO COUNCIL APPROVAL ALL MEASUREMENTS TO BE CONFIRMED ON SITE BY CONTRACTOR PRIOR TO THE COMMENCEMENT OF WORK DO NOT SCALE FROM DRAWINGS UNDER ANY CIRCUMSTANCES	scale: 1:10 Job No.: -	page: 27g of: 25 DATE: 18/07/23
---	--	---	--	---	---	---