



ROW 1

DWV 150 345 100/1.0

75.05

DWV 150 345 100/1.0

WW LATERAL
IL: 47.094
ME: 1549363.959
MN: 5171265.693

1

ORIGIN OF LEVELS:	BM UG32 (B882)
REDUCED LEVEL:	55.597m
DATUM:	NZVD2016
SITE BENCHMARK:	IRON TUBE FLUSH IN SEAL
REDUCED LEVEL:	48.644m

REV	DATE	REVISION DETAILS	ISSUED
A	14/10/2025	As-Built	D.Varkey

DRAFTED BY D.Varkey	VERIFIED BY L.Bellingan	VERIFIED DATE 14/10/2025
------------------------	----------------------------	-----------------------------


PROJECT
**15168-26 JOZECOM PLACE,
ROLLESTON**

CLIENT
ANDY CROSSBIE



CONTACT
OFFICE: [24a Sheffield Crescent, Christchurch 8053](#)
OFFICE: PO Box 5558, Papanui, Christchurch
PHONE: 0508 787 887
EMAIL: hello@survus.co.nz

DRAWING TITLE AS BUILT WASTEWATER RETICULATION		
PROJECT NO	SCALE	SIZE
15168	1:200	A3
DRAWING NO	STATUS	REVISION
AB-WW02	AS-BUILT	A

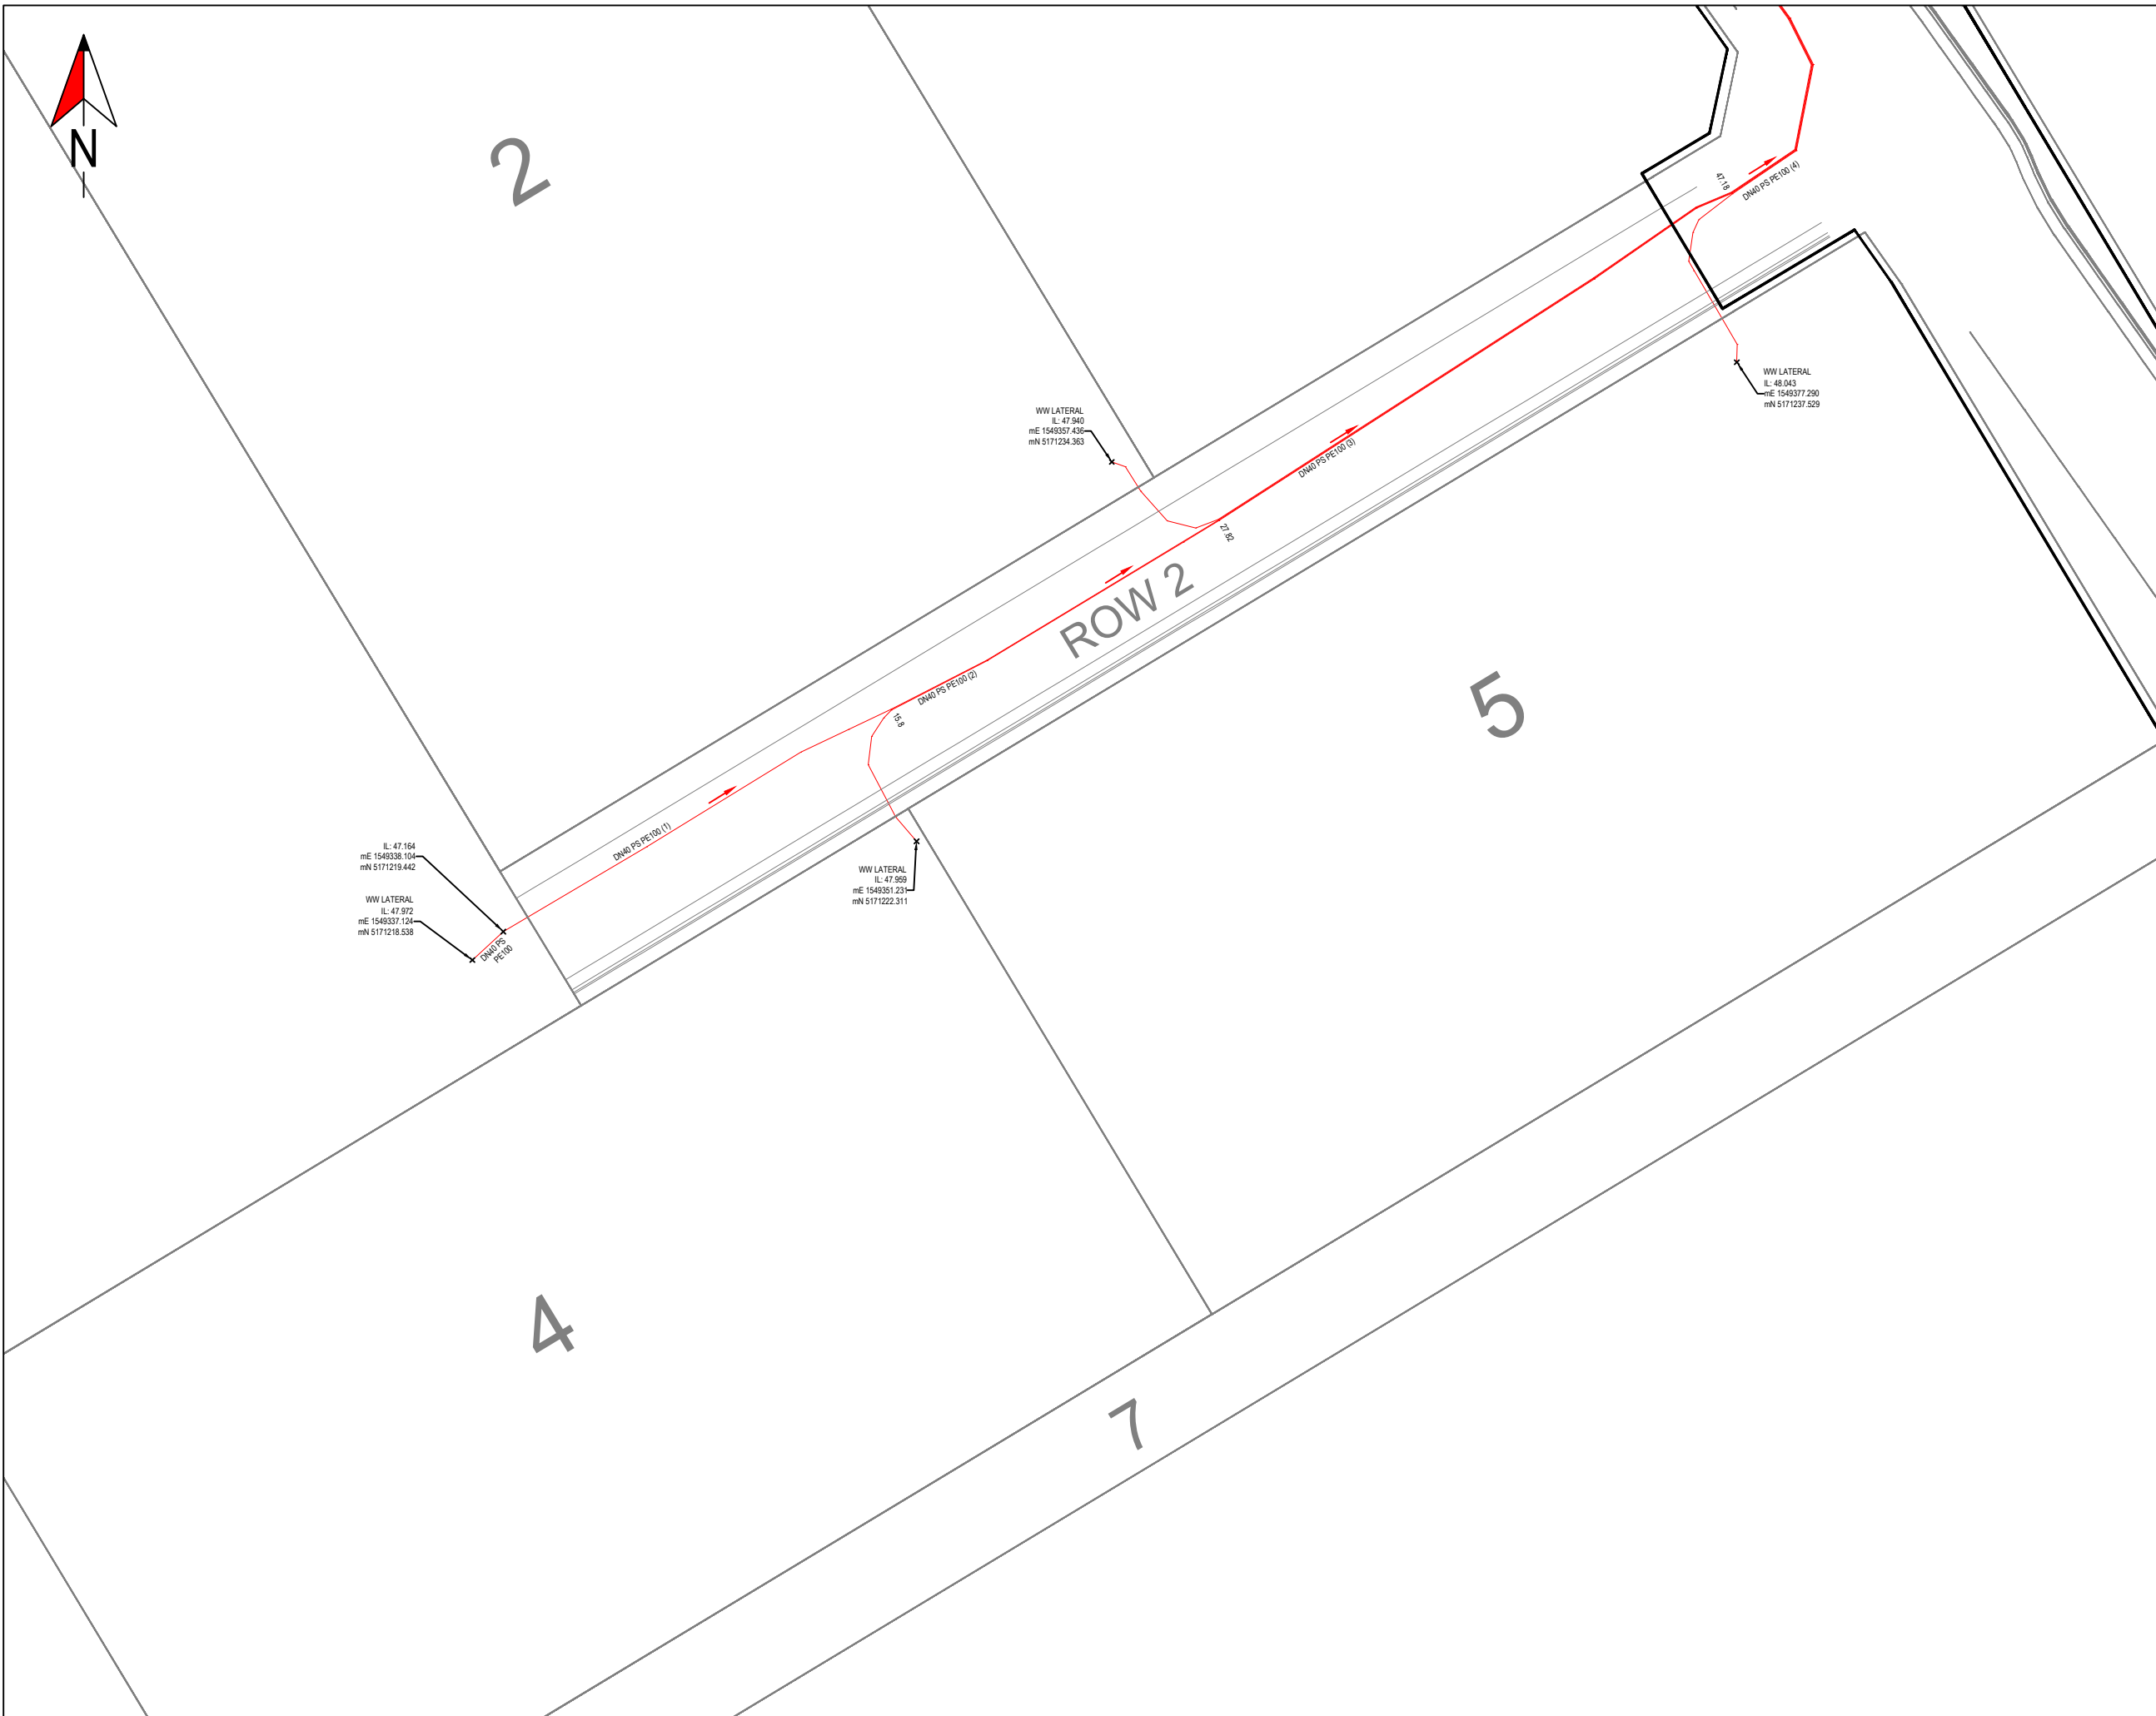

ORIGIN OF LEVELS:	BM UG32 (B882)
REDUCED LEVEL:	55.597m
DATUM:	NZVD2016
SITE BENCHMARK:	IRON TUBE FLUSH IN SEAL
REDUCED LEVEL:	48.644m

REV	DATE	REVISION DETAILS	ISSUED
A	14/10/2025	As-Built	D.Varkey

DRAFTED BY	VERIFIED BY	VERIFIED DATE
D.Varkey	L.Bellingan	14/10/2025

PROJECT
**15168-26 JOZECOM PLACE,
 ROLLESTON**

CLIENT
ANDY CROSBIE




CONTACT
 OFFICE: [24a Sheffield Crescent, Christchurch 8053](#)
 OFFICE: PO Box 5558, Papanui, Christchurch
 PHONE: 0508 787 887
 EMAIL: hello@survus.co.nz

DRAWING TITLE
**AS BUILT WASTEWATER
 RETICULATION**

PROJECT NO	SCALE	SIZE
15168	1:200	A3
DRAWING NO	STATUS	REVISION
AB-WW03	AS-BUILT	A

SURVUS 26 JOZECOM PLACE WASTEWATER AS-BUILT PLAN 15168

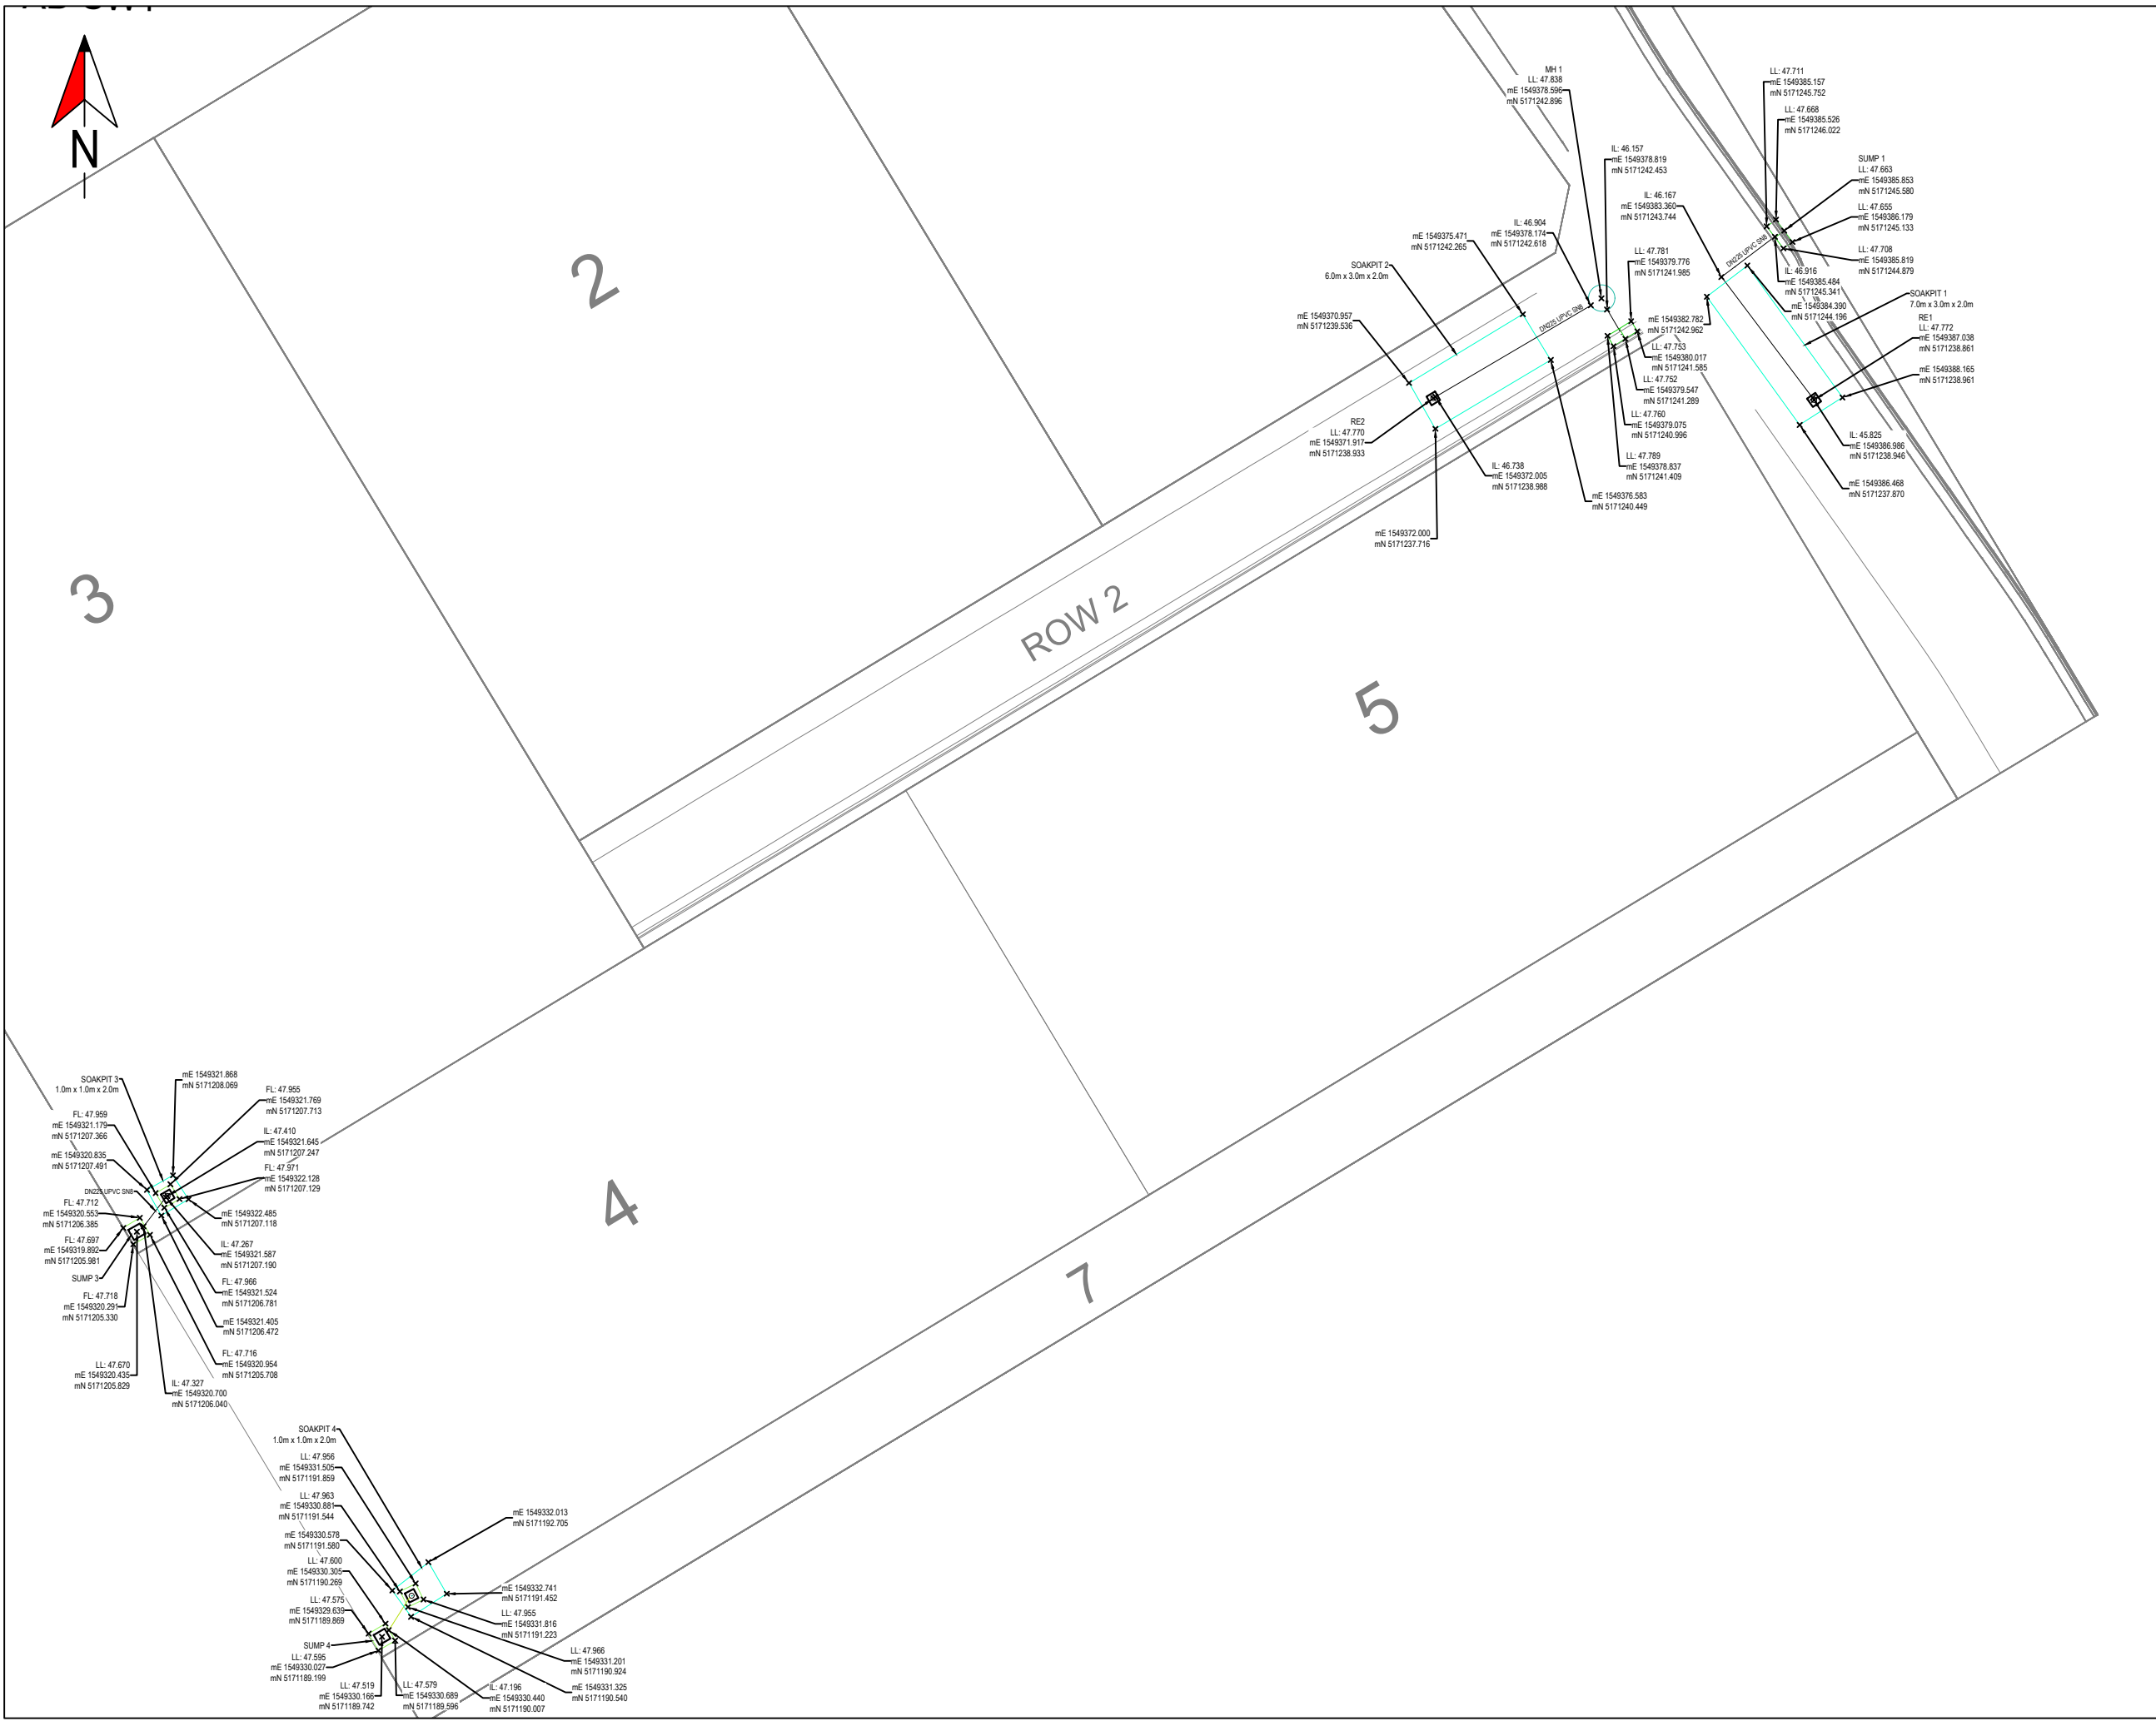

ORIGIN OF LEVELS: BM UG32 (B882)
 REDUCED LEVEL: 55.597m
 DATUM: NZVD2016
 SITE BENCHMARK: IRON TUBE FLUSH IN SEAL
 REDUCED LEVEL: 48.644m

REV	DATE	REVISION DETAILS	ISSUED
A	08/10/2025	As-Built	D.Varkey

DRAFTED BY	VERIFIED BY	VERIFIED DATE
D.Varkey	L. Bellingan	08/10/2025

PROJECT
 15168-26 JOZECOM PLACE,
 ROLLESTON

CLIENT
 ANDY CROSBIE



CONTACT
 OFFICE: 24a Sheffield Crescent, Christchurch 8053
 OFFICE: PO Box 5558, Papanui, Christchurch
 PHONE: 0508 787 887
 EMAIL: hello@survus.co.nz

DRAWING TITLE
 AS BUILT STORMWATER
 RETICULATION


PROJECT NO	SCALE	SIZE
15168	1:250	A3
DRAWING NO	STATUS	REVISION
AB-SW1	AS-BUILT	A

26 JOZECOM PLACE STORMWATER ASBUILT NETWORK



EXISTING DN50 PVCU - RIDER
WATER SUPPLY CONNECTION

PROPERTY BOUNDARY

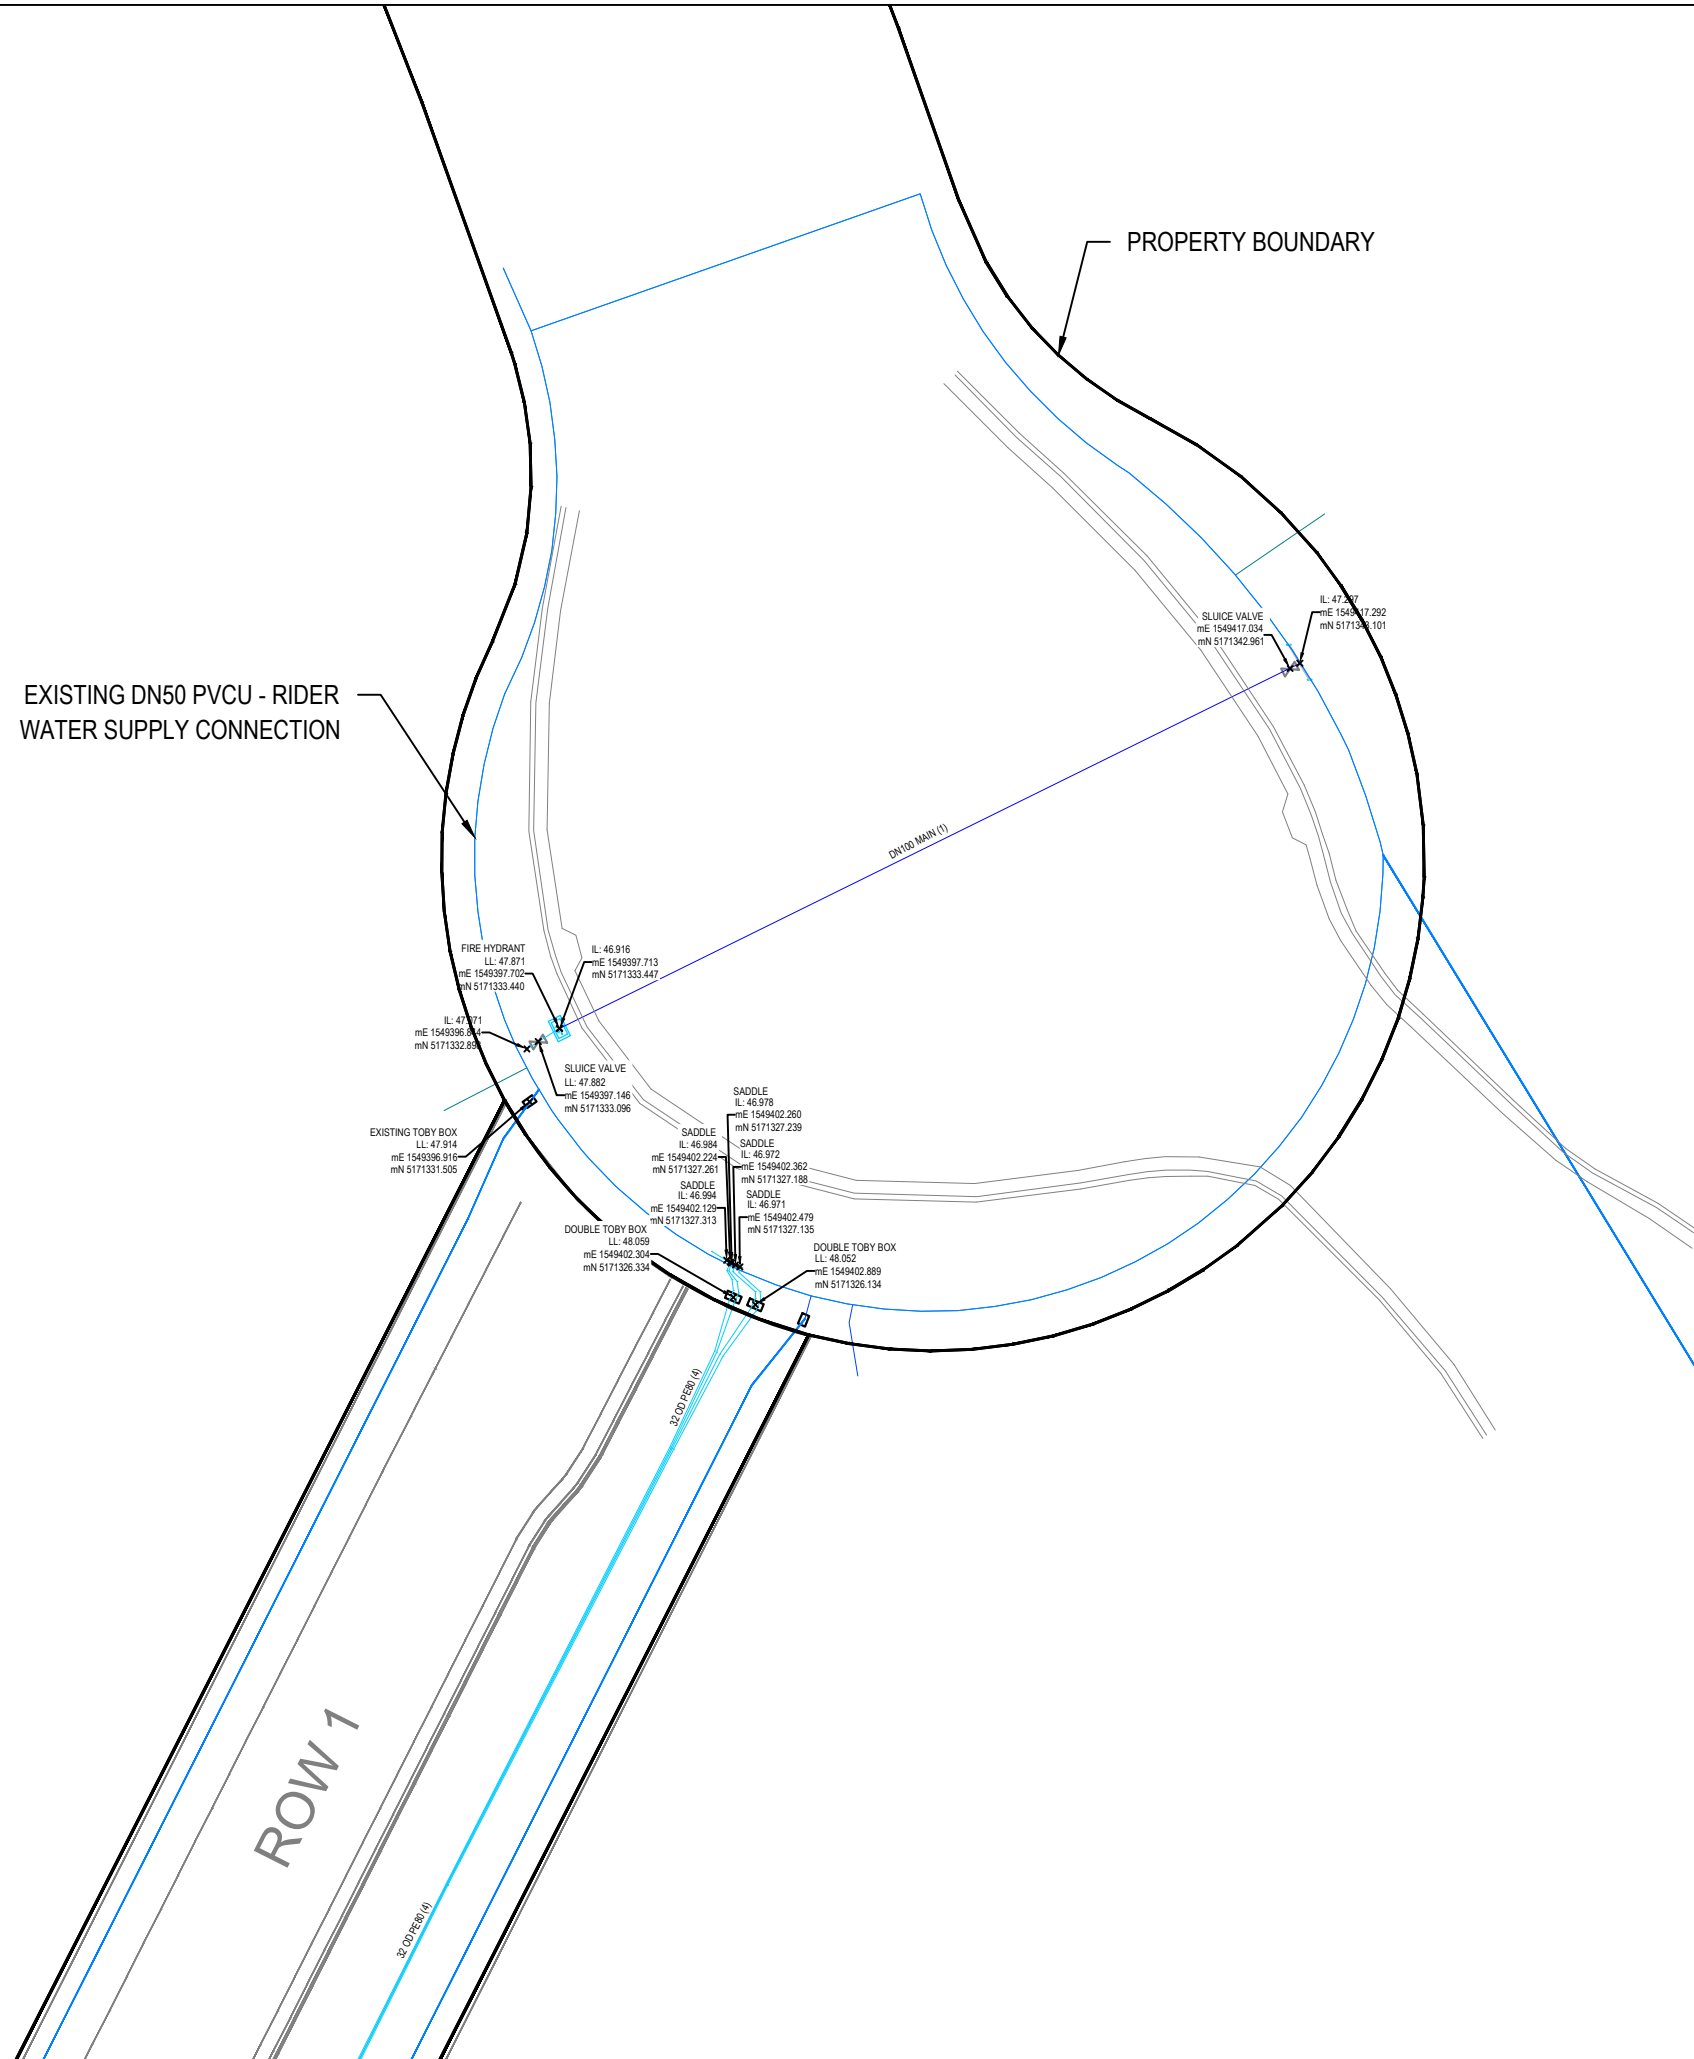

ORIGIN OF LEVELS:	BM UG32 (B882)
REDUCED LEVEL:	55.597m
DATUM:	NZVD2016
SITE BENCHMARK:	IRON TUBE FLUSH IN SEAL
REDUCED LEVEL:	48.644m

REV	DATE	REVISION DETAILS	ISSUED
A	14/10/2025	As-Built	D.Varkey

DRAFTED BY	VERIFIED BY	VERIFIED DATE
D.Varkey	L.Bellingan	14/10/2025

PROJECT
15168-26 JOZECOM PLACE,
ROLLESTON

CLIENT
ANDY CROSBIE




CONTACT
OFFICE: 24a Sheffield Crescent, Christchurch 8053
OFFICE: PO Box 5558, Papanui, Christchurch
PHONE: 0508 787 887
EMAIL: hello@survus.co.nz

DRAWING TITLE

AS BUILT WATER RETICULATION

PROJECT NO	SCALE	SIZE
15168	1:200	A3
DRAWING NO	STATUS	REVISION
AB-WS01	AS-BUILT	A

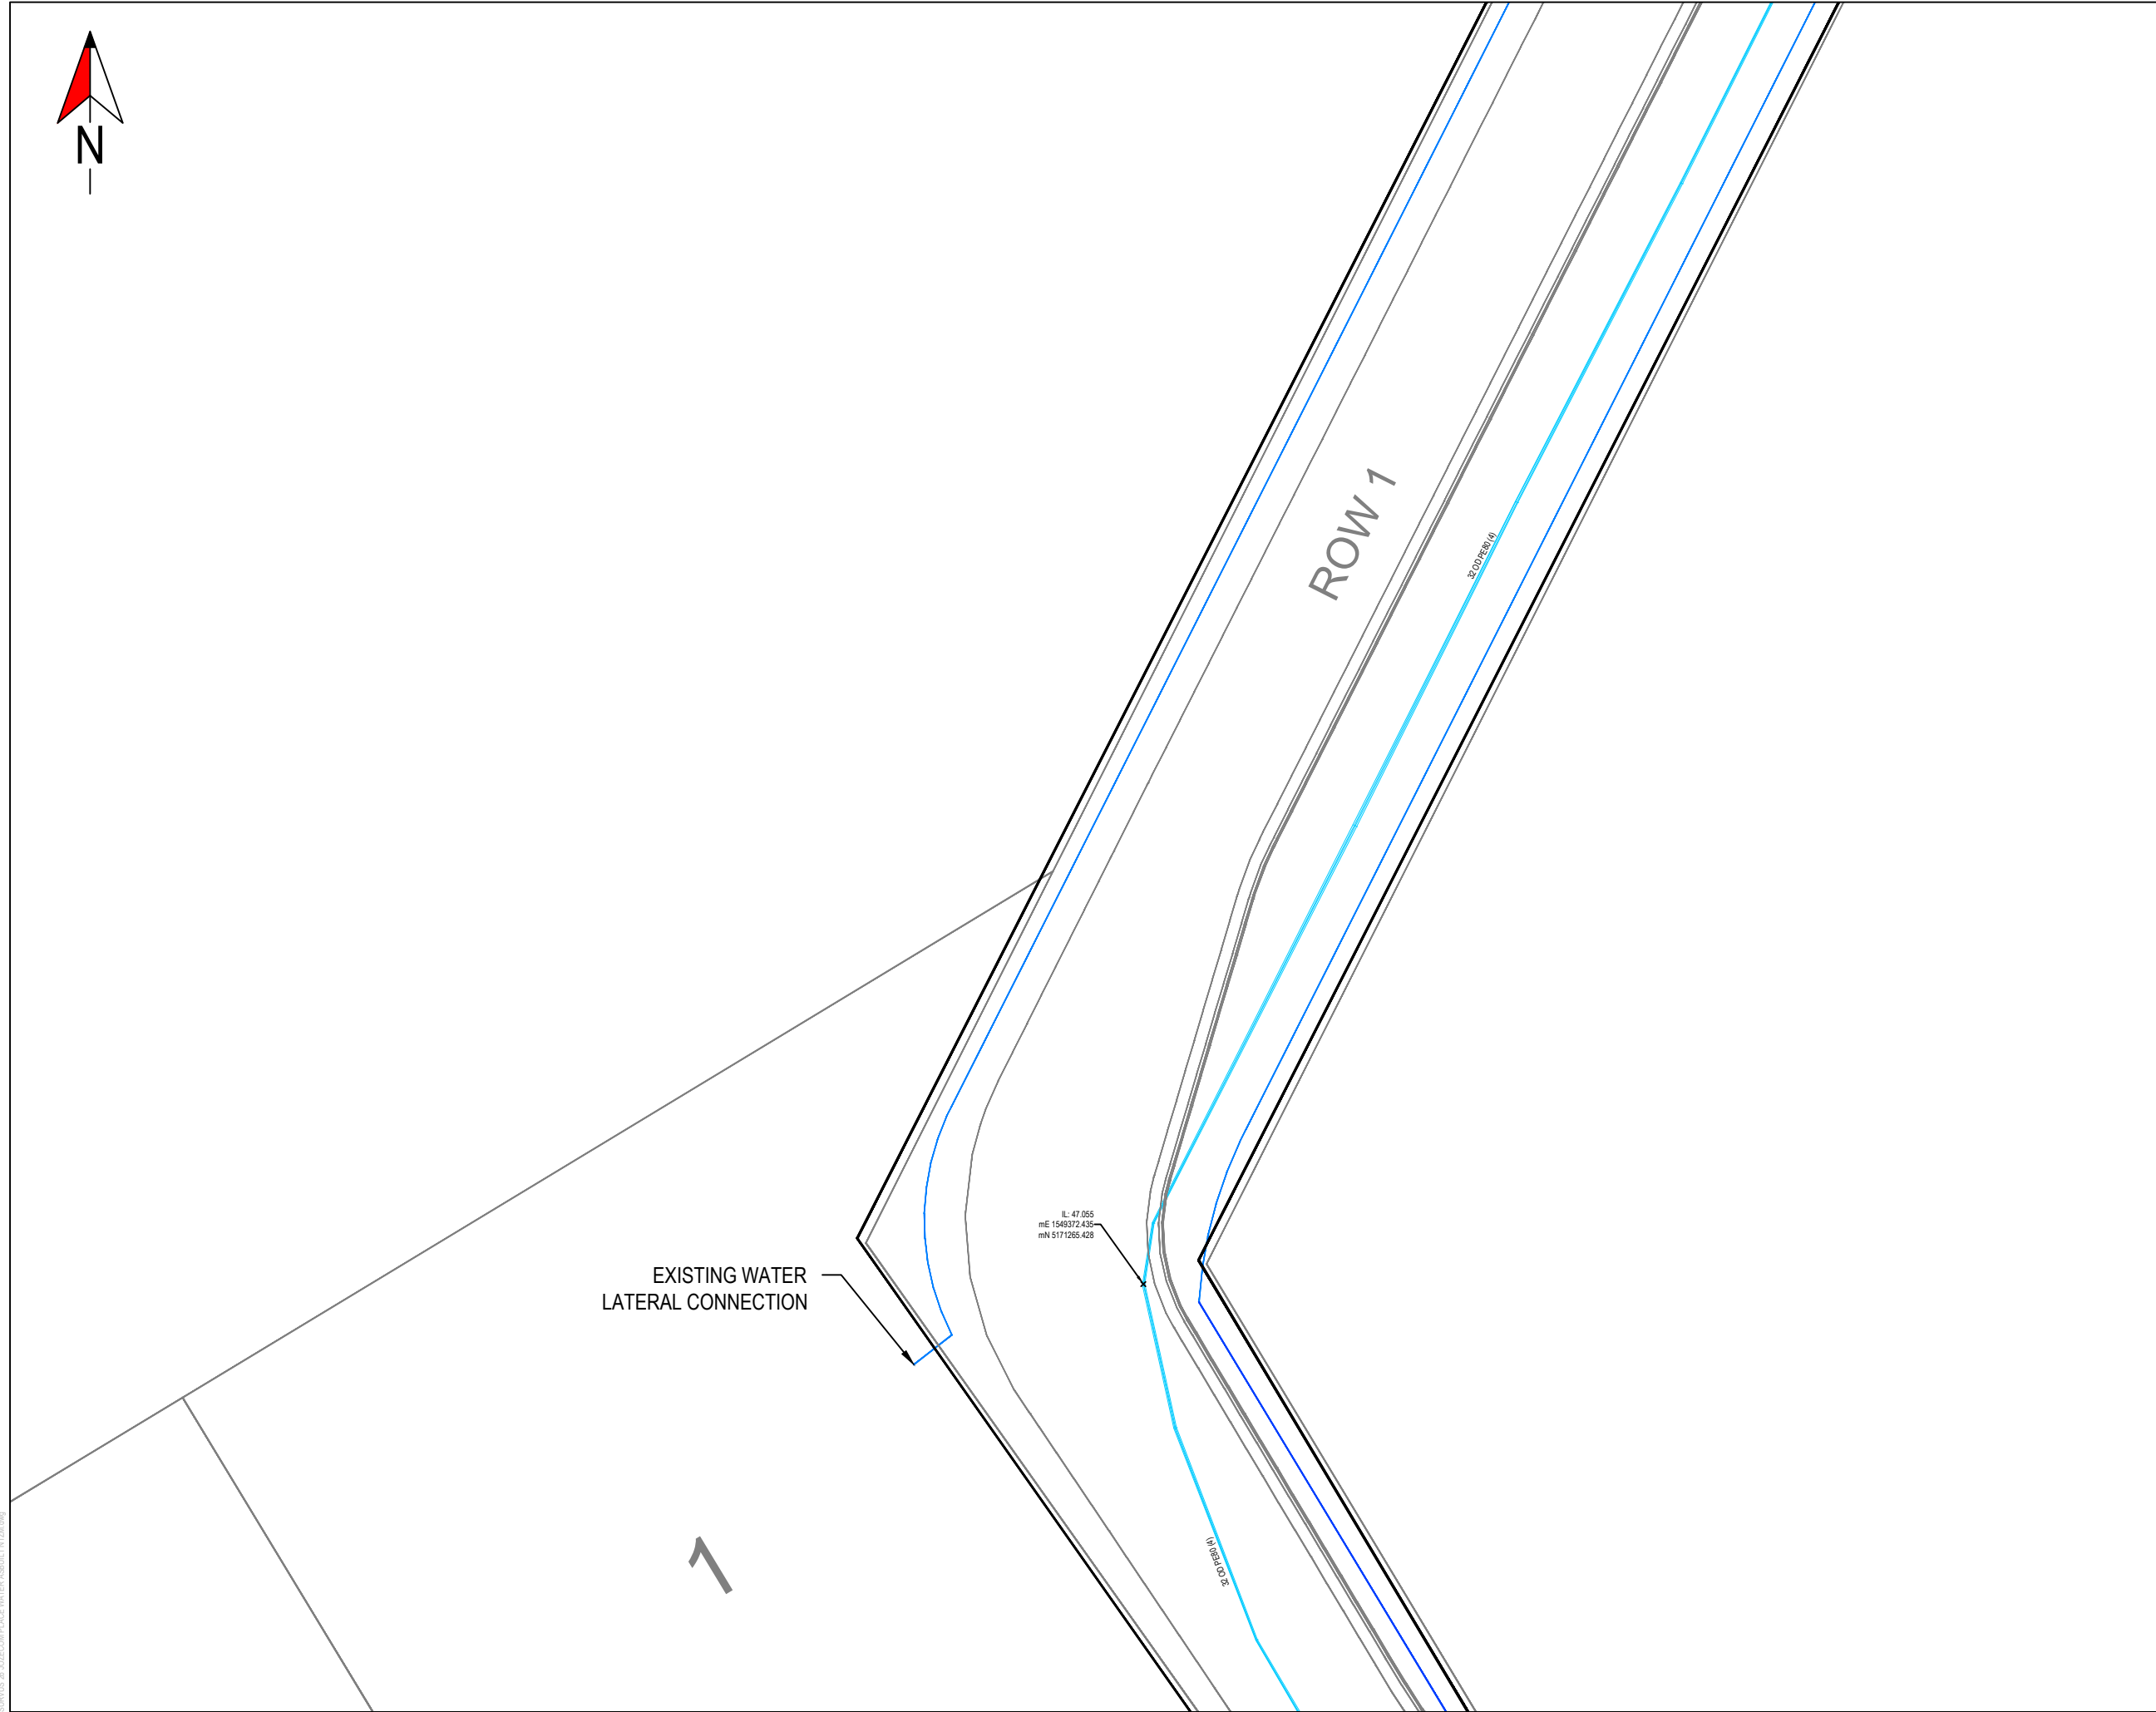

ORIGIN OF LEVELS: BM UG32 (B882)
 REDUCED LEVEL: 55.597m
 DATUM: NZVD2016
 SITE BENCHMARK: IRON TUBE FLUSH IN SEAL
 REDUCED LEVEL: 48.644m

REV	DATE	REVISION DETAILS	ISSUED
A	14/10/2025	As-Built	D.Varkey

DRAFTED BY	VERIFIED BY	VERIFIED DATE
D.Varkey	L.Bellingan	14/10/2025

PROJECT
 15168-26 JOZECOM PLACE,
 ROLLESTON


CLIENT
 ANDY CROSSBIE



CONTACT
 OFFICE: 24a Sheffield Crescent, Christchurch 8053
 OFFICE: PO Box 5558, Papanui, Christchurch
 PHONE: 0508 787 887
 EMAIL: hello@survus.co.nz

DRAWING TITLE
 AS BUILT WATER RETICULATION

PROJECT NO	SCALE	SIZE
15168	1:200	A3
DRAWING NO	STATUS	REVISION
AB-WS02	AS-BUILT	A

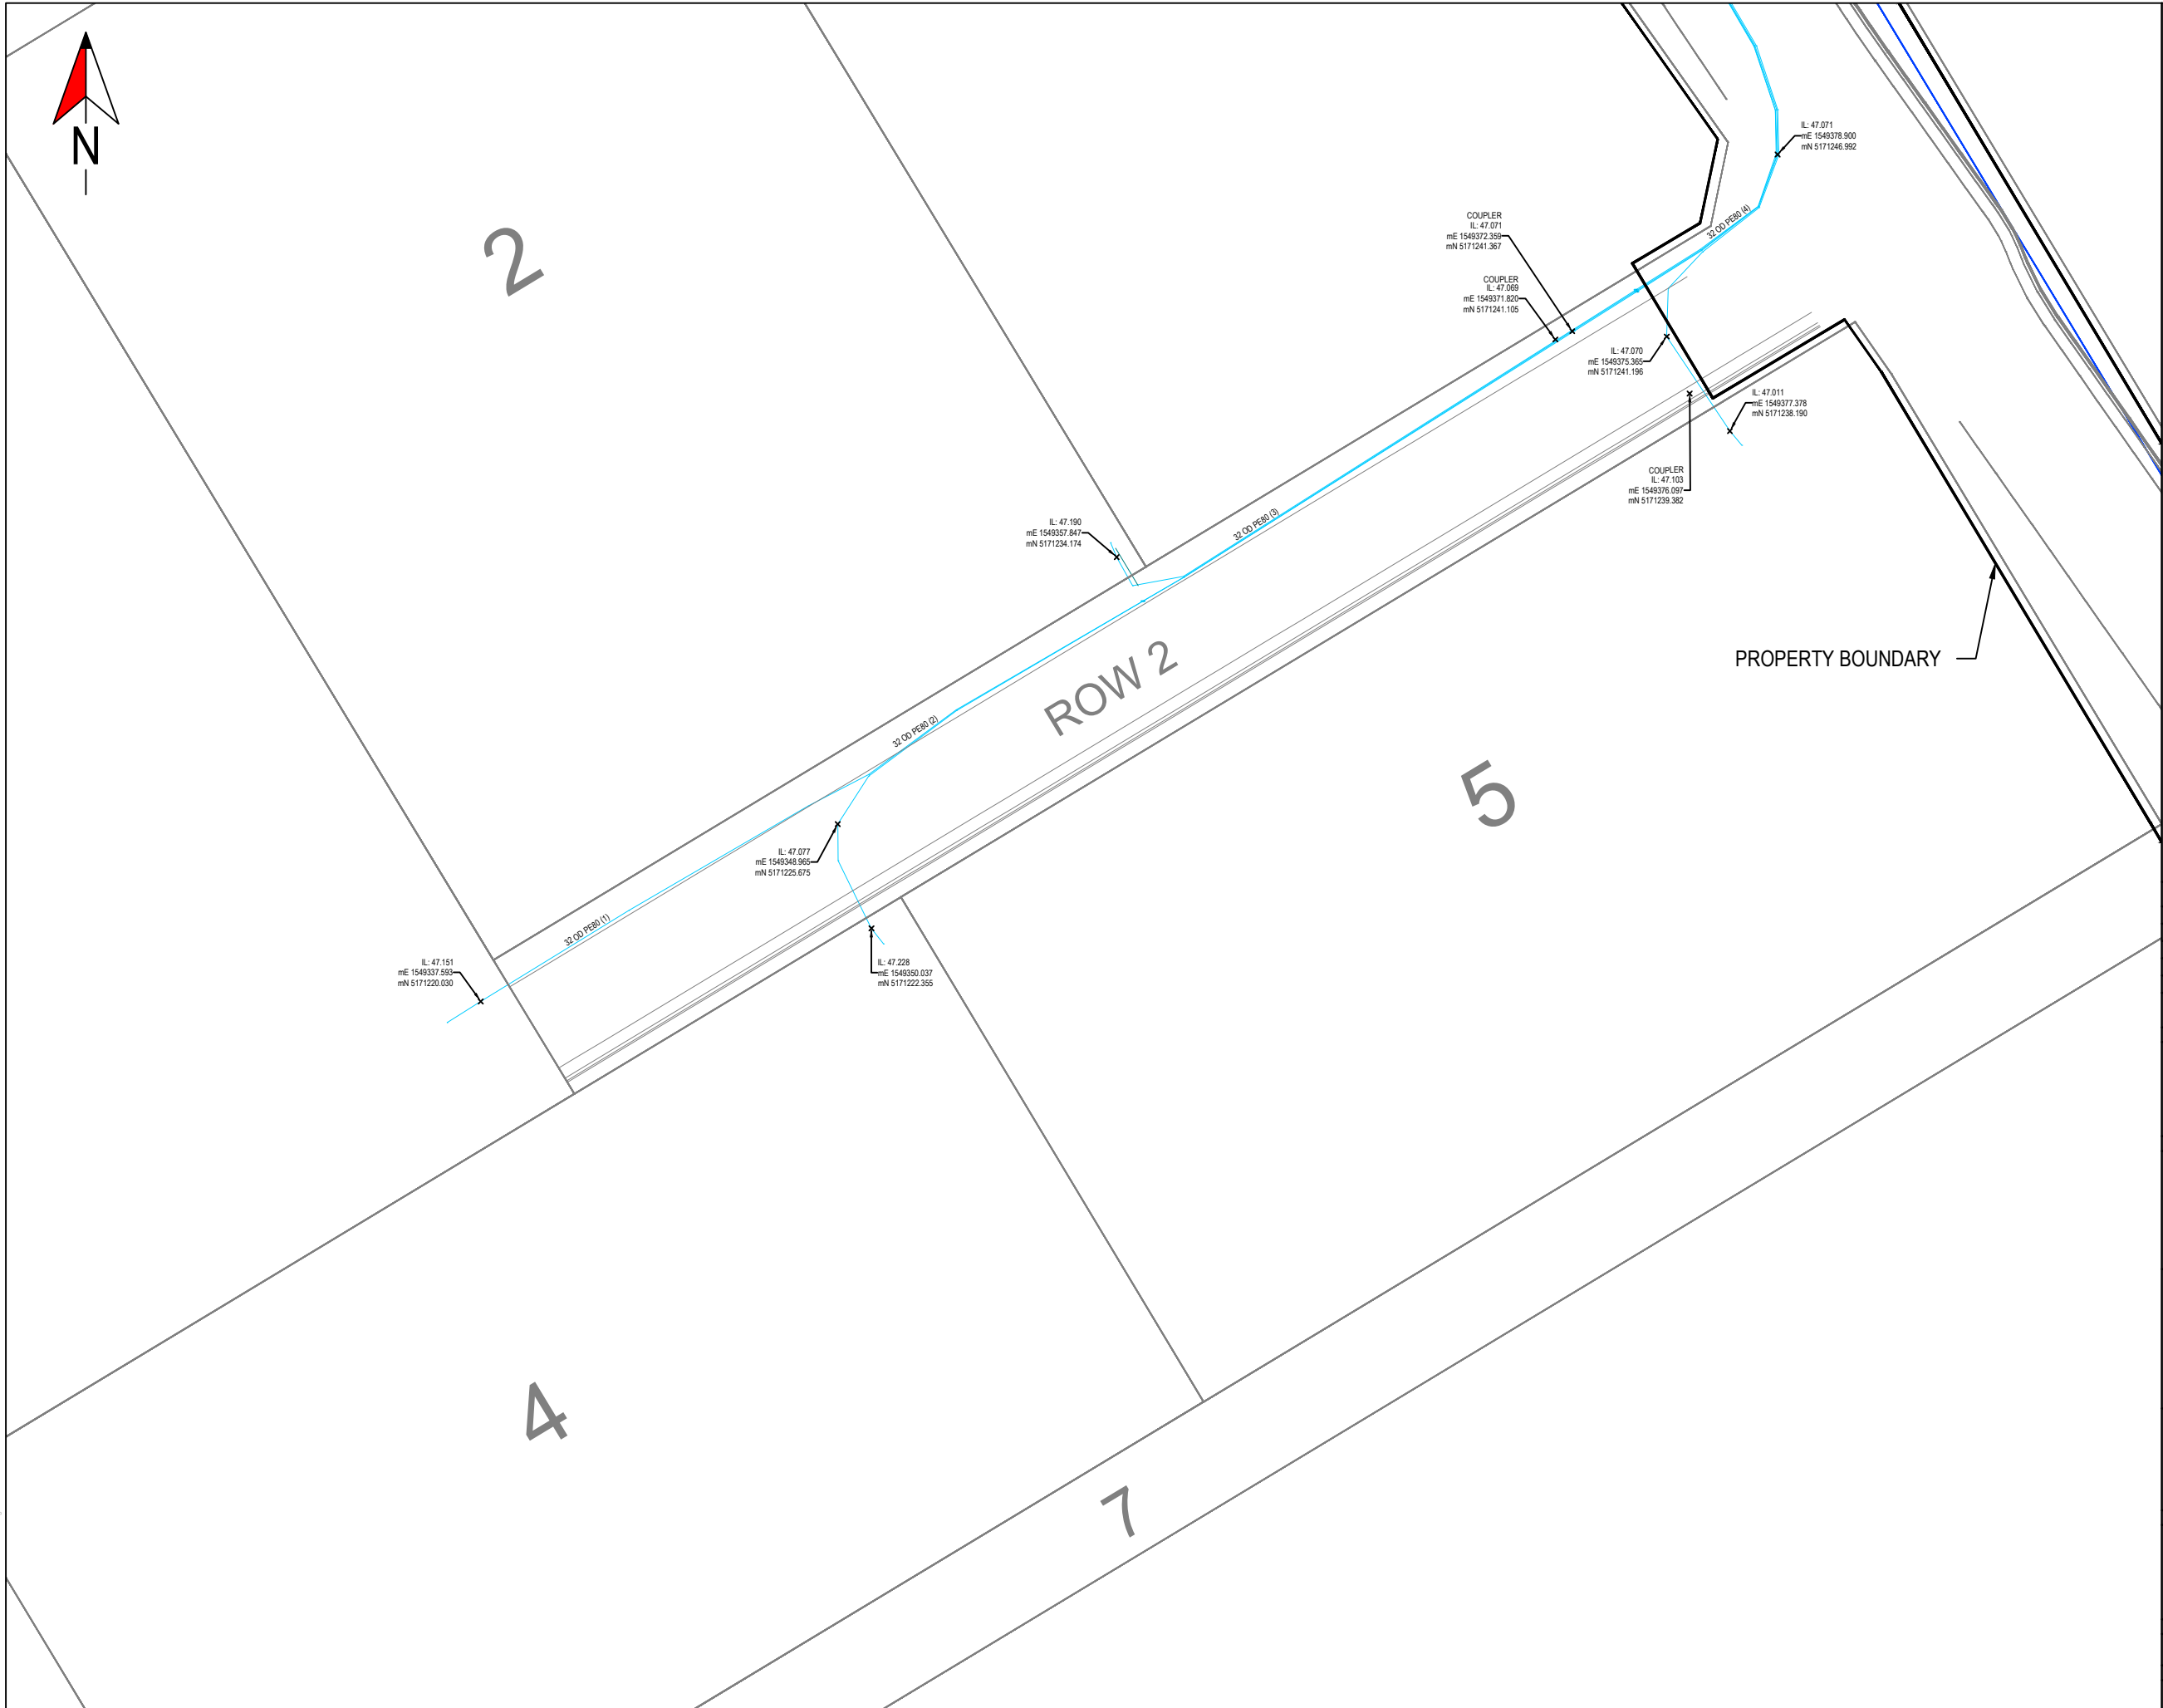

ORIGIN OF LEVELS:	BM UG32 (B882)
REDUCED LEVEL:	55.597m
DATUM:	NZVD2016
SITE BENCHMARK:	IRON TUBE FLUSH IN SEAL
REDUCED LEVEL:	48.644m

REV	DATE	REVISION DETAILS	ISSUED
A	14/10/2025	As-Built	D.Varkey

DRAFTED BY	VERIFIED BY	VERIFIED DATE
D.Varkey	L.Bellingan	14/10/2025

PROJECT
**15168-26 JOZECOM PLACE,
 ROLLESTON**

CLIENT
ANDY CROSSBIE



CONTACT
 OFFICE: 24a Sheffield Crescent, Christchurch 8053
 OFFICE: PO Box 5558, Papanui, Christchurch
 PHONE: 0508 787 887
 EMAIL: hello@survus.co.nz

DRAWING TITLE
AS BUILT WATER RETICULATION

PROJECT NO	SCALE	SIZE
15168	1:200	A3
DRAWING NO	STATUS	REVISION
AB-WS03	AS-BUILT	A