


Drainage - Ray Vincent : 24613
Crew: R+C

Grade = 1:90

15.11.21

29 Pegasus Main St, Pegasus.

bc# 210889.

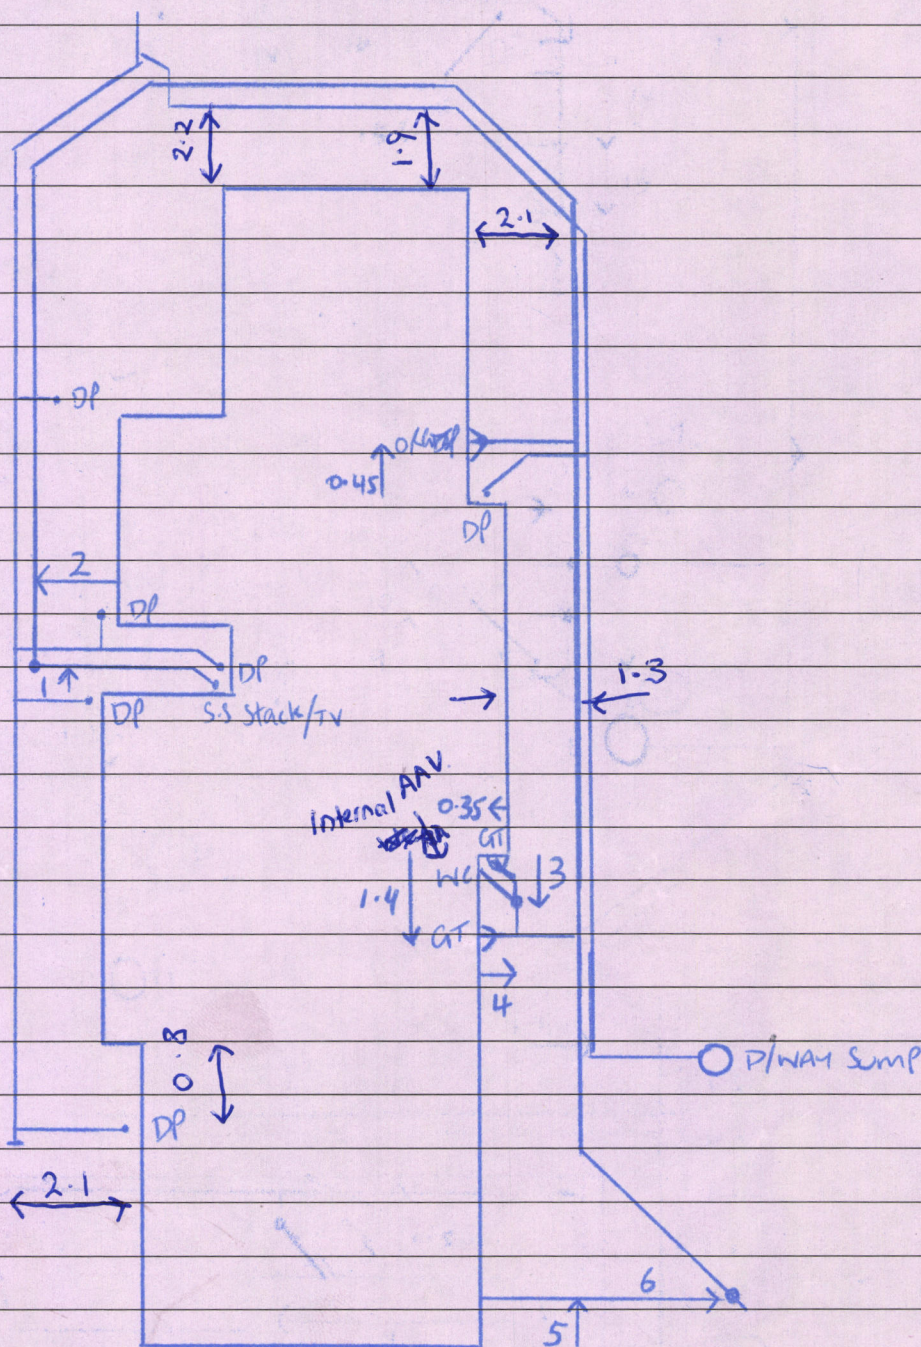

S.S. Measurements:

1. 0.7m.

2. 1.75m

3. 0.8m

4. 0.7m

5. 1.7m

6. 3.2m

NOTE: S-S Lateral was not located due to being too deep & groundwater at 1.8m. Notified Rob Frizzell & he will get a subcontractor to connect lateral.