



200 Maces Road
PO Box 35-193 Christchurch

Ph (03) 389 8200

JOB No **20-0232J**

Client: Mike Greer Mid Canterbury
Job Name: CT5958
Address: 13 Hart Place
Lake Coleridge Village

Pitch: 40.00, 35.00
Roof Material: Galv Iron .5mm
Soffit Overhang: 150, 170
Wind Area: Very High
Snow Load: 0.735

Trusses And Rafters At 900 Centres
Unless Stated Otherwise

DRAWN BY Ashley Stapleton

DATE 13 Feb,2020 PAGE 1 of


These lintels have been sized as per
the GANGLAM and FLITCH BEAM
selection manuals as provided by
MiTek NZ Ltd.


HYSPAN lintels have been sized as per
the HYSPAN selection charts.

Unless otherwise stated all lintels are
as per NZS3604 2011

Level 1 Frames

**As Built Design
BC#192333**

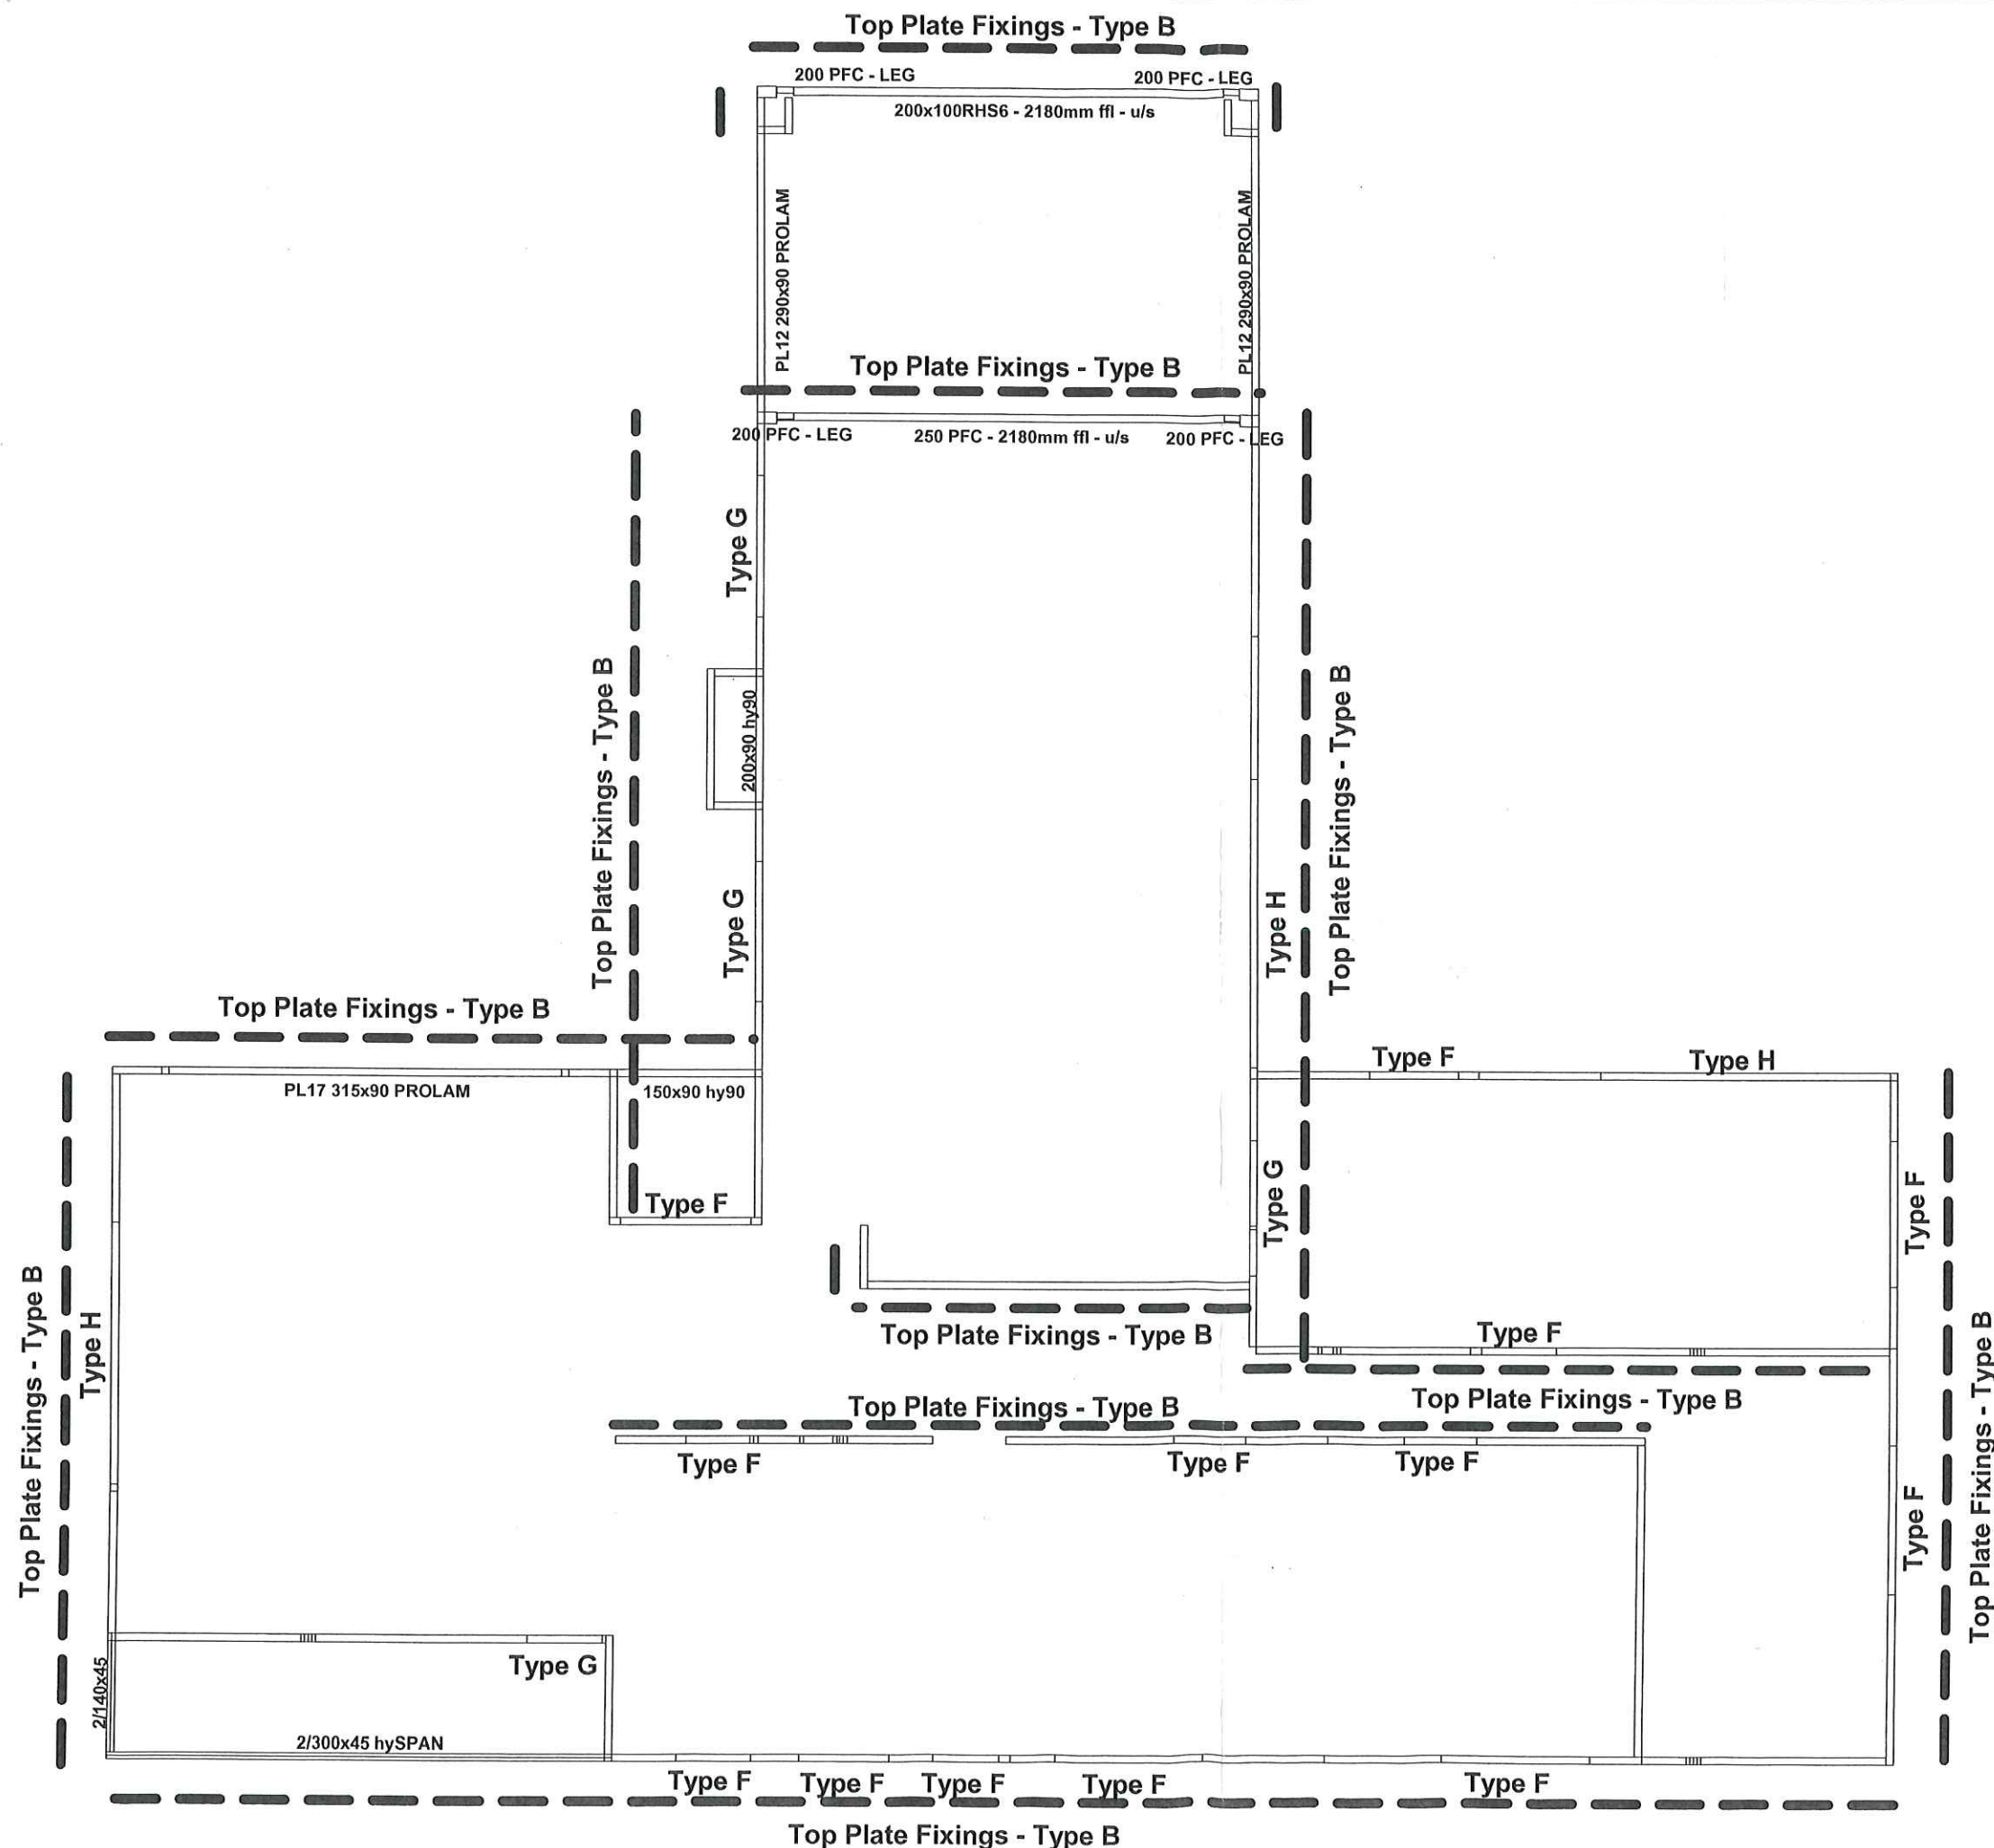

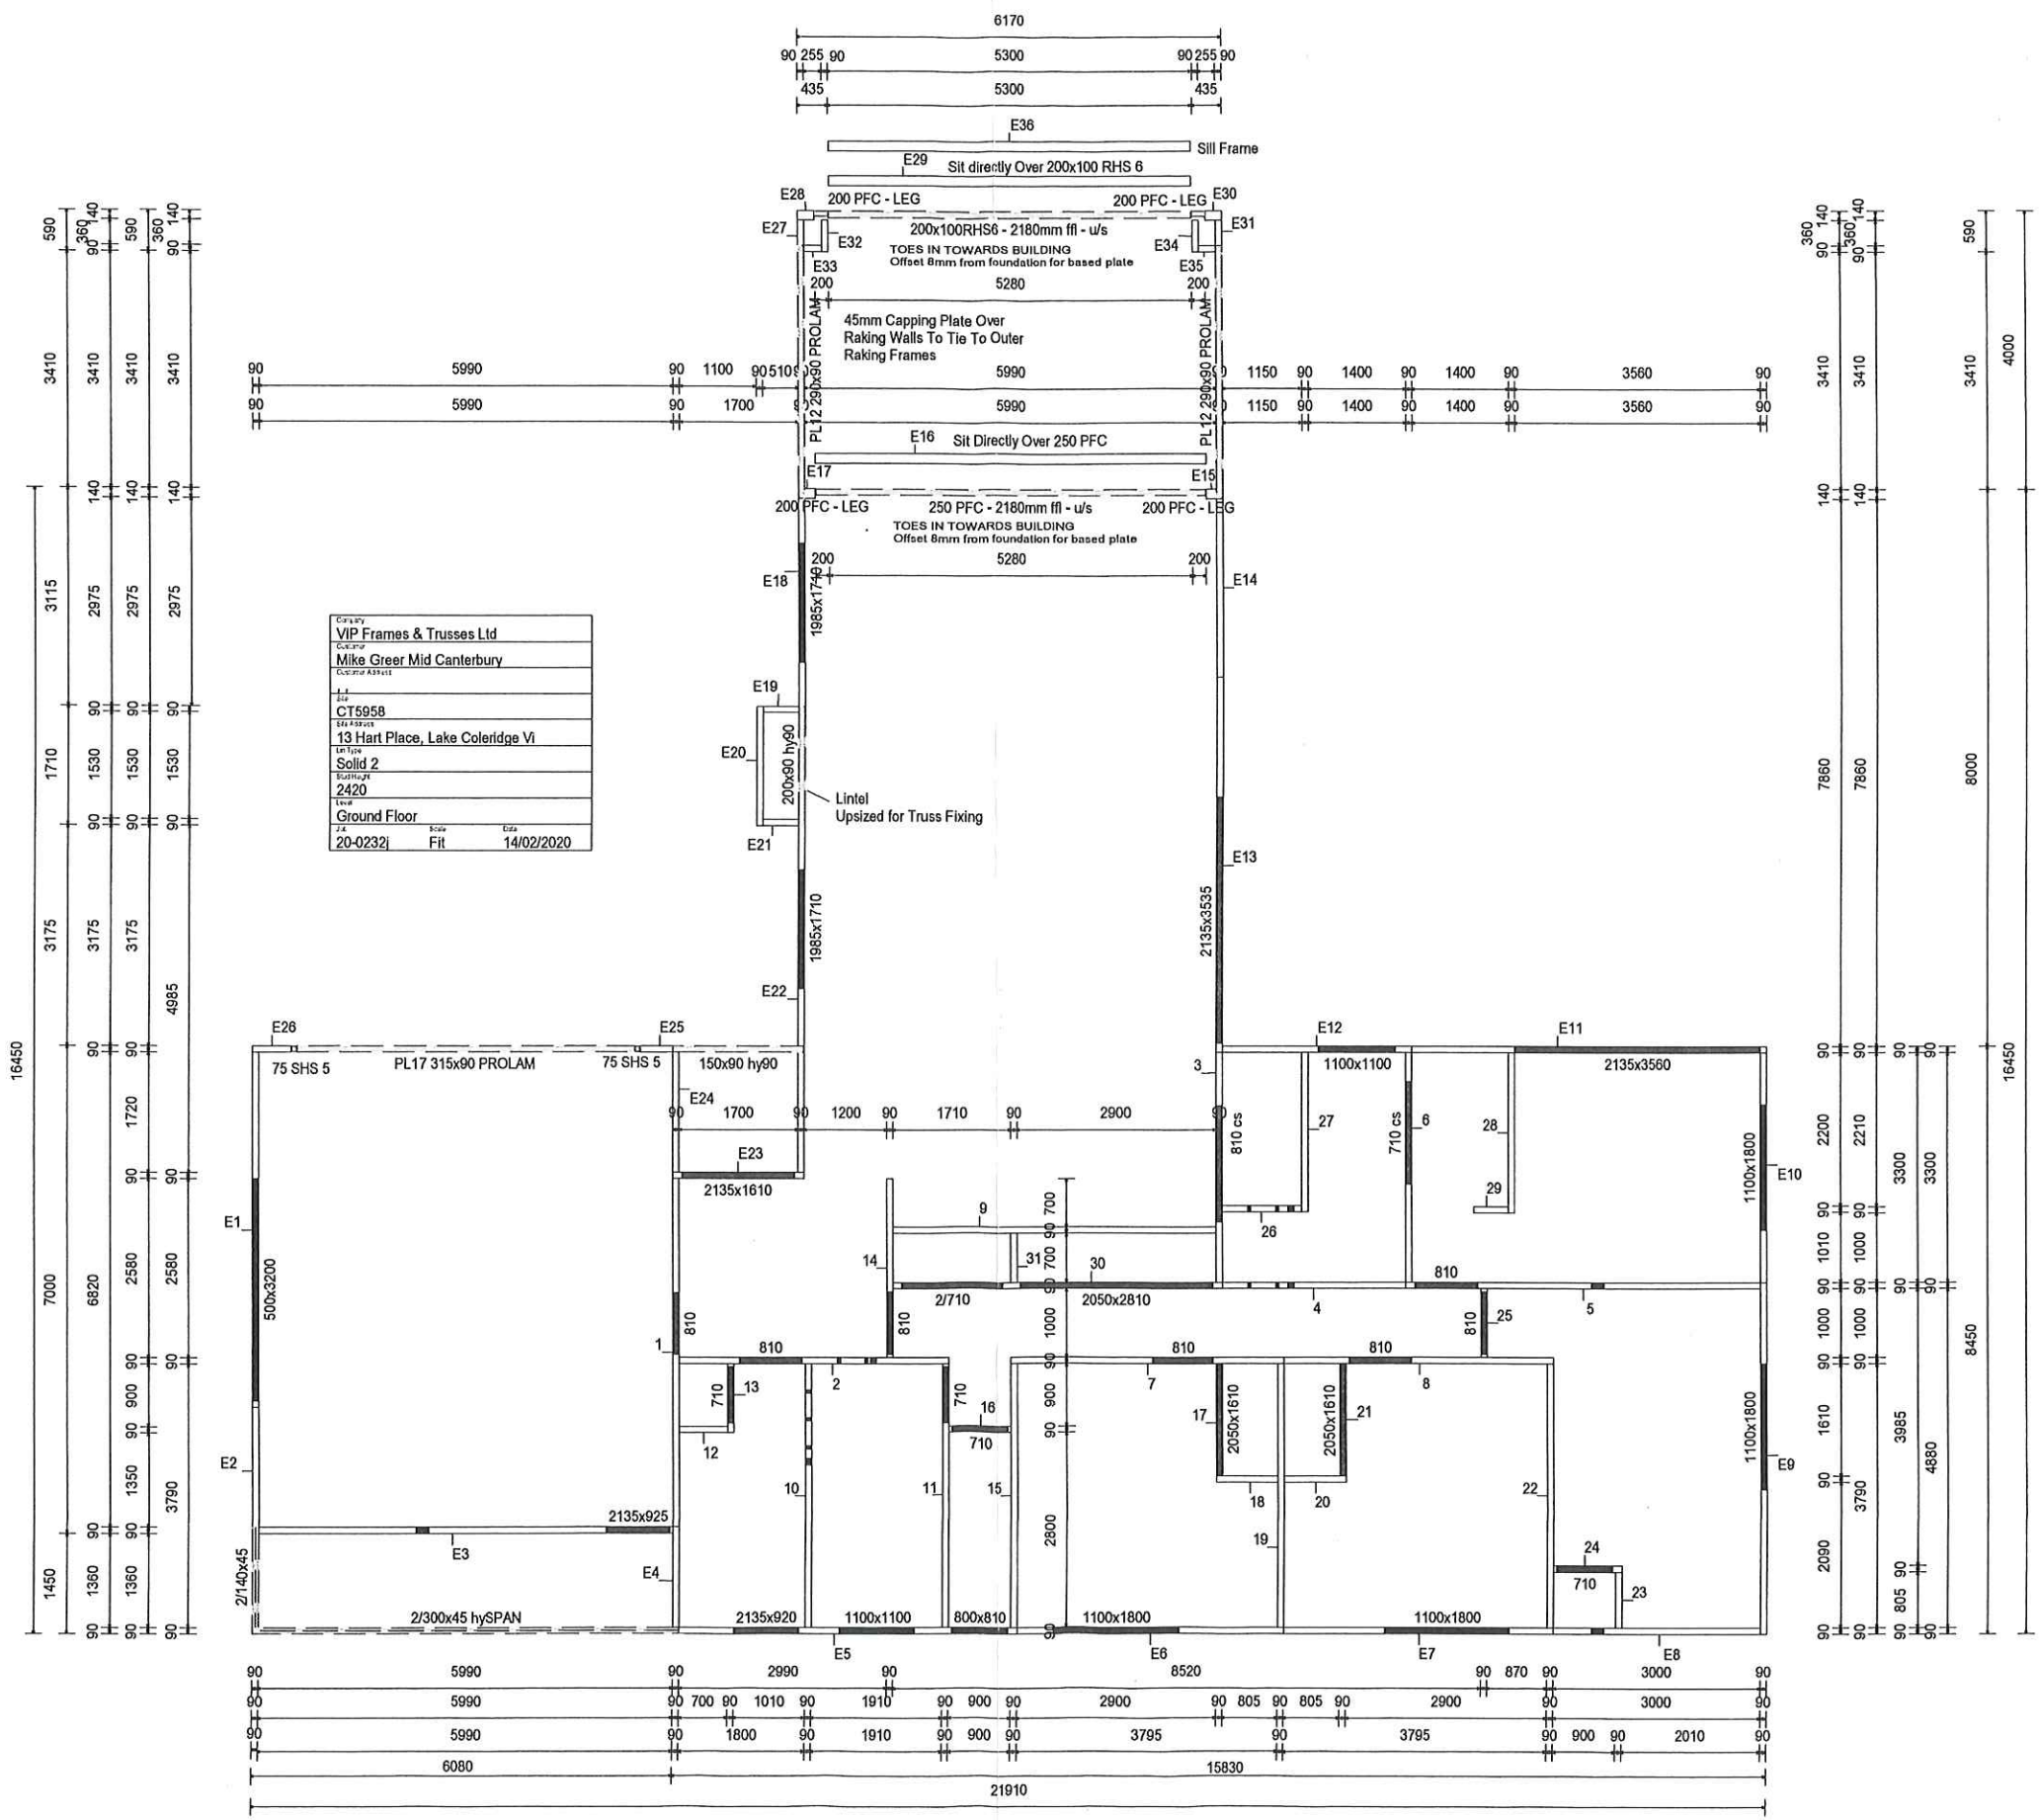


0800 PRENAIL (0800 773 6245)

TRUSS TO TOP PLATE FIXING
= PAIRS OF WIRE DOGS & 2/90x3.15 nails
UNLESS STATED OTHERWISE

MULTI-PLY NAILING

TOP CHORD
= 1 row @ 180mm ctrs
BOTTOM CHORD
= 1 row @ 280mm ctrs
WEBS
= 1 row @ 180mm ctrs

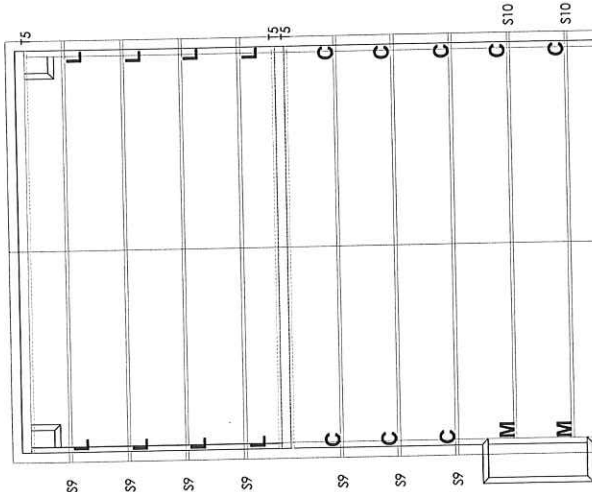

Lateral Bracing Required to W1
70x45 Rad KD H1.2 SG8 Fixed to
Center Webs @ mid Span from S1
through to S2

Ⓔ = Fixings As Per Engineer
Refer to Engineers Drawings S4.03
(Note allowance for pair of CT200's in place of CT600
similar kN uplift rating)

VIP FRAMES
&
TRUSSES

200 Maces Road
PO Box 35-193 Christchurch
Ph (03) 389 8200

JOB No 20-0232J

Client: Mike Greer Mid Canterbury
Job Name: CT5958
Address: 13 Hart Place
Lake Coleridge Village

Pitch: 40.00, 35.00
Roof Material: Galv Iron .5mm
Soffit Overhang: 150, 170
Wind Area: Very High
Snow Load: 0.735

Trusses And Rafters At 900 Centres
Unless Stated Otherwise

DRAWN BY Ashley Stapleton

DATE 13 Feb.2020 PAGE 1 of

FIXINGS

A=47x90 JH
B=47x120 JH
D=47x190 JH
E=95x165 JH



Joist Hanger

CT 200

C=2xCT200's
M=Multigrips



Multi Grips

N=Nail On Plate



Nail on plate

L=Pair CPC 40



P=Pair CPC 80



CPC

NOTE

Please contact VIP Frames and Trusses Ltd
for any queries regarding this layout or if any
on site remedial work is required.

No modifications to Roof Trusses or Wall Frames
are to be undertaken without first obtaining
written authority from VIP Frames and Trusses Ltd.

As Built Design
BC#192333

