


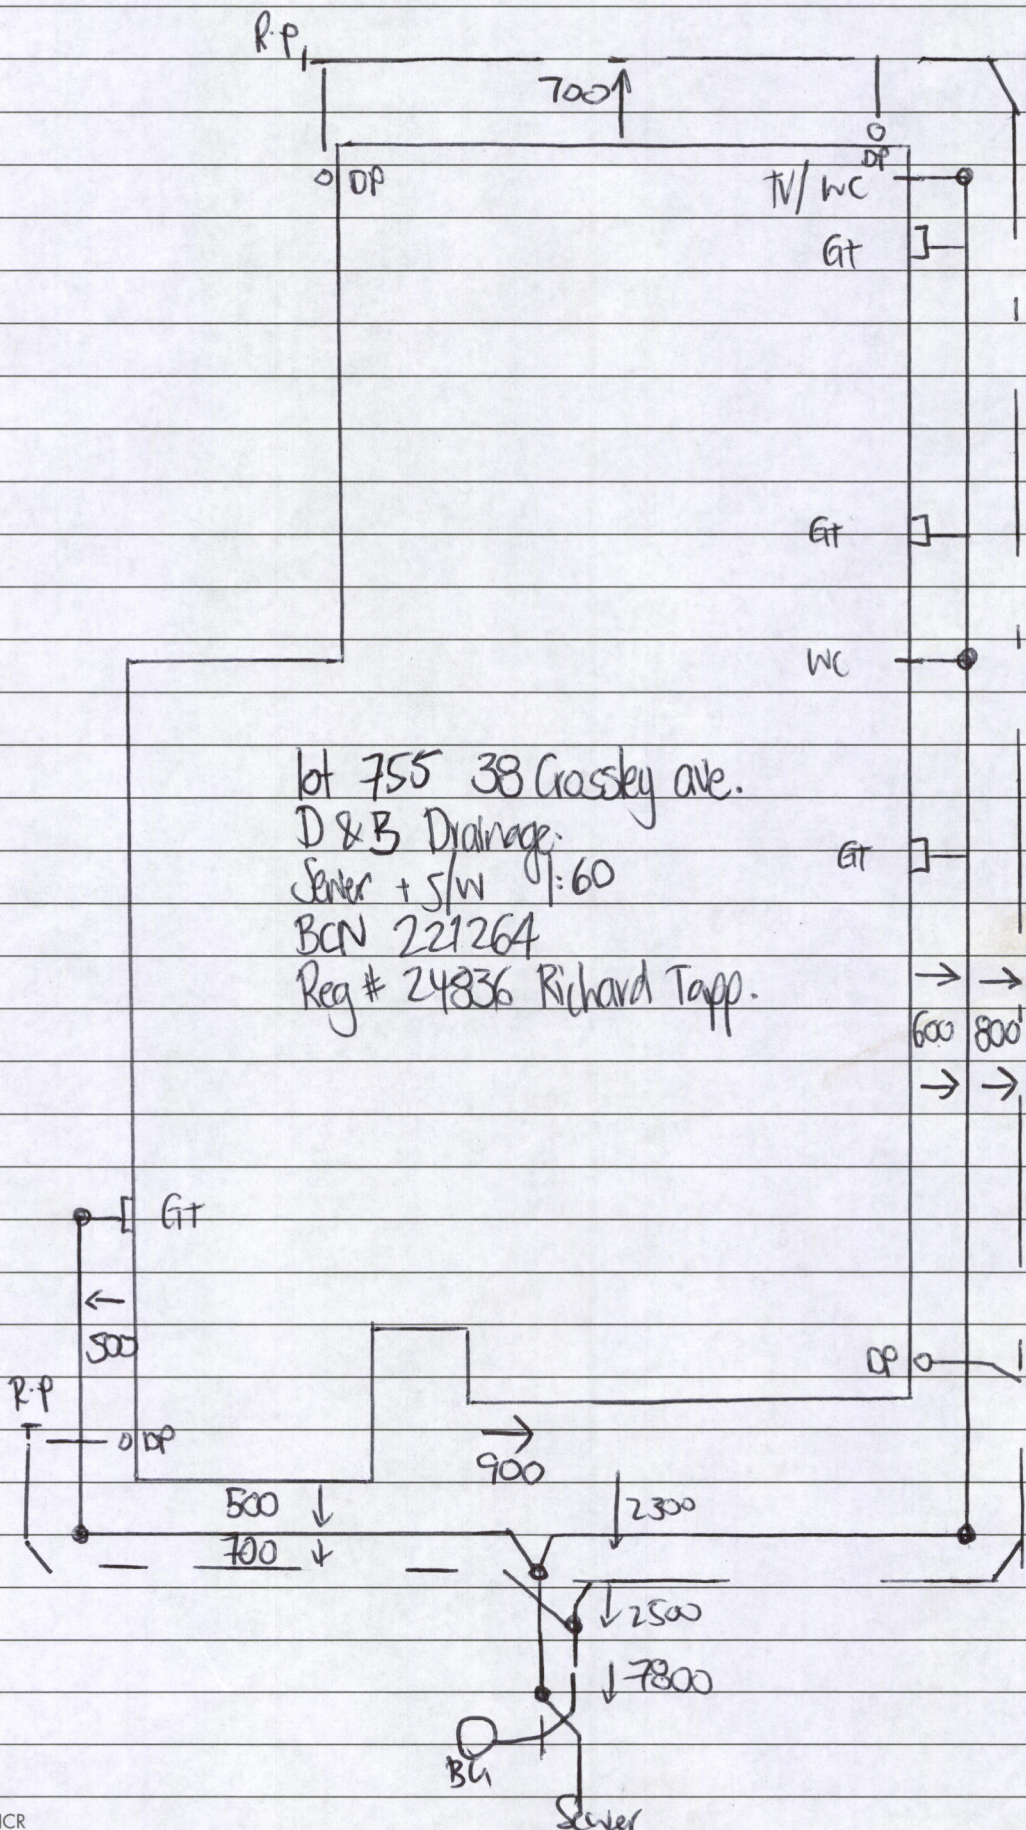

lot 755 38 Grassley ave.
D & B Drainage.
Sewer + S/W 1:60
BCN 221264
Reg # 24836 Richard Tapp.