0641

FEARY DRAINAGE
COMMERCIAL • RESIDENTIAL

CERTIFIED DRAINLAYER
MOBILE: 027 826 3692
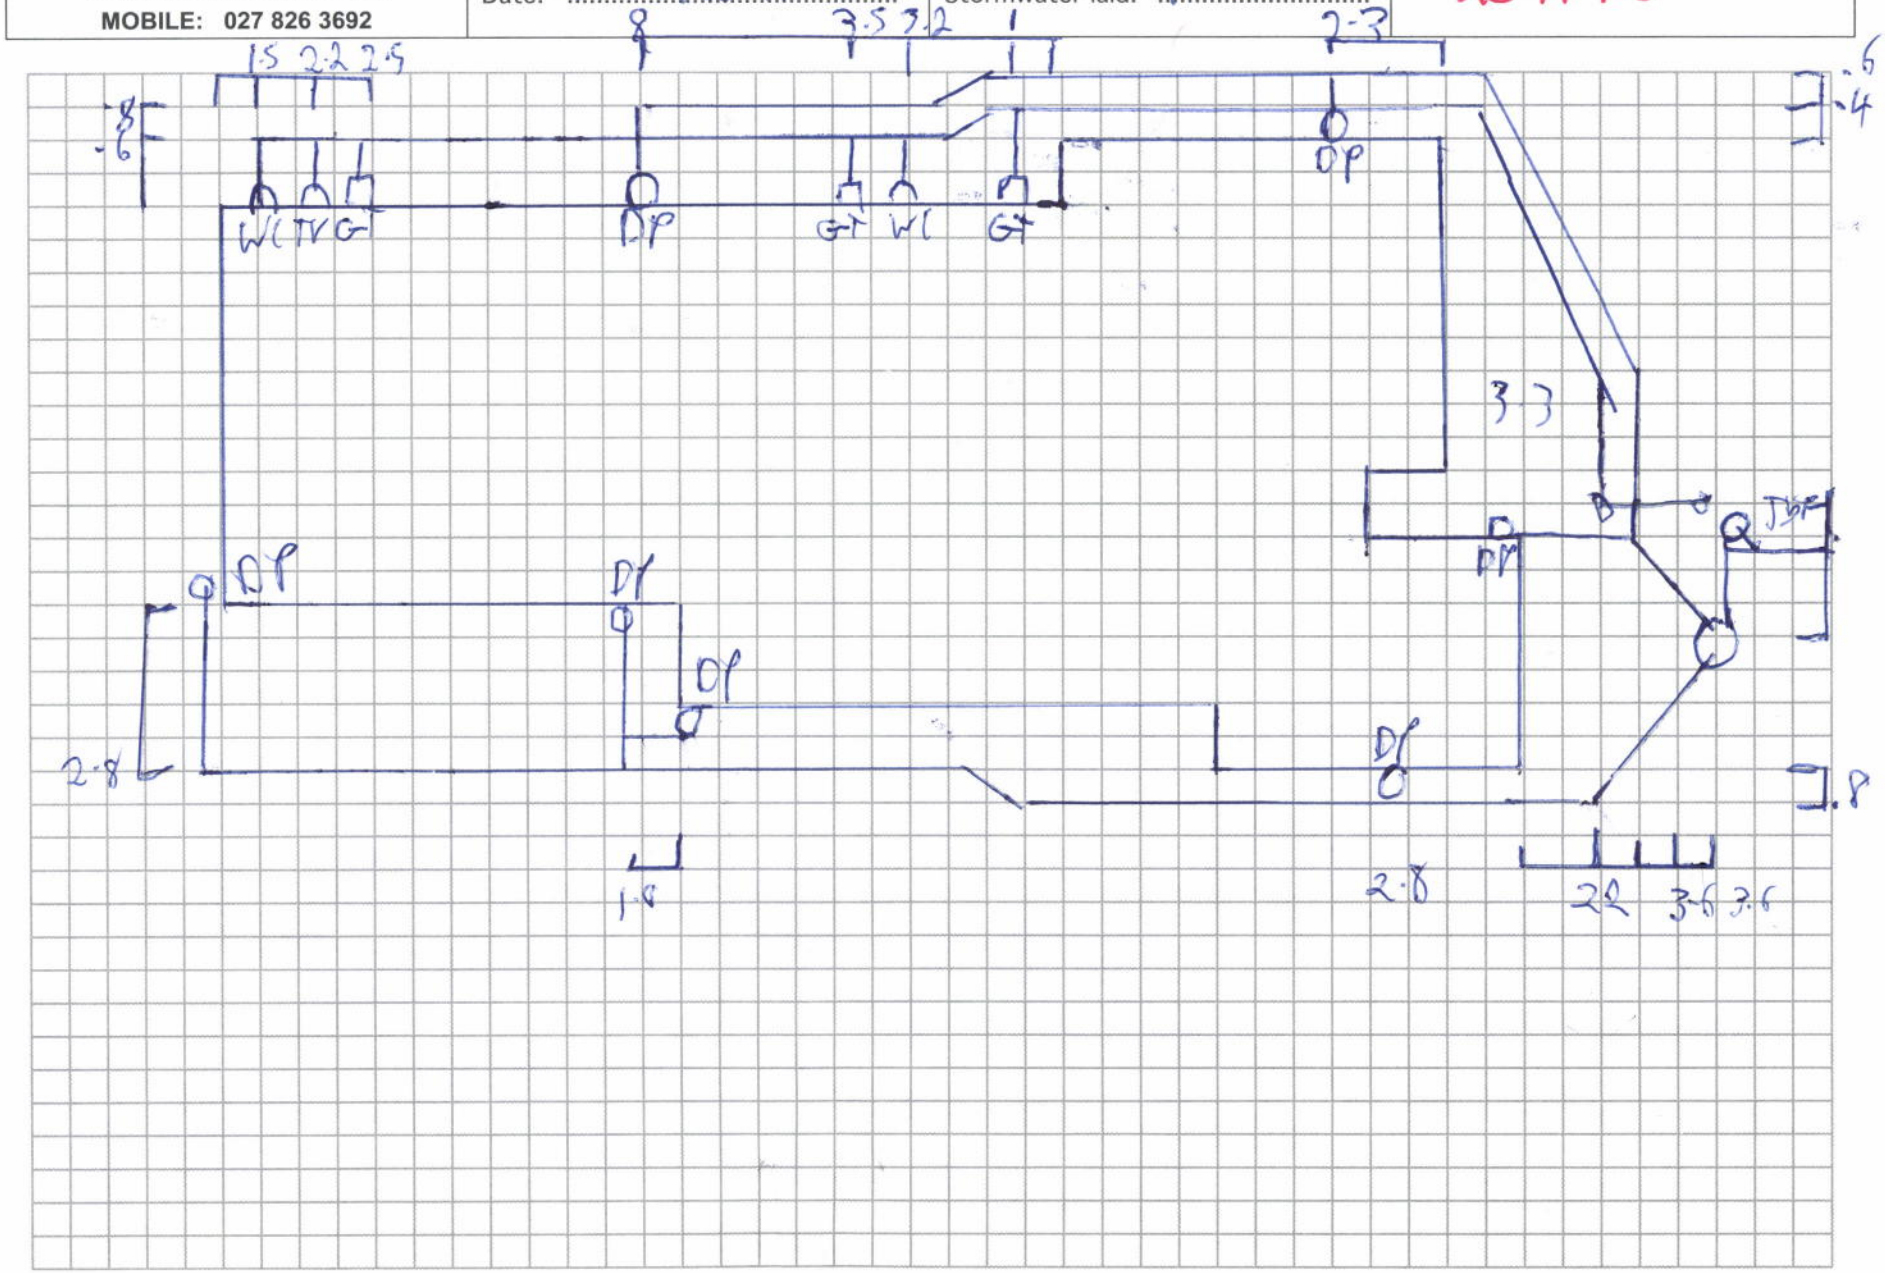
DRAINAGE PICKUP		CONSENT NUMBER
Address: 11 Crete Street Dean Cameron	Drainlayer: Charlie 24971	201170
Client:	Sewer laid: 1.60	201170
Date: 21/1/2021	Stormwater laid: 1.100