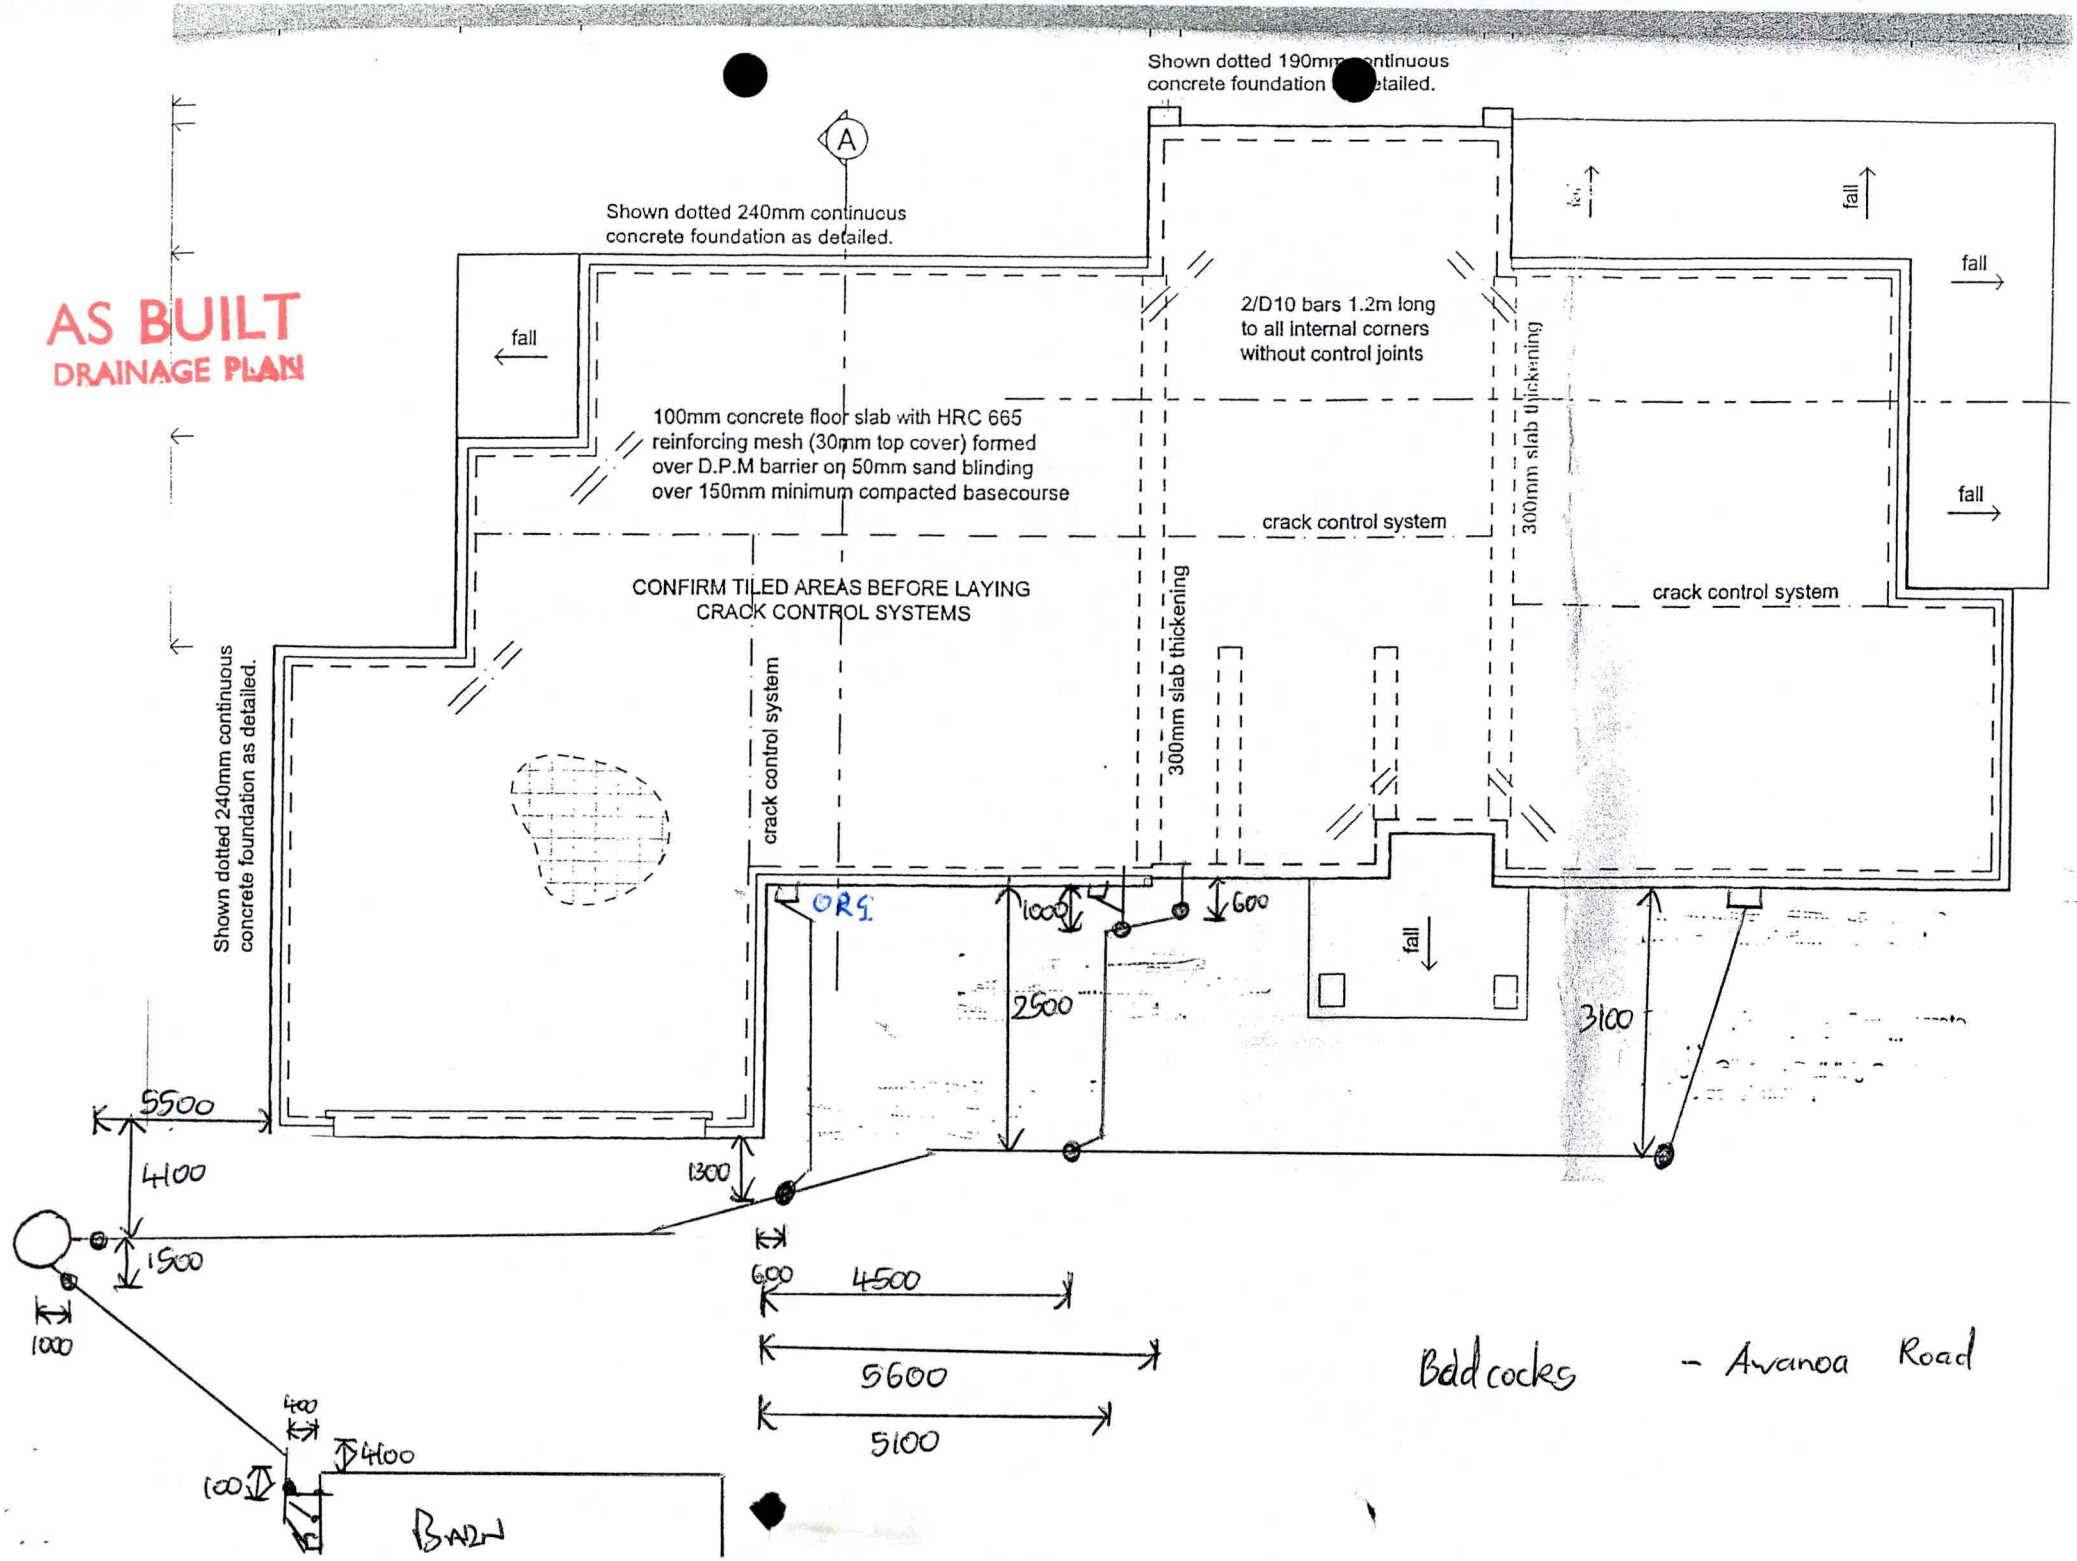
AS BUILT
DRAINAGE PLAN
Shown dotted 190mm continuous concrete foundation as detailed.
A
Shown dotted 240mm continuous concrete foundation as detailed.
fall
fall
fall
fall
fall
fall
2/D10 bars 1.2m long to all internal corners without control joints
300mm slab thickening
100mm concrete floor slab with HRC 665 reinforcing mesh (30mm top cover) formed over D.P.M barrier on 50mm sand blinding over 150mm minimum compacted basecourse
crack control system
crack control system
CONFIRM TILED AREAS BEFORE LAYING CRACK CONTROL SYSTEMS
crack control system
300mm slab thickening
Shown dotted 240mm continuous concrete foundation as detailed.
ORS
1000
600
2500
3100
5500
4100
1300
1500
1000
600
4500
5600
5100
400
4100
100
BARN
Baddcocks - Avanoa Road
140