

Property File : 15 Hamon Pl

As Built - Drainage Plan



RRD001VD8S

Document Number: RDC-390389

Date Registered: 5/8/2013

DESTINATION

ROTORUA

Document Set ID: 205694
Version: 1.0
Date: 05/08/2013

As Built - Drainage Plan


Drainage Plan for :

Address 15 Hamon St
Lot 67 D.P. 399109
Owner Smith & Geddes Trust
Inspector Sally Tarral Date of Inspection 15-10-12
Drainlayer W.H. Kellys Licence No. _____
Building Consent No. 62586

Note : Plan to be drawn in black and red ballpoint on graph opposite

Plan to include :

- 1 The correct position of the drains in relation to the building and boundaries.
- 2 The position of the street frontage
- 3 Depth of drains at connection point.
- 4 Both wastewater and stormwater drains to be drawn.
- 5 Clearly define all inspection openings, with accurate measurements from two points.
- 6 Clearly define all buildings and boundaries.
- 7 Refer to example drain plan back page.

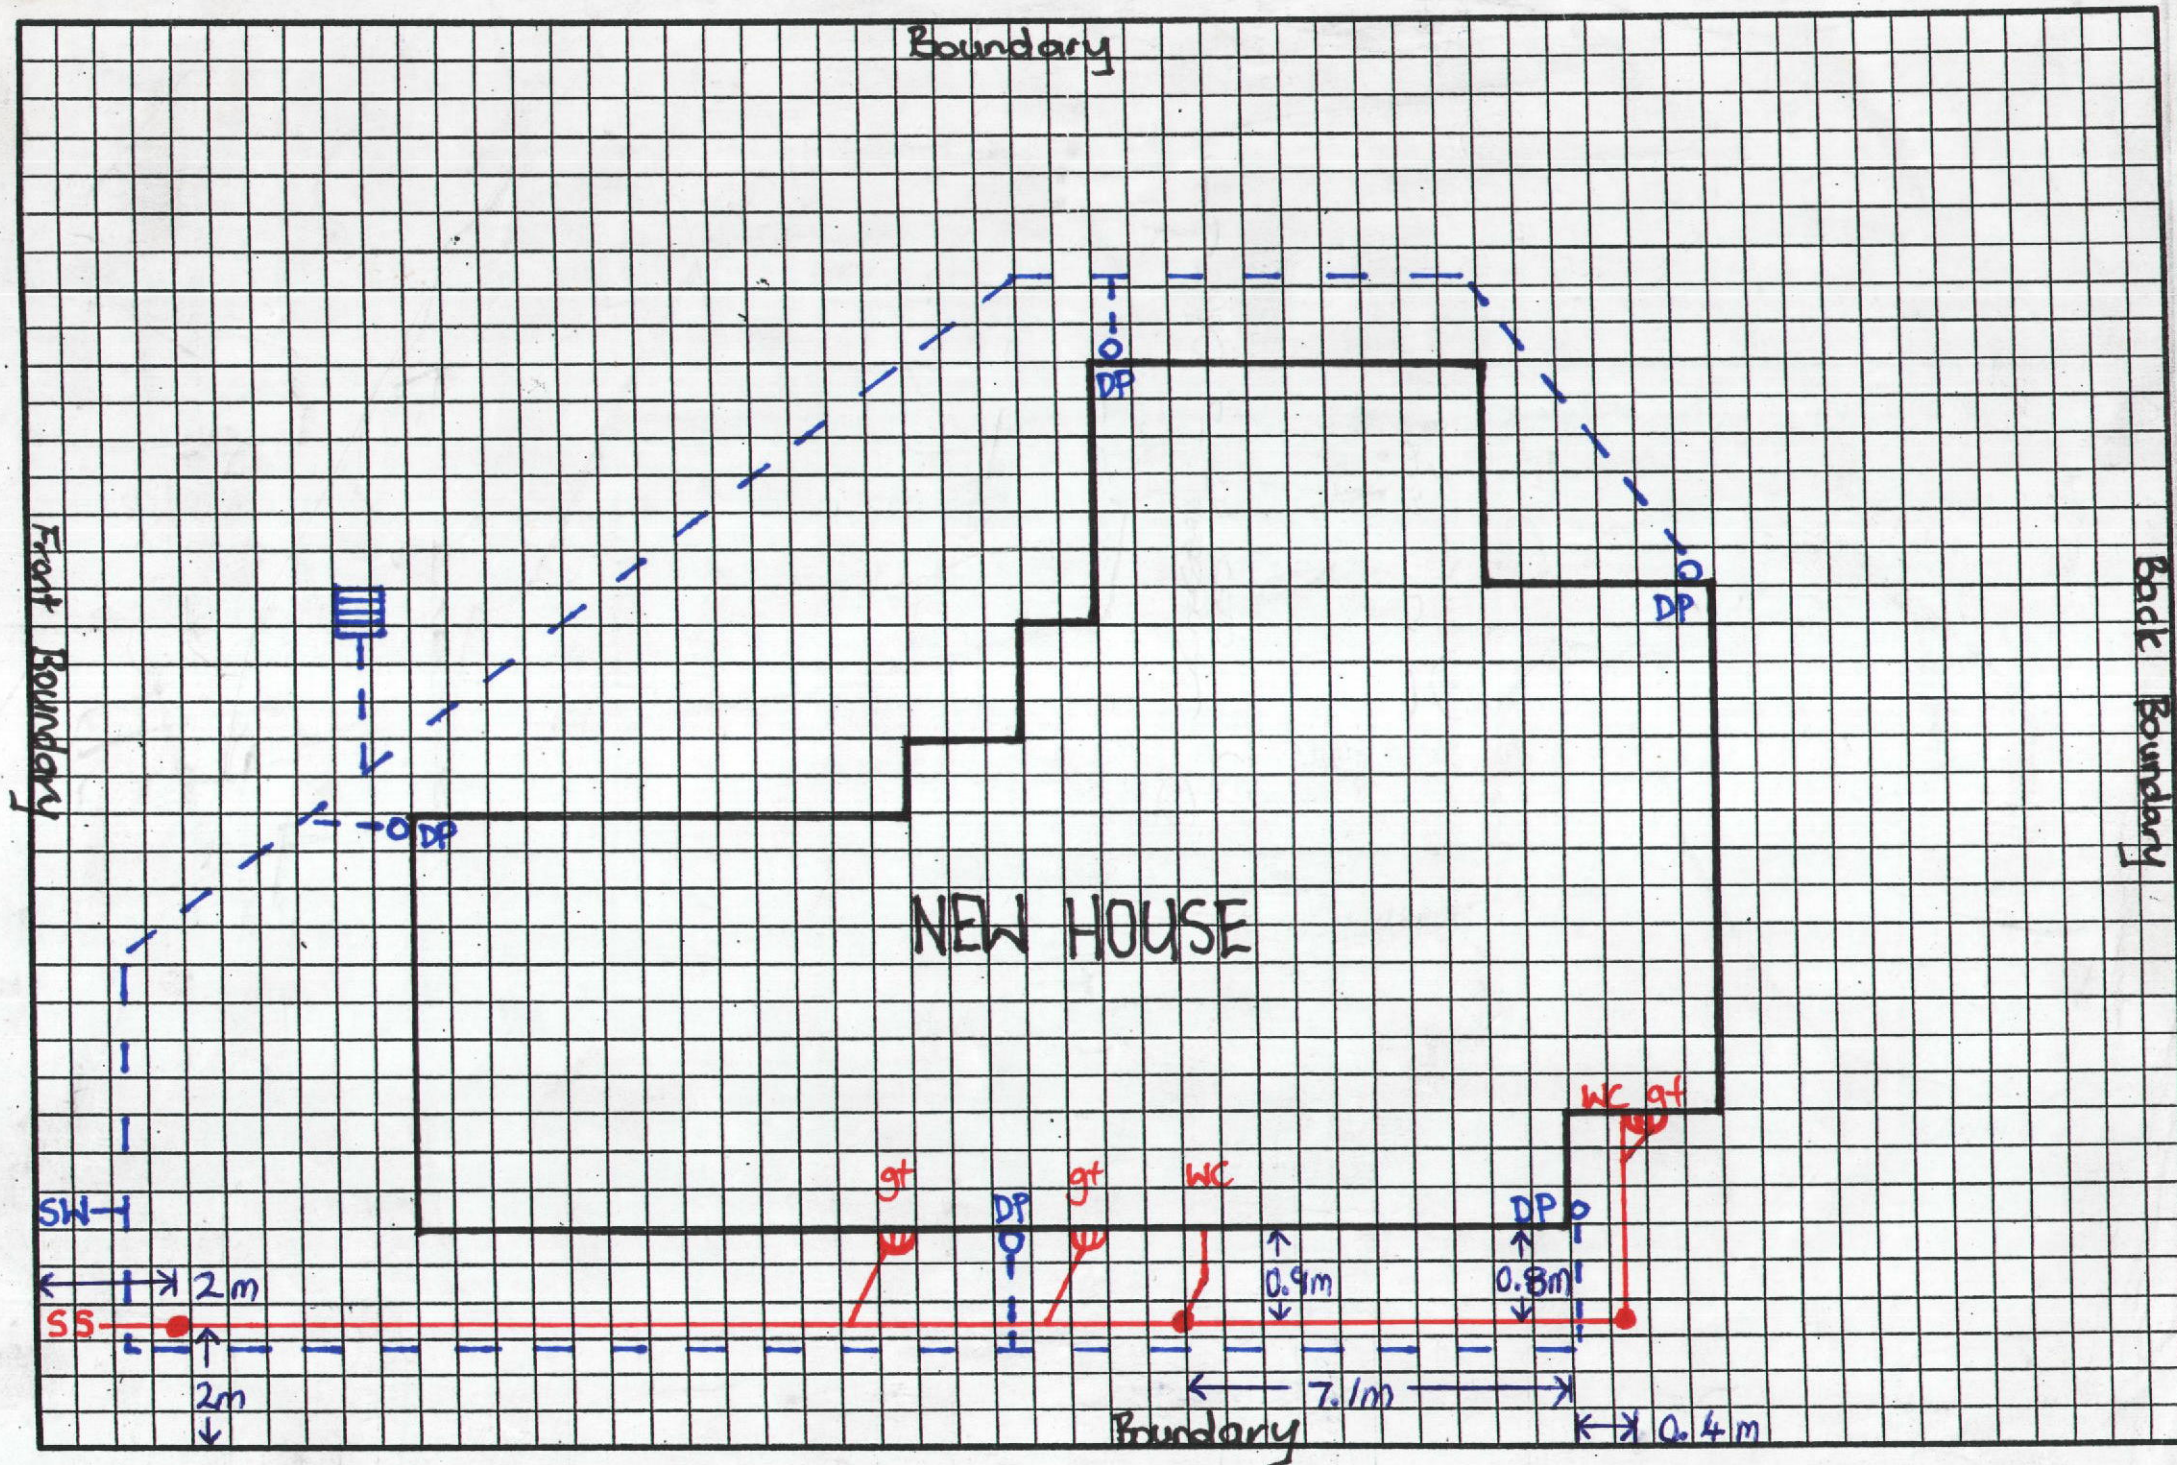

1000

