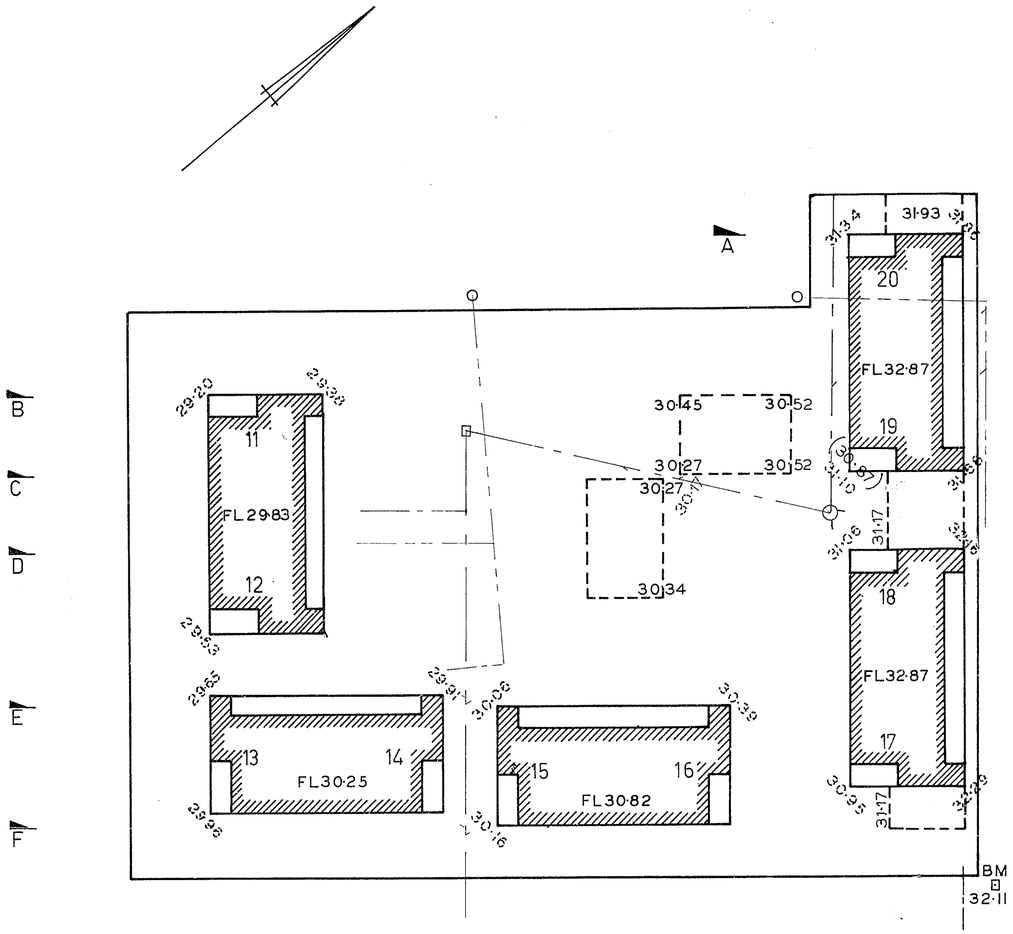

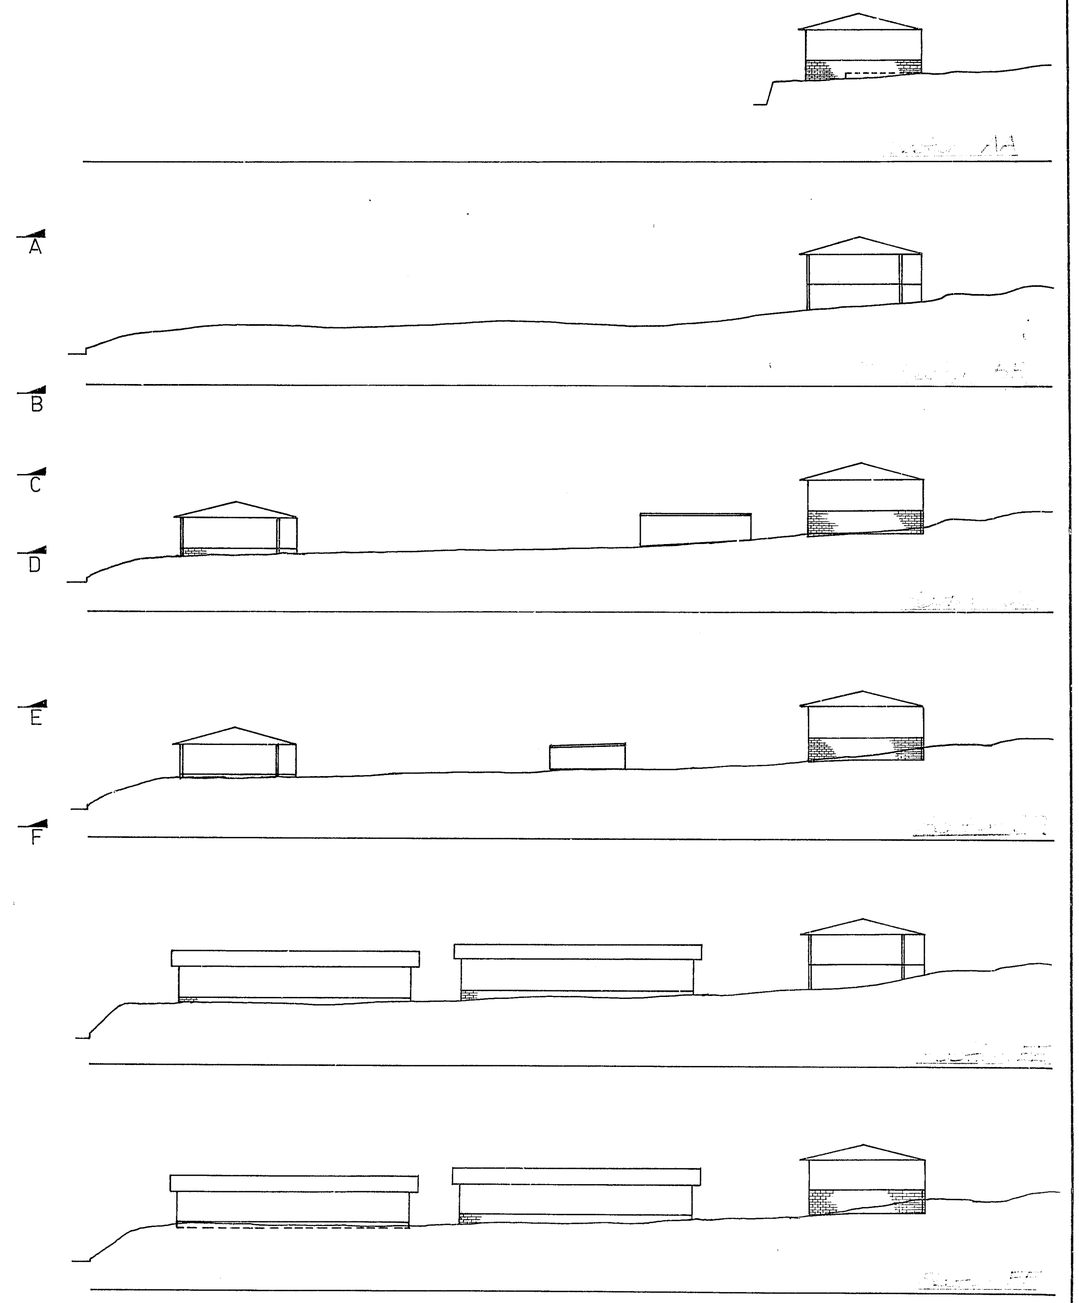

LEGEND

FINISHED CONCRETE LEVEL	30·25
FINISHED GROUND LEVEL	(30·87)
EXISTING GROUND OR PEG LEVEL	30·39
SANITARY SEWER AS BUILT	———
STORMWATER AS BUILT	———

NOTE
ELEVATIONS SCHEMATIC ONLY & NOT TO BE USED FOR BLOCK NUMBERS.
NO FOOTINGS SHOWN.

SURVEYED		7/77
DRAWN		7/77
DESIGNED		7/77
TRACED		9/77
CHECKED		
APPROVED		
REFERENCES		

PIAKO COUNTY COUNCIL
P.O. BOX 26 TE AROHA
F.W. Norton COUNTY ENGINEER

AMENDMENTS	INITIAL	DATE

SILVER JUBILEE FLATS
SITE PLAN
STAGE II

SHEET No. 2 OF 6 SHEETS
P.C.C. 982
SCALES 1:250

ORIGINAL LINE LENGTH 25 ... REPRODUCTION