RRD002IUN5

Document Number: RDC-1094334

Date Registered: 22/1/2021

BUILDING UNIT
AS BUILT DRAINAGE PLAN

Inspection Booking Phone 07 349 5646

Street: Oakland No: 16	Lot: DPS: 389915
Owner: Mark Lam	Drainlayer: Gary Adlem
Inspector: C Lomas	Reg No: 13892
Date of Inspection: 15-10-20	Consent No: 80240

DRAINLAYER PLEASE FILL IN ALL DETAILS

The building consent must be onsite for all inspections.

RECEIVED
16 OCT 2020
B.C. NO 80240

AS BUILT PLAN

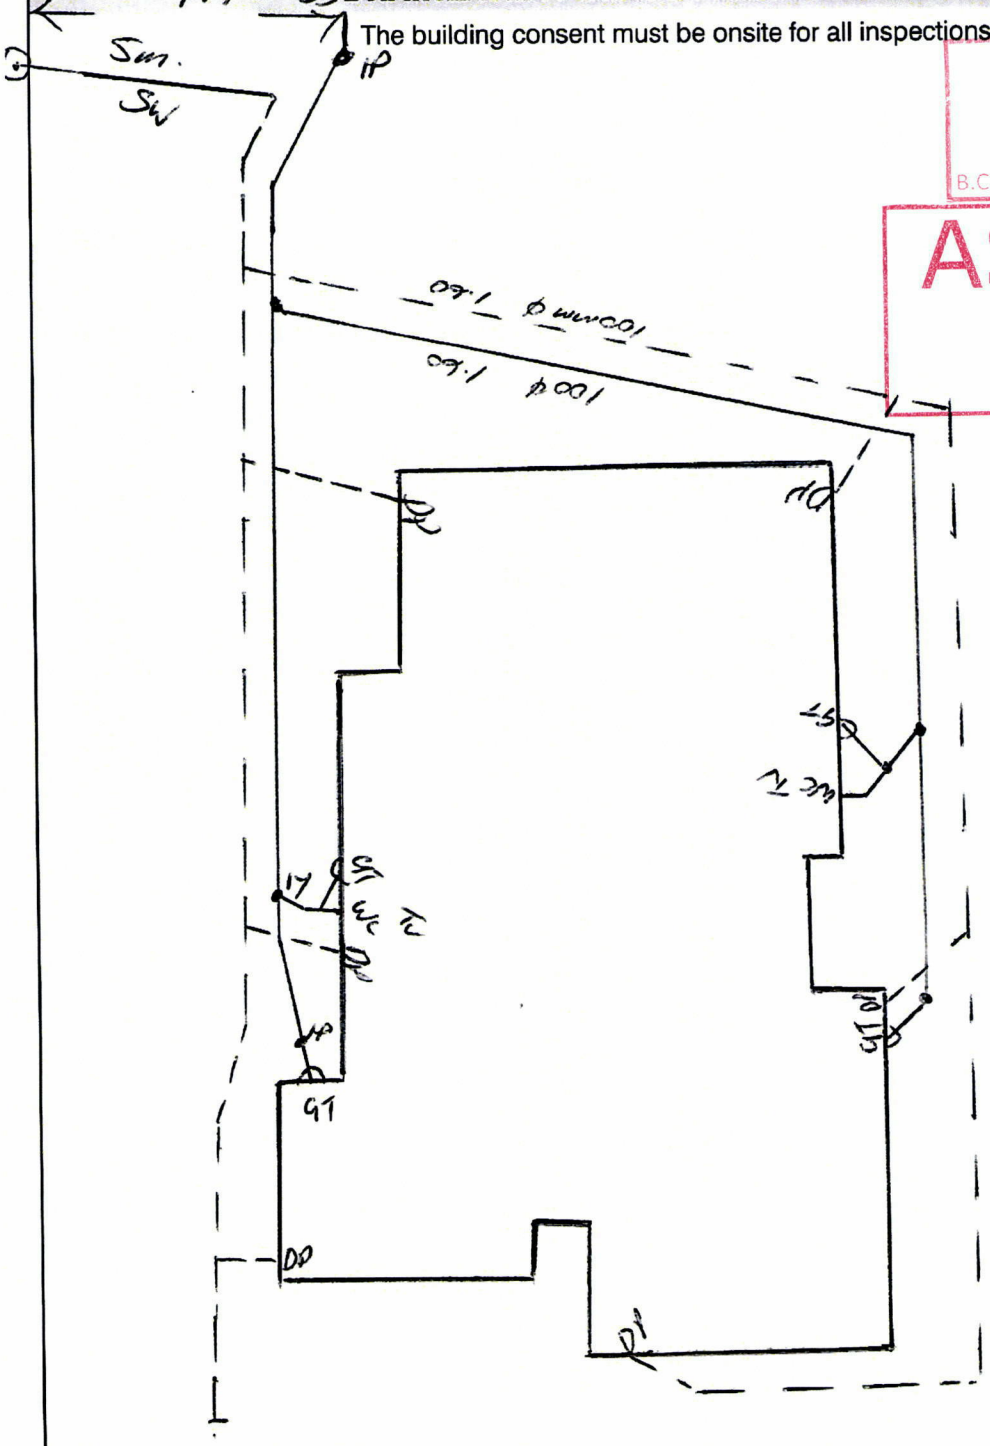

Drainlayer's Signature: Gadlem

Date: 15-10-20

Document Set ID: 1755901
Version: 1, Version Date: 22/01/2021