


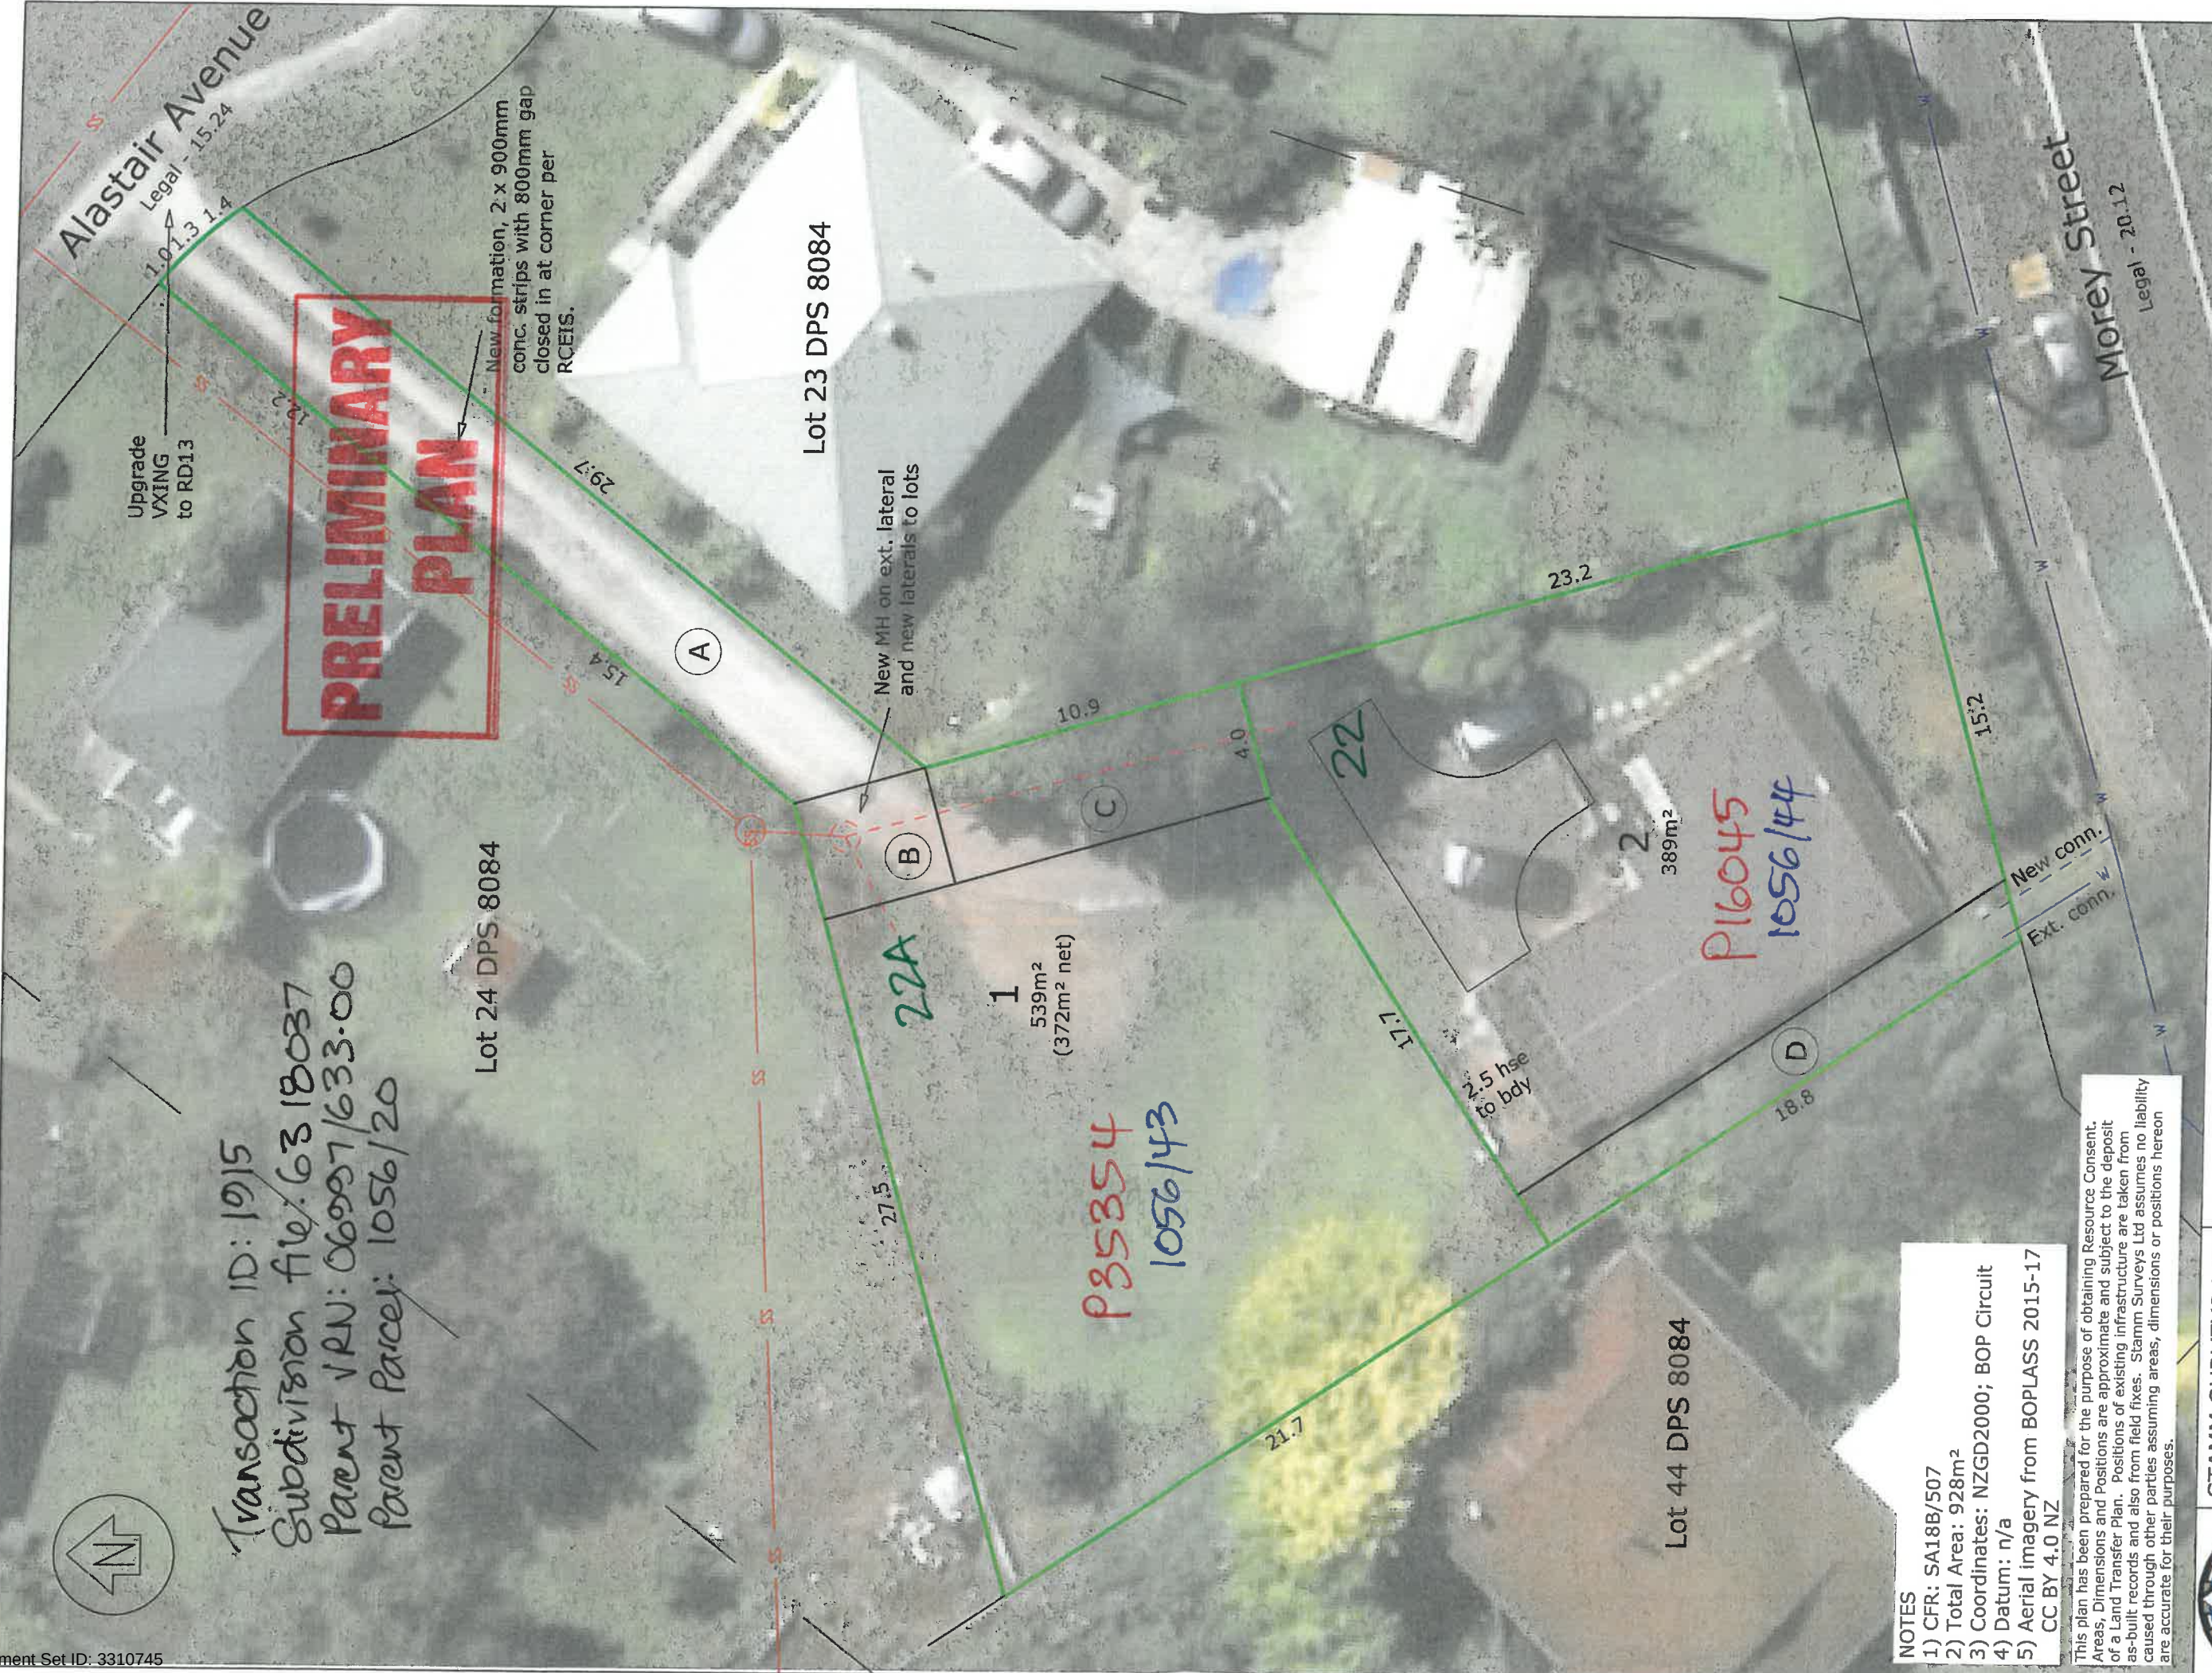

NOTES

- 1) CFR: SA18B/507
- 2) Total Area: 928m²
- 3) Coordinates: NZGD2000; BOP Circuit
- 4) Datum: n/a
- 5) Aerial imagery from BOPCLASS 2015-17 CC BY 4.0 NZ

This plan has been prepared for the purpose of obtaining Resource Consent. Areas, Dimensions and Positions are approximate and subject to the deposit of a Land Transfer Plan. Positions of existing infrastructure are taken from as-built records and also from field fixes. Stamm Surveys Ltd assumes no liability caused through other parties assuming areas, dimensions or positions hereon are accurate for their purposes.



STAMM SURVEYS LTD
PO Box 707, 10 Railway Road,
ROTORUA
P: 07 3483279
M: 0274 777 878
E: office@nzsurveys.co.nz
www.nzsurveys.co.nz

COPYRIGHT STAMM SURVEYS LTD

**Lots 1 & 2 Being
a Subdivision of
Lot 45 DPS 8048**

Client: Rex Gotz
22 Alastair Ave
OWHATA
Zone: Residential 1
ROTORUA LAKES COUNCIL

Drawing: 18016-S-1

8 May 2018

Scale 1: 200 on A3