BUILDING WORK THAT IS NOT SPECIFICALLY DETAILED ON THE CONSENTED PLANS WILL NOT BE THE RESPONSIBLITY OF DRAFTLINE OR THEIR NOMINATED LBP(DESIGN)

REV/D	CH/D	REVISION	DATE

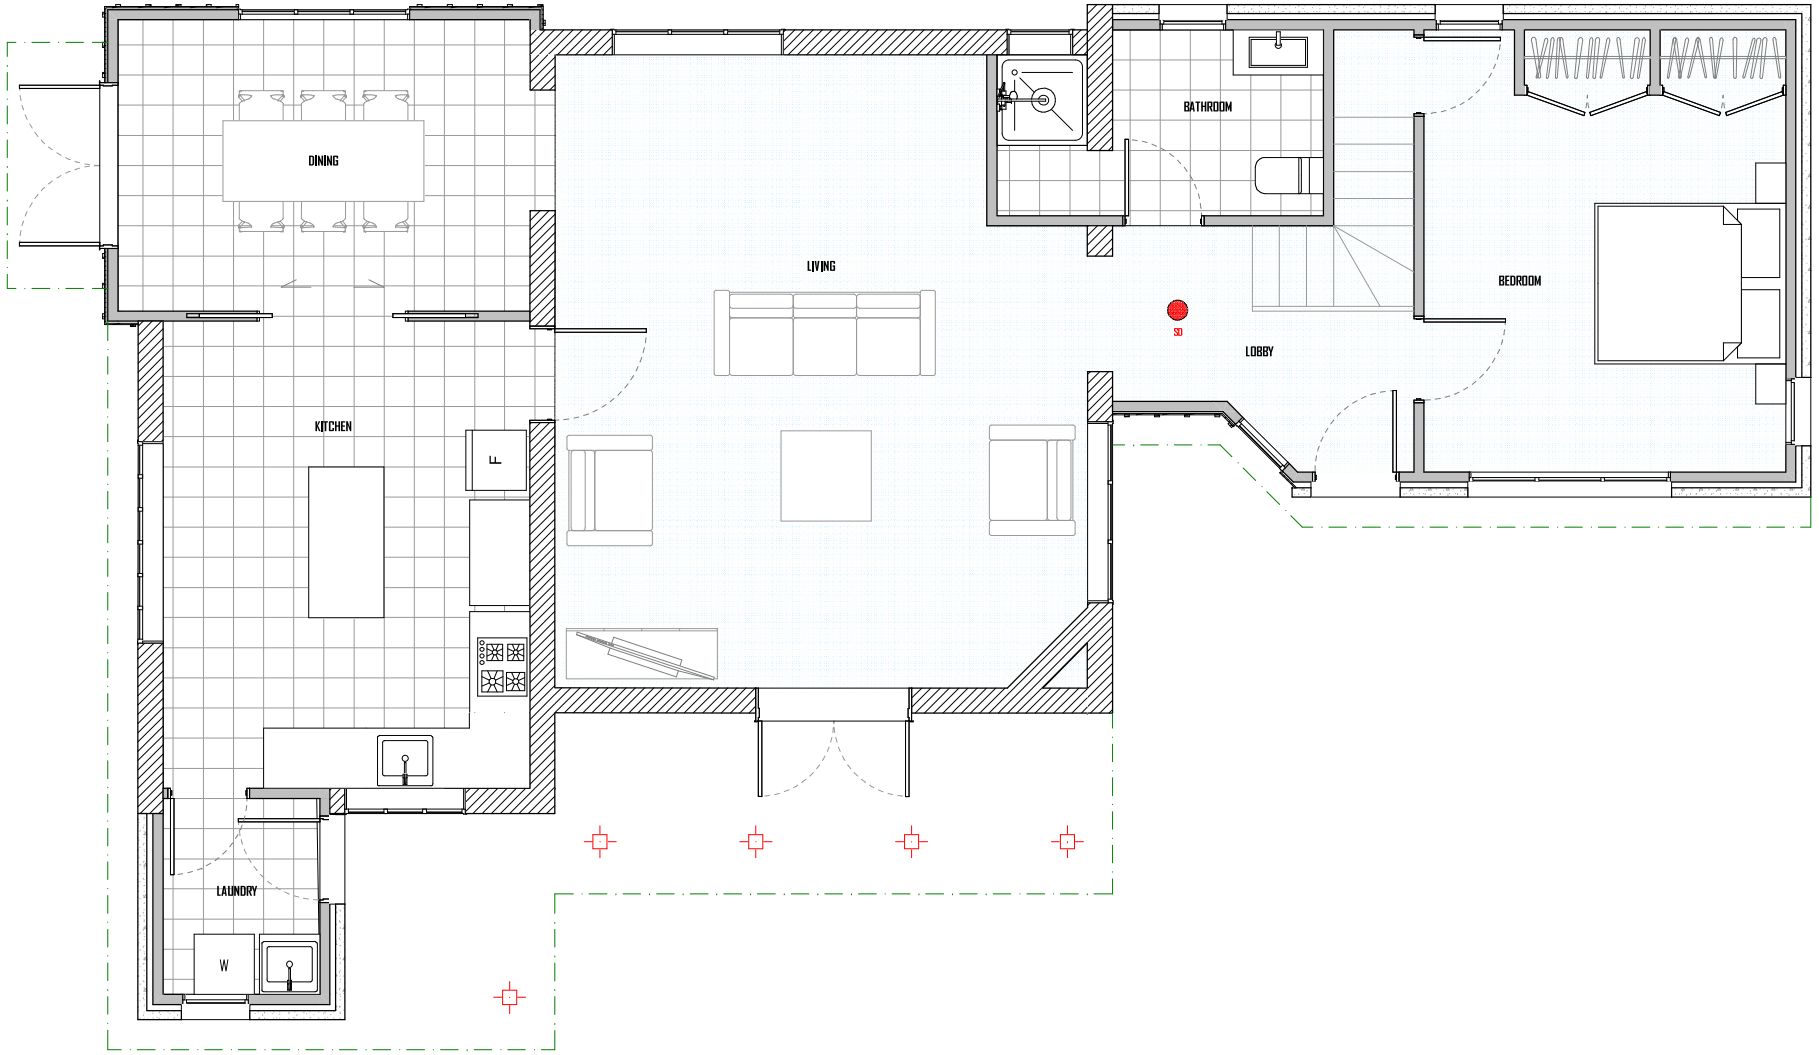

DRAFTLINE PROJECT TEMPLATE VERSION 1.1: 4TH JULY 2022 - ANY MISSING INFORMATION - CONTACT THE DESIGNER. DO NOT SCALE OFF DRAWINGS. (only use figured dimensions). READ IN CONJUNCTION WITHTHE MANUFACTURERS SPECIFICATION BEFORE INSTALLATION.

DRAFTLINE
DESIGN & DRAUGHTING SERVICES

TIMARU OFFICE
10 BESWICK STREET TIMARU
PH 03 688 8455
EMAIL admin@draftline.co.nz

CHRISTCHURCH OFFICE
46 DISRAELI STREET CHRISTCHURCH
PH 03 688 8455
EMAIL admin@draftline.co.nz

NOTES

COPYRIGHT OF THESE DOCUMENTS REMAIN THE PROPERTY OF DRAFTLINE 2021 LTD UNLESS OTHERWISE AGREED TO IN WRITING

ALL DIMENSIONS ARE IN MILLIMETRES UNLESS OTHERWISE STATED
ALL CONSTRUCTION TO COMPLY WITH NZBC/NZS3604:2011, AND ALONGSIDE ALL OTHER CURRENT STANDARDS
PLANS MUST BE READ WITH THE ARCHITECTURAL SPECIFICATIONS AND MANUFACTURERS INFORMATION

ALL DIMENSIONS AND SITE LEVELS TO BE VERIFIED ON SITE

JOB TITLE
4 HILLSDEN PLACE, TIMARU 7910
AS BUILT FLOOR PLANS

DESIGNER	N/A
DRAFTSMAN	A. KITCHING
CHECKED	N/A
PROJECT NUMBER	23120013
PRINT DATE	19/12/2023

CLIENT NAME
MIKE PERO REAL ESTATE

DRAWING TITLE
GROUND FLOOR PLAN

SCALE @ A3
1:50

DRAWING NUMBER
A101

REVISION ID

BUILDING WORK THAT IS NOT SPECIFICALLY DETAILED ON THE CONSENTED PLANS WILL NOT BE THE RESPONSIBLITY OF DRAFTLINE OR THEIR NOMINATED LBP(DESIGN)

REV ID	CHID	REVISION	DATE

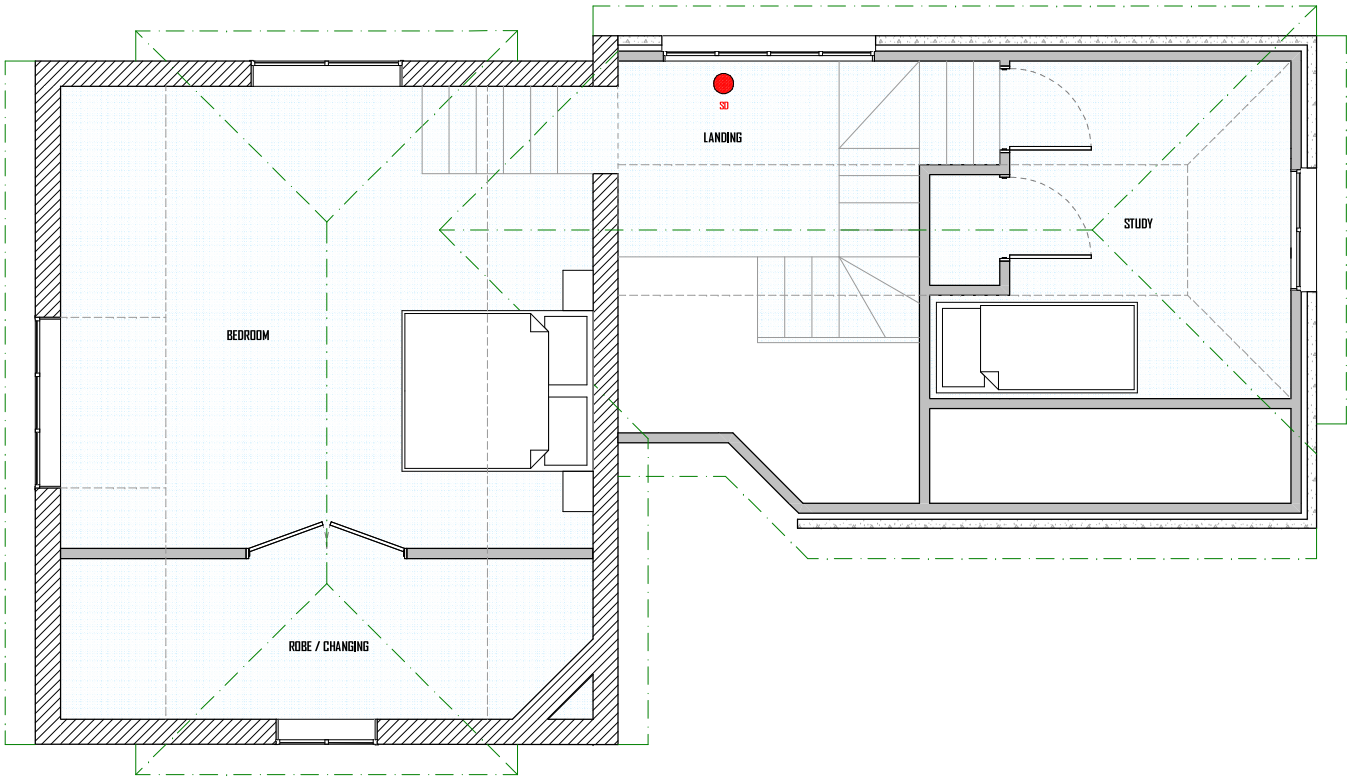

DRAFTLINE PROJECT TEMPLATE VERSION 1.1: 4TH JULY 2022 - ANY MISSING INFORMATION - CONTACT THE DESIGNER. DO NOT SCALE OFF DRAWINGS. (only use figured dimensions). READ IN CONJUNCTION WITHTHE MANUFACTURERS SPECIFICATION BEFORE INSTALLATION.

DRAFTLINE
DESIGN & DRAUGHTING SERVICES

TIMARU OFFICE
10 BESWICK STREET TIMARU
PH 03 688 8455
EMAIL admin@draftline.co.nz

CHRISTCHURCH OFFICE
46 DISRAELI STREET CHRISTCHURCH
PH 03 688 8455
EMAIL admin@draftline.co.nz

NOTES
COPYRIGHT OF THESE DOCUMENTS REMAIN THE PROPERTY OF DRAFTLINE 2021 LTD UNLESS OTHERWISE AGREED TO IN WRITING
ALL DIMENSIONS ARE IN MILLIMETRES UNLESS OTHERWISE STATED
ALL CONSTRUCTION TO COMPLY WITH NZBC/NZS3604:2011, AND ALONGSIDE ALL OTHER CURRENT STANDARDS
PLANS MUST BE READ WITH THE ARCHITECTURAL SPECIFICATIONS AND MANUFACTURERS INFORMATION

ALL DIMENSIONS AND SITE LEVELS TO BE VERIFIED ON SITE

JOB TITLE
4 HILLSDEN PLACE, TIMARU 7910
AS BUILT FLOOR PLANS

DESIGNER	N/A
DRAFTSMAN	A. KITCHING
CHECKED	N/A
PROJECT NUMBER	23120013
PRINT DATE	19/12/2023

CLIENT NAME
MIKE PERO REAL ESTATE

DRAWING TITLE
FIRST FLOOR PLAN

SCALE @ A3
1:50

DRAWING NUMBER
A102

REVISION ID