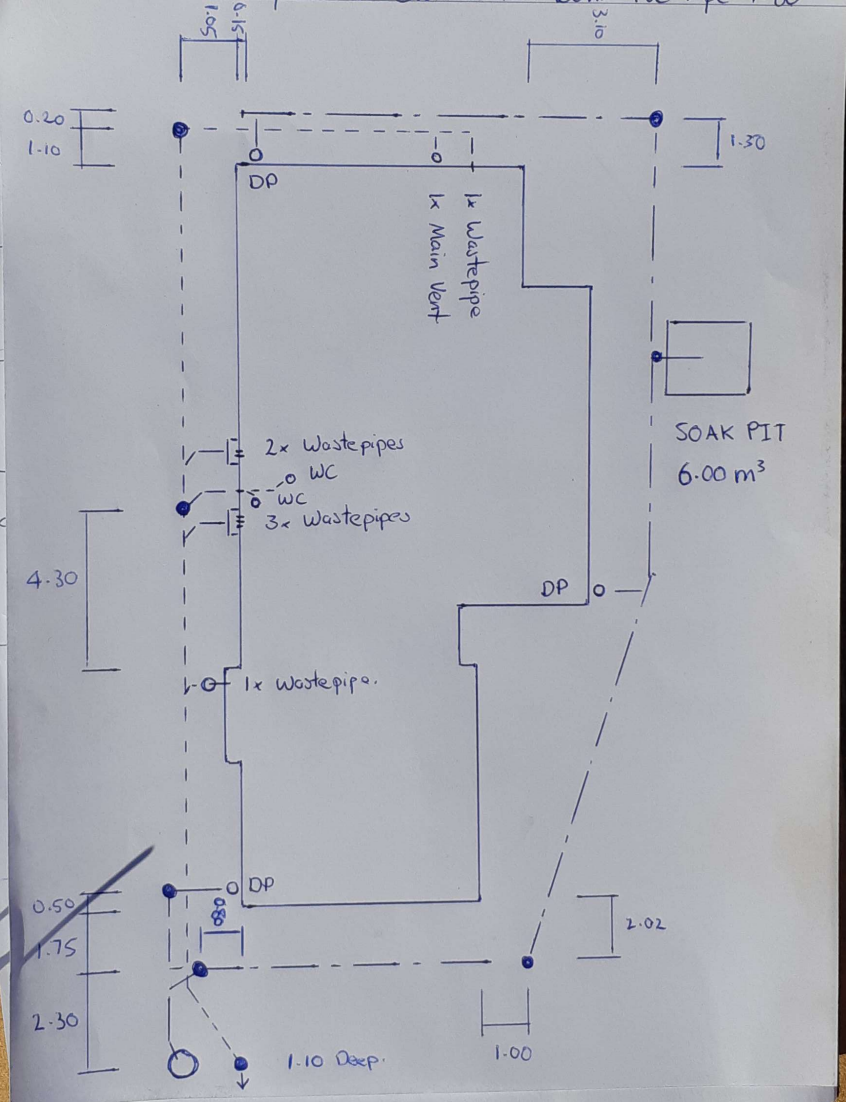2 Branthwaite Drive, Rolleston. BCN 231907 30/04/2024
Drainlayer : Michael Henry Attewell # 18515
Sewer 100mm PVC Pipe 1:60 Stormwater 100mm PVC Pipe 1:80