


COPYRIGHT - OVERINGTON SURVEYORS
 THIS DOCUMENT SHALL BE USED ONLY FOR THE PURPOSE FOR WHICH IT WAS SUPPLIED AND
 MUST NOT BE USED IN ISOLATION FROM OTHER ASSOCIATED INFORMATION

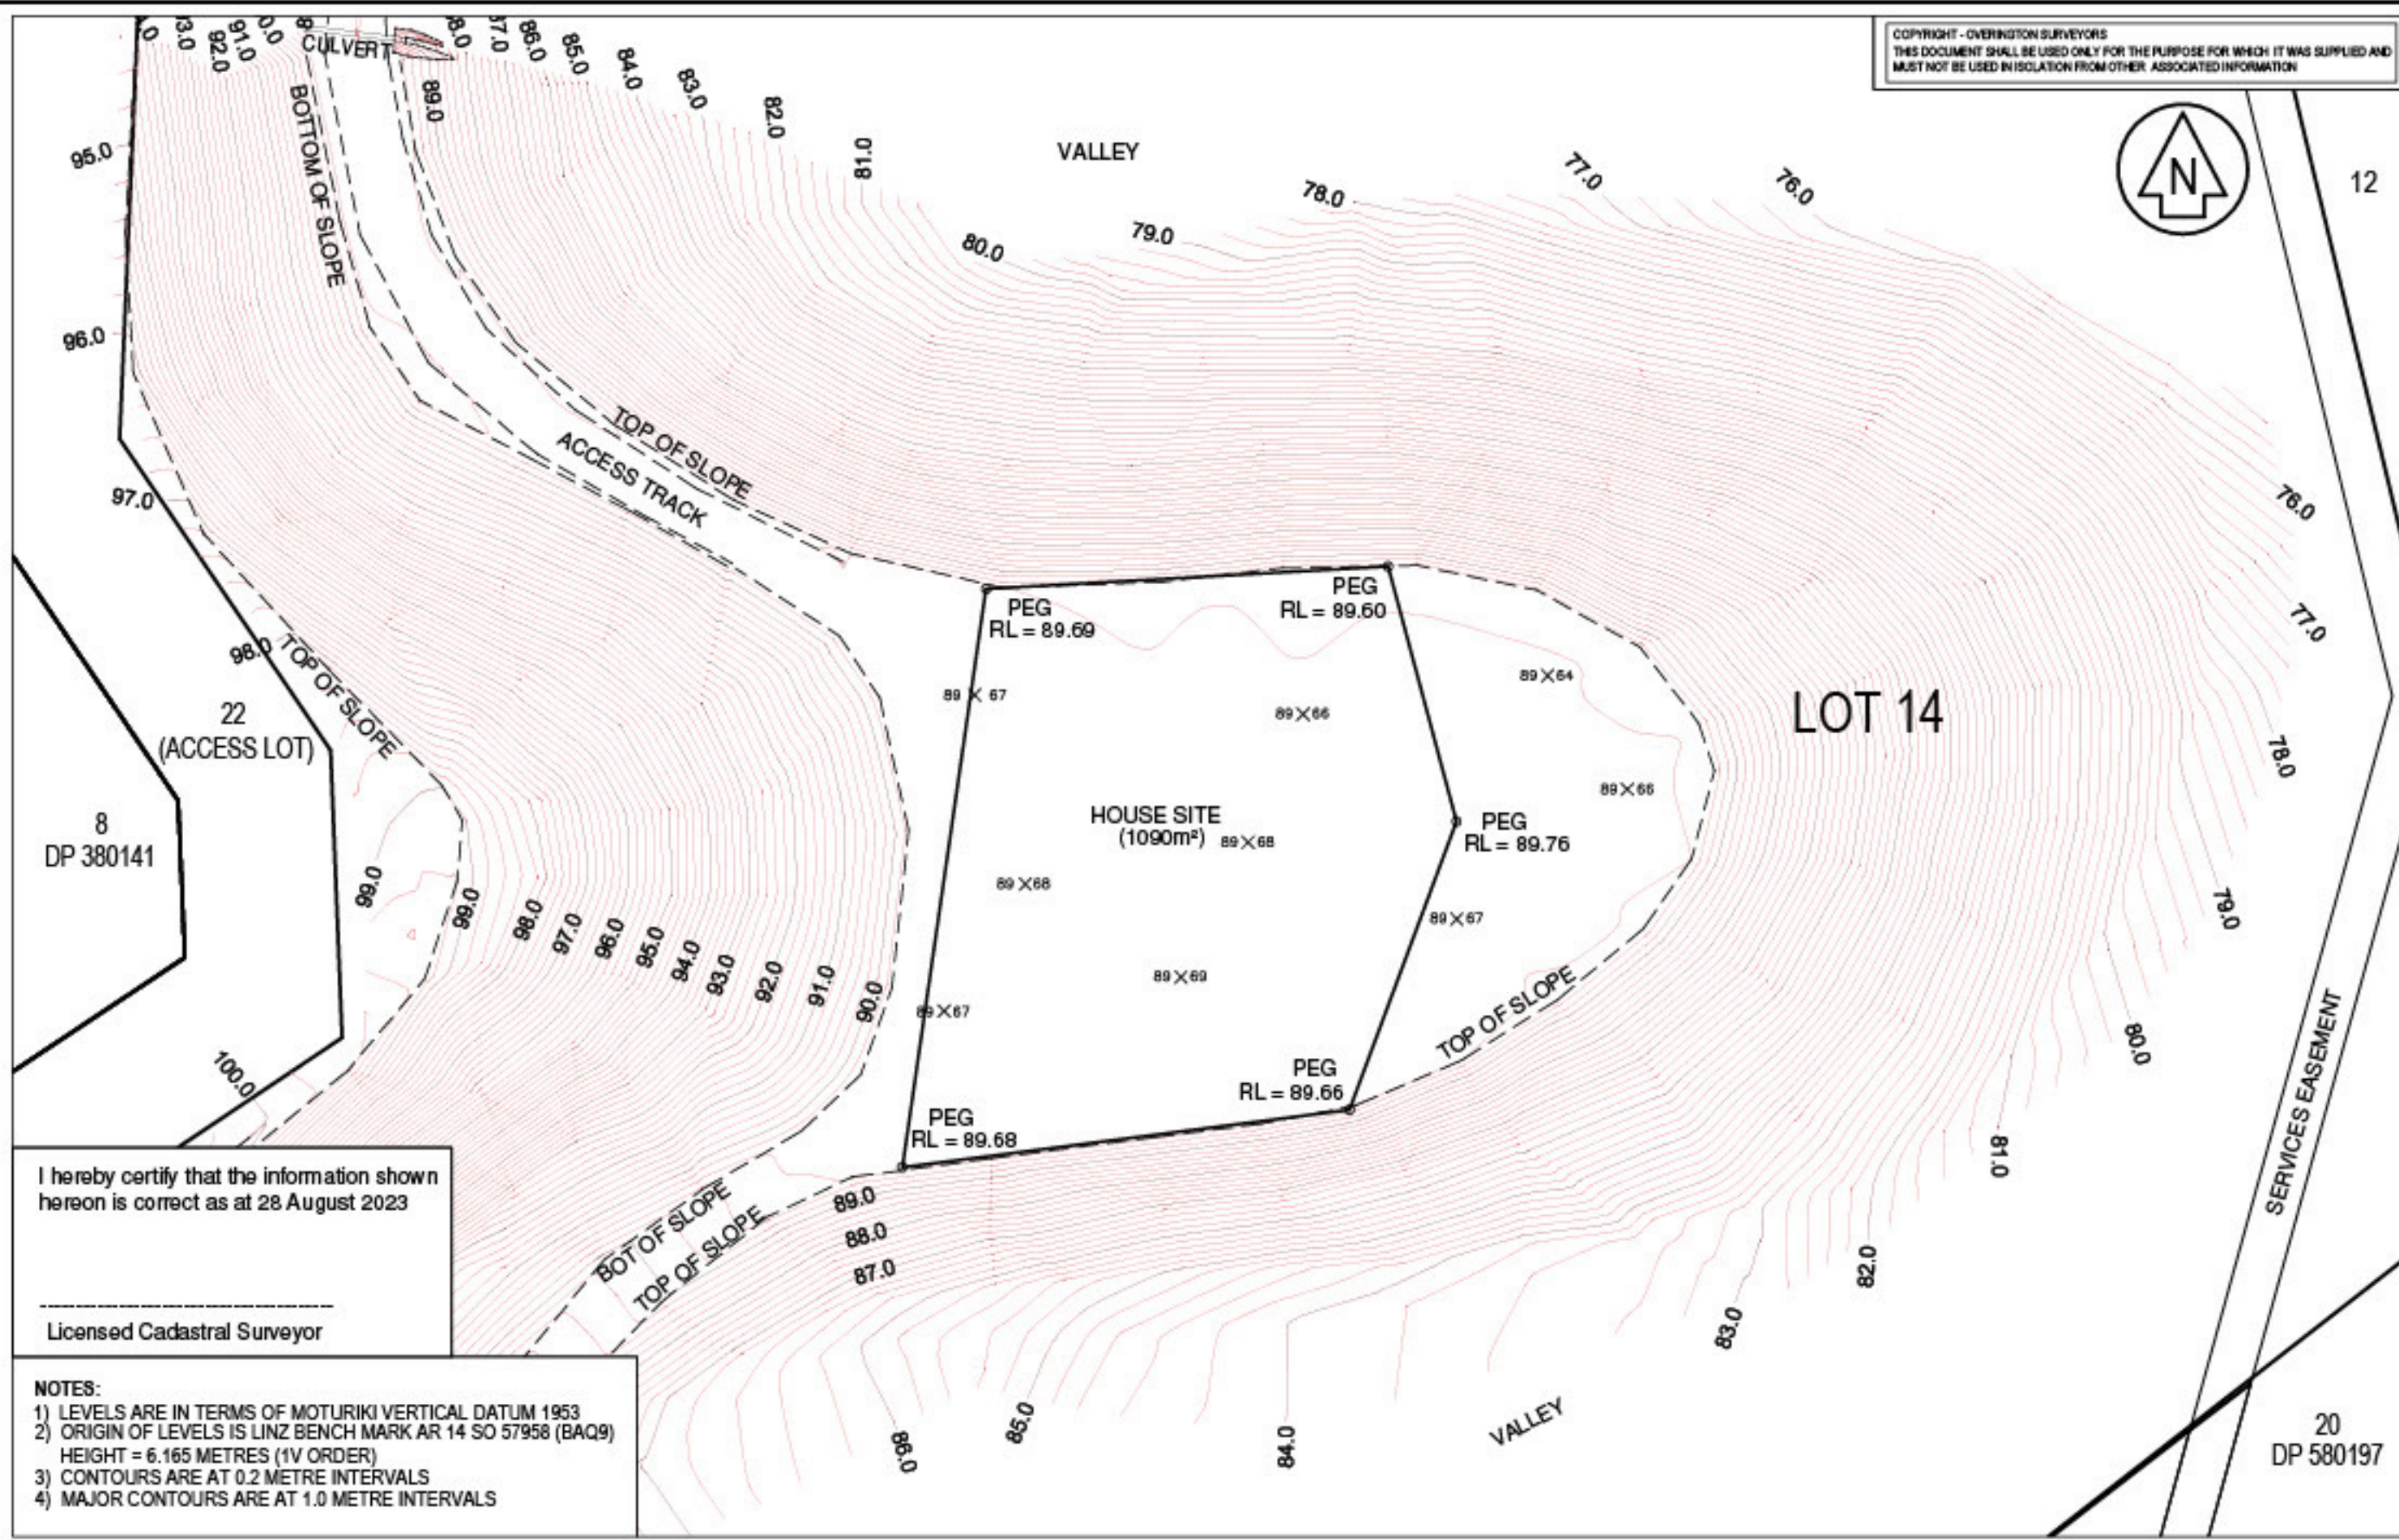

I hereby certify that the information shown hereon is correct as at 28 August 2023

 Licensed Cadastral Surveyor

- NOTES:**
- 1) LEVELS ARE IN TERMS OF MOTURIKI VERTICAL DATUM 1953
 - 2) ORIGIN OF LEVELS IS LINZ BENCH MARK AR 14 SO 57958 (BAQ9)
 HEIGHT = 6.165 METRES (1V ORDER)
 - 3) CONTOURS ARE AT 0.2 METRE INTERVALS
 - 4) MAJOR CONTOURS ARE AT 1.0 METRE INTERVALS

PREPARED FOR:
 PUKEKO ESTATES (2021) LIMITED
 220 WITTY ROAD
 AWAKAPONGA
 WHAKATANE

HOUSE SITE AS-BUILT PLAN LOT 14

DATE	AUGUST 2023	
SCALE	1 : 400 (A3)	
No.	Date	Revision

OVERINGTON SURVEYORS

Phone: 0274 994208 Email: ross.overington@overington.co.nz

DESIGNED	CGO	SURVEYED
DRAWN	CGO	

DRAWING No.
**4106
 AB 14**

CAD No.