
A-sbuilt Drainage Plan by Universal Drainage

UNIVERSAL DRAINAGE

Date: 18-2-22 Address: (LOT 156) 33 Tara PL WOODEND BCN No: 200635 Name: JUSTIN REGO: 26216

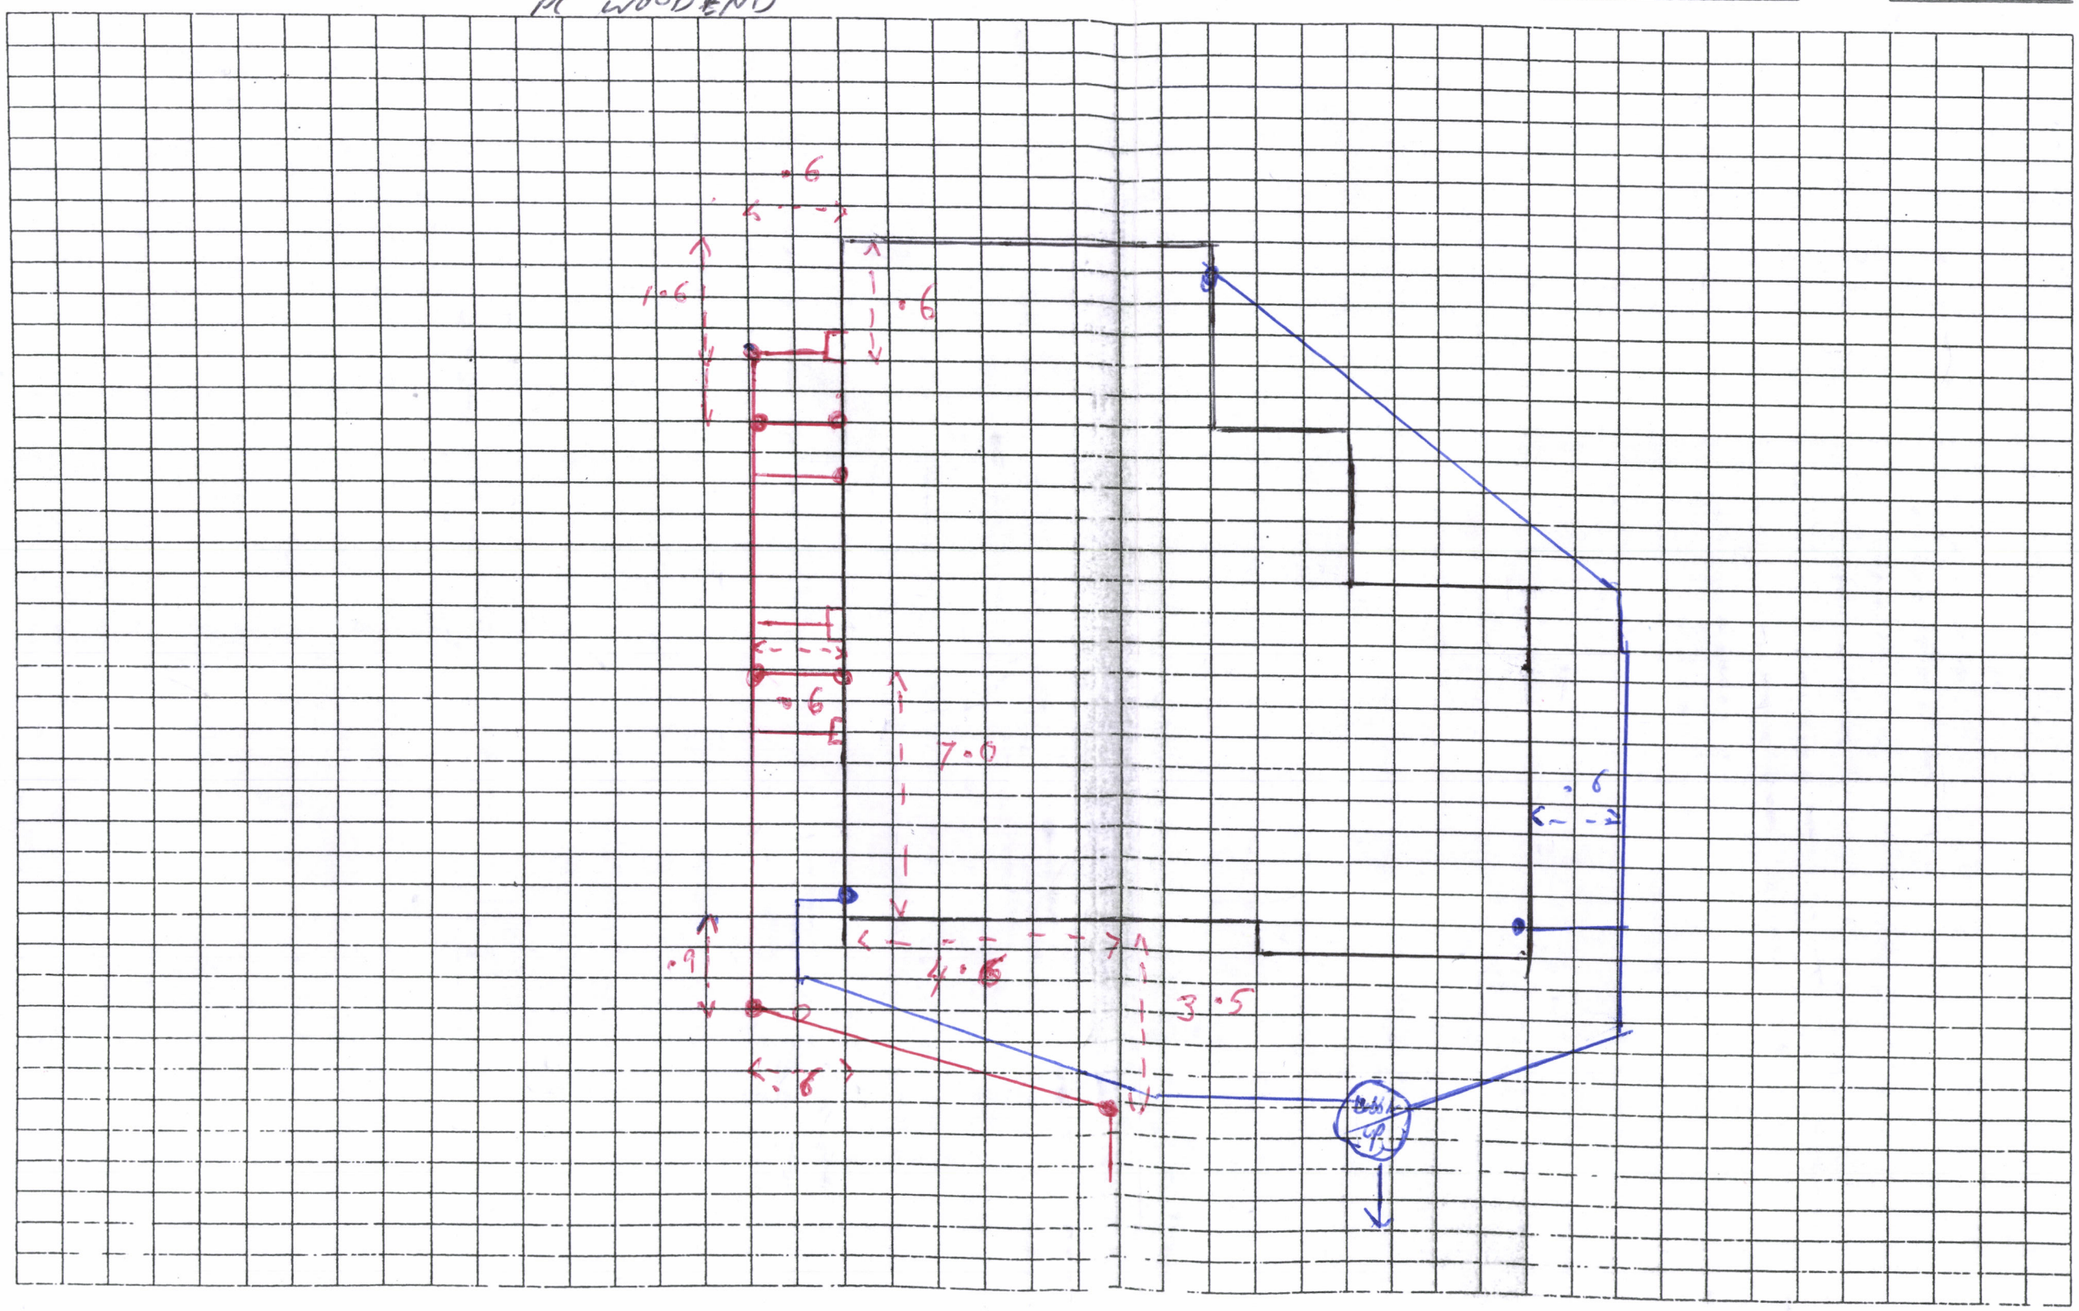


sewer grade 1:90

storm grade 1:90